
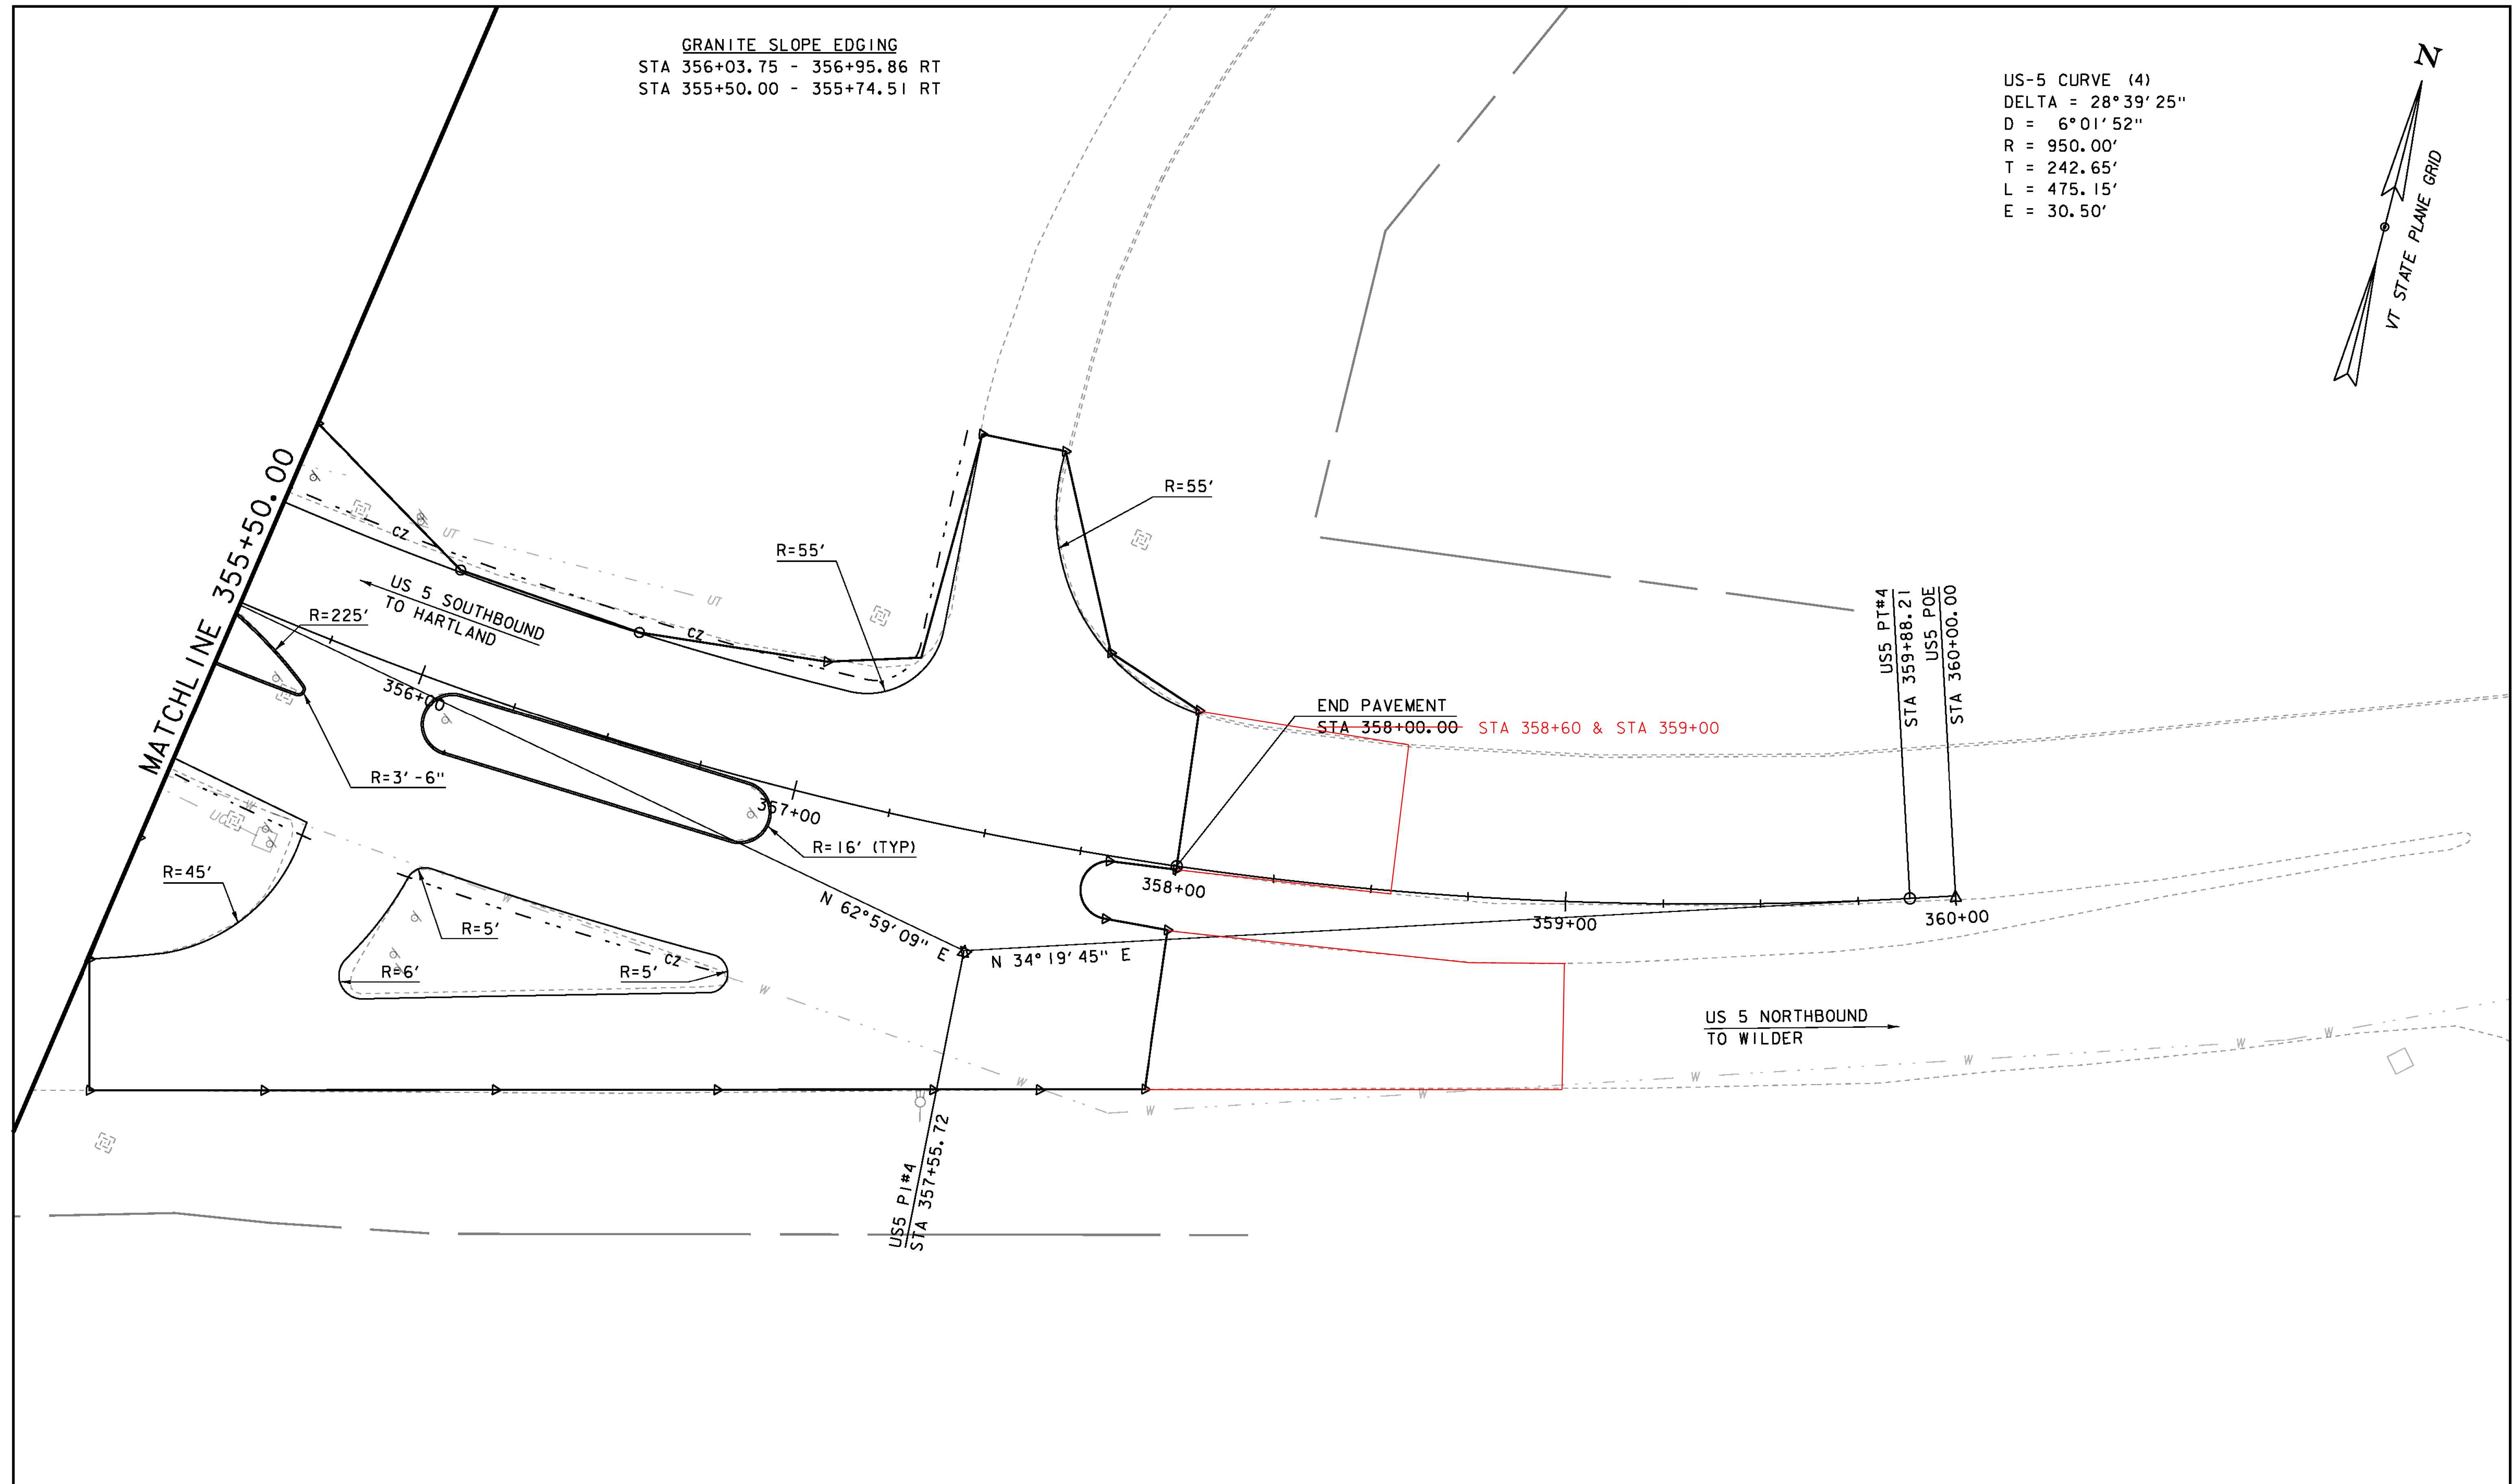


GRANITE SLOPE EDGING  
 STA 356+03.75 - 356+95.86 RT  
 STA 355+50.00 - 355+74.51 RT

US-5 CURVE (4)  
 DELTA = 28°39'25"  
 D = 6°01'52"  
 R = 950.00'  
 T = 242.65'  
 L = 475.15'  
 E = 30.50'

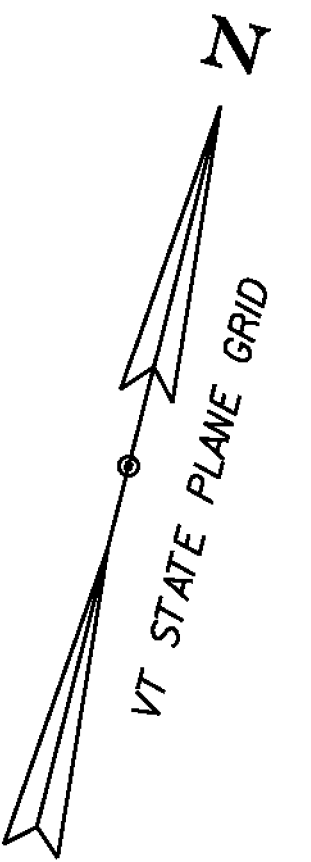

US 5 LAYOUT SHEET 3

SCALE 1" = 20'-0"  
 20 0 20

PROJECT NAME: HARTFORD	PLOT DATE: 15-DEC-2014
PROJECT NUMBER: IM 091-2(79)	DRAWN BY: K. FRIEDLAND
FILE NAME: s12ol32bdr_rte5.dgn	CHECKED BY: J. SALVATORI
DESIGNED BY: W. LAMMER	SHEET 28 OF 166
US 5 LAYOUT SHEET 3	