

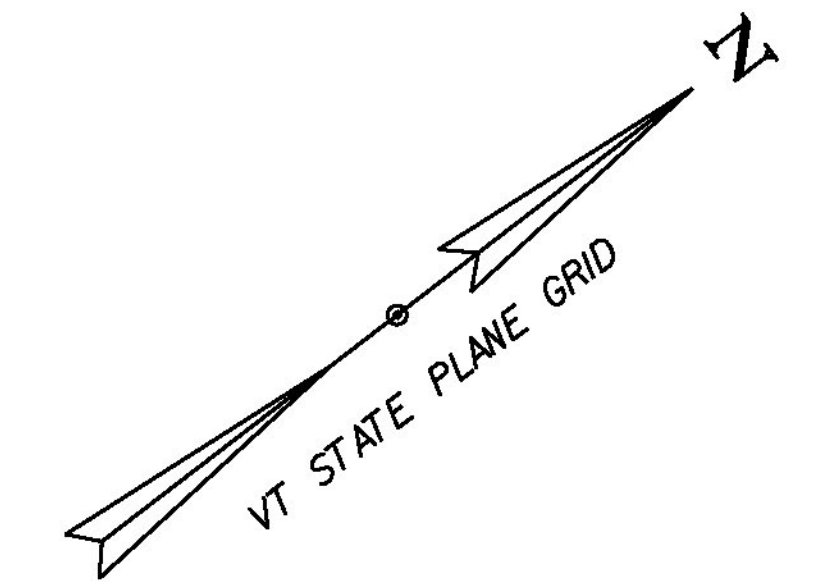


MATCHLINE STA 16+50

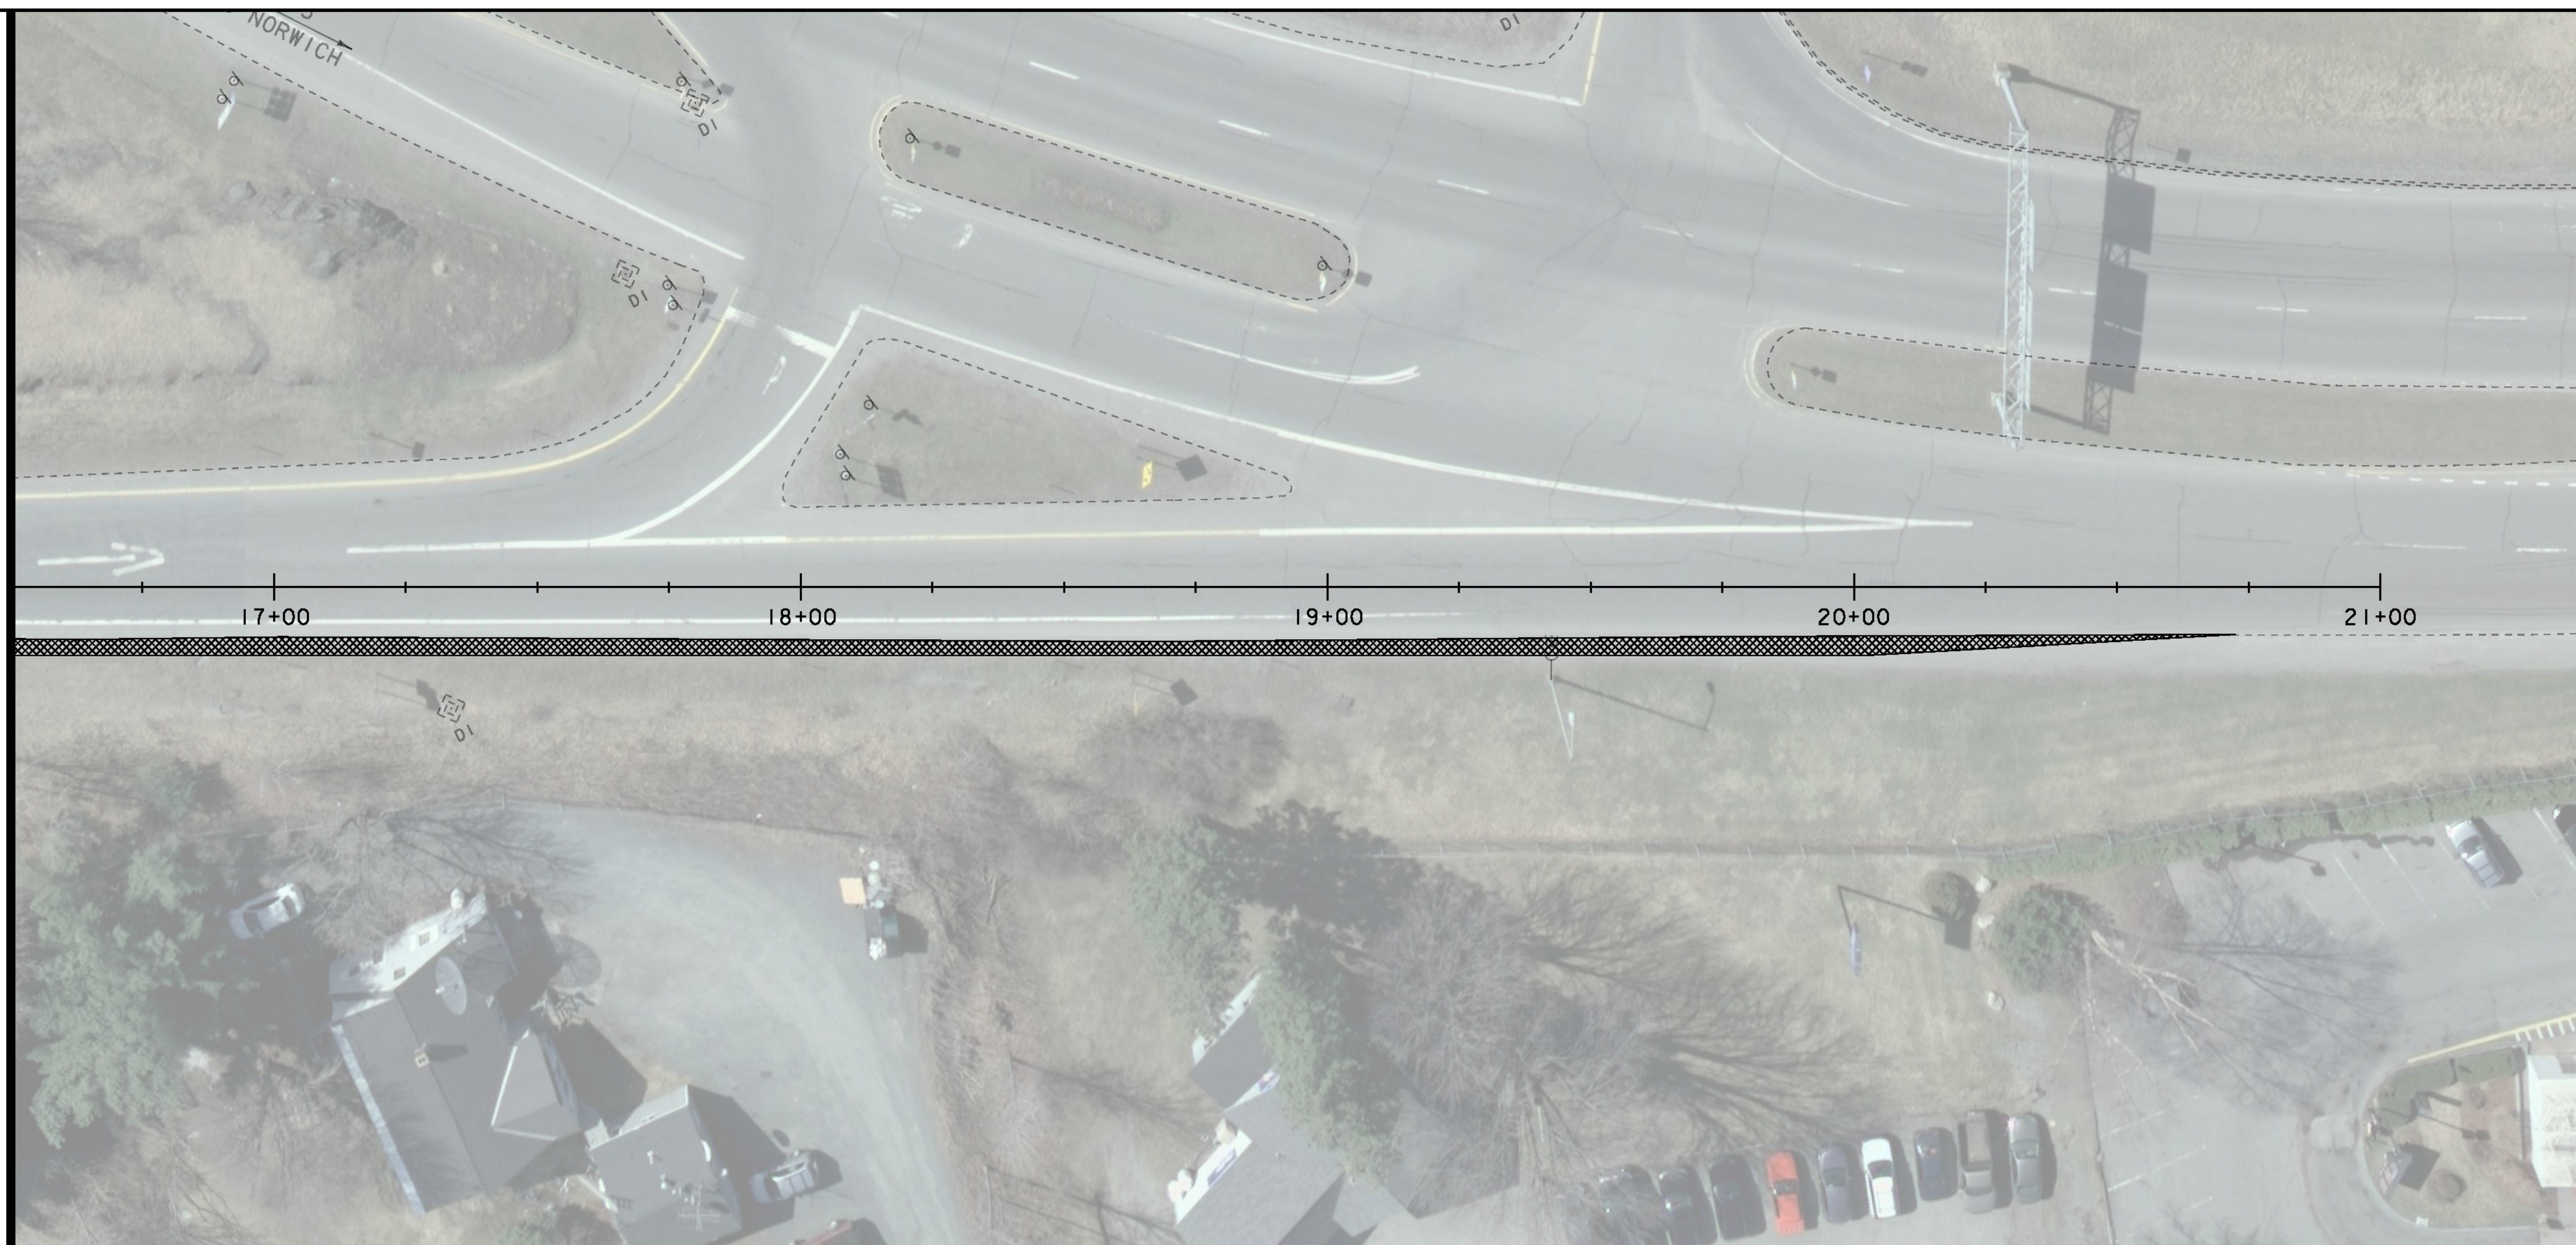

RAMP C LAYOUT 2

SCALE 1" = 20'-0"  
20 0 20

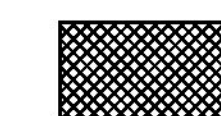

AREA OF TEMPORARY EXPANSION

|                              |                           |
|------------------------------|---------------------------|
| PROJECT NAME: HARTFORD       | PLOT DATE: 15-DEC-2014    |
| PROJECT NUMBER: IM 091-2(79) | DRAWN BY: J. SALVATORI    |
| FILE NAME: s12a132rampc.dgn  | DESIGNED BY: J. SALVATORI |
| PROJECT LEADER: K. HIGGINS   | CHECKED BY: -----         |
| RAMP C TEMPORARY EXPANSION 2 | SHEET 41 OF 166           |