

OFFSETS FOR GUARDRAIL FLARE

STATION	OFFSET
STA 246+92.50	27.17' LT
STA 247+29.25	23.17' LT
STA 247+41.75	22.75' LT
STA 247+66.50	21.83' LT
STA 247+91.25	20.92' LT
STA 248+16.00	20.00' LT
STA 248+40.75	19.08' LT
STA 248+65.75	18.08' LT
STA 248+90.50	17.08' LT
STA 249+15.25	16.00' LT

DELINEATOR W/STEEL POST (BLUE)


STA 246+90.00 LT
STA 247+04.00 RT

DELINEATOR W/STEEL POST (GREEN)

STA 149+17.00 RT
STA 251+92.00 LT

ANCHOR FOR STEEL BEAM RAIL

STA 149+34.00 RT
STA 249+42.00 FLT
STA 249+47.00 LT
STA 251+44.00 FLT
STA 251+49.00 LT
STA 251+75.00 LT

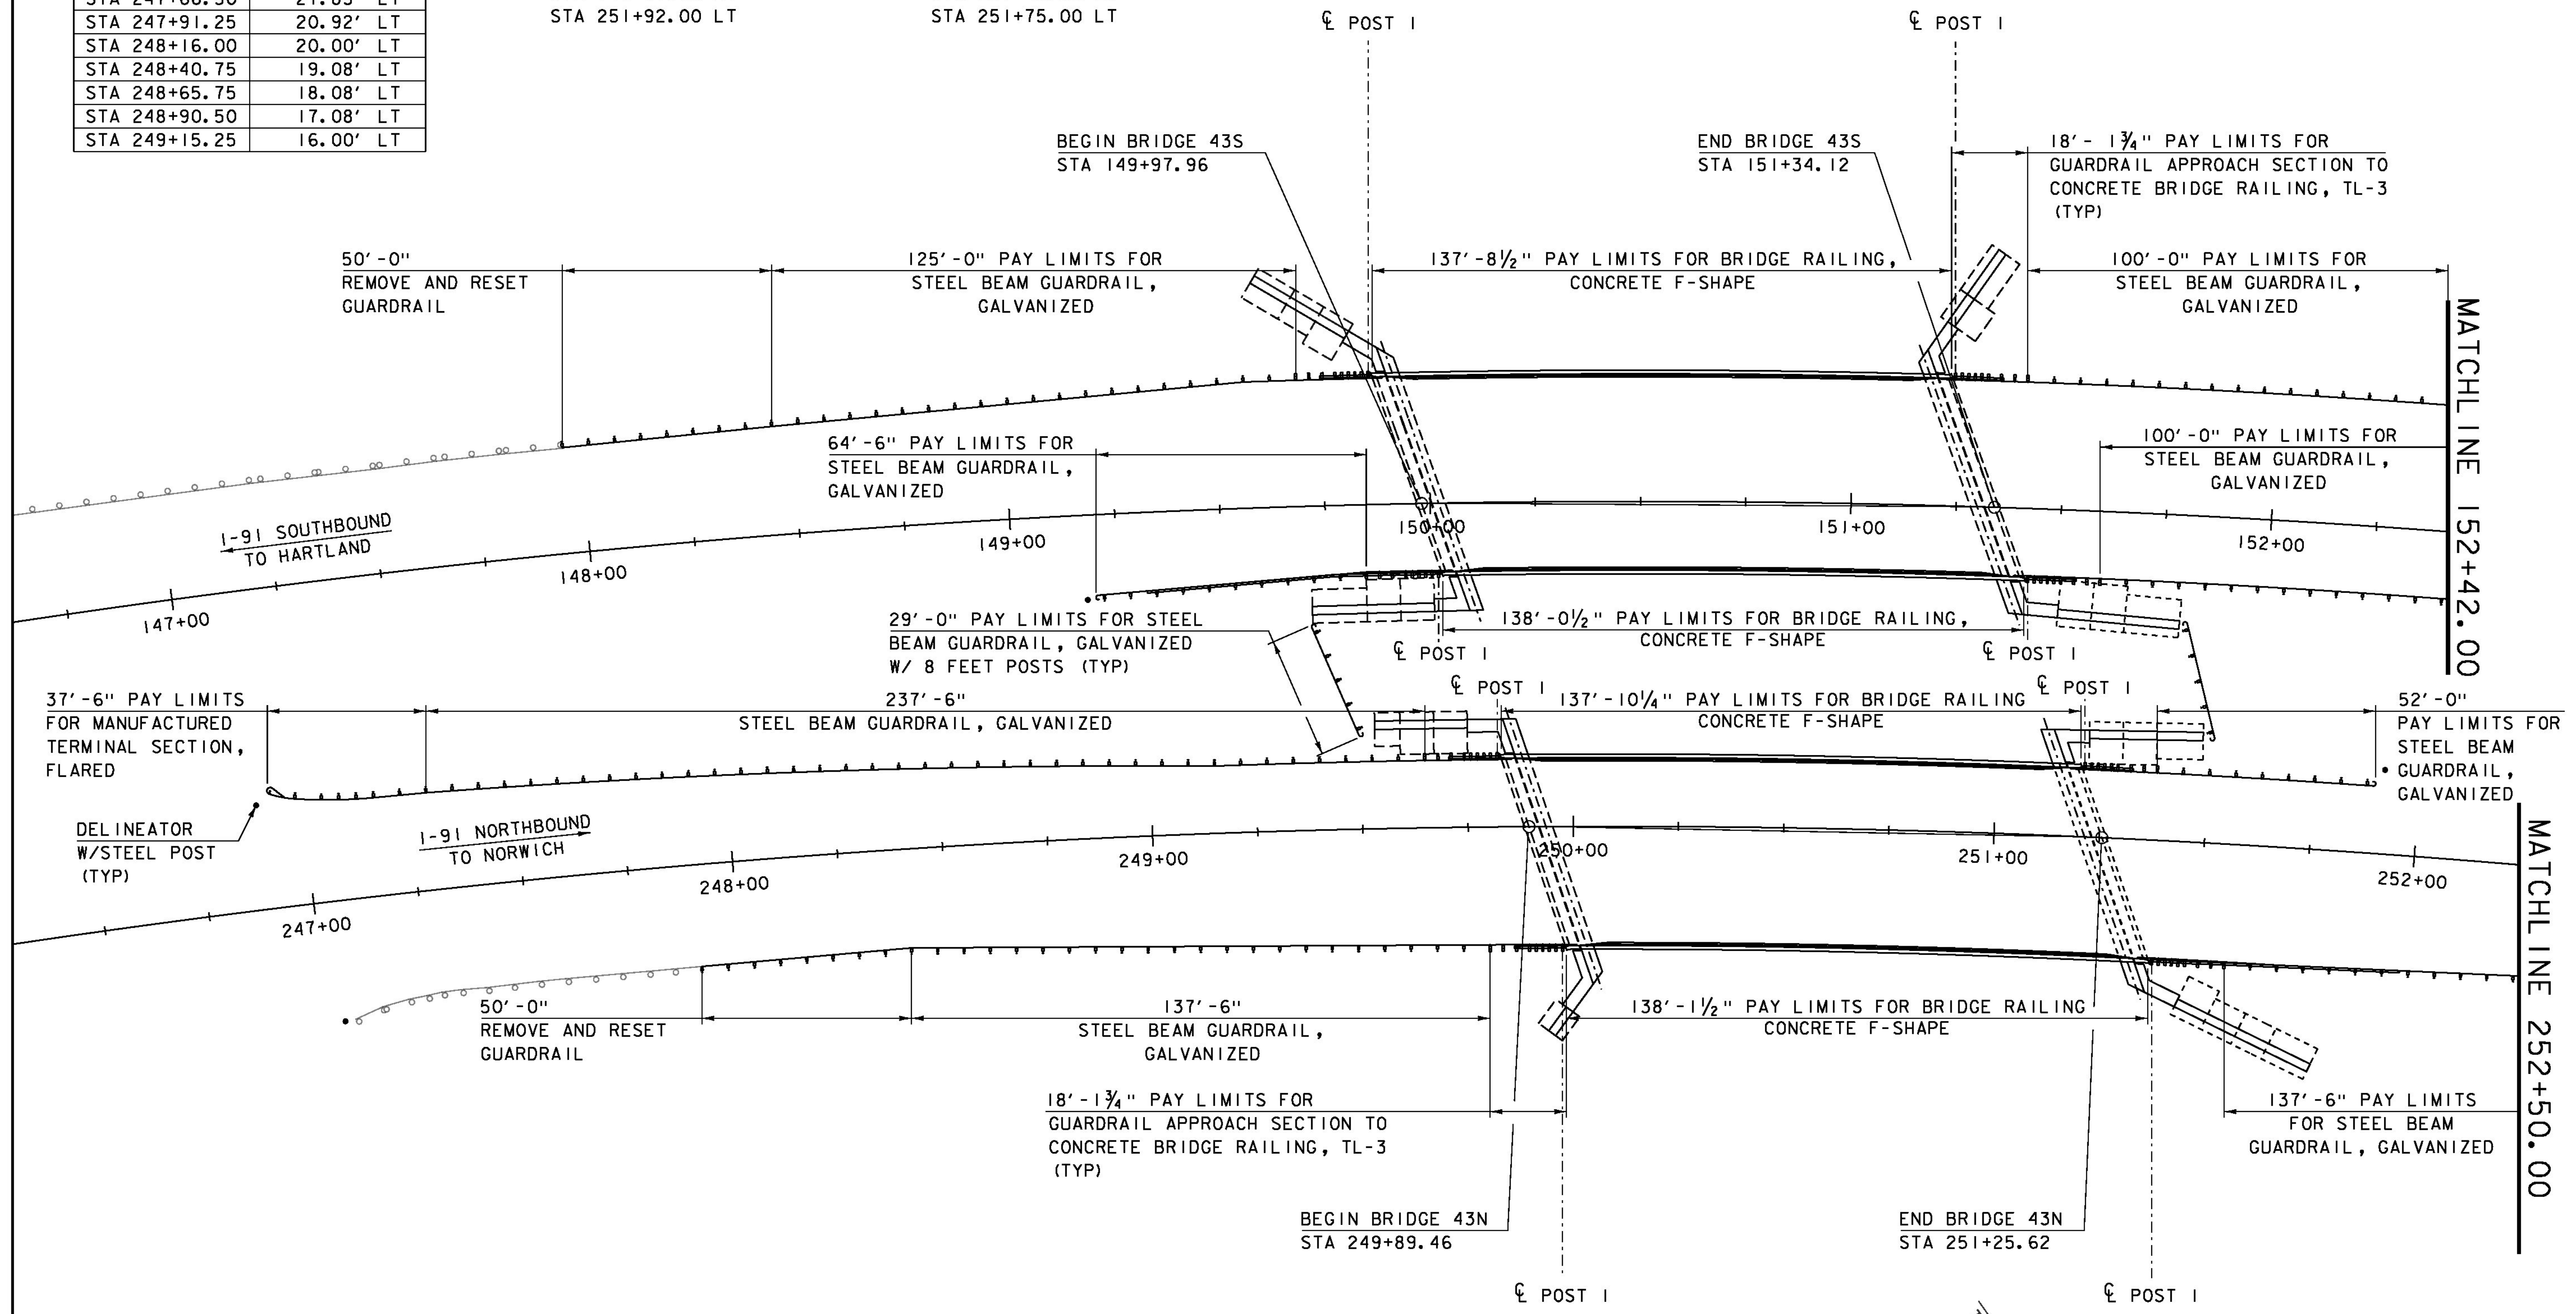

NOTES:

- SEE STANDARDS C-10, G-1, G-1D, G-19, T-40, T-45, S-363 FOR FURTHER DETAILS.
- OFFSETS GIVEN FOR GUARDRAIL FLARE ARE TO FACE OF RAIL.

RAIL LAYOUT SHEET 1

SCALE 1" = 20'-0"
20 0 20

PROJECT NAME:	HARTFORD	FILE NAME:	st2a132bdr_rail.dgn	PLOT DATE:	15-DEC-2014
PROJECT NUMBER:	IM 091-2(79)	PROJECT LEADER:	K. HIGGINS	DRAWN BY:	K. FRIEDLAND
		DESIGNED BY:	J. GRIGAS	CHECKED BY:	J. SALVATORI
		RAIL LAYOUT SHEET 1		SHEET	64 OF 166