


BRIDGE 43N TYPICAL SECTION
SCALE: 1/4" = 1'-0"

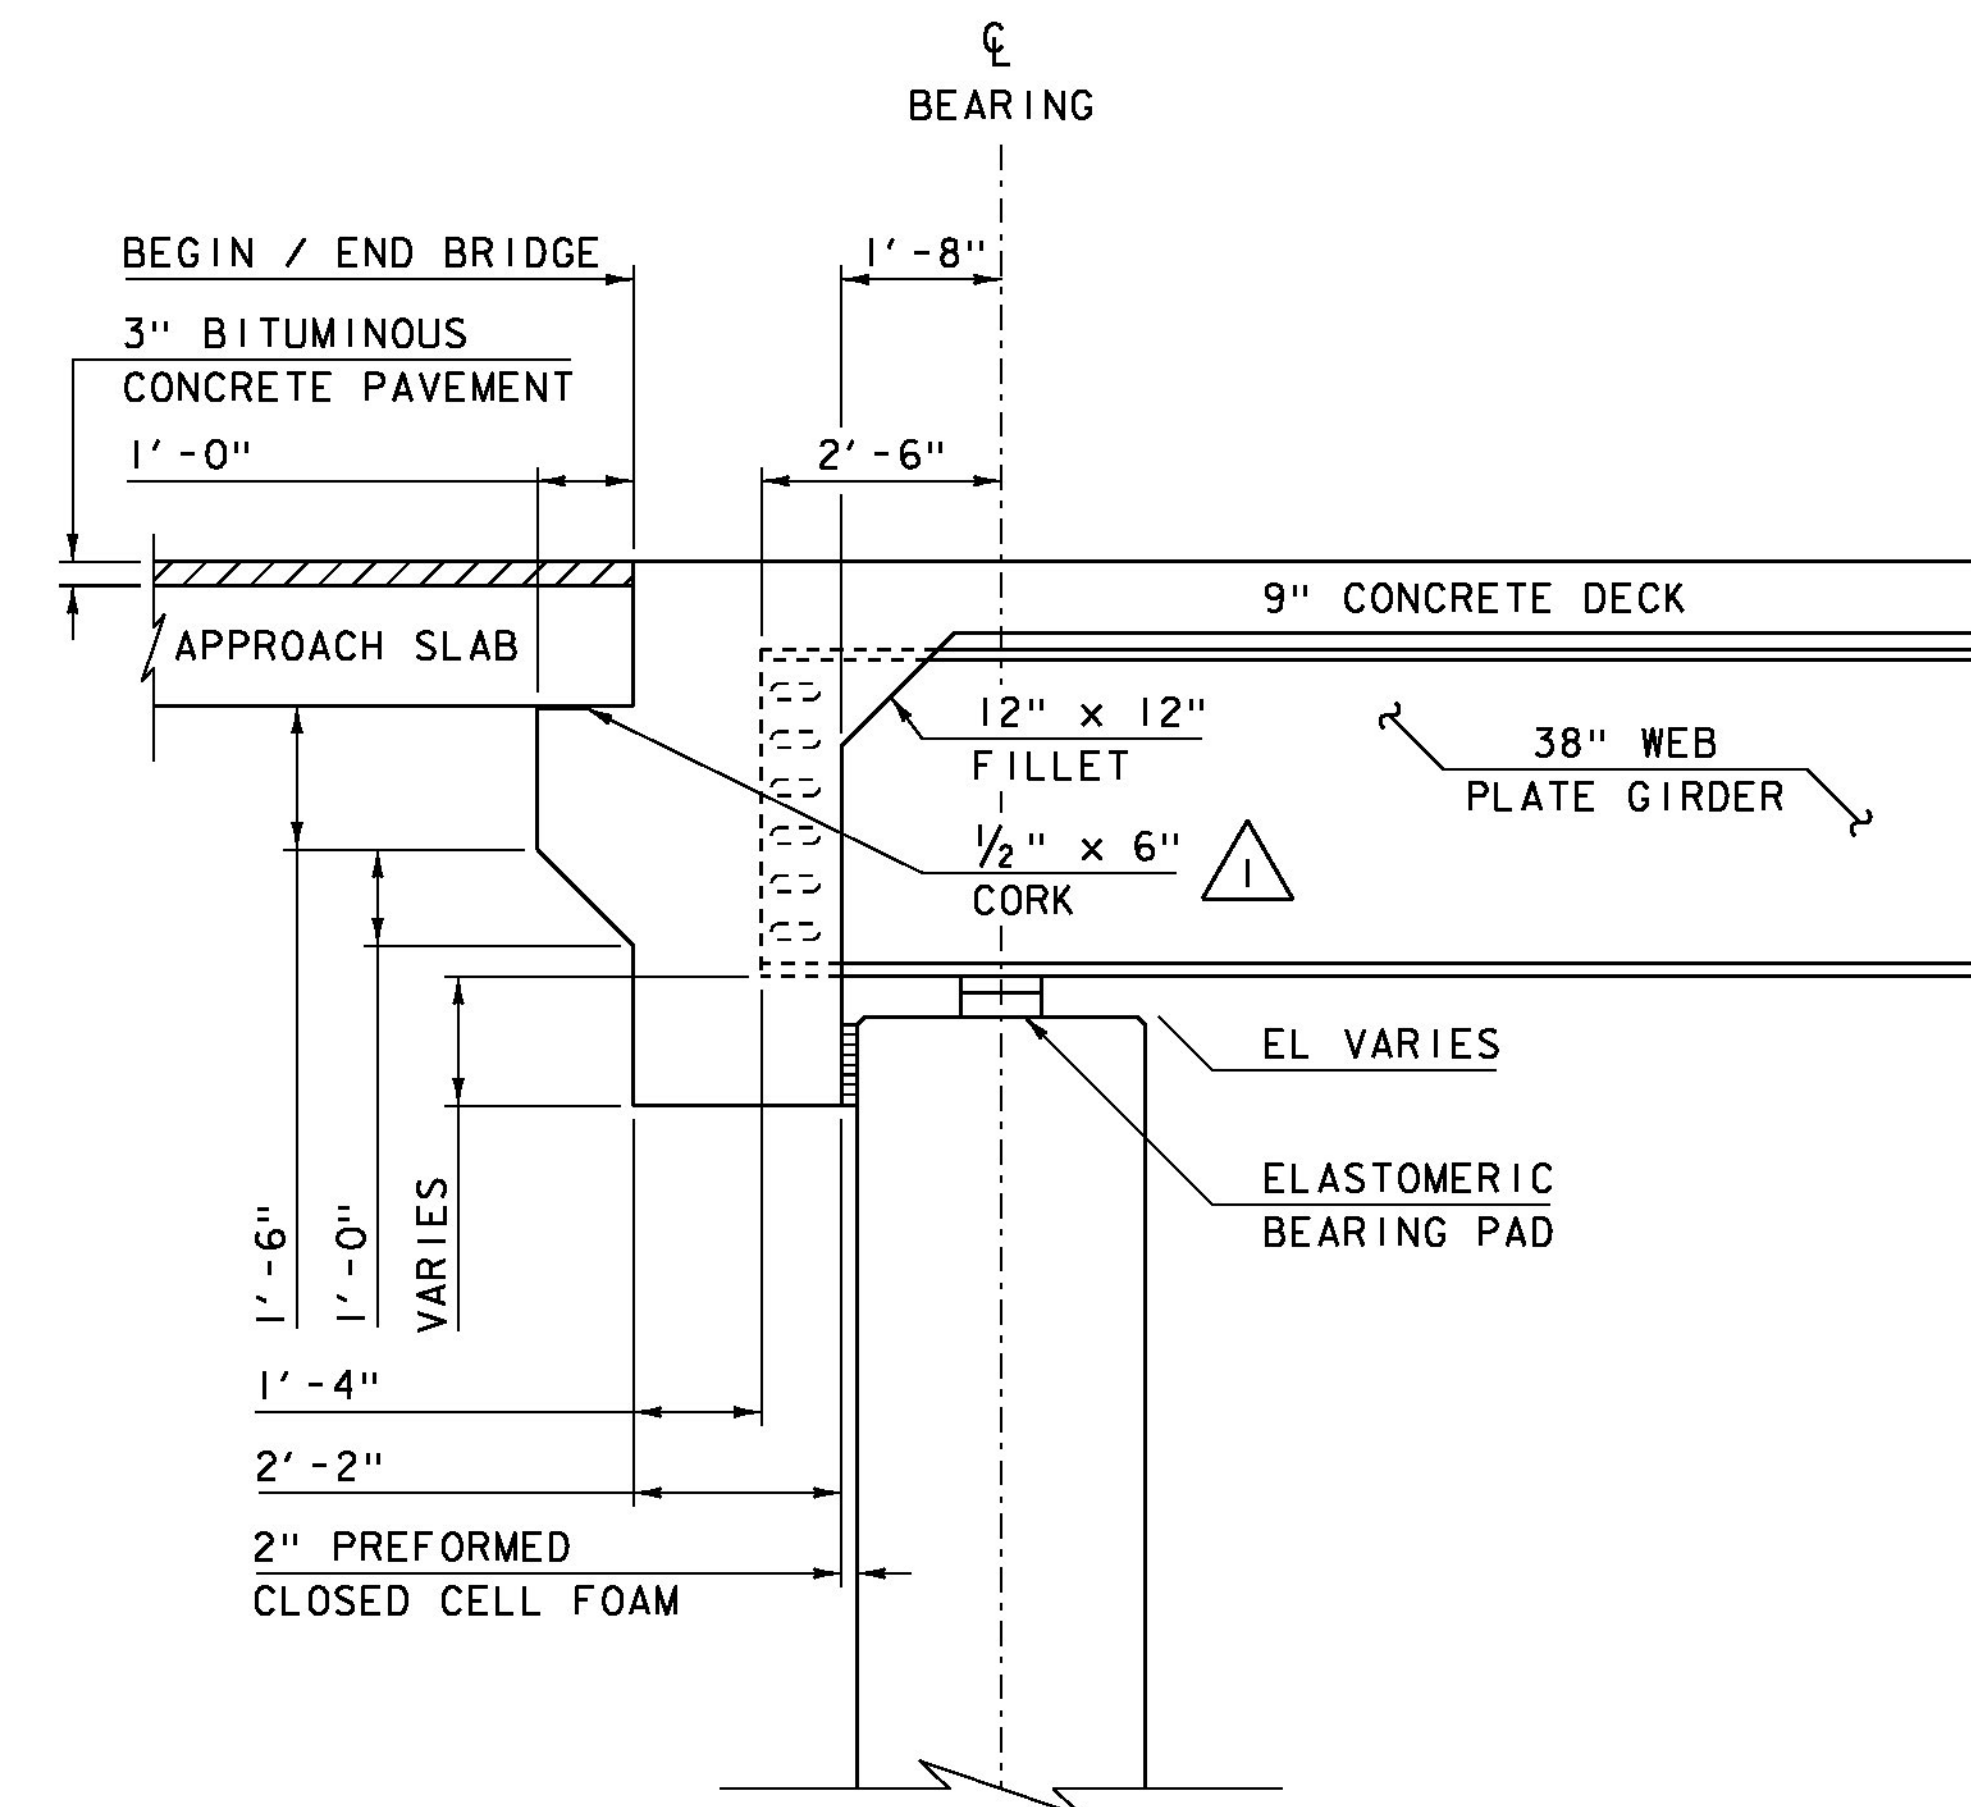

BRIDGE 43N END DETAIL
SCALE 1/2" = 1'-0"

REVISION	DATE	DESCRIPTION	BY
1	01-06-2015	CORK DIMENSION	RK

PROJECT NAME: HARTFORD
PROJECT NUMBER: IM 091-2(79)

FILE NAME: s12a132bridge_end_detail.dgn PLOT DATE: 06-JAN-2015
PROJECT LEADER: K. HIGGINS DRAWN BY: K. FRIEDLAND
DESIGNED BY: R. KLINEFELTER CHECKED BY: J. SALVATORI
SUPERSTRUCTURE TYPICALS 43N SHEET 86 OF 166