


**APPROACH SLAB 1 PLAN**  
SCALE 1/4" = 1'-0"

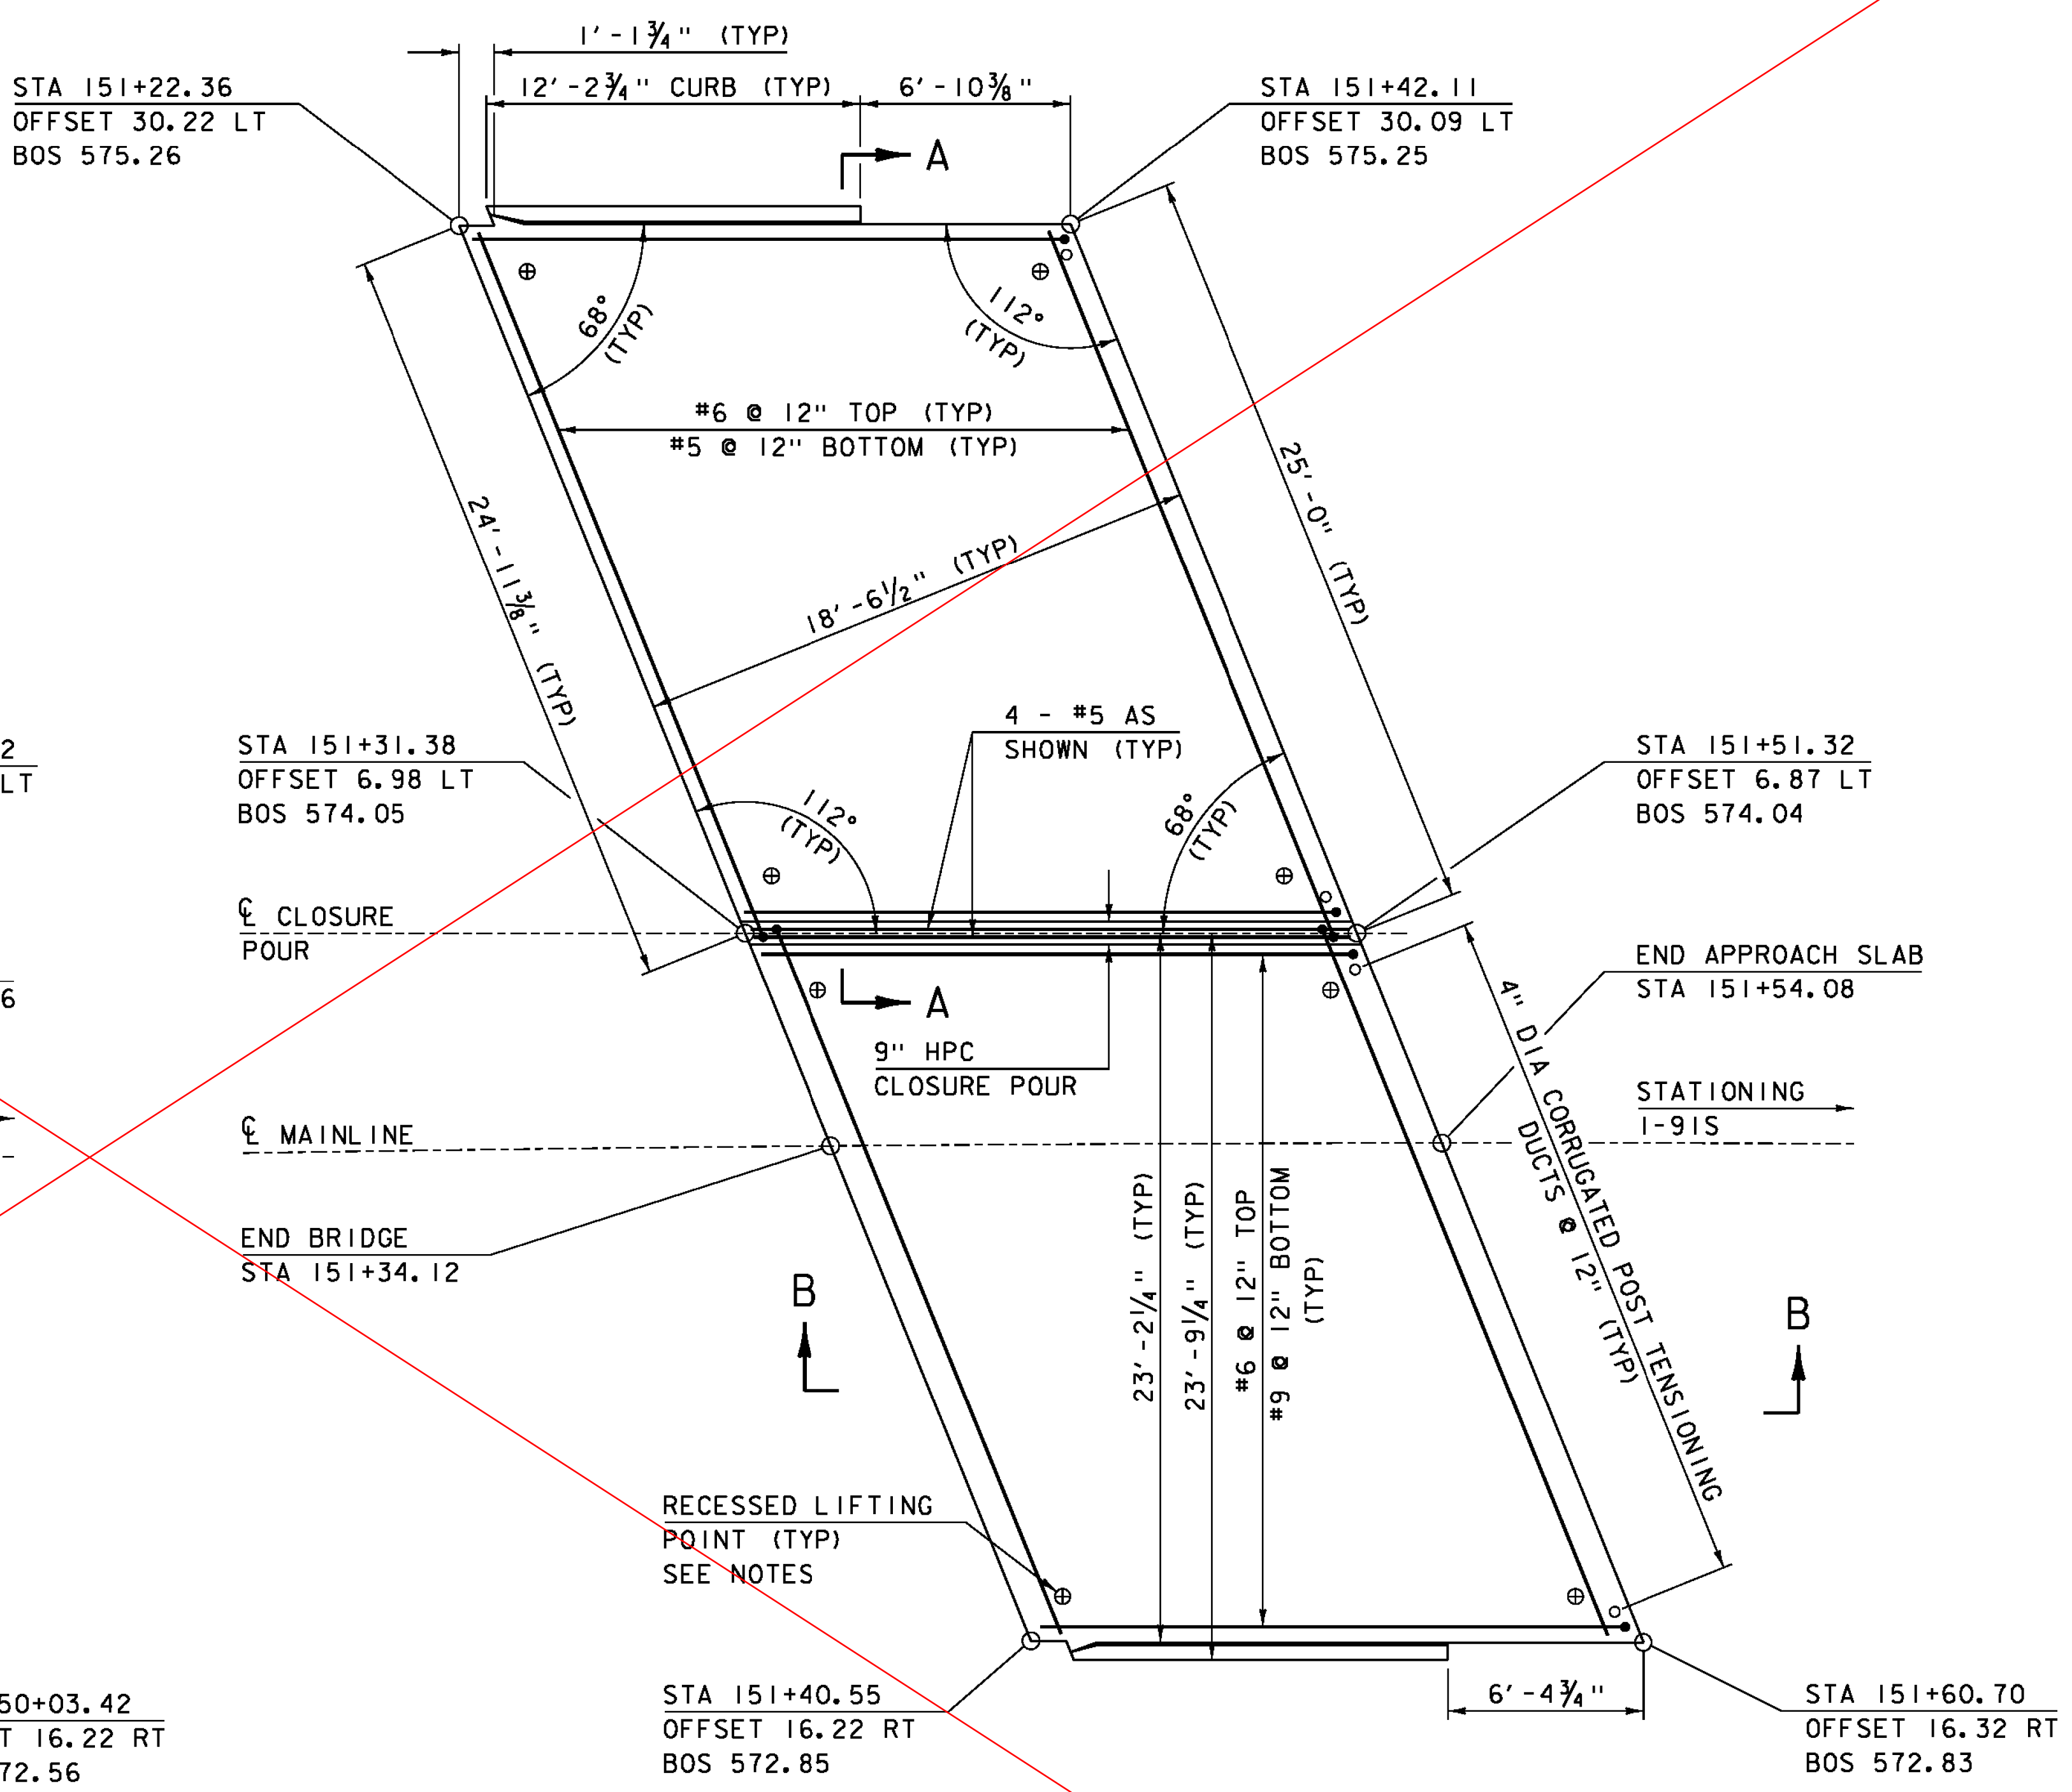

**APPROACH SLAB 2 PLAN**  
SCALE 1/4" = 1'-0"

**NOTES:**

- 1) ALL APPROACH SLAB REINFORCING STEEL SHALL BE LEVEL II OR HIGHER.
- 2) BOS = BOTTOM OF SLAB
- 3) LIFTING POINTS SHALL BE DESIGNED BY OTHERS AND CALCULATIONS INCLUDED WITH SUBMITTAL.

SEE SHEET 97-R

**NOTE:**

NF = NEAR FACE  
 FF = FAR FACE  
 EF = EACH FACE  
 3" CLEAR, UNLESS OTHERWISE SPECIFIED ON THE PLANS.  
 2'-2" BAR LAP UNLESS OTHERWISE SPECIFIED ON THE PLANS.

PROJECT NAME: HARTFORD	PLOT DATE: 15-DEC-2014
PROJECT NUMBER: IM 091-2(79)	DRAWN BY: K. FRIEDLAND
FILE NAME: s12a132apslabs.43S.dgn	CHECKED BY: W. LAMMER
PROJECT LEADER: K. HIGGINS	SHEET 97 OF 166
DESIGNED BY: G. LAROCHE	
APPROACH SLAB DETAILS 43S	