


APPROACH SLAB 1 PLAN  
SCALE 1/4" = 1'-0"

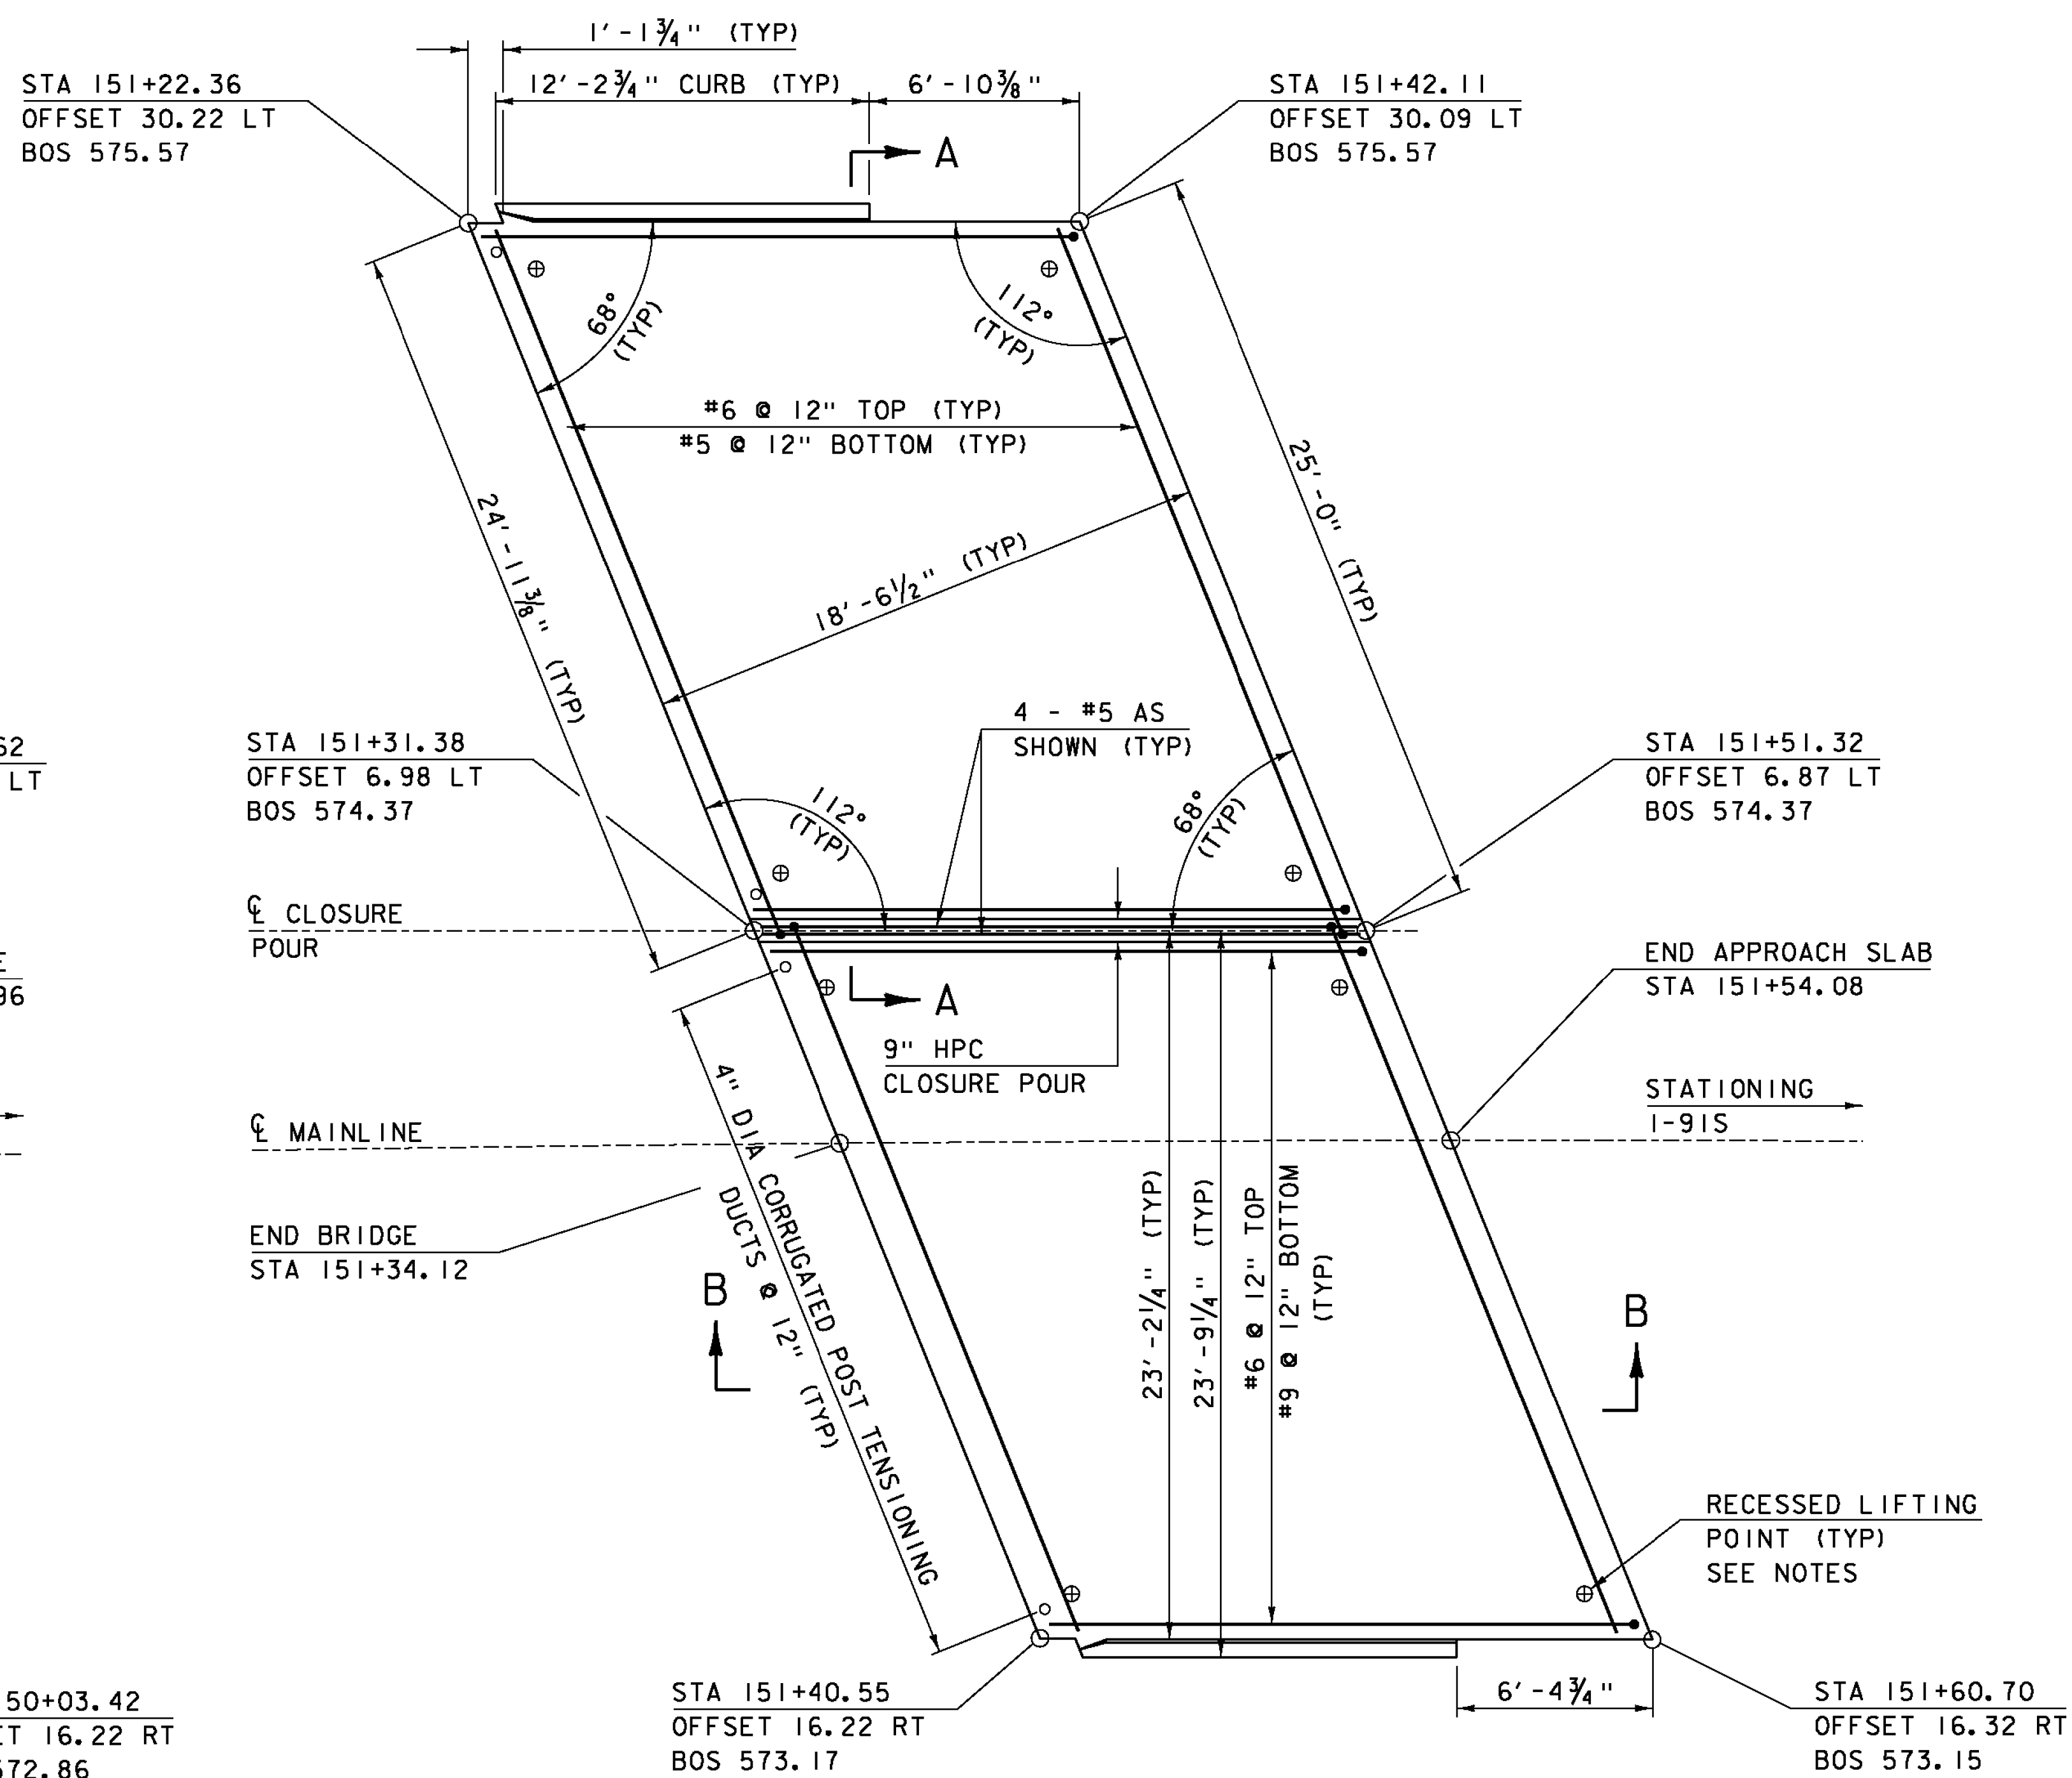

APPROACH SLAB 2 PLAN  
SCALE 1/4" = 1'-0"

NOTES:

- 1) ALL APPROACH SLAB REINFORCING STEEL SHALL BE LEVEL II OR HIGHER.
- 2) BOS = BOTTOM OF SLAB
- 3) LIFTING POINTS SHALL BE DESIGNED BY OTHERS AND CALCULATIONS INCLUDED WITH SUBMITTAL.

NOTE:

NF = NEAR FACE  
 FF = FAR FACE  
 EF = EACH FACE  
 3" CLEAR, UNLESS OTHERWISE SPECIFIED ON THE PLANS.  
 2'-2" BAR LAP UNLESS OTHERWISE SPECIFIED ON THE PLANS.

REVISION	DATE	DESCRIPTION	BY
1	09-09-2015	REVISED DUCT LOCATIONS AND LONGITUDINAL REINFORCING	JTS
2	09-09-2015	REVISED BOS ELEVATIONS	JTS

PROJECT NAME:	HARTFORD	PLOT DATE:	09-SEP-2015
PROJECT NUMBER:	IM 091-2(79)	DRAWN BY:	K. FRIEDLAND
FILE NAME:	sl20132opslabs_43S.dgn	DESIGNED BY:	G. LAROCHE
APPROACH SLAB DETAILS 43S		CHECKED BY:	W. LAMMER
			SHEET 97R OF 166