
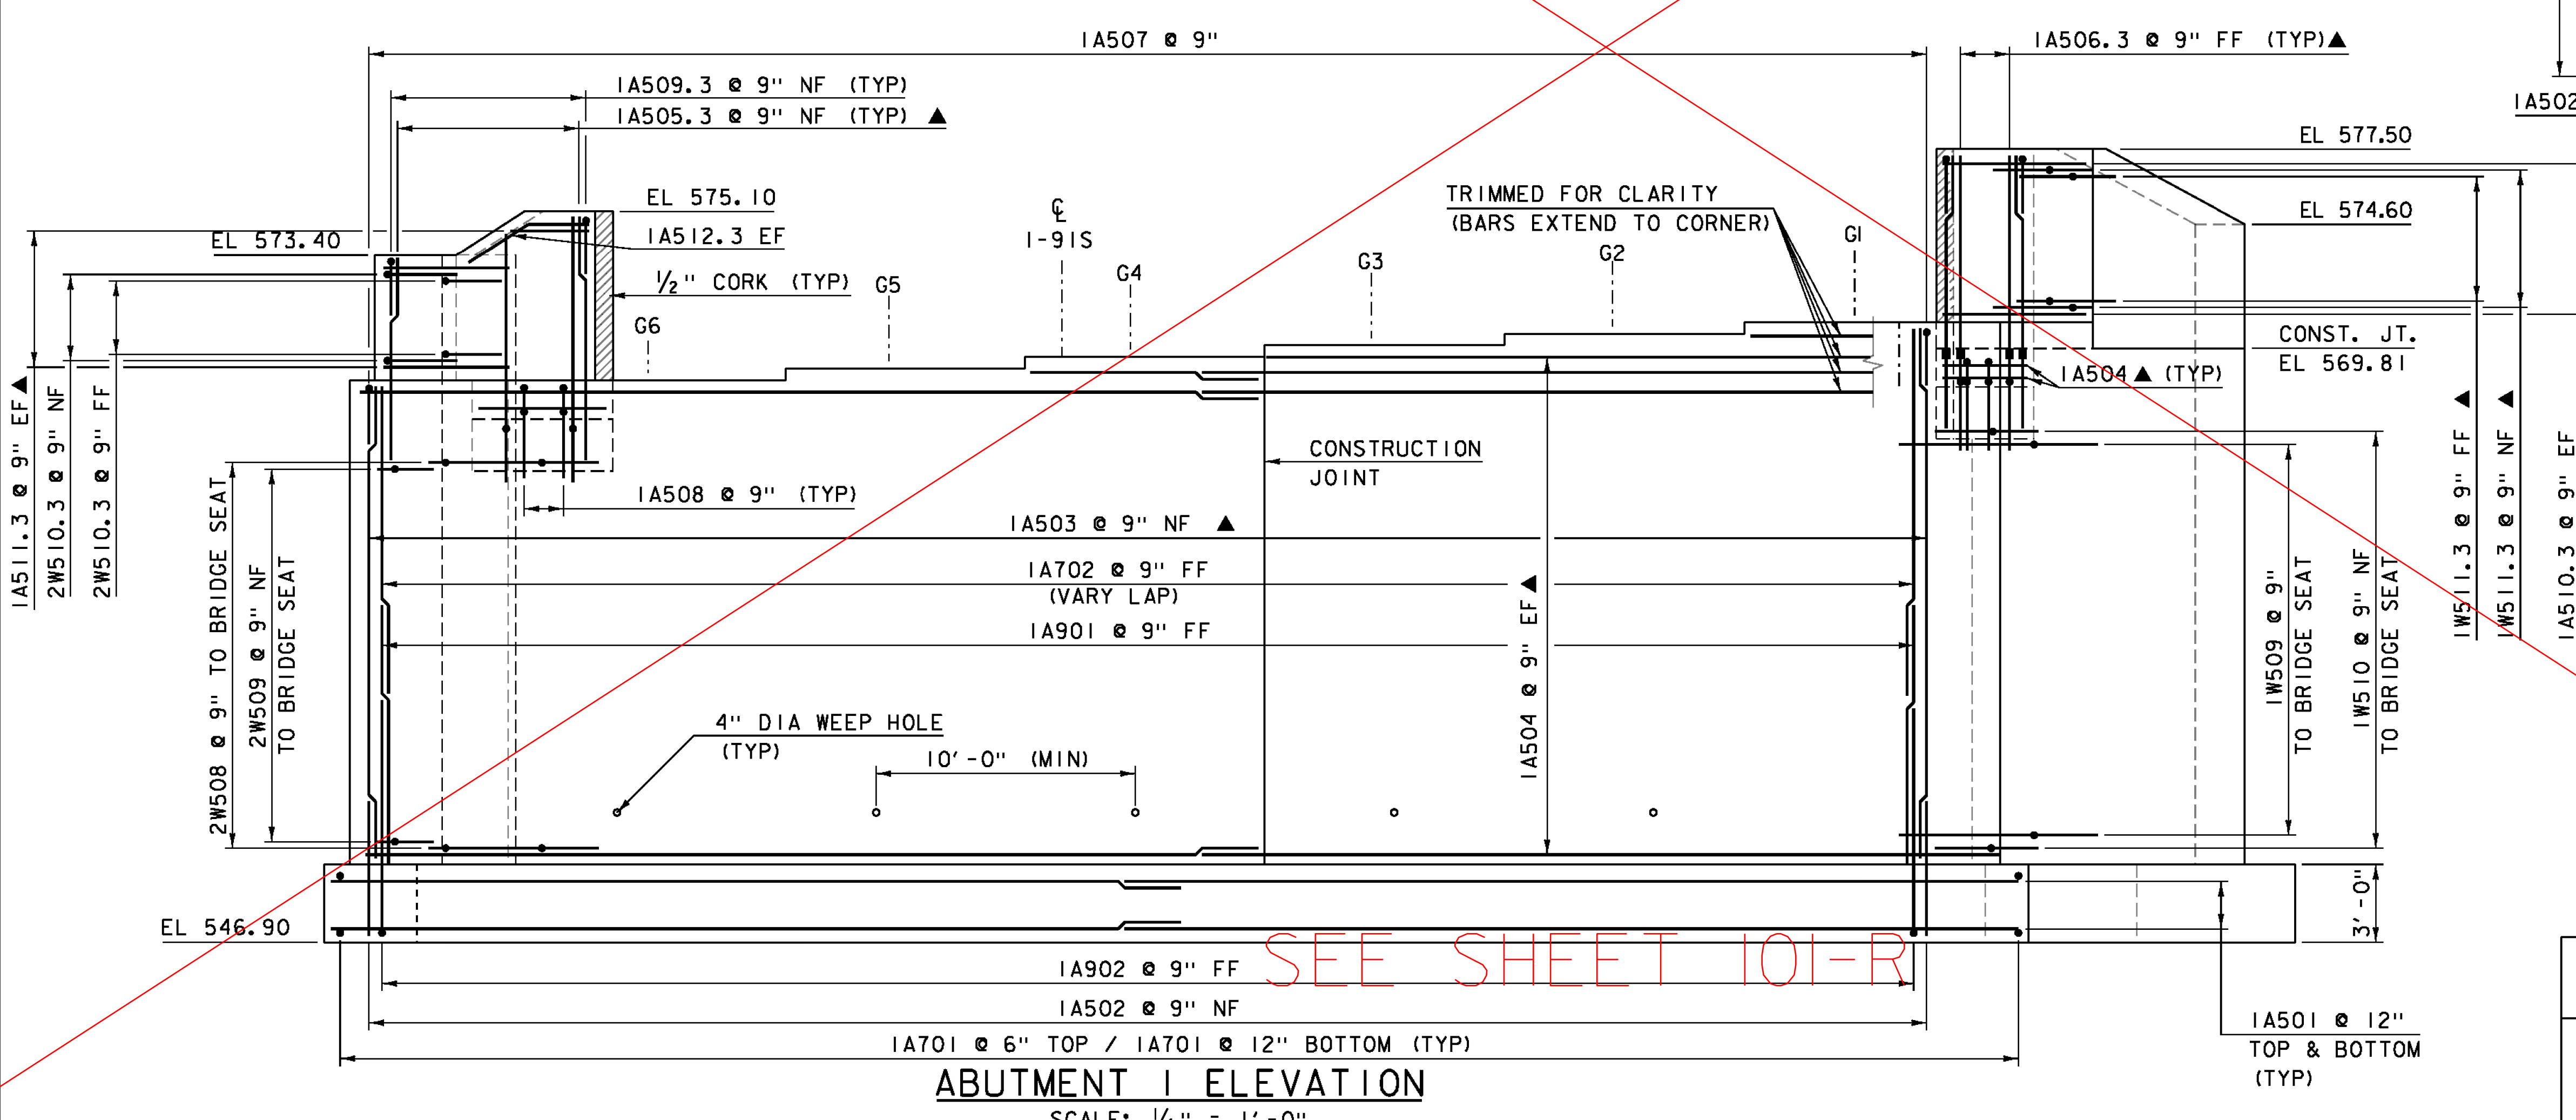
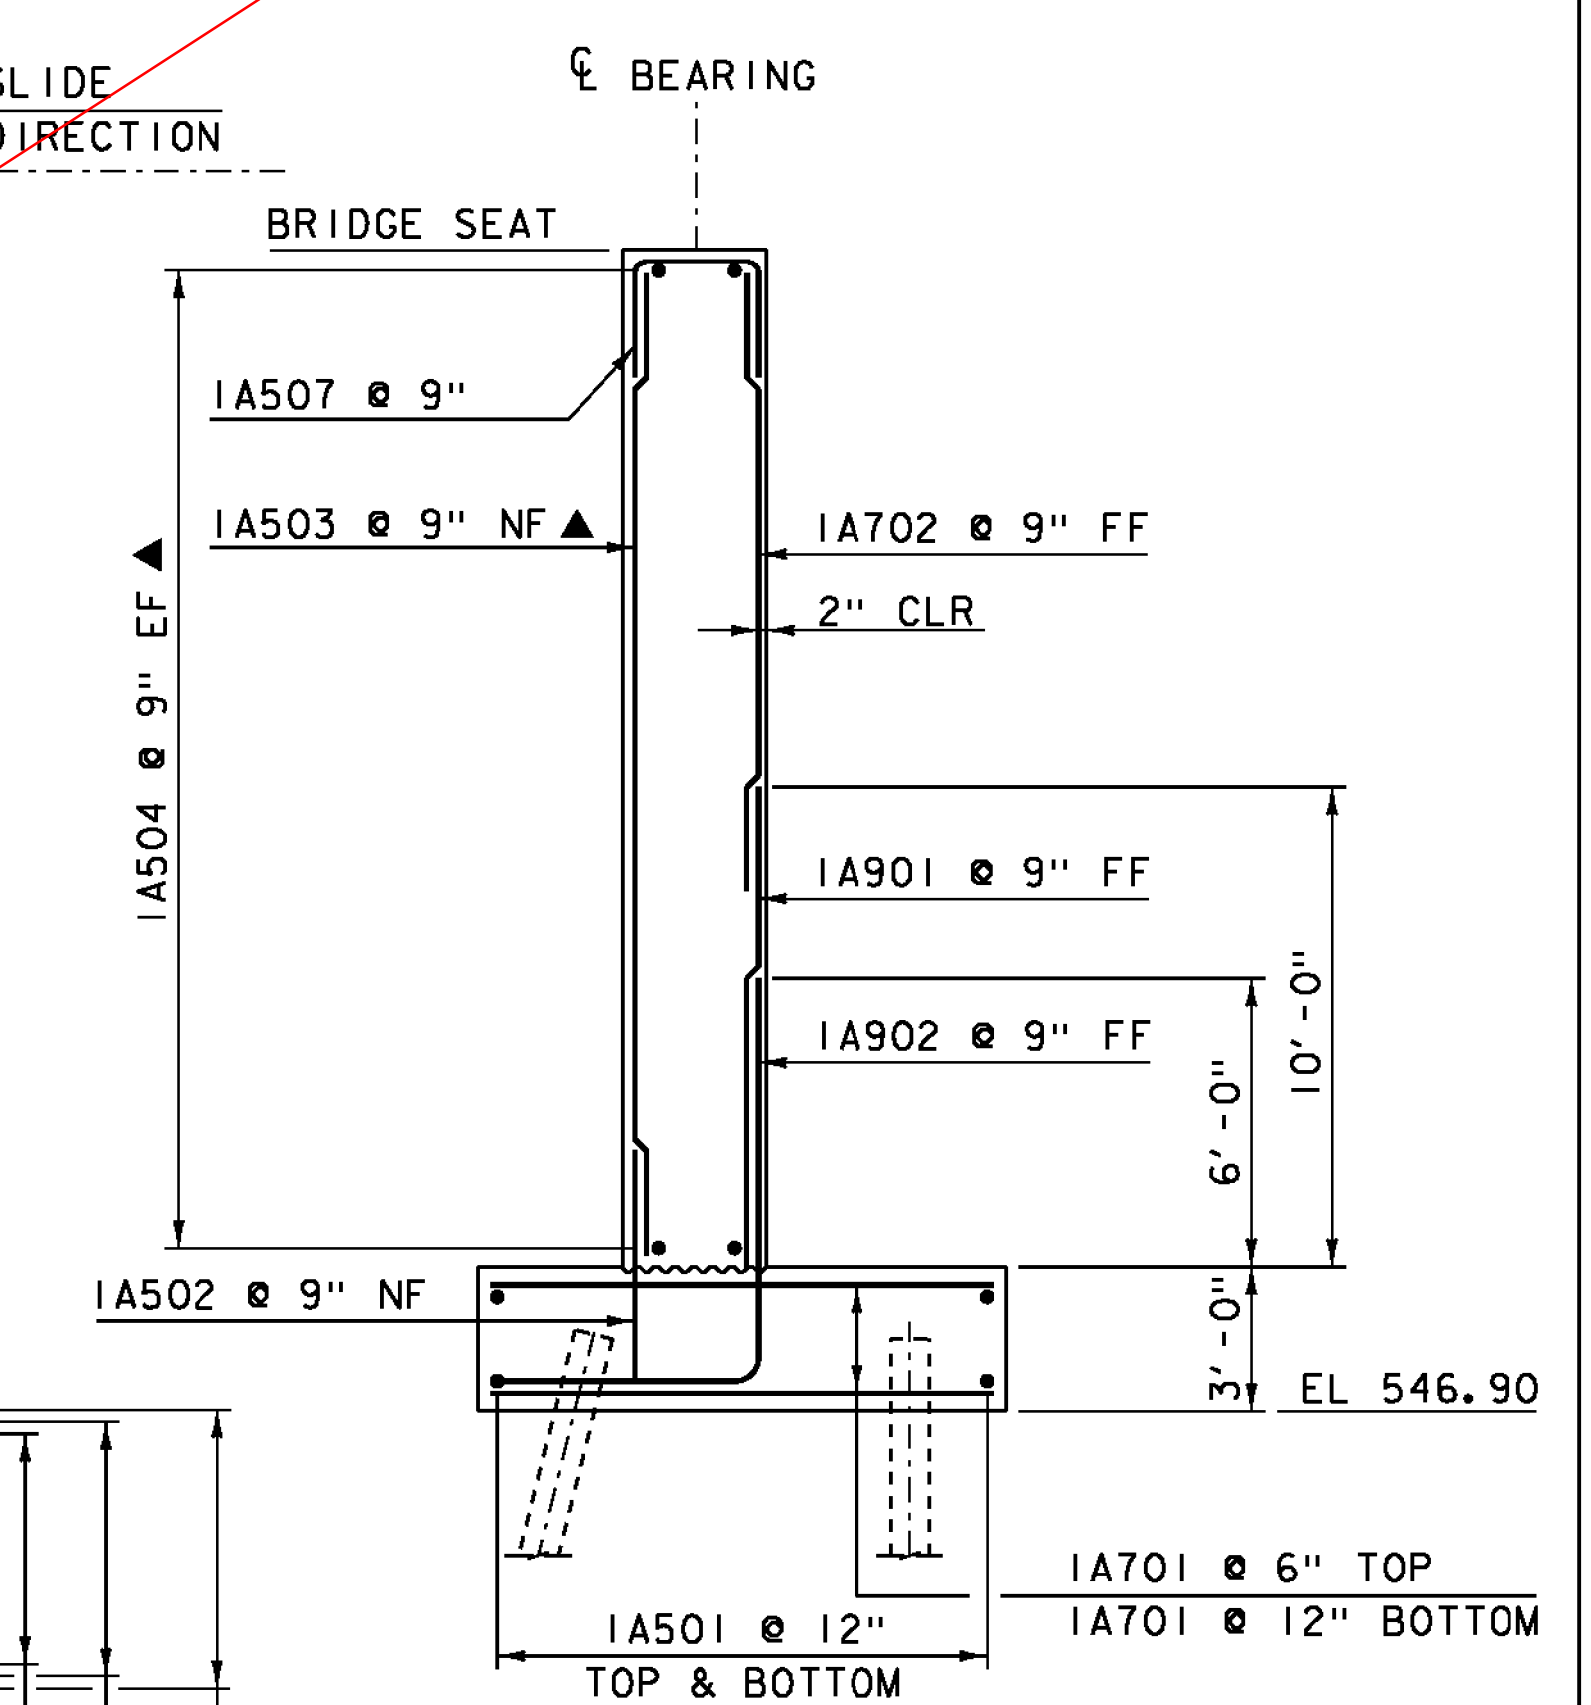


BRIDGE SEAT ELEVATIONS

GIRDER	ELEVATION
G1	570.81
G2	570.37
G3	569.92
G4	569.47
G5	569.03
G6	568.58

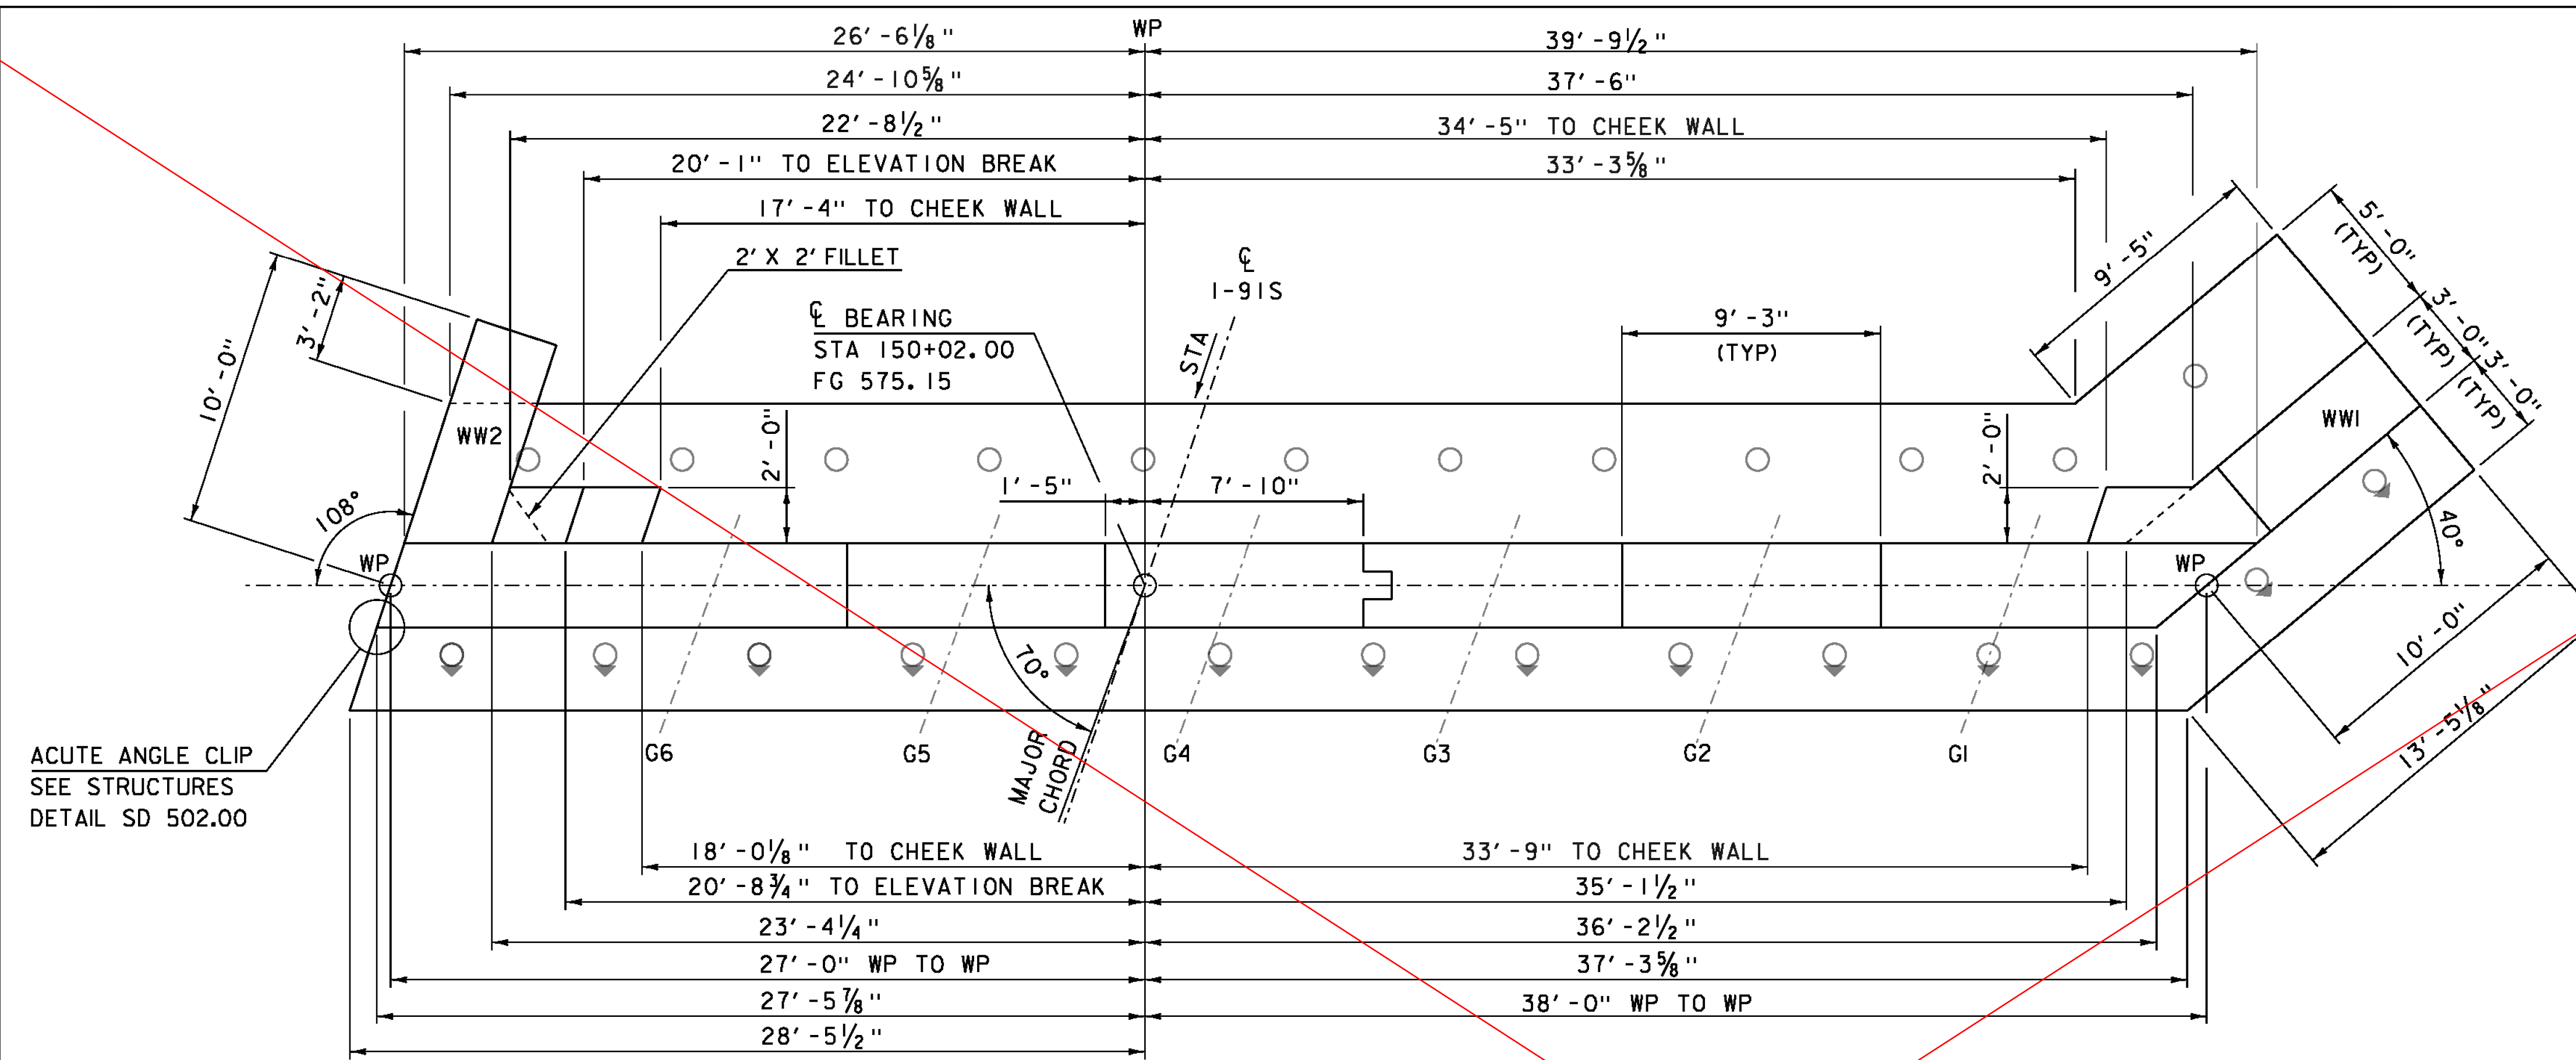

NOTE:

- NF = NEAR FACE
- FF = FAR FACE
- EF = EACH FACE
- ▲ = CUT TO FIT IN FIELD
- = MECHANICAL CONNECTOR
- 3" CLEAR, UNLESS OTHERWISE SPECIFIED ON THE PLANS.
- 2'-2" LAP FOR #5 BAR
- 2'-7" LAP FOR #6 BAR
- 3'-5" LAP FOR #7 BAR
- 4'-6" LAP FOR #8 BAR

SEE SHEET 101-R

PROJECT NAME:	HARFORD	PLOT DATE:	15-DEC-2014
PROJECT NUMBER:	IM 091-2(79)	DRAWN BY:	J. SALVATORI
FILE NAME:	sl20132sub.abl.dgn	CHECKED BY:	G. LAROCHE
DESIGNED BY:	G. LAROCHE	SHEET	101 OF 166
ABUTMENT I			