

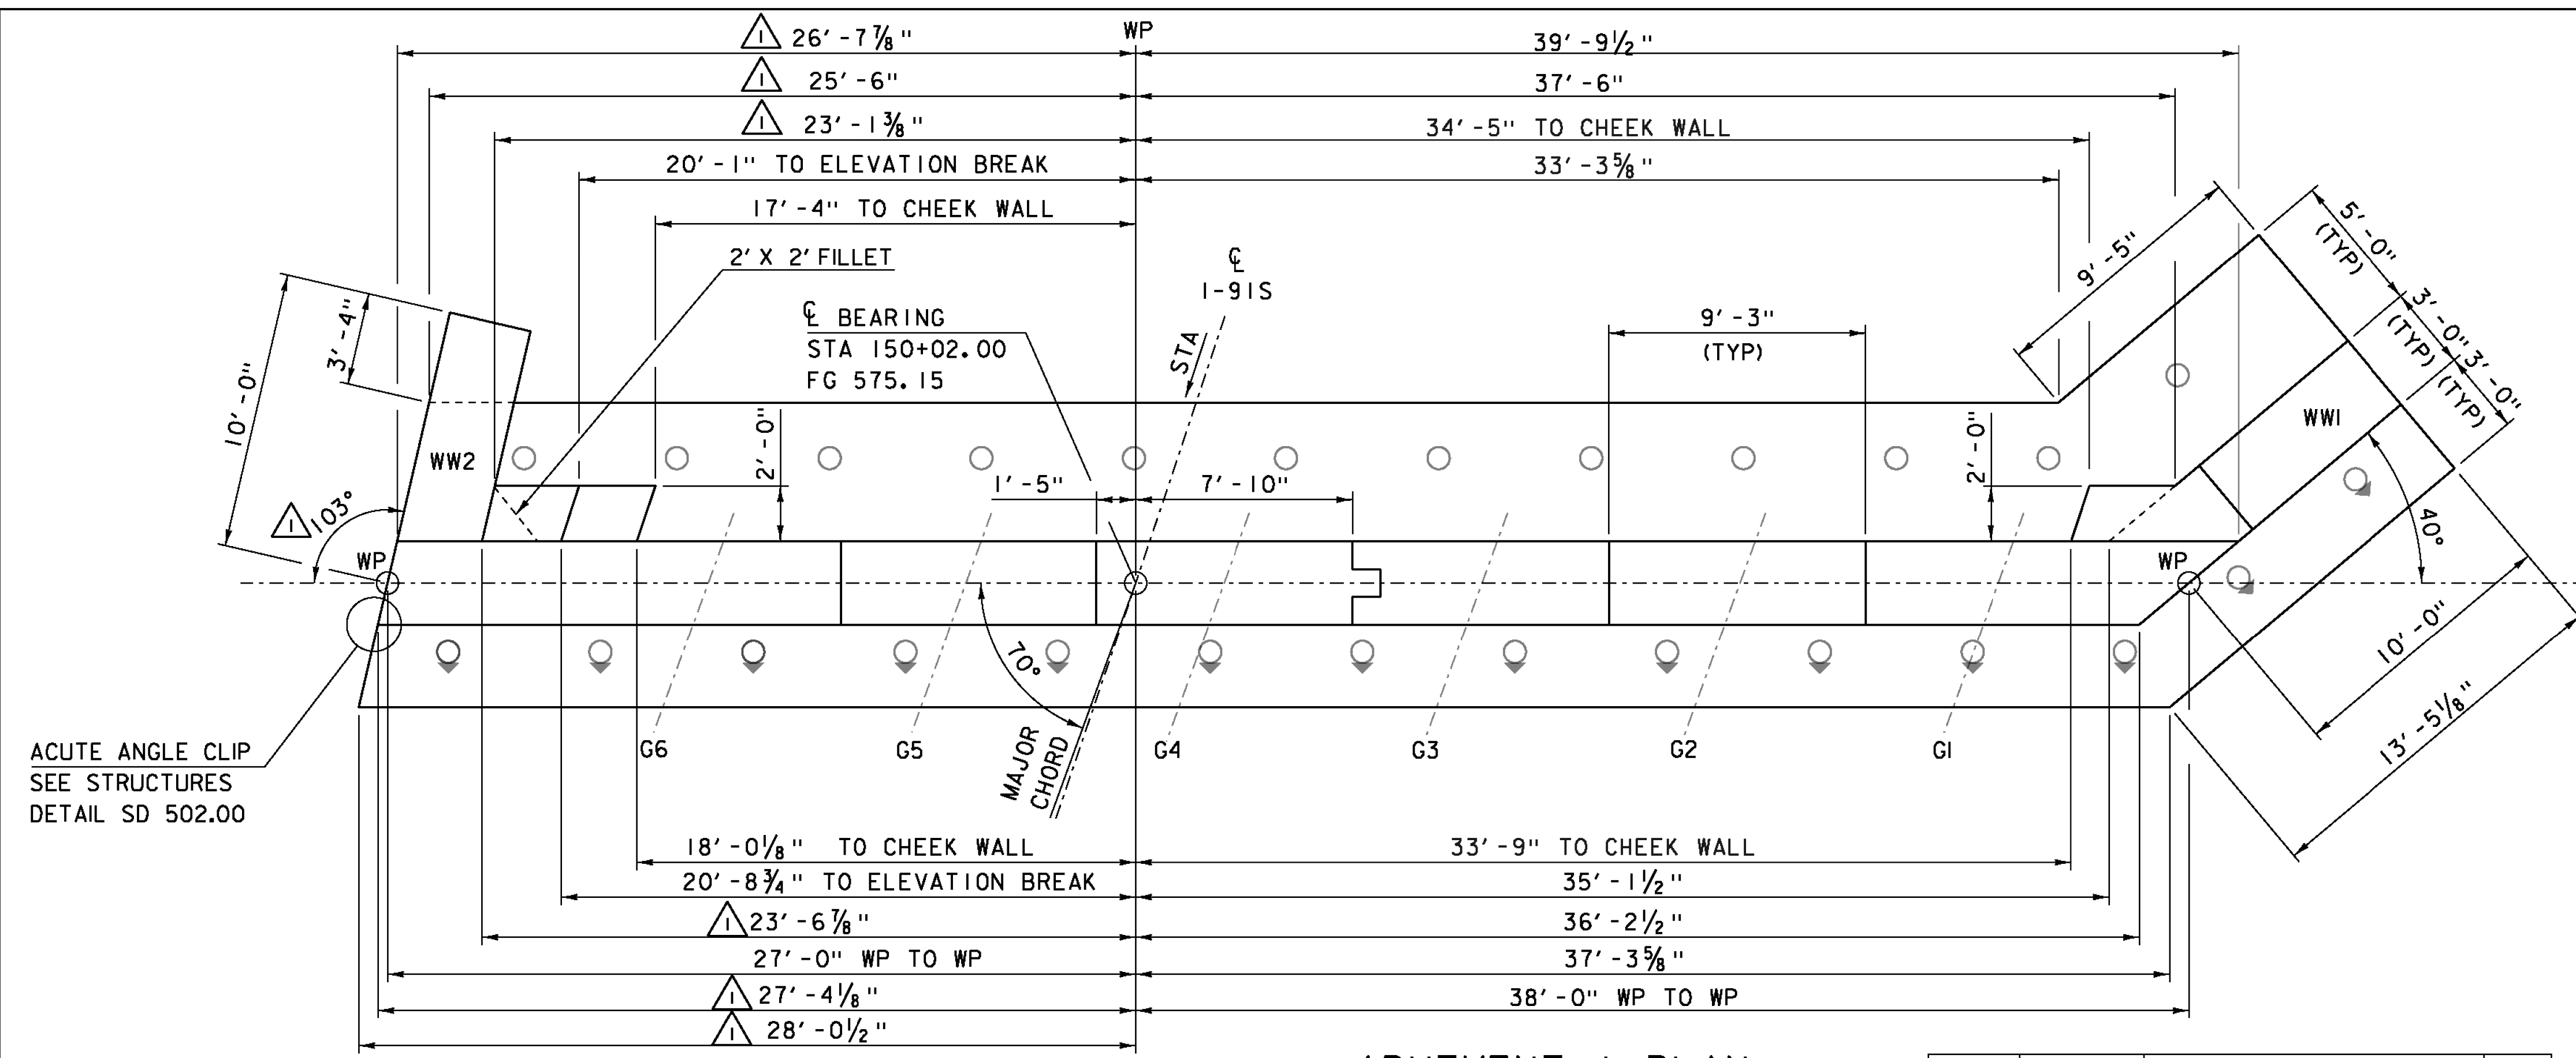


BRIDGE SEAT ELEVATIONS

GIRDER	ELEVATION
G1	570.81
G2	570.37
G3	569.92
G4	569.47
G5	569.03
G6	568.58

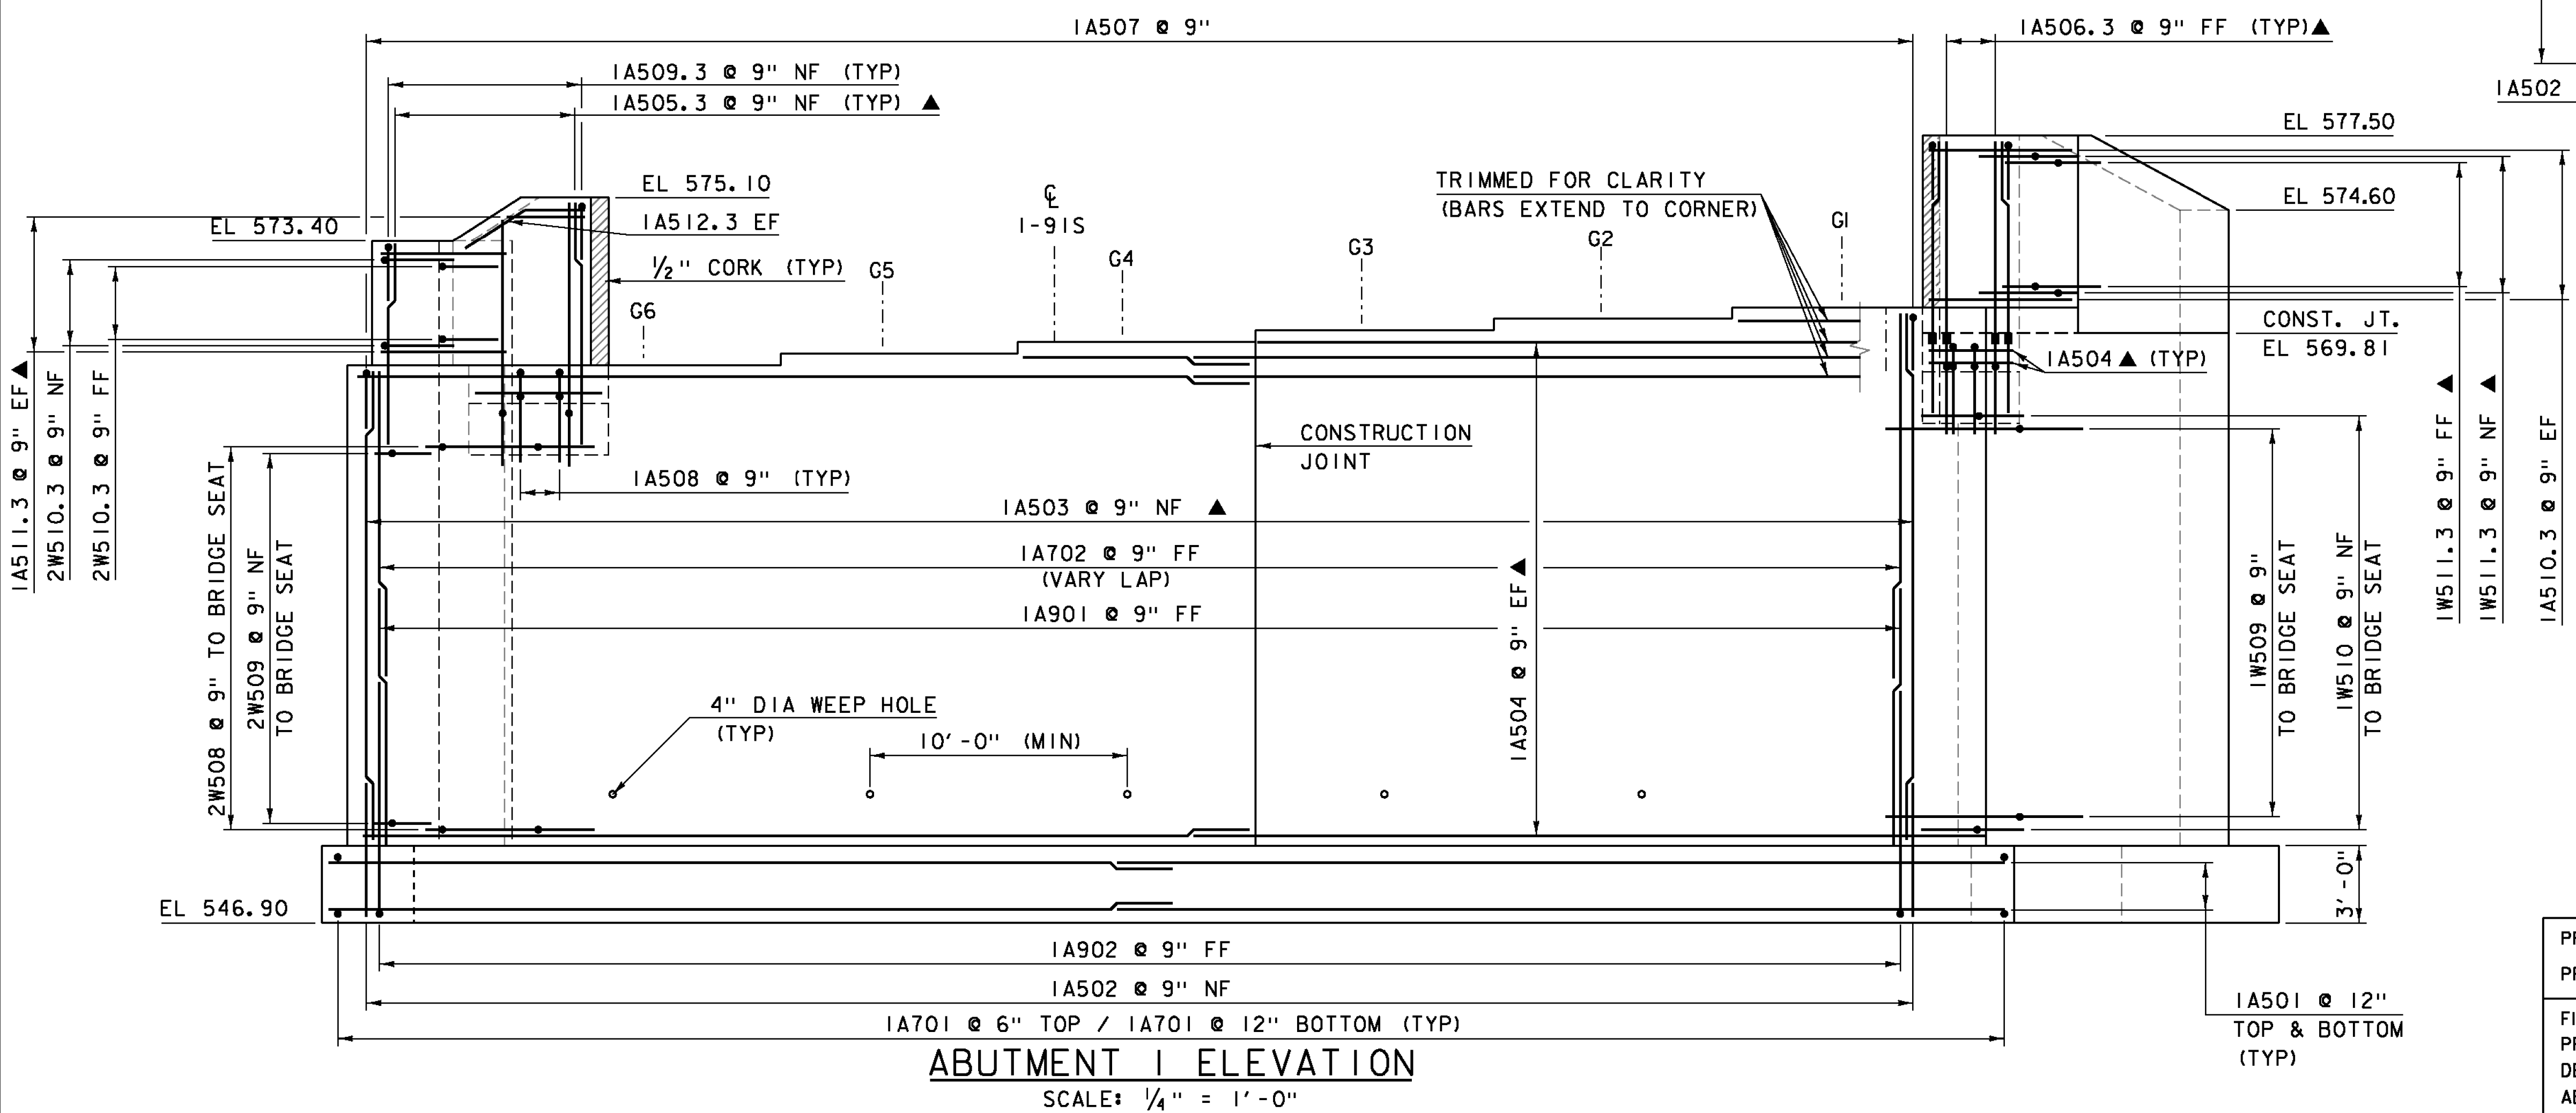

REVISION	DATE	DESCRIPTION	BY
1	04-23-2015	WINGWALL 2 ROTATED 5 DEGREES	JS

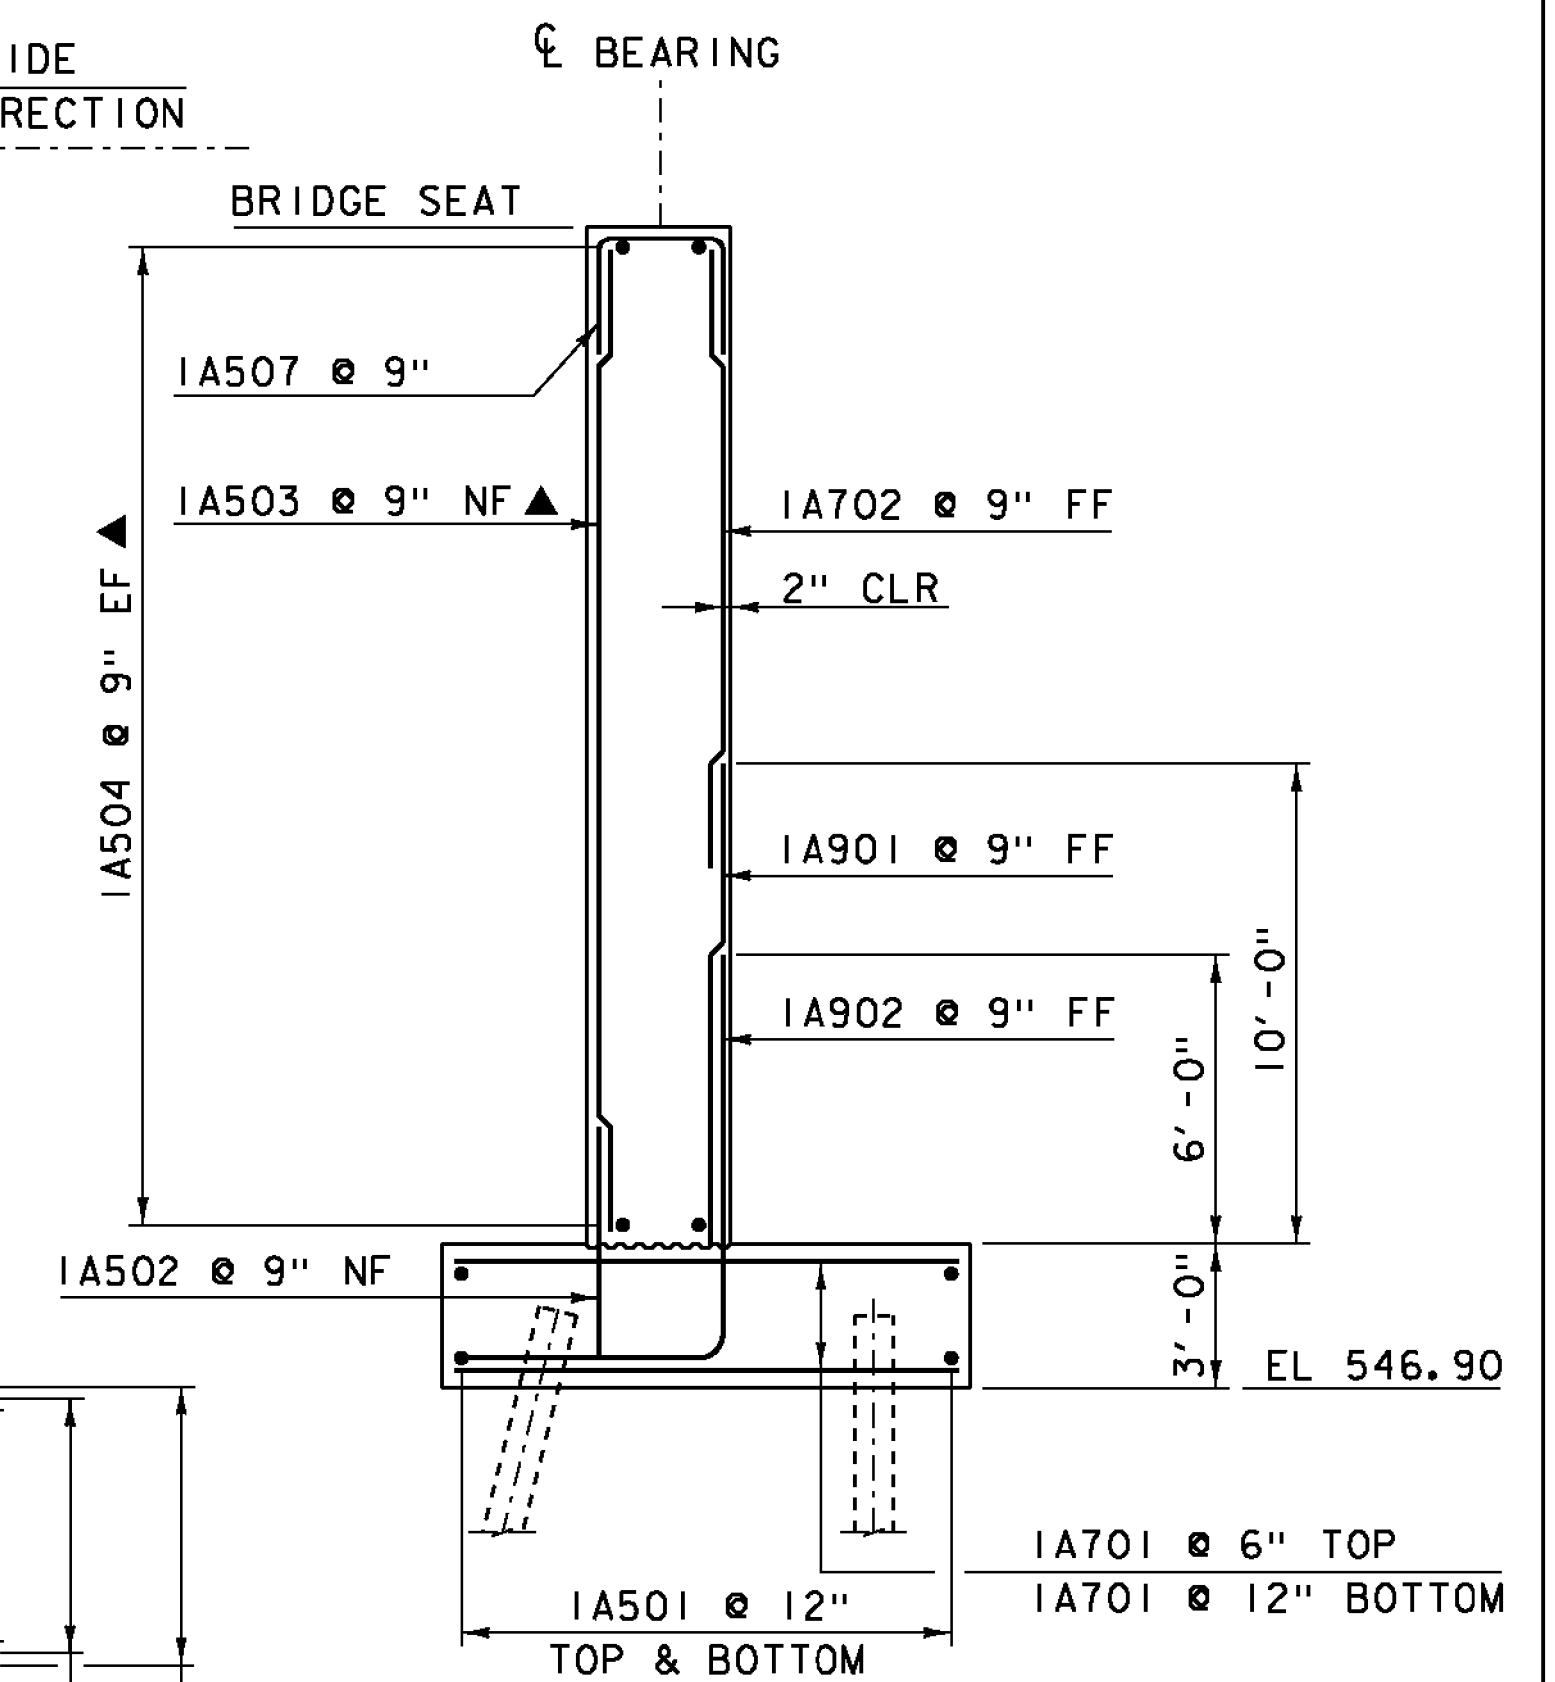

NOTE:
 NF = NEAR FACE
 FF = FAR FACE
 EF = EACH FACE
 ▲ = CUT TO FIT IN FIELD
 ■ = MECHANICAL CONNECTOR
 3" CLEAR, UNLESS OTHERWISE SPECIFIED ON THE PLANS.
 2'-2" LAP FOR #5 BAR
 2'-7" LAP FOR #6 BAR
 3'-5" LAP FOR #7 BAR
 4'-6" LAP FOR #8 BAR

PROJECT NAME:	HARFORD	PLOT DATE:	23-APR-2015
PROJECT NUMBER:	IM 091-2(79)	DRAWN BY:	J. SALVATORI
FILE NAME:	sl20132sub.abl.dgn	CHECKED BY:	G. LAROCHE
DESIGNED BY:	G. LAROCHE	SHEET	101R OF 166