


WINGWALL I ELEVATION

SCALE: 1/2" = 1'-0"

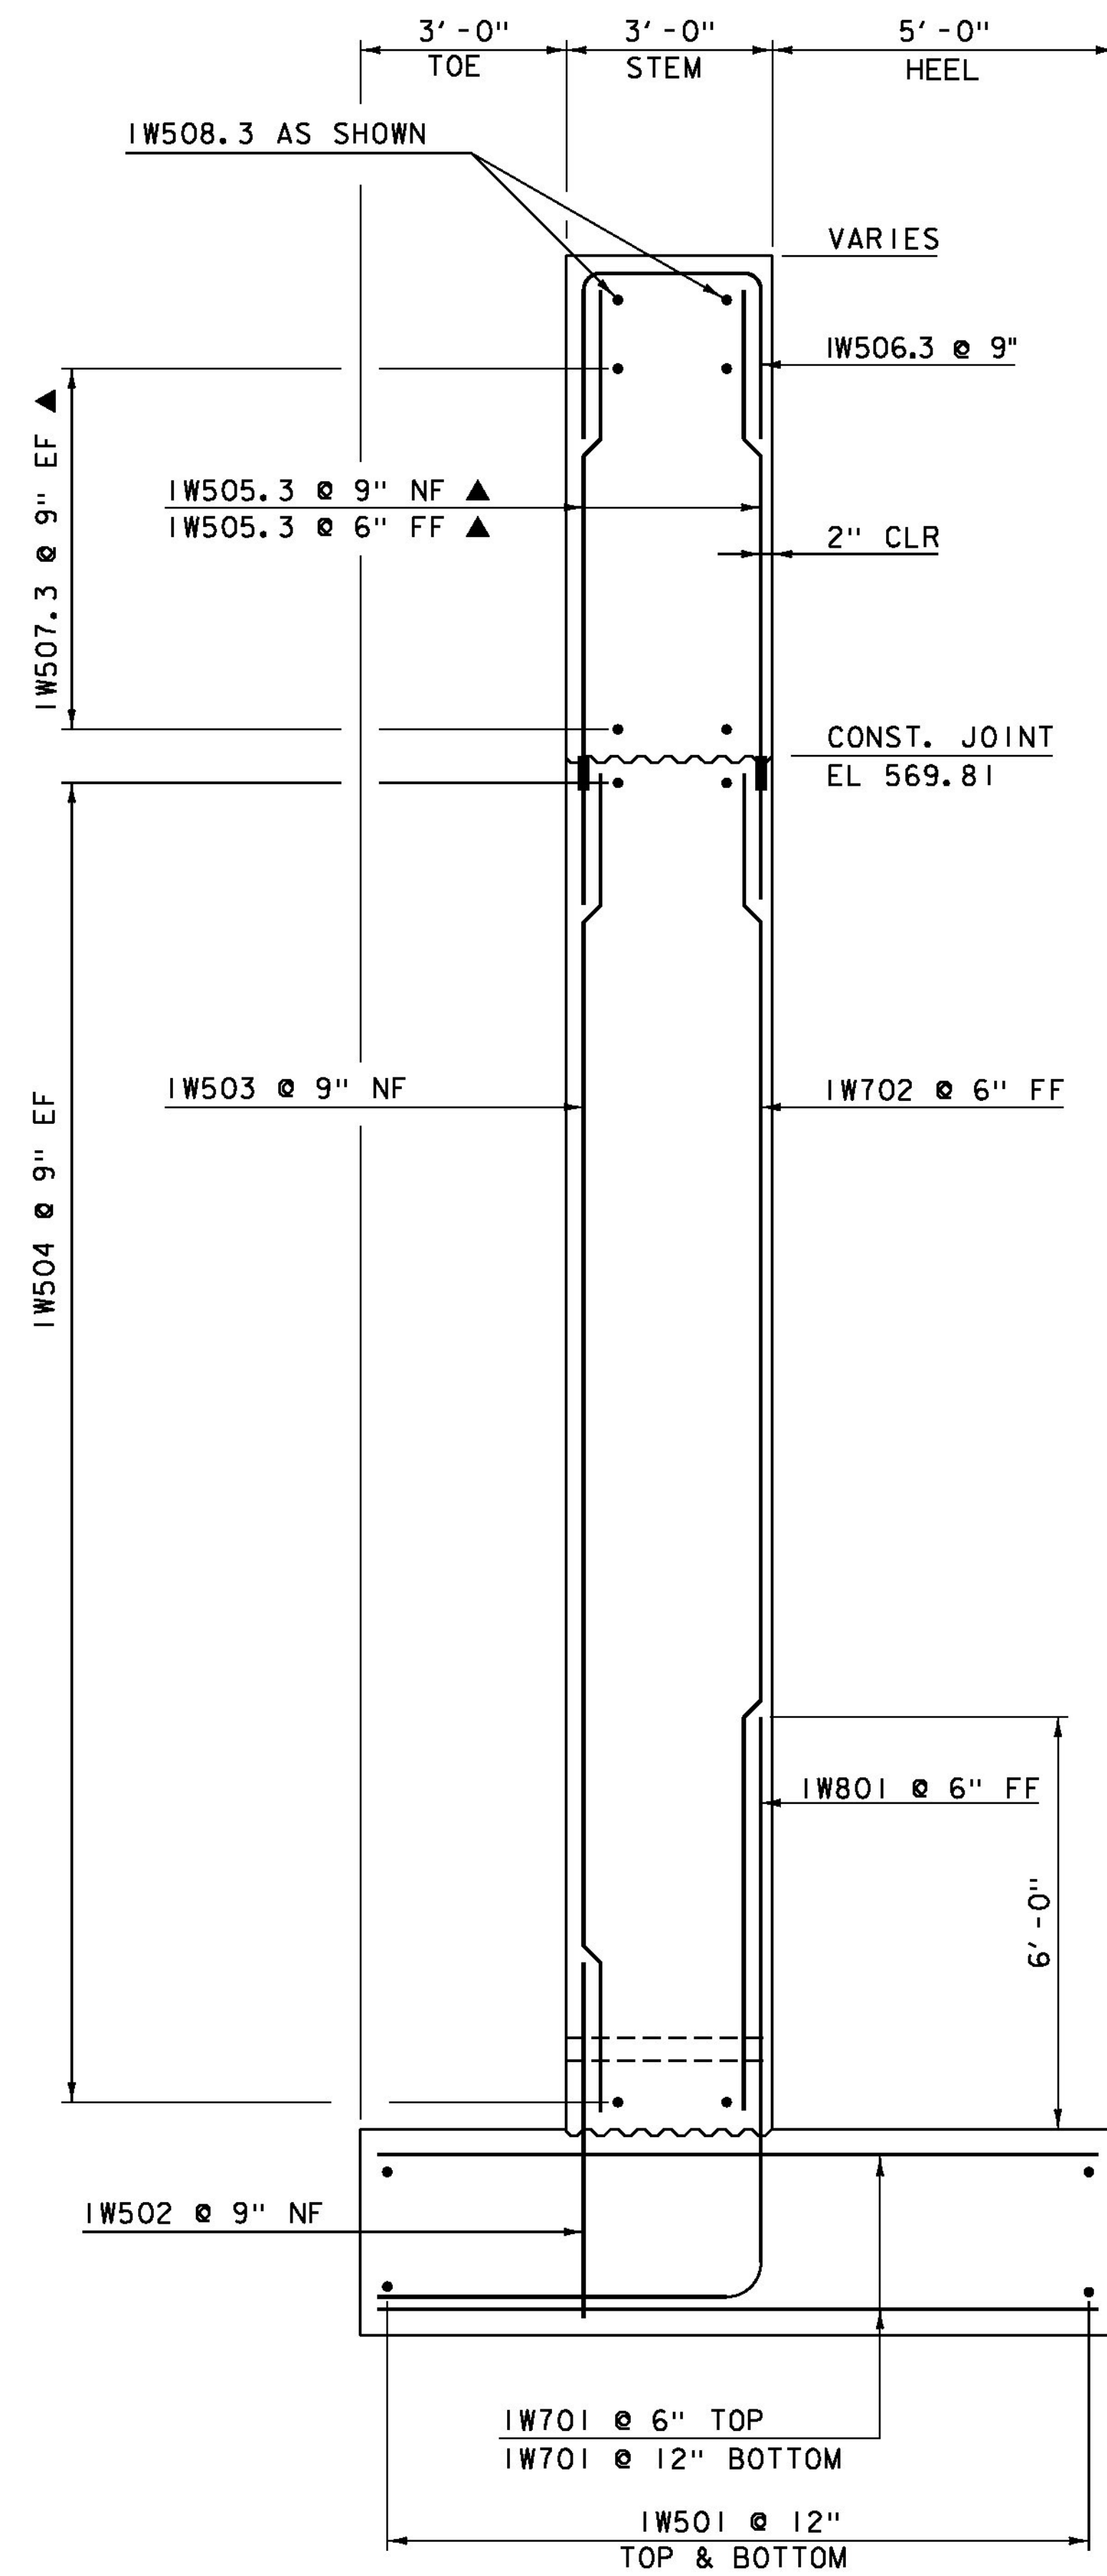

WINGWALL I TYPICAL

SCALE: 1/2" = 1'-0"

NOTE:

- NF = NEAR FACE
- FF = FAR FACE
- EF = EACH FACE
- ▲ = CUT TO FIT IN FIELD
- = MECHANICAL CONNECTOR
- 3" CLEAR, UNLESS OTHERWISE SPECIFIED ON THE PLANS.
- 2'-2" LAP FOR #5 BAR
- 2'-7" LAP FOR #6 BAR
- 3'-5" LAP FOR #7 BAR
- 4'-6" LAP FOR #8 BAR

PROJECT NAME: HARTFORD
 PROJECT NUMBER: IM 091-2(79)

FILE NAME: s12a132sub_abl.dgn
 PROJECT LEADER: K. HIGGINS
 DESIGNED BY: G. LAROCHE
 WINGWALL I DETAILS

PLOT DATE: 15-DEC-2014
 DRAWN BY: J. SALVATORI
 CHECKED BY: G. LAROCHE
 SHEET 103 OF 166