


WINGWALL 2 TYPICAL
SCALE: 1/2" = 1'-0"

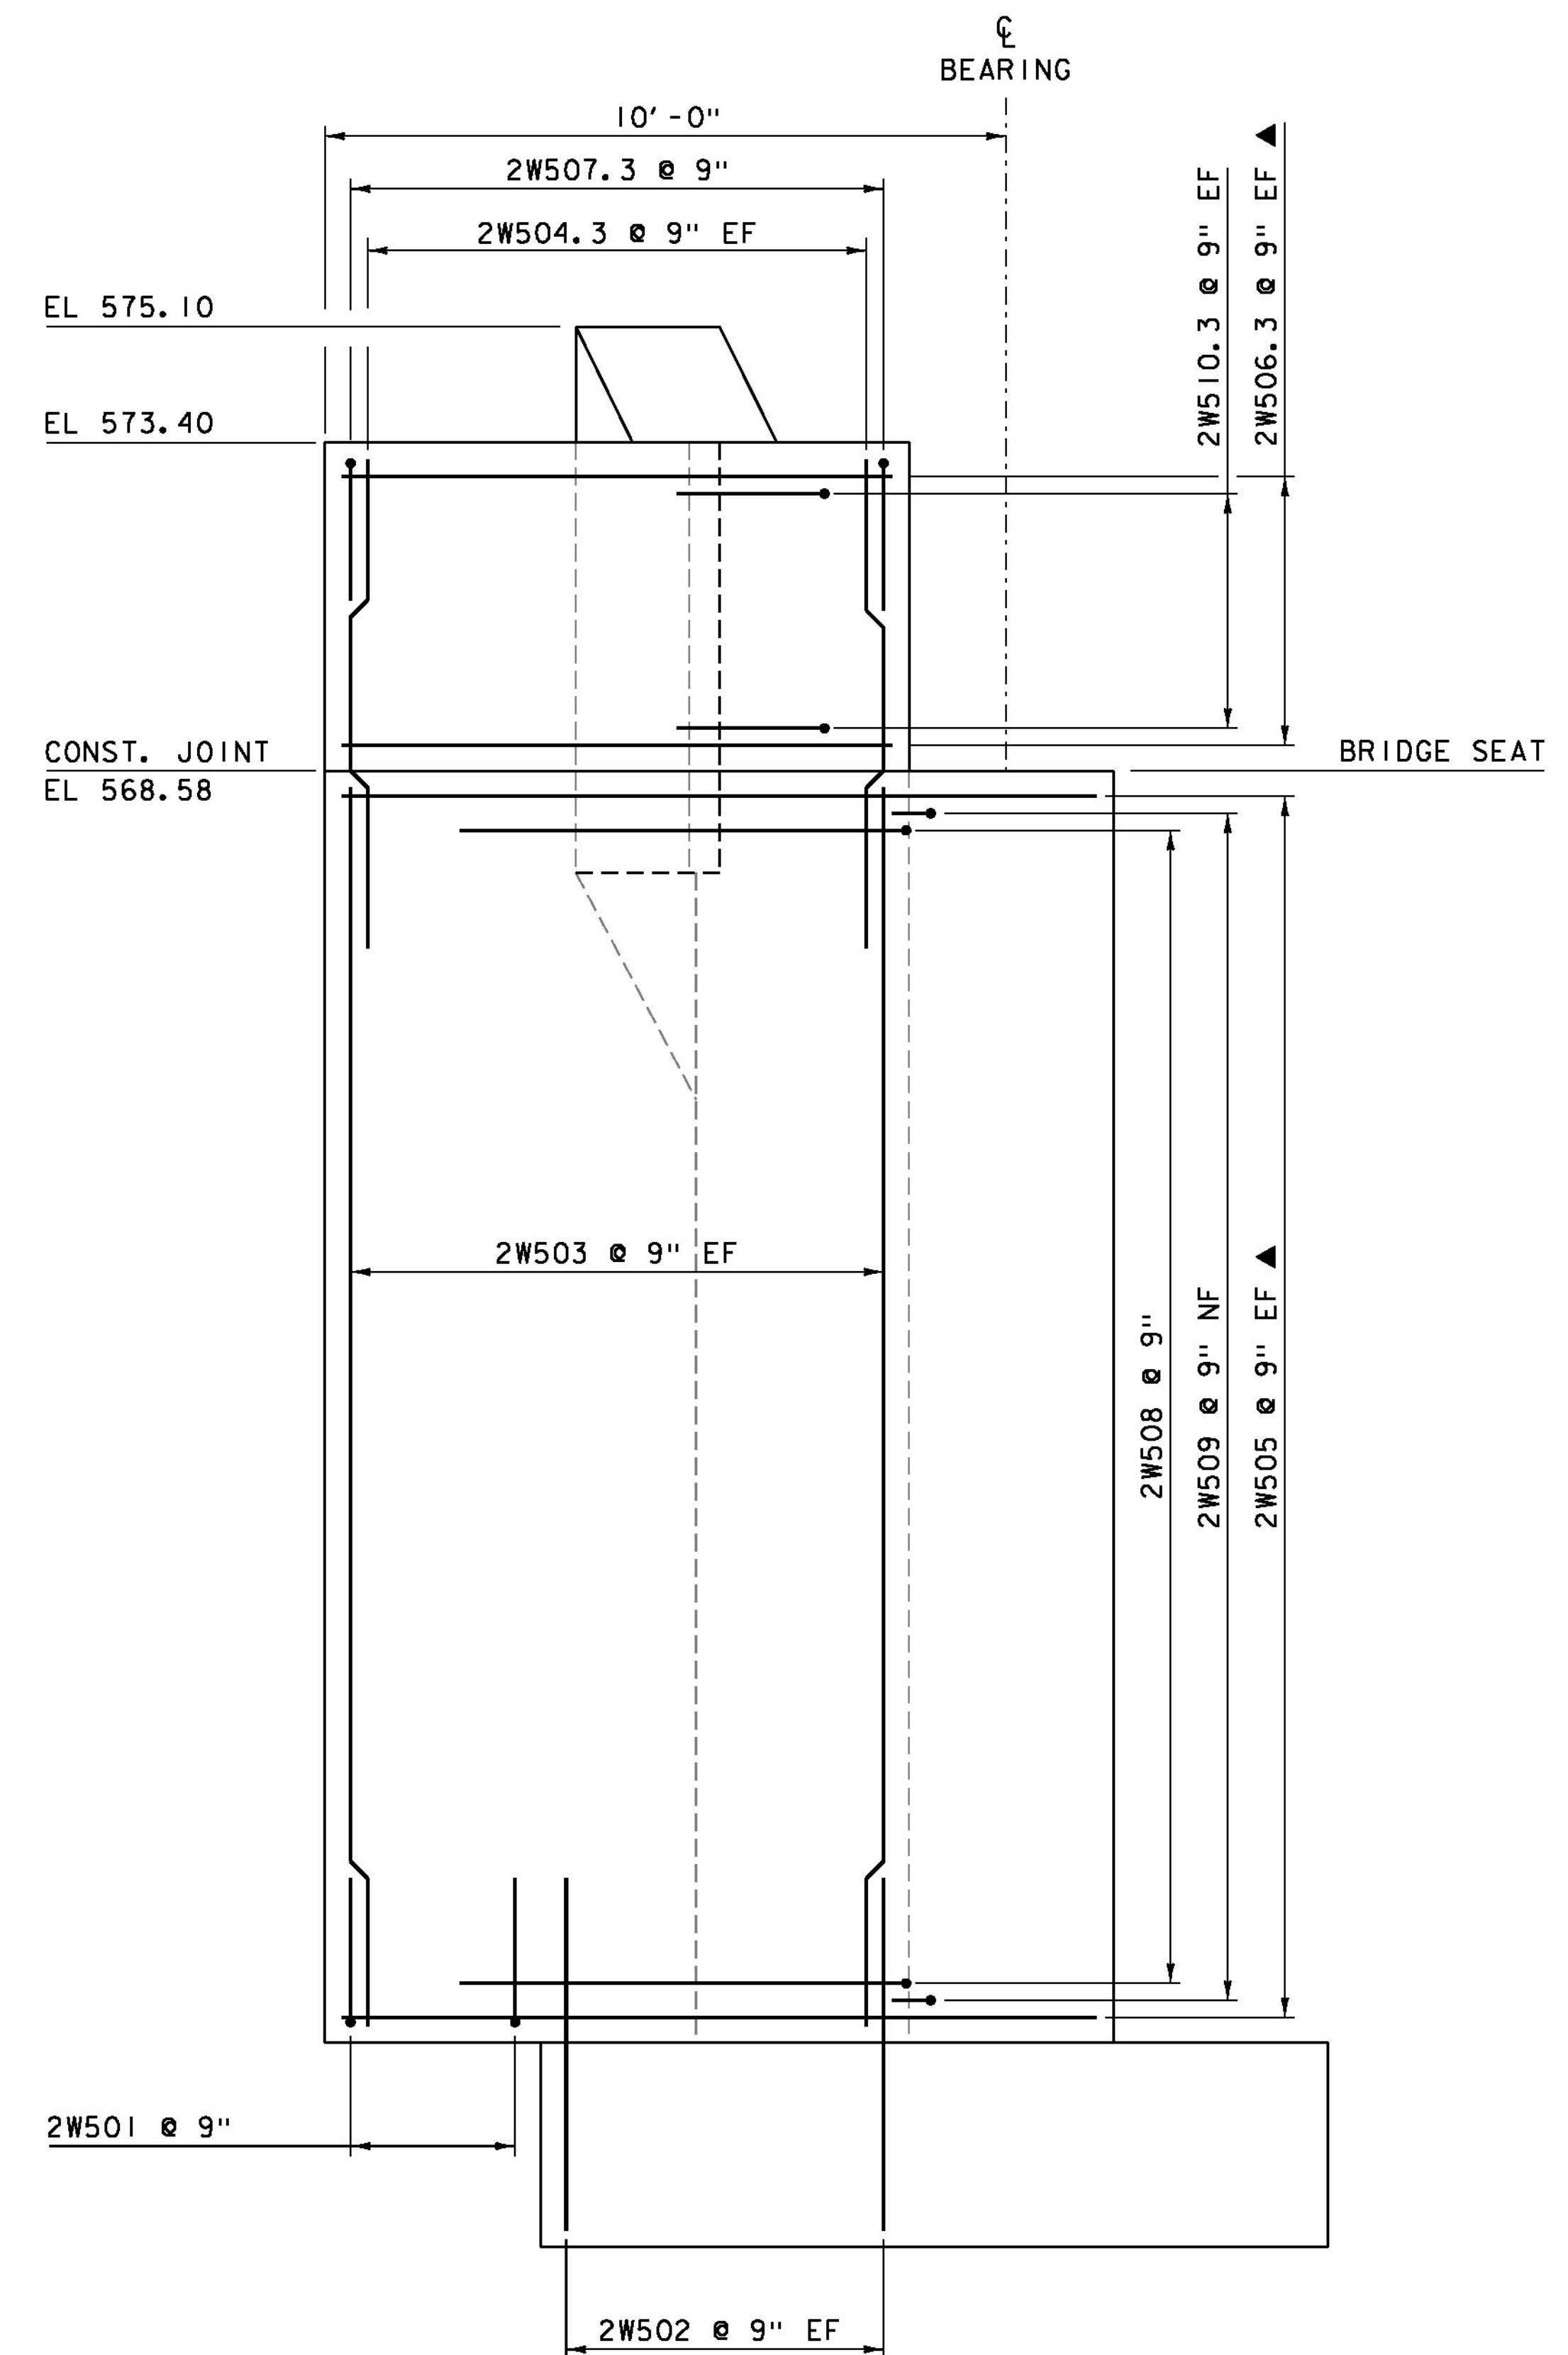

WINGWALL 2 ELEVATION
SCALE: 1/2" = 1'-0"

NOTE:
 NF = NEAR FACE
 FF = FAR FACE
 EF = EACH FACE
 ▲ = CUT TO FIT IN FIELD
 ■ = MECHANICAL CONNECTOR
 3" CLEAR, UNLESS OTHERWISE SPECIFIED ON THE PLANS.
 2'-2" LAP FOR #5 BAR
 2'-7" LAP FOR #6 BAR
 3'-5" LAP FOR #7 BAR
 4'-6" LAP FOR #8 BAR

PROJECT NAME:	HARTFORD
PROJECT NUMBER:	IM 091-2(79)
FILE NAME:	s12a132sub_abl.dgn
PROJECT LEADER:	K. HIGGINS
DESIGNED BY:	G. LAROCHE
WINGWALL 2 DETAILS	
PLOT DATE:	15-DEC-2014
DRAWN BY:	J. SALVATORI
CHECKED BY:	G. LAROCHE
SHEET	104 OF 166