


BRIDGE SEAT ELEVATIONS


GIRDER	ELEVATION
G1	571.11
G2	570.66
G3	570.22
G4	569.77
G5	569.32
G6	568.87

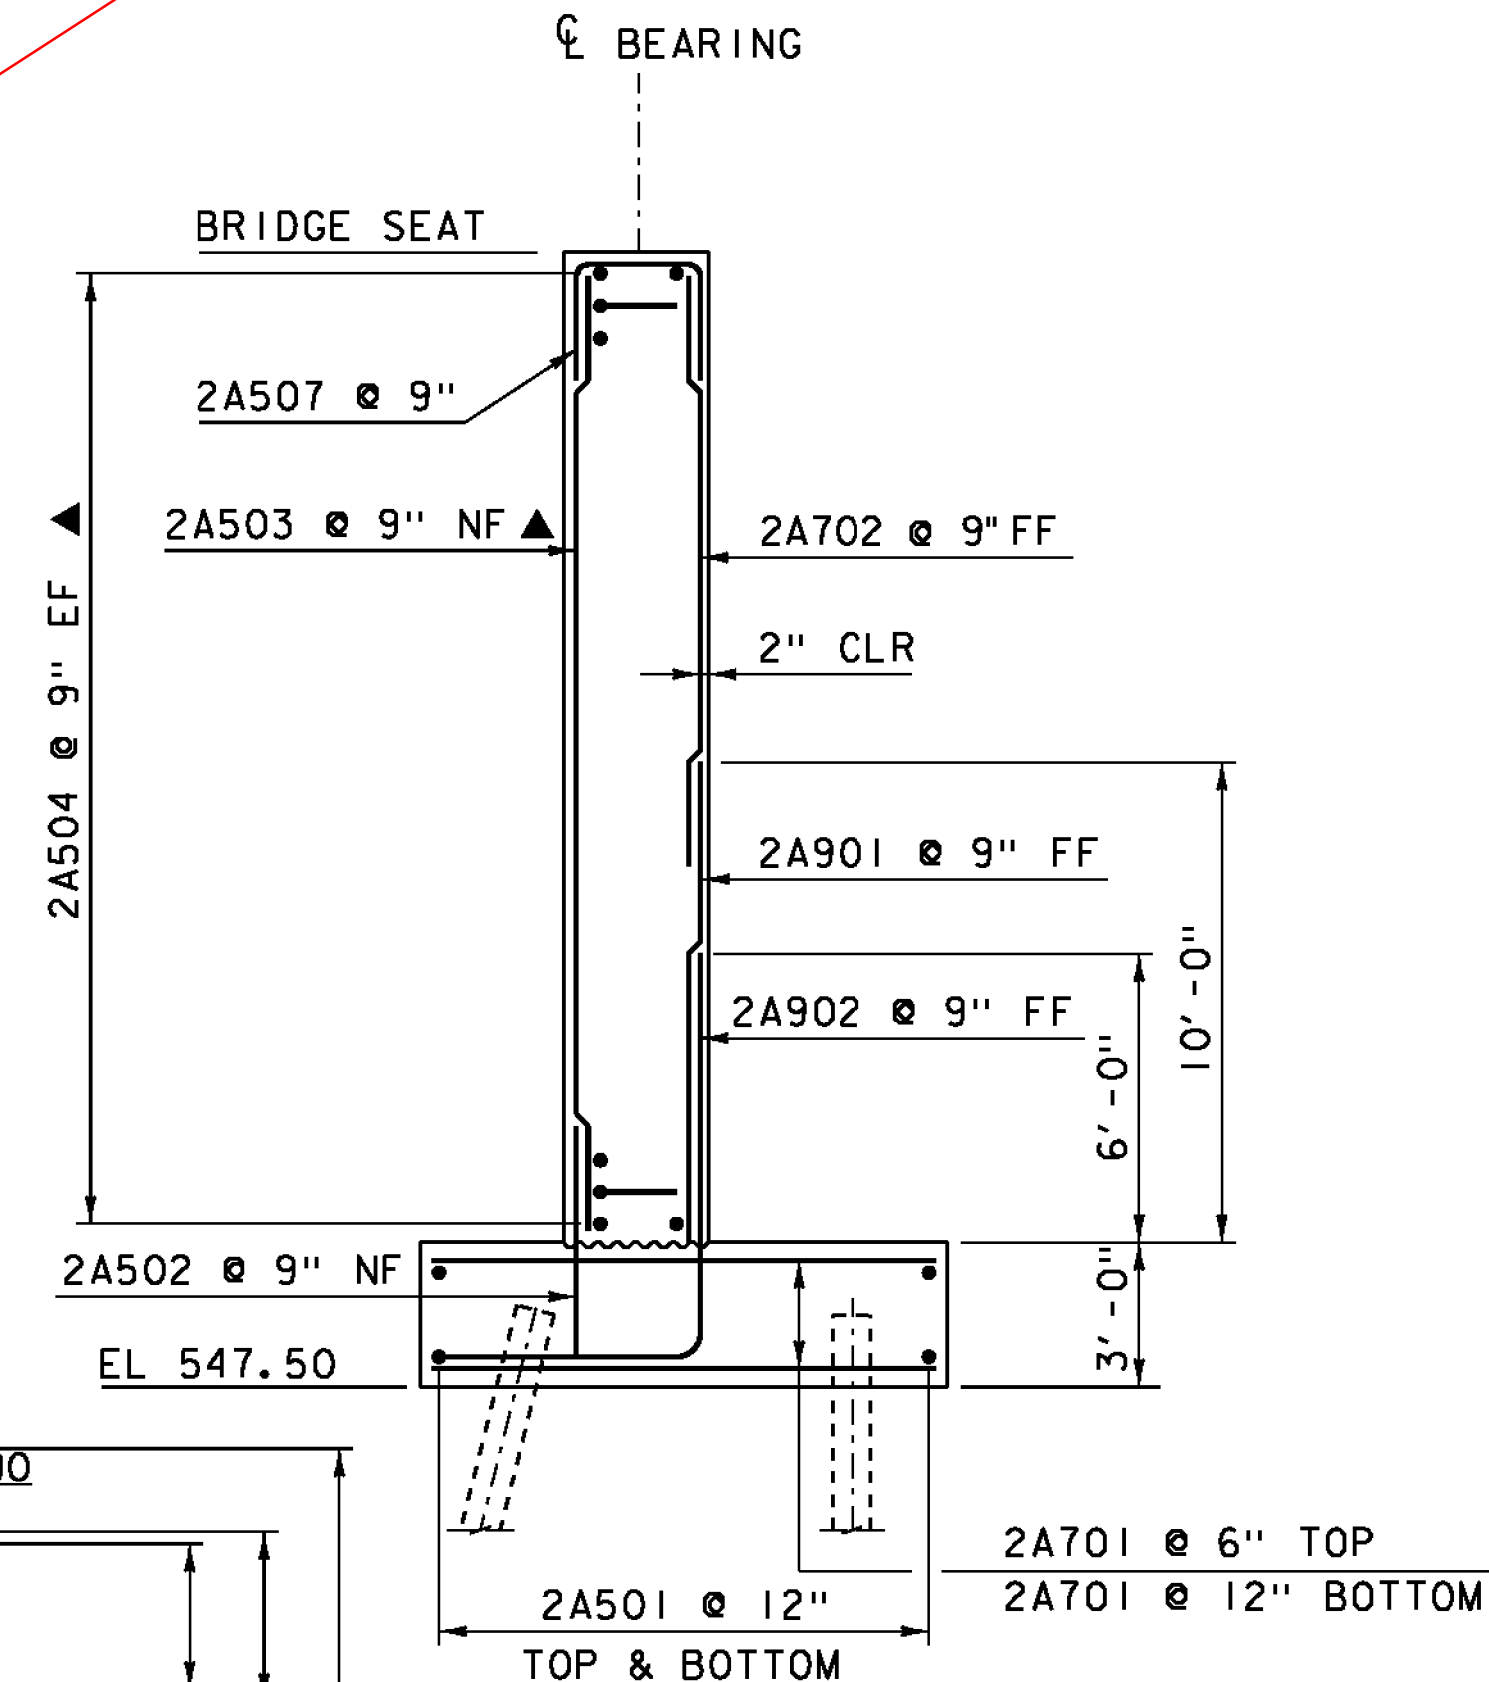

ABUTMENT 2 REINFORCING AT BRIDGE SEAT


SCALE: 1/4" = 1'-0"

- NOTE:**
- NF = NEAR FACE
 - FF = FAR FACE
 - EF = EACH FACE
 - ▲ = CUT TO FIT IN FIELD
 - = MECHANICAL CONNECTOR
 - 3" CLEAR, UNLESS OTHERWISE SPECIFIED ON THE PLANS.
 - 2'-2" LAP FOR #5 BAR
 - 2'-7" LAP FOR #6 BAR
 - 3'-5" LAP FOR #7 BAR
 - 4'-6" LAP FOR #8 BAR

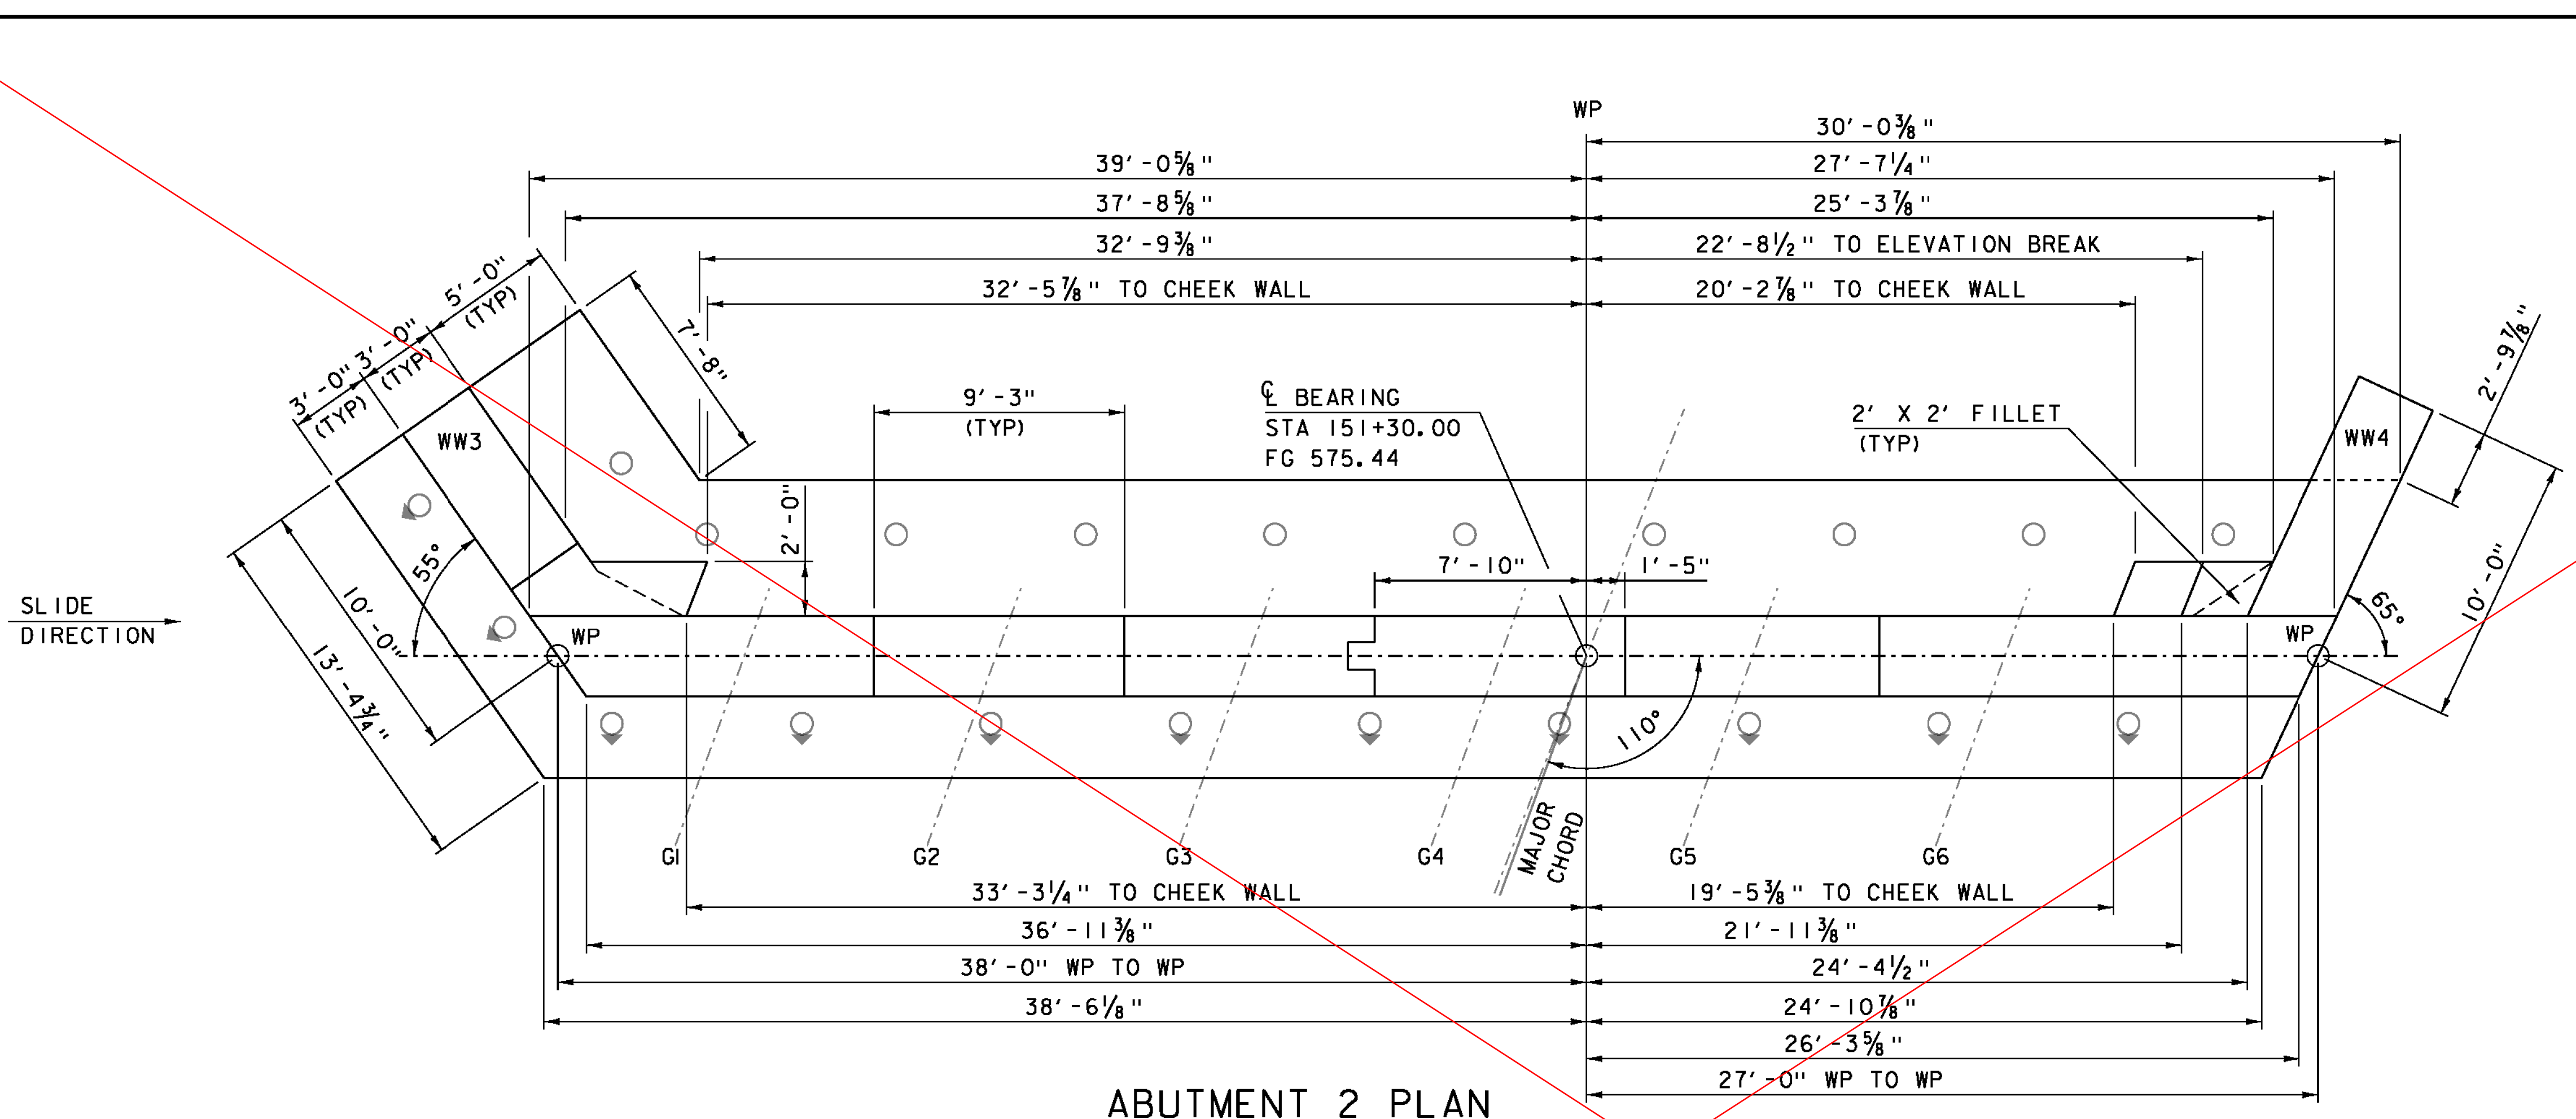

ABUTMENT 2 PLAN

SCALE: 1/4" = 1'-0"

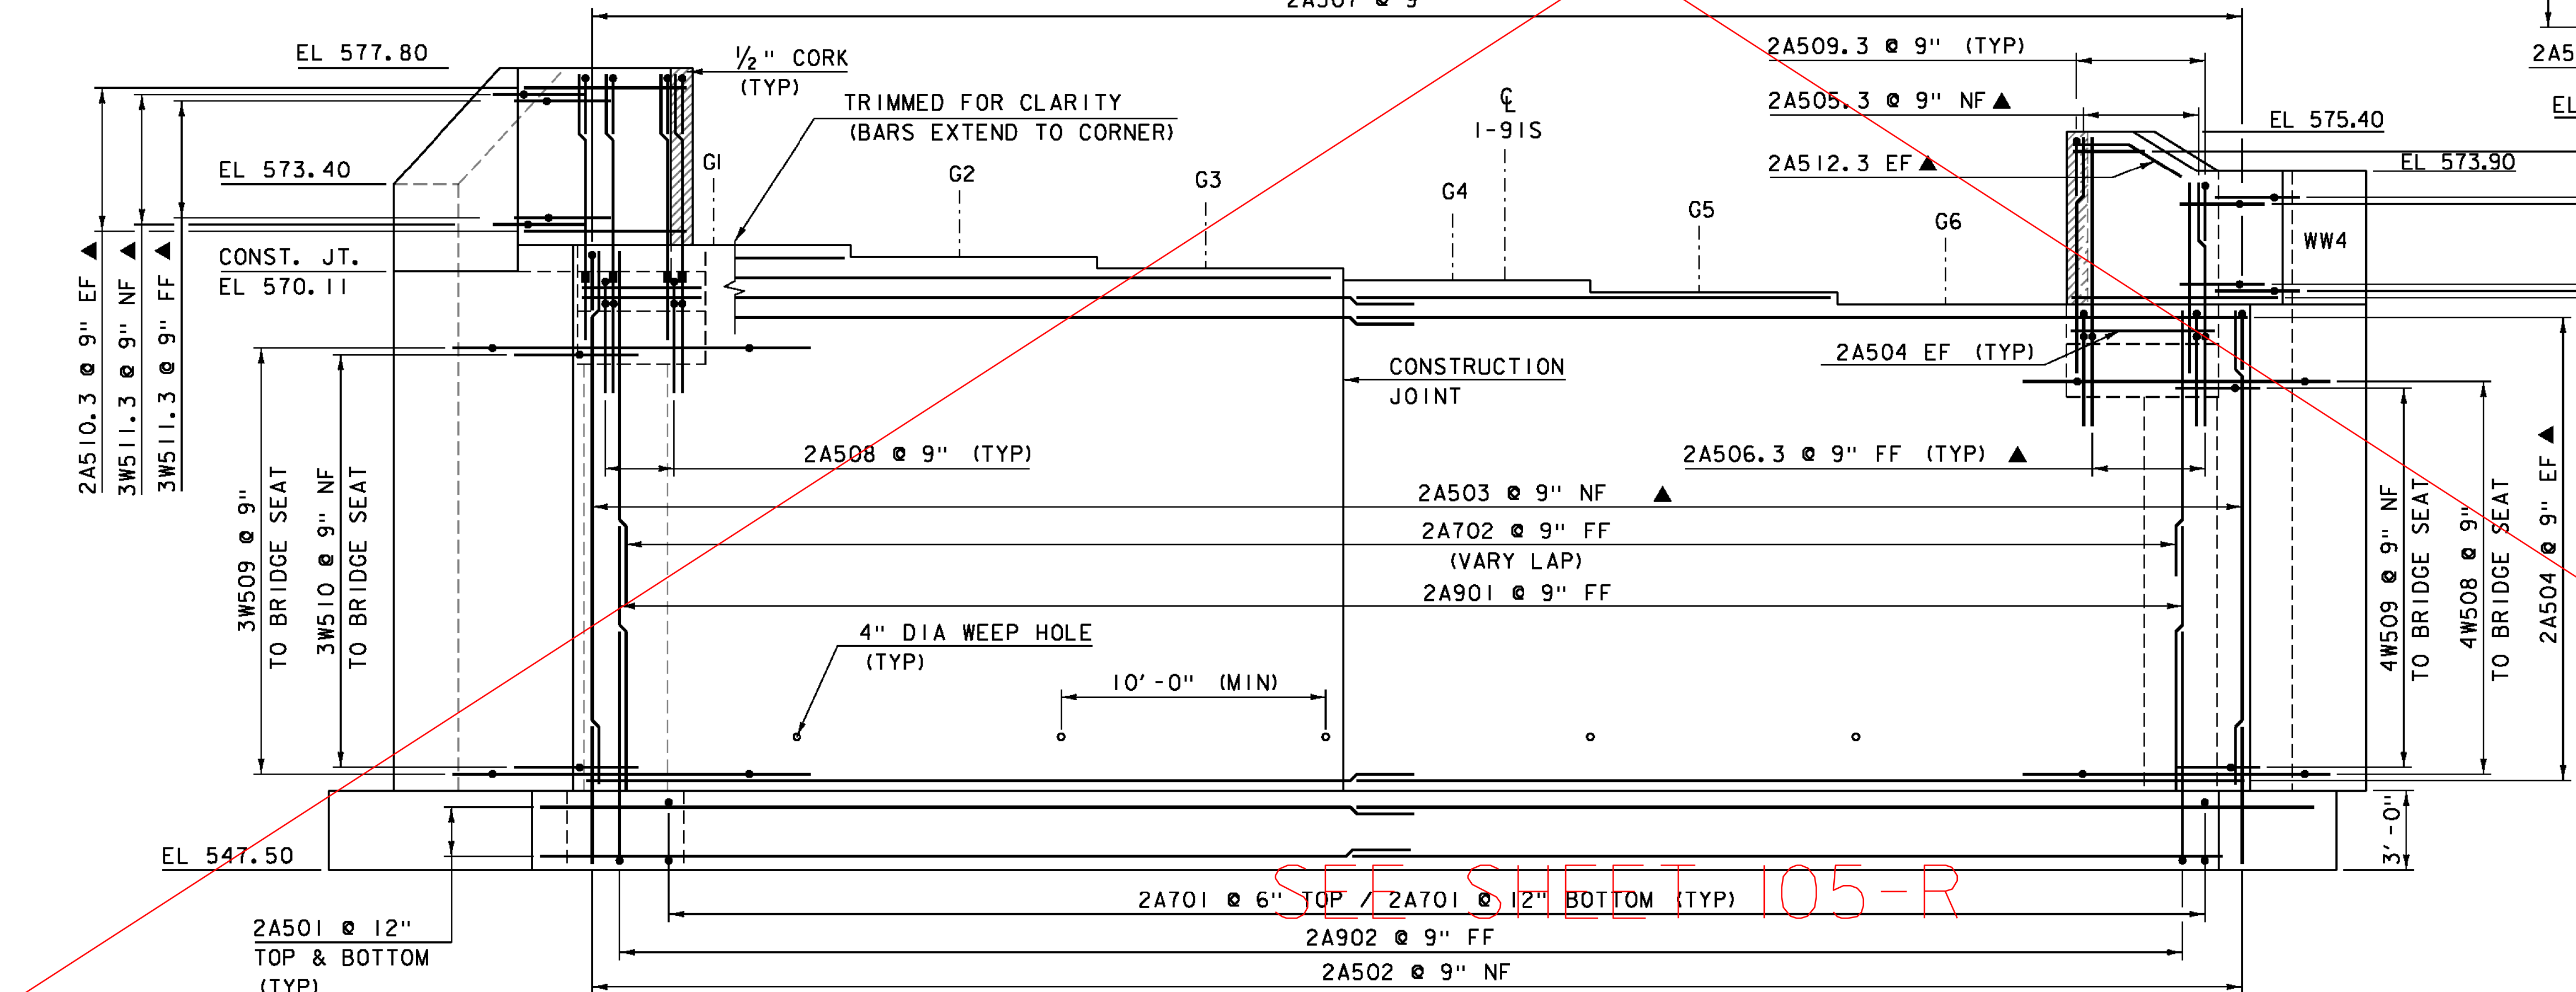

ABUTMENT 2 ELEVATION

SCALE: 1/4" = 1'-0"

SEE SHEET 105-R

PROJECT NAME: HARTFORD	PLOT DATE: 15-DEC-2014
PROJECT NUMBER: IM 091-2(79)	DRAWN BY: J. SALVATORI
FILE NAME: s120132sub.ab2	CHECKED BY: G. LAROCHE
PROJECT LEADER: K. HIGGINS	SHEET 105 OF 166
DESIGNED BY: G. LAROCHE	
ABUTMENT 2	