



REVISION	DATE	DESCRIPTION	BY
1	04-23-2015	WINGWALL 4 ROTATED 5 DEGREES	JS

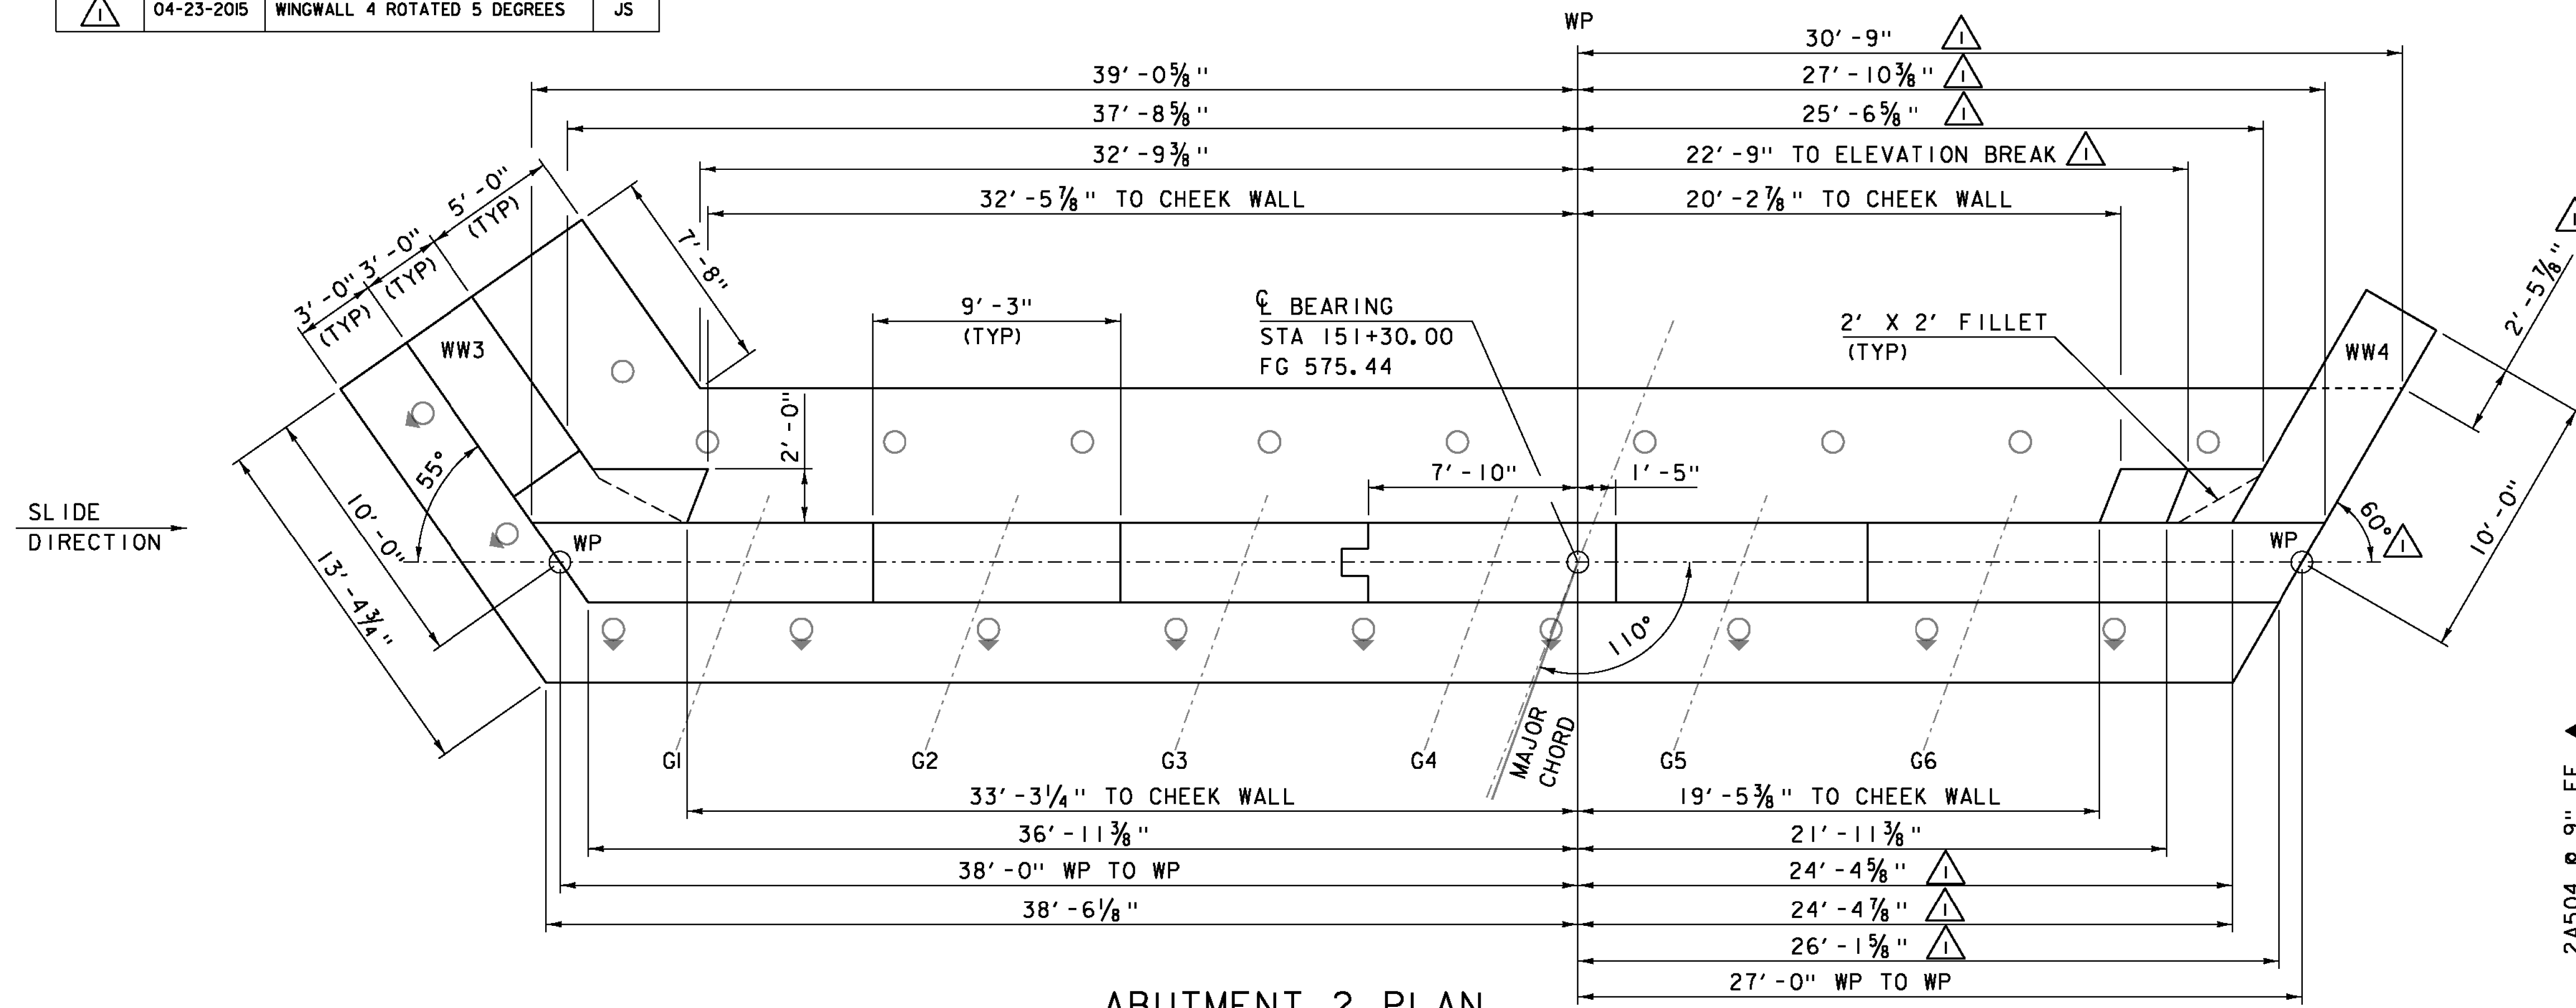


BRIDGE SEAT ELEVATIONS

GIRDER	ELEVATION
G1	571.11
G2	570.66
G3	570.22
G4	569.77
G5	569.32
G6	568.87

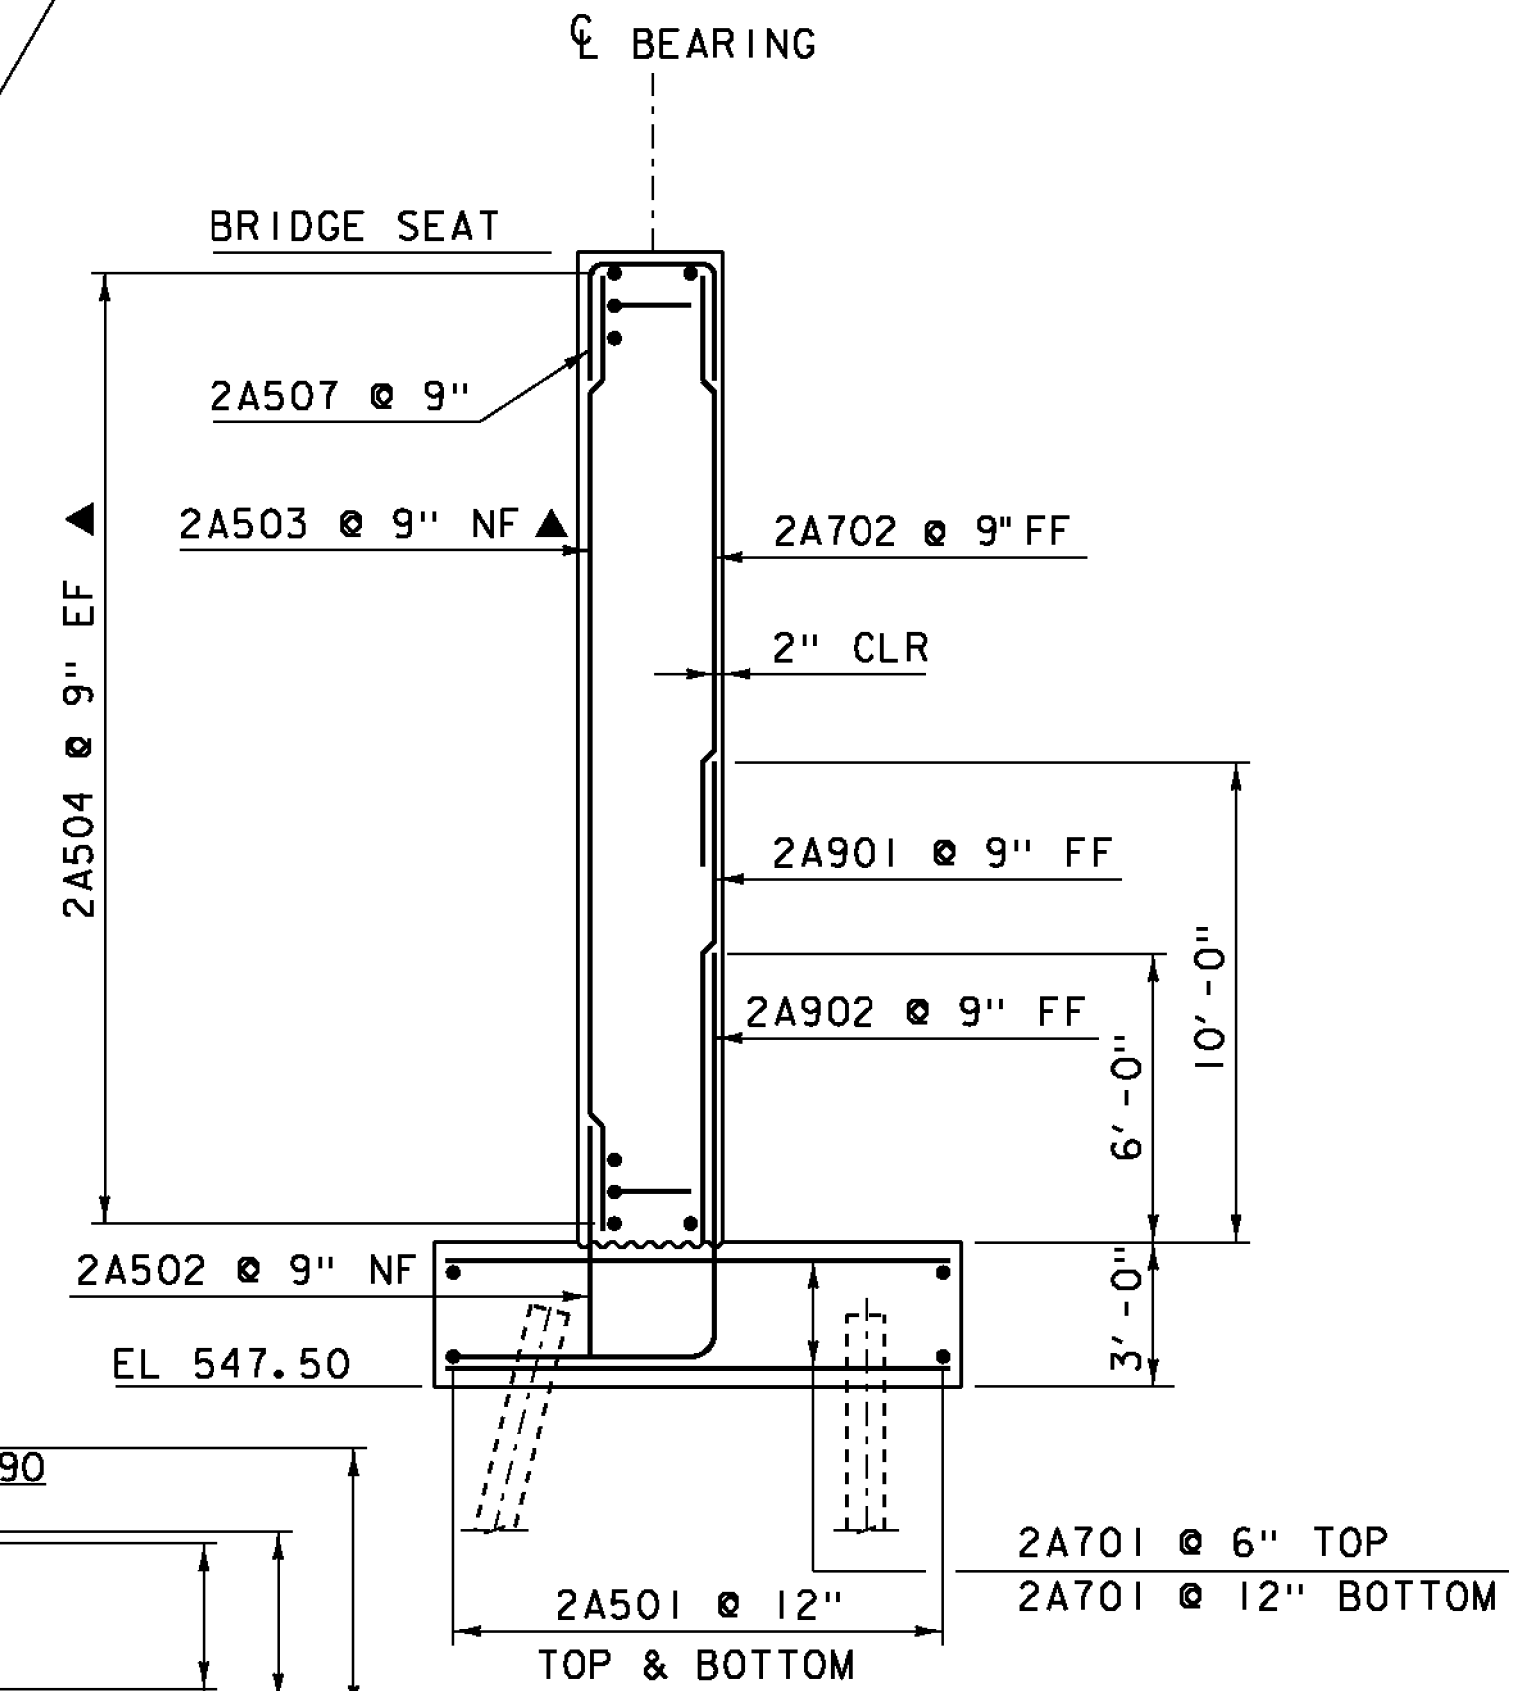

ABUTMENT 2 REINFORCING AT BRIDGE SEAT
SCALE: 1/4" = 1'-0"

NOTE:
 NF = NEAR FACE
 FF = FAR FACE
 EF = EACH FACE
 ▲ = CUT TO FIT IN FIELD
 ■ = MECHANICAL CONNECTOR
 3" CLEAR, UNLESS OTHERWISE SPECIFIED ON THE PLANS.
 2'-2" LAP FOR #5 BAR
 2'-7" LAP FOR #6 BAR
 3'-5" LAP FOR #7 BAR
 4'-6" LAP FOR #8 BAR

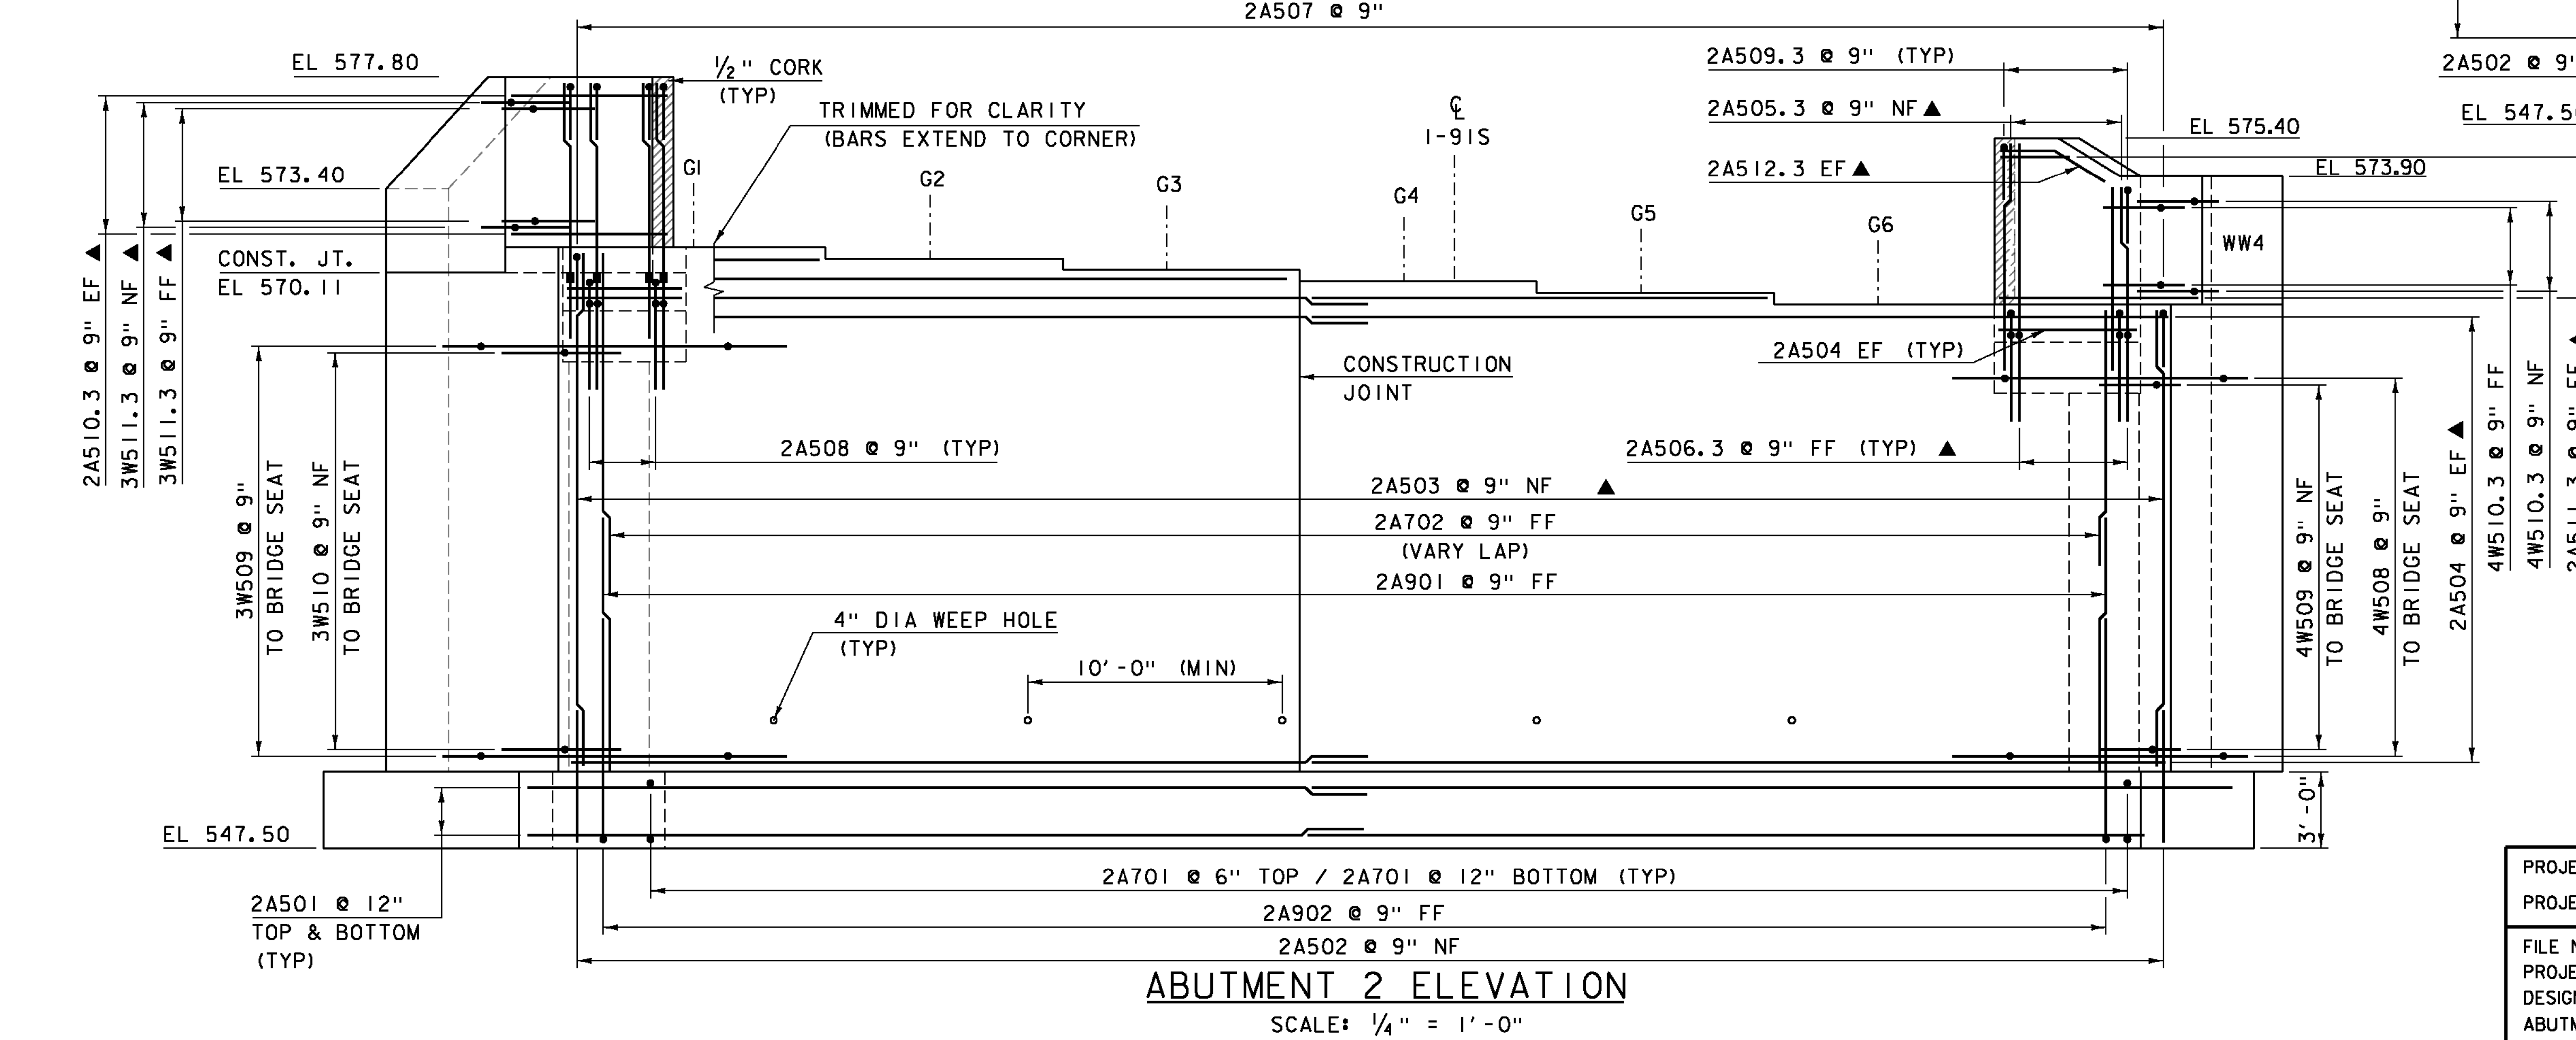

PROJECT NAME:	HARTFORD	PLOT DATE:	23-APR-2015
PROJECT NUMBER:	IM 091-2(79)	DRAWN BY:	J. SALVATORI
FILE NAME:	sl20132sub.ab2	DESIGNED BY:	G. LAROCHE
PROJECT LEADER:	K. HIGGINS	CHECKED BY:	G. LAROCHE
ABUTMENT 2		SHEET	105R OF 166