


**WINGWALL 3 TYPICAL**  
SCALE: 1/2" = 1'-0"

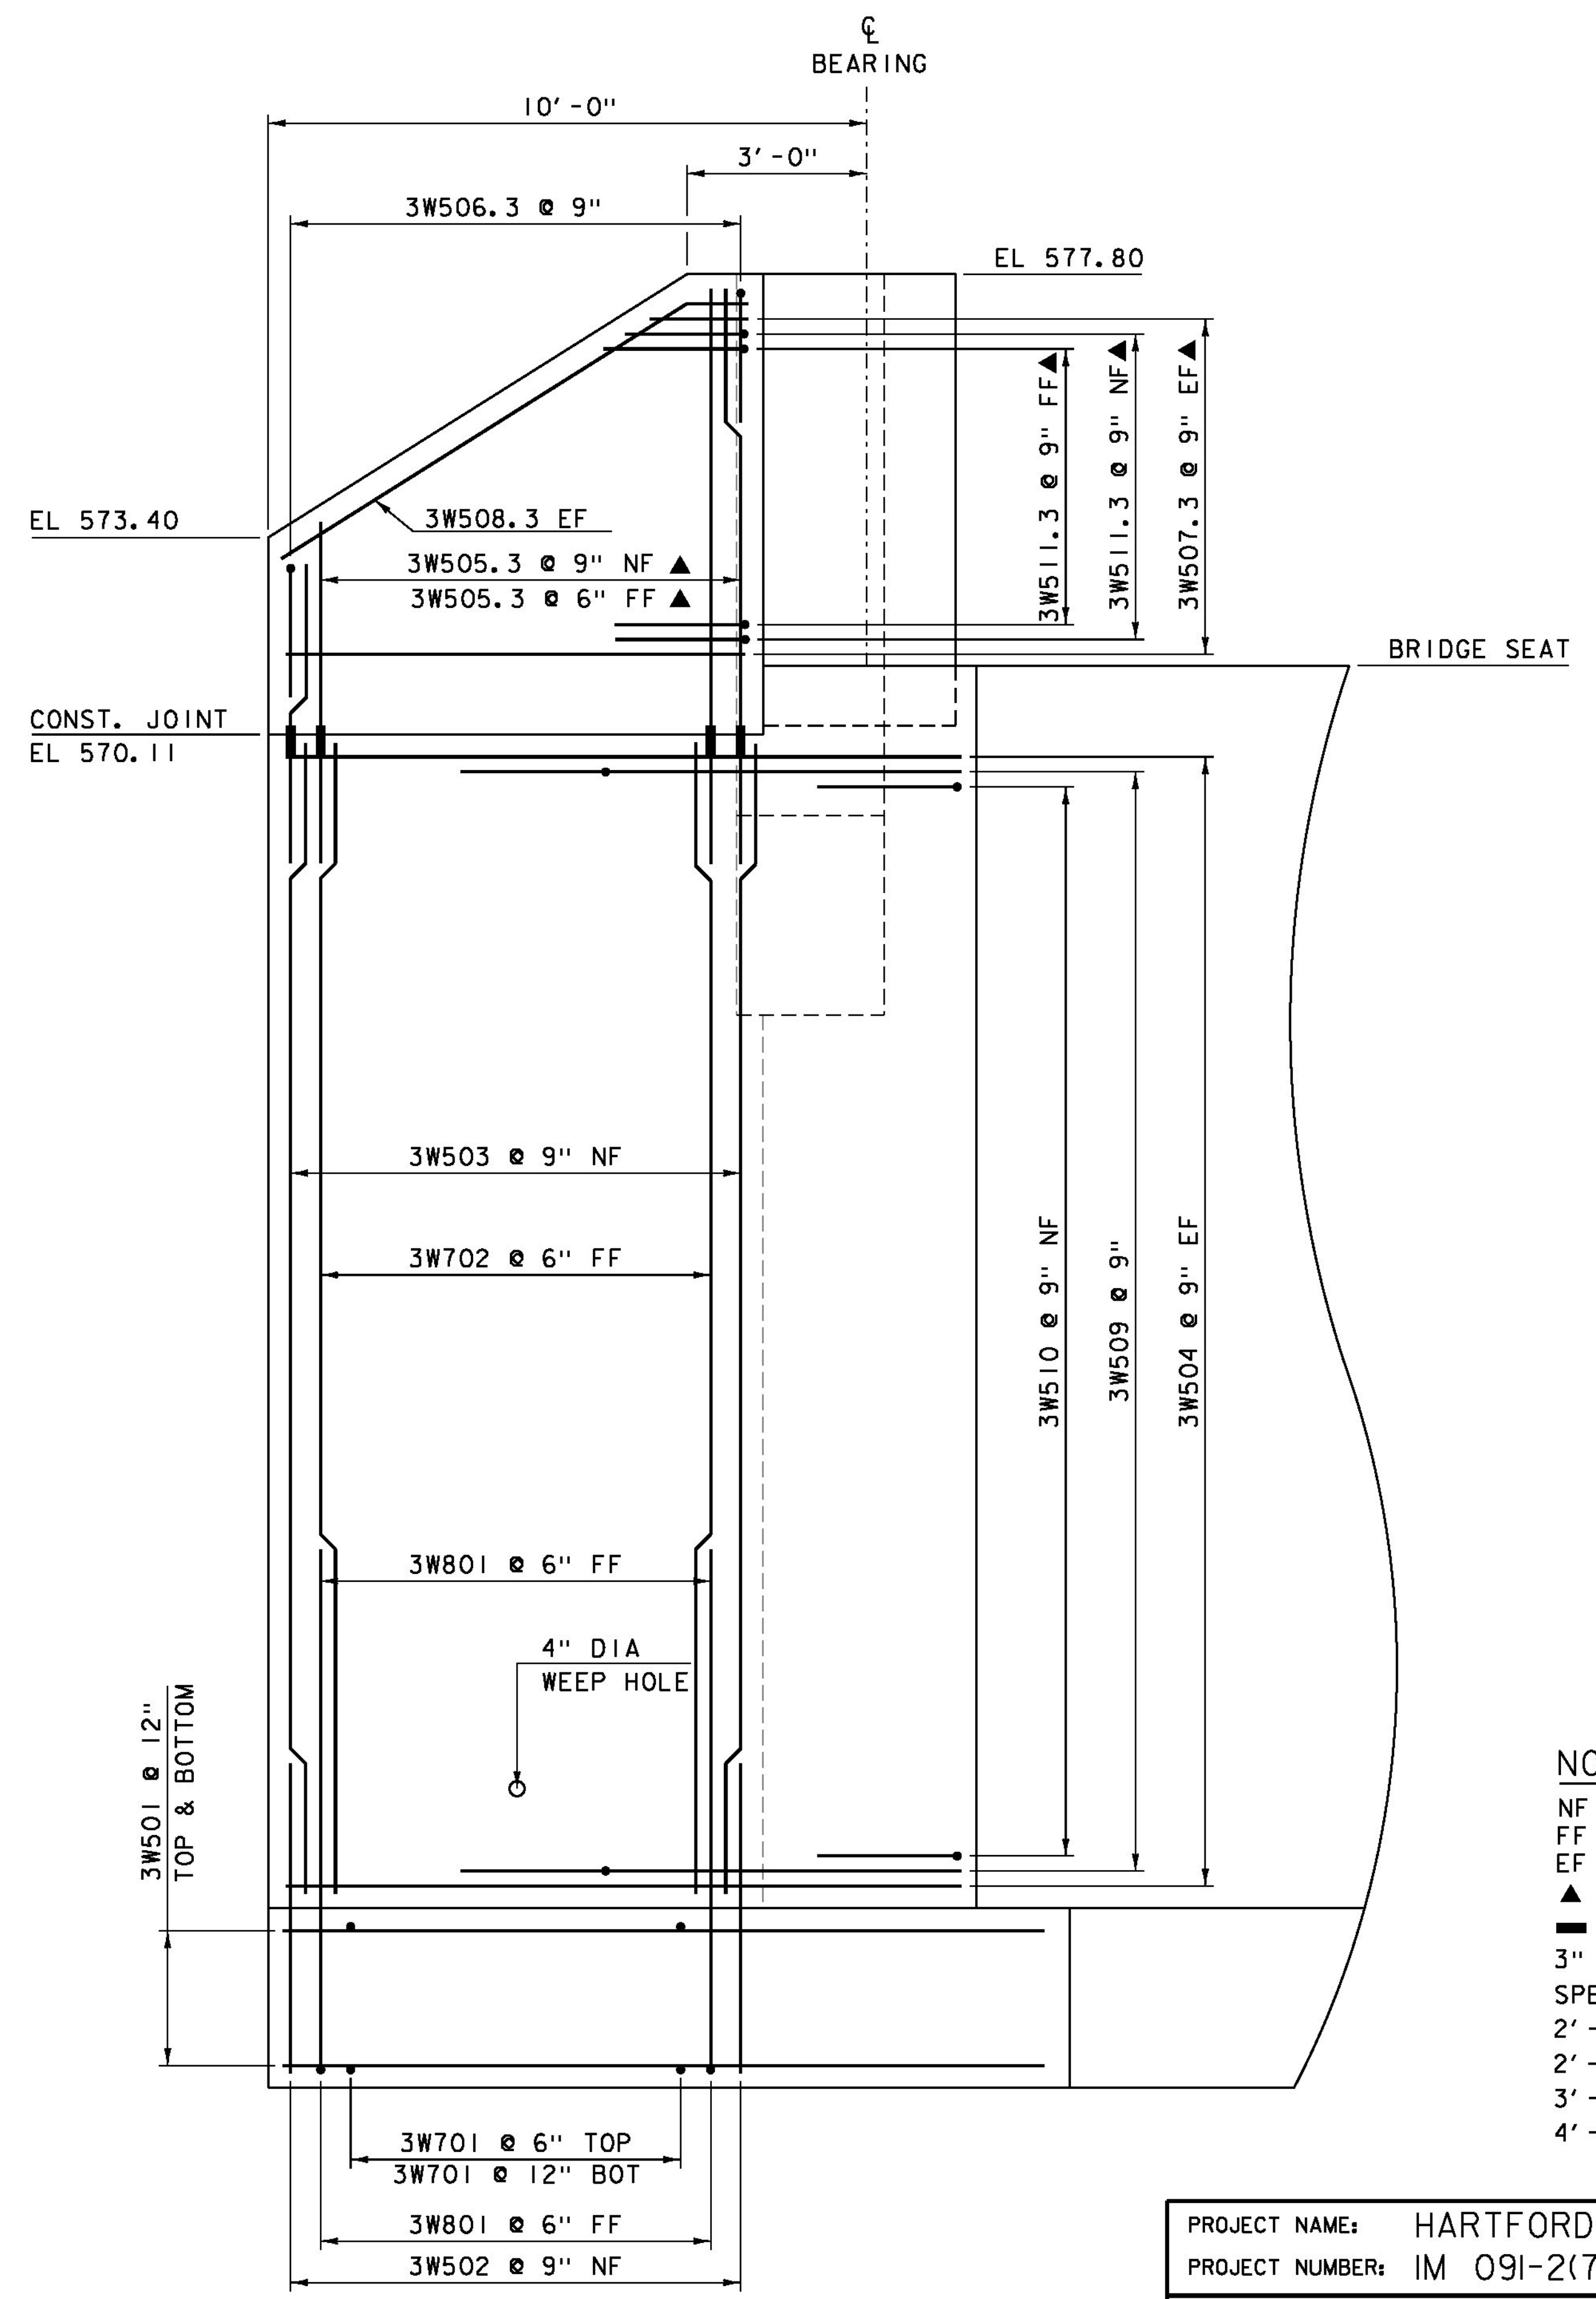

**WINGWALL 3 ELEVATION**  
SCALE: 1/2" = 1'-0"

**NOTE:**  
 NF = NEAR FACE  
 FF = FAR FACE  
 EF = EACH FACE  
 ▲ = CUT TO FIT IN FIELD  
 ■ = MECHANICAL CONNECTOR  
 3" CLEAR, UNLESS OTHERWISE  
 SPECIFIED ON THE PLANS.  
 2'-2" LAP FOR #5 BAR  
 2'-7" LAP FOR #6 BAR  
 3'-5" LAP FOR #7 BAR  
 4'-6" LAP FOR #8 BAR

PROJECT NAME:	HARTFORD	FILE NAME:	st2a132sub_ab2	PLOT DATE:	15-DEC-2014
PROJECT NUMBER:	IM 091-2(79)	PROJECT LEADER:	K. HIGGINS	DRAWN BY:	J. SALVATORI
		DESIGNED BY:	G. LAROCHE	CHECKED BY:	G. LAROCHE
		WINGWALL 3 DETAILS		SHEET	107 OF 166