


**WINGWALL 4 ELEVATION**  
 SCALE: 1/2" = 1' - 0"

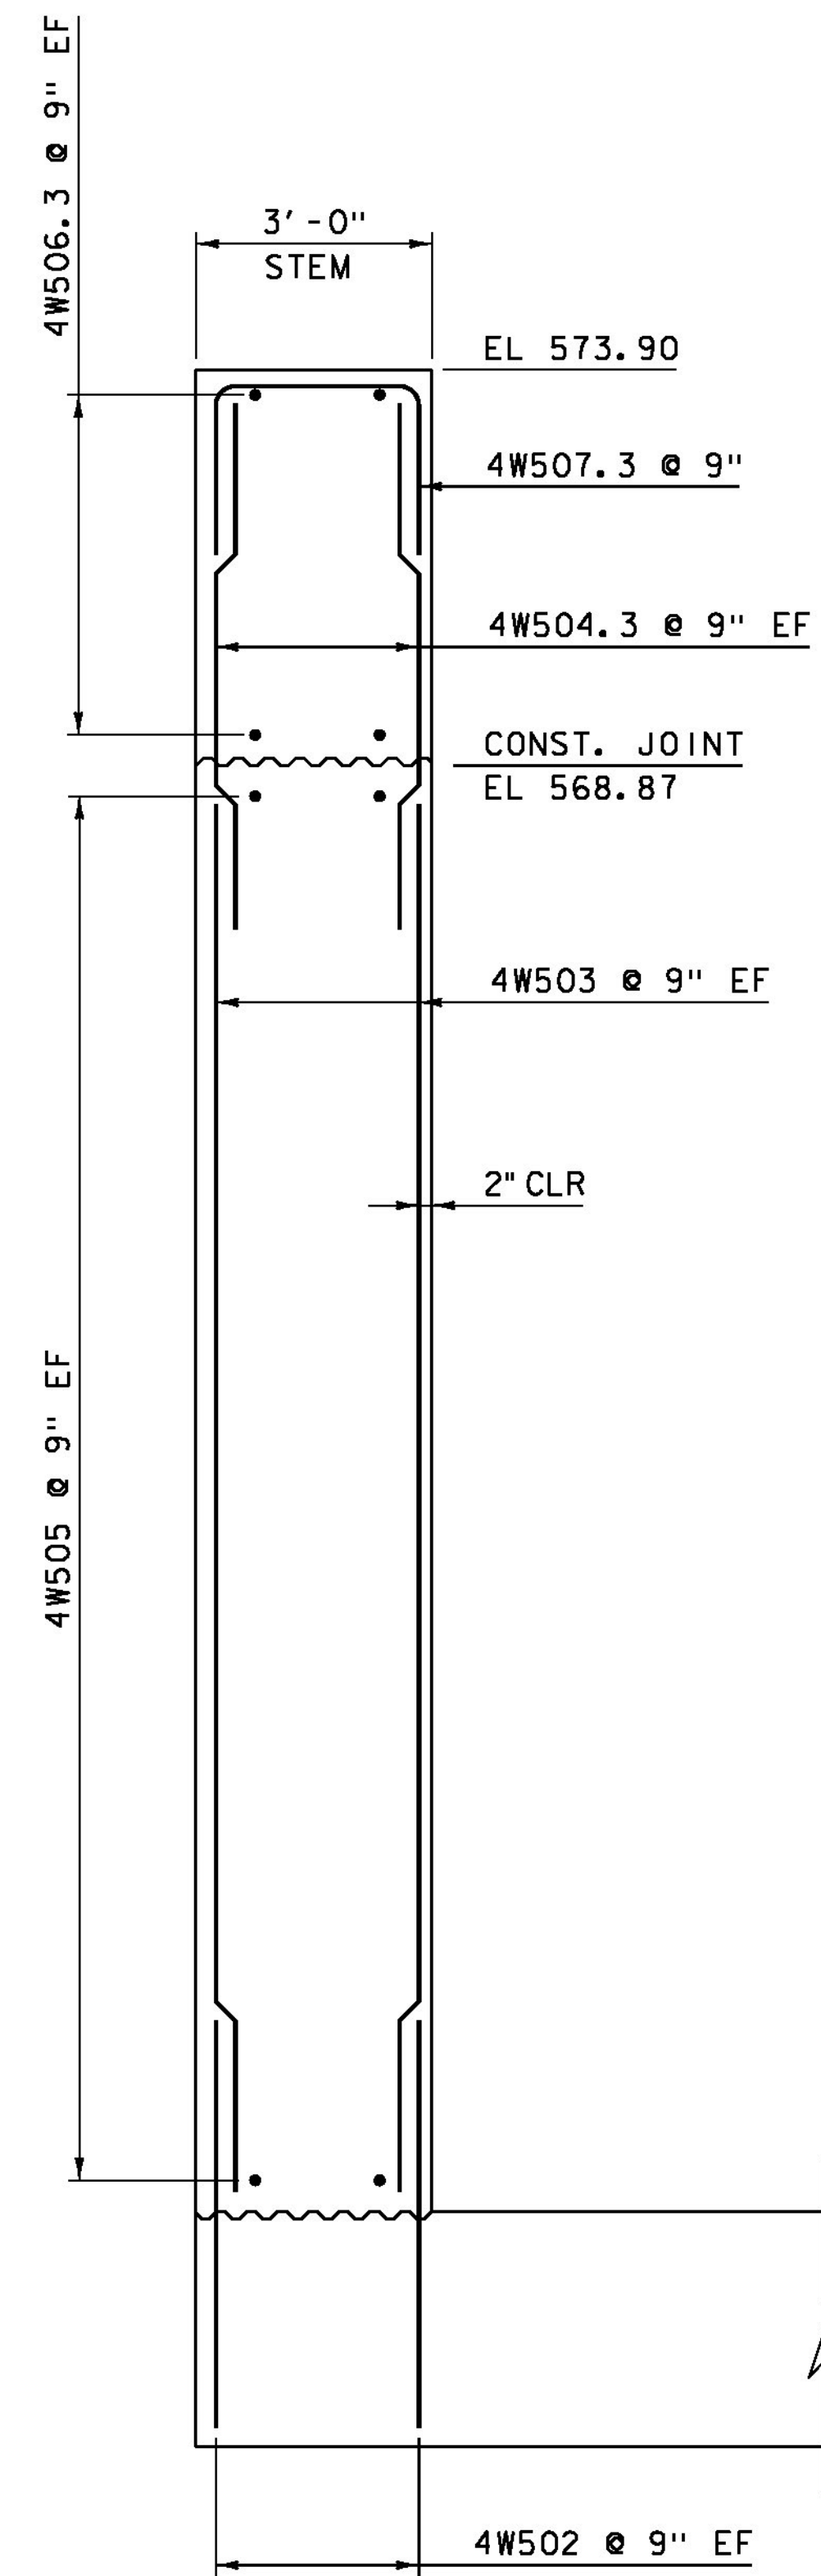

**WINGWALL 4 TYPICAL  
 OVER FOOTING**  
 SCALE: 1/2" = 1' - 0"

**NOTE:**  
 NF = NEAR FACE  
 FF = FAR FACE  
 EF = EACH FACE  
 ▲ = CUT TO FIT IN FIELD  
 ■ = MECHANICAL CONNECTOR  
 3" CLEAR, UNLESS OTHERWISE  
 SPECIFIED ON THE PLANS.  
 2' - 2" LAP FOR #5 BAR  
 2' - 7" LAP FOR #6 BAR  
 3' - 5" LAP FOR #7 BAR  
 4' - 6" LAP FOR #8 BAR

PROJECT NAME: HARTFORD	PLOT DATE: 15-DEC-2014
PROJECT NUMBER: IM 091-2(79)	DRAWN BY: J. SALVATORI
FILE NAME: s12a132sub_ab2	CHECKED BY: G. LAROCHE
PROJECT LEADER: K. HIGGINS	SHEET 108 OF 166
DESIGNED BY: G. LAROCHE	
WINGWALL 4 DETAILS	