


**RETAINING WALL #4 ELEVATION**  
SCALE 1/2" = 1'-0"

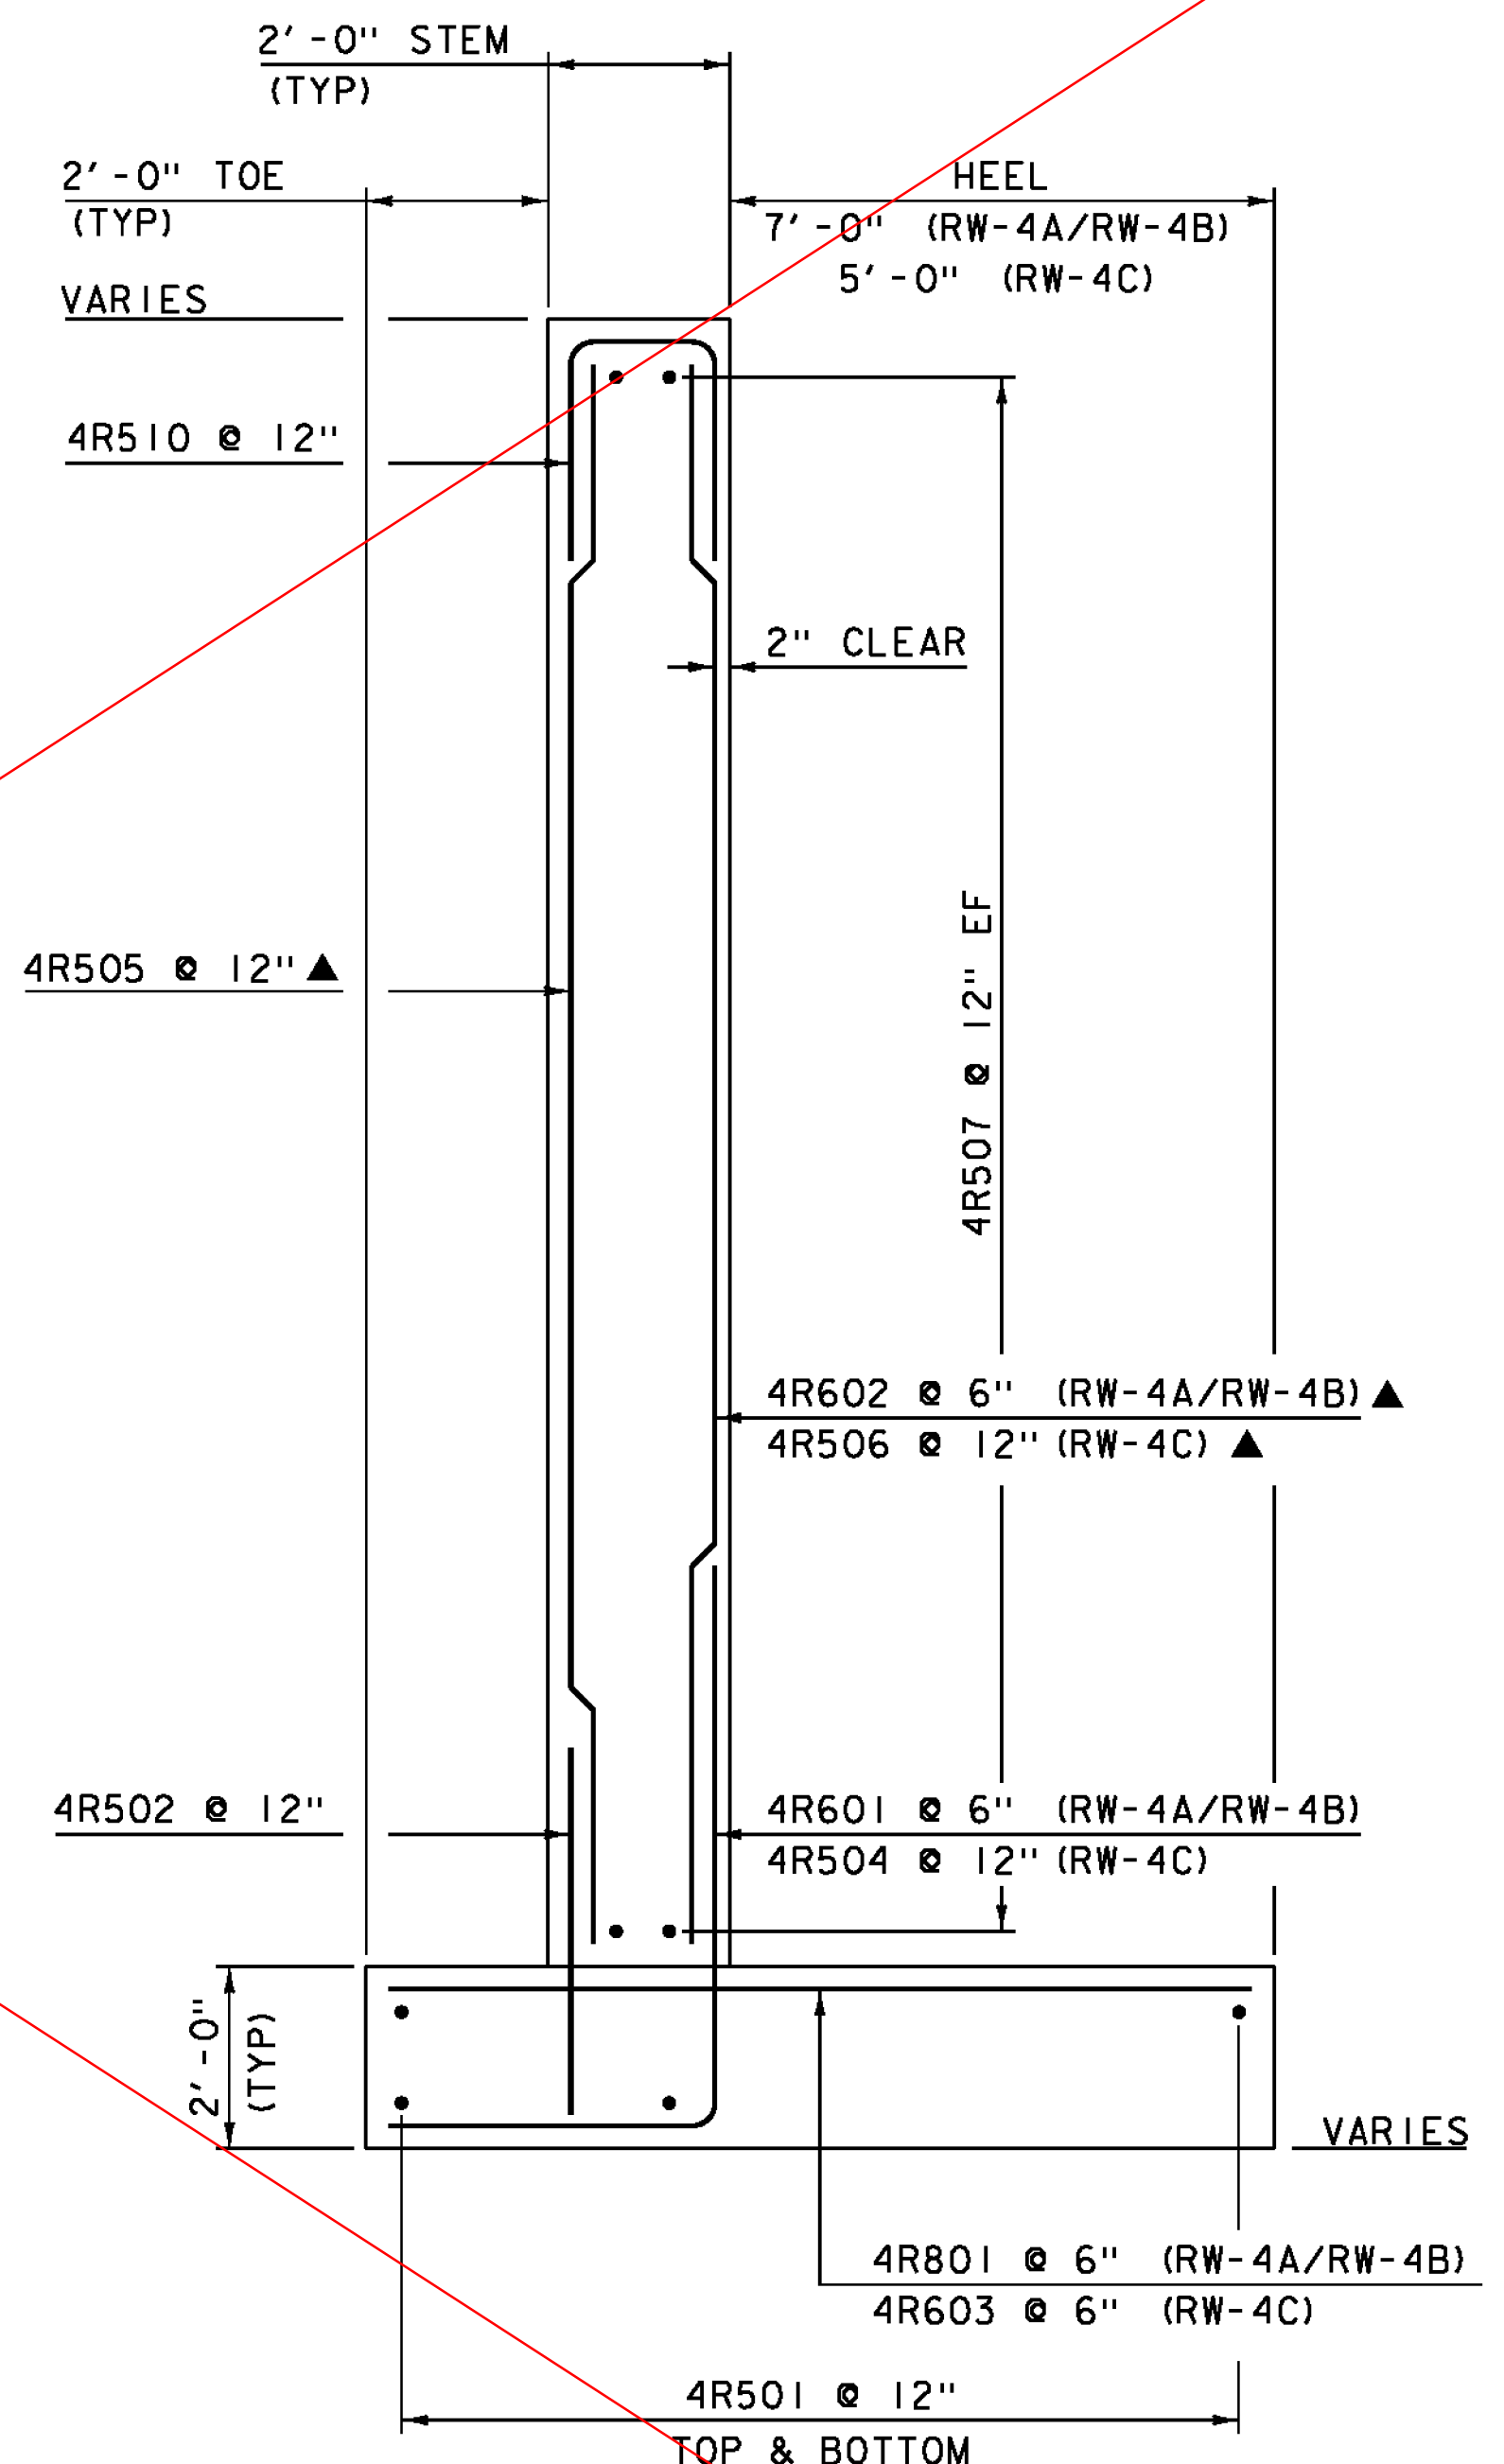

**RETAINING WALL #4 TYPICAL**  
SCALE 1/2" = 1'-0"

**NOTE:**  
 NF = NEAR FACE  
 FF = FAR FACE  
 EF = EACH FACE  
 ▲ = CUT TO FIT IN FIELD  
 3" CLEAR, UNLESS OTHERWISE SPECIFIED ON THE PLANS.  
 2'-2" LAP FOR #5 BAR  
 2'-7" LAP FOR #6 BAR  
 3'-5" LAP FOR #7 BAR  
 4'-6" LAP FOR #8 BAR

SEE SHEET 120-R

PROJECT NAME: HARTFORD	PLOT DATE: 15-DEC-2014
PROJECT NUMBER: IM 091-2(79)	DRAWN BY: J. SALVATORI
FILE NAME: s120132retwall.dgn	CHECKED BY: J. GRIGAS
PROJECT LEADER: K. HIGGINS	SHEET 120 OF 166
DESIGNED BY: G. LAROCHE	
RETAINING WALL #4	