




REINFORCING STEEL SCHEDULE

ITEM	EACH	SIZE	LENGTH	MARK	TYPE	A	B	C	D	E	F	G	H	J	K	R	O	ITEM	EACH	SIZE	LENGTH	MARK	TYPE	A	B	C	D	E	F	G	H	J	K	R	O	
	32	5	36'- 2"	1S501.3	STR																															
	▲ 90	5	17'- 1"	1S502.3	STR																															
	▲ 30	5	37'- 2"	1S503.3	STR																															
	* ▲ 21	5	11'- 9"	1S504.3	STR																															
	▲ 28	5	26'- 2"	1S505.3	STR																															
	▲ 46	5	11'- 10"	1S506.3	STR																															
	356	5	35'- 7"	1S507.3	STR																															
	88	5	27'- 2"	1S508.3	STR																															
	12	5	27'- 2"	1S509.3	STR																															
	56	6	36'- 6"	1S601.3	STR																															
	484	6	25'- 7"	1S602.3	STR																															
	* 65	6	23'- 11"	1S603.3	STR																															
	102	6	2'- 10"	1S605.3	STR																															
△	466	4	5'- 0"	1S401.3	1	0'- 6"	4'- 6"																													
	▲ 416	5	3'- 9"	1S510.3	1	0'- 7"	3'- 2"																													
	204	5	18'- 7"	1S511.3	S5	2'- 5"	6'- 1"	1'- 10"	5'- 10"																											
	102	5	5'- 6"	1S512.3	22	2'- 5"	3'- 1"																													
	124	5	5'- 8"	1S513.3	1	0'- 7"	5'- 1"																													
	212	6	7'- 3"	1S604.3	16	1'- 0"	2'- 1"	1'- 2"	3'- 0"																											

~ NOTES ~

- UNLESS OTHERWISE DESIGNATED, ALL BAR REINFORCEMENT FOR CONCRETE IN SIZES UP TO AND INCLUDING NO. 18 SHALL CONFORM TO THE REQUIREMENTS OF THE "SPECIFICATIONS FOR DEFORMED BILLET-STEEL BARS FOR CONCRETE REINFORCEMENT", AASHTO M 31 (ASTM A 615-SI). ALL BARS SHALL BE GRADE 60, UNLESS OTHERWISE DESIGNATED.
- FOR TYPICAL BENDING DETAILS, RECOMMENDED PIN DIAMETER "D" OF BENDS AND HOOKS, AND OTHER STANDARD PRACTICE, SEE CURRENT CONCRETE REINFORCING STEEL INSTITUTE "MANUAL OF STANDARD PRACTICE".
- BARS WHICH REQUIRE MORE ACCURATE BENDING THAN STANDARD PRACTICES SHOULD HAVE LIMITS INDICATED.
- ALL DIMENSIONS ARE OUT TO OUT OF BAR EXCEPT "A" AND "G" ON STANDARD 180 DEGREE AND 135 DEGREE HOOKS.
- "J" DIMENSION ON 180 DEGREE HOOKS TO BE SHOWN ONLY WHERE NECESSARY TO RESTRICT HOOK SIZE. OTHERWISE, STANDARD HOOKS ARE TO BE USED.
- "H" DIMENSION ON STIRRUPS TO BE SHOWN ONLY WHEN NECESSARY TO MAINTAIN CLEARANCES.
- WHERE SLOPE DIFFERS FROM 45 DEGREES, DIMENSIONS "H" AND "K" MUST BE SHOWN.
- ▲ DENOTES BARS TO BE CUT IN FIELD.
- * DENOTES ONE EXTRA BAR ADDED FOR TESTING PURPOSES.
- △ DENOTES TWO EXTRA BARS ADDED FOR TESTING PURPOSES.
- E IN BAR MARK PREFIX DENOTES EPOXY COATED REINFORCING STEEL.

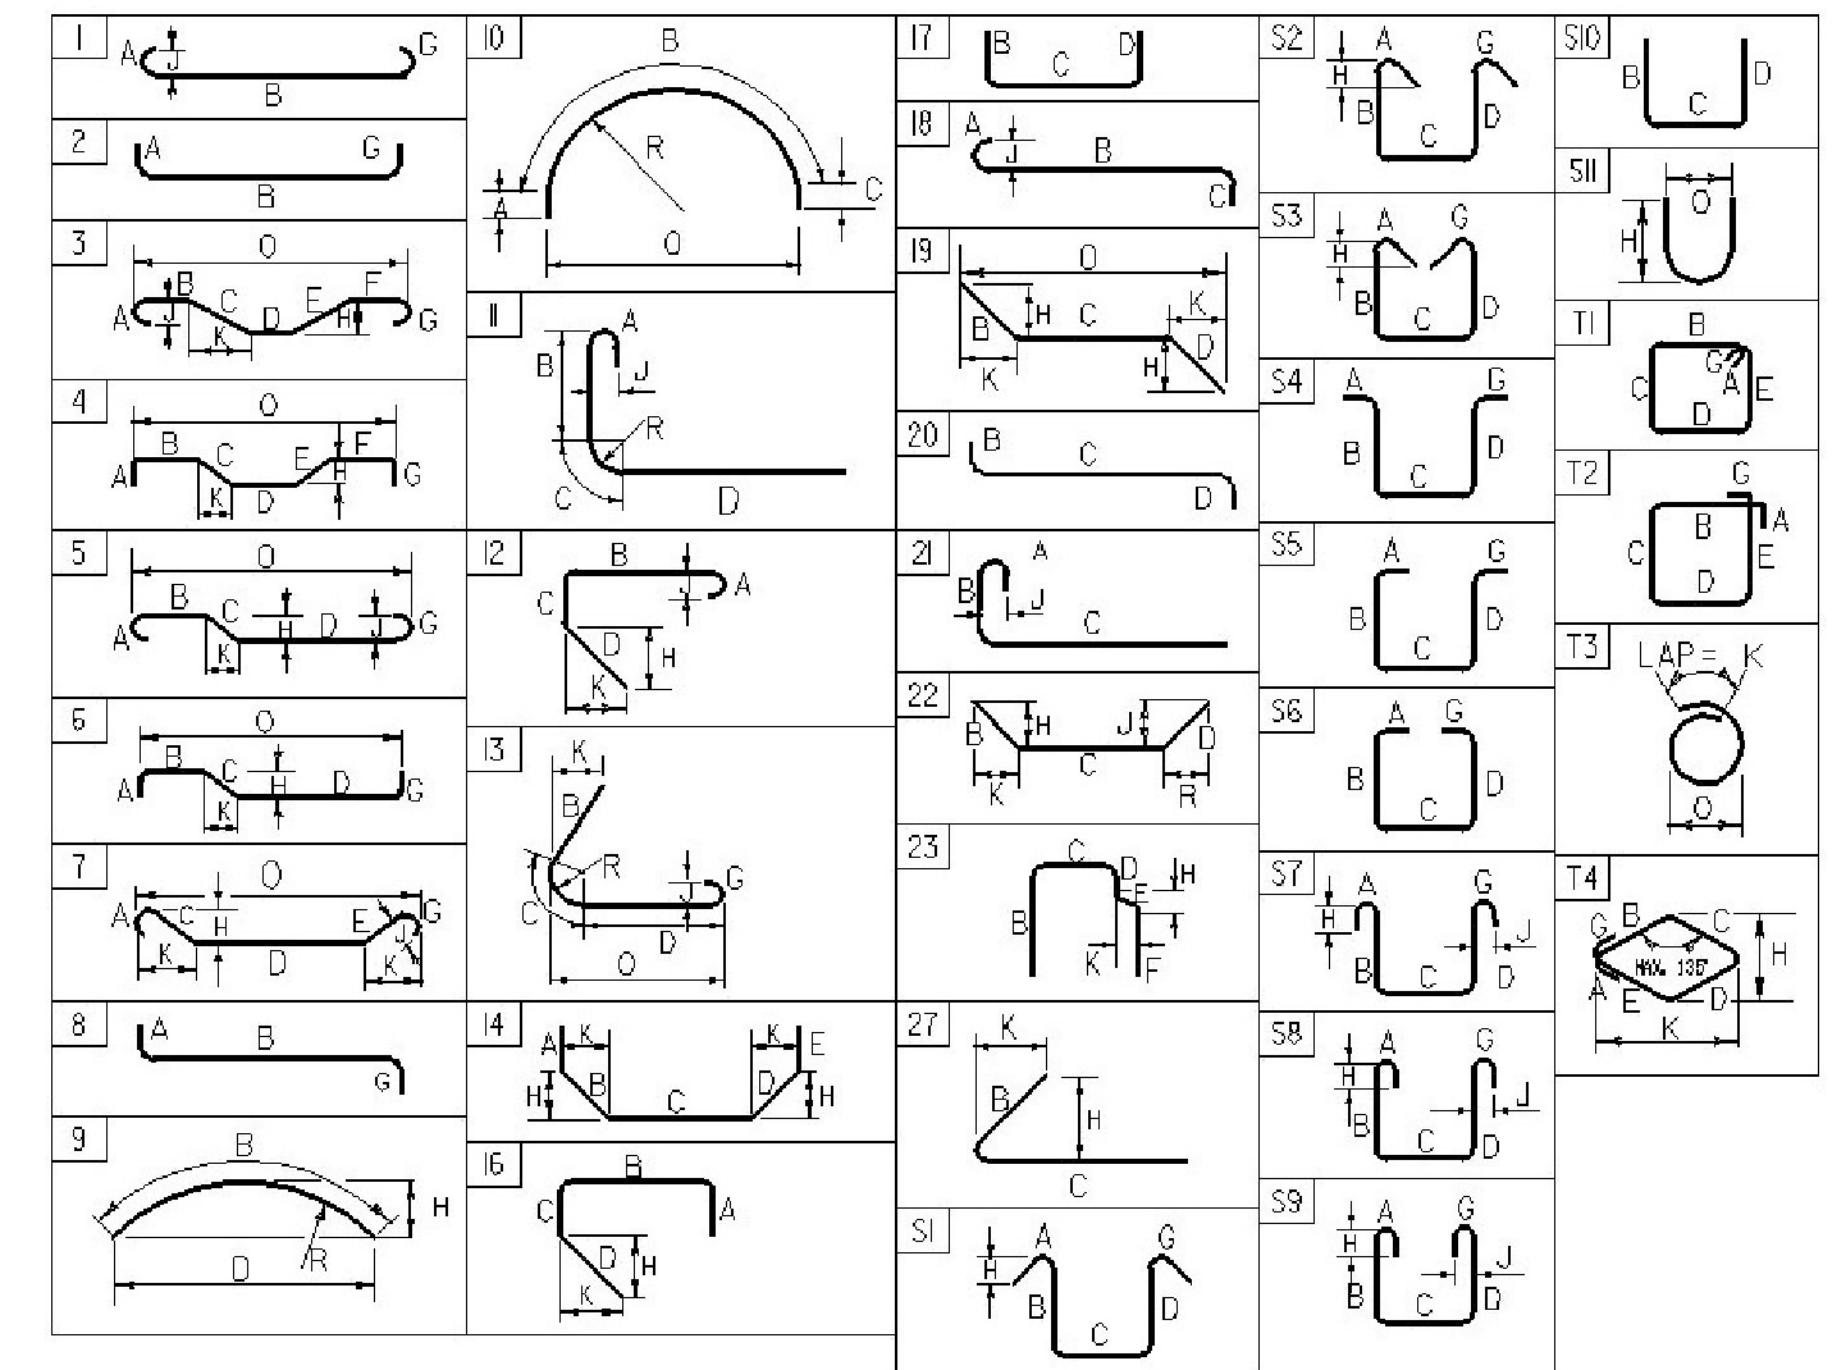

ASTM STANDARD
REINFORCING BARS

Bar Size	Weight (lb/ft)	Area (sq in)	Yield (ksi)	Tensile (ksi)
#3	0.376	0.375	0.11	1.178
#4	0.668	0.500	0.20	1.571
#5	1.043	0.625	0.31	1.963
#6	1.502	0.750	0.44	2.356
#7	2.04	0.875	0.60	2.749
#8	2.670	1.000	0.79	3.14
#9	3.400	1.13	1.00	3.54
#10	4.3	1.270	1.27	3.990
#11	5.31	1.410	1.56	4.430
#14	7.65	1.69	2.25	5.32
#18	13.60	2.26	4.00	7.09

~ REINFORCING STEEL CORROSION RESISTANCE LEVEL ~

THE REINFORCING STEEL MARKS IN THIS SCHEDULE INDICATE THE REQUIRED BAR CORROSION RESISTANCE LEVEL. CORROSION RESISTANCE LEVEL IS DENOTED WITH A .2 FOR LEVEL TWO SUFFIX OR .3 FOR LEVEL THREE SUFFIX. 1 FOR LEVEL ONE IS TO BE OMITTED. THE BAR MATERIAL TYPE AND BAR STEEL GRADE PROVIDED FOR EACH CORROSION LEVEL WILL BE RECORDED ON THE PLAN SET PI SHEET FOR AS-BUILT RECORD PLAN ARCHIVES.

REVISION	DATE	DESCRIPTION	BY
1	01-05-2015	REINFORCING STEEL SCHEDULE UPDATE, ADDED TEST BARS	RK

PROJECT NAME:	HARTFORD
PROJECT NUMBER:	IM 091-2 (79)
FILE NAME:	s12a132RSS_43S.dgn
PROJECT MANAGER:	K. HIGGINS
DESIGNED BY:	R. KLINEFELTER
RSS SUPERSTRUCTURE	43S
PLOT DATE:	1/5/2015
DRAWN BY:	K. FRIEDLAND
CHECKED BY:	J. GRIGAS
SHEET	125 OF 166