


MATCHLINE STA 352+75.00

EPSC DURING CONSTRUCTION SHEET 1

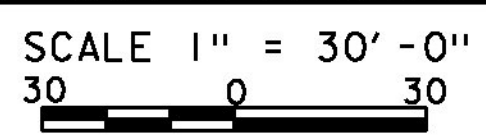

PROJECT NAME:	HARTFORD	PLOT DATE:	15-DEC-2014
PROJECT NUMBER:	IM 091-2(79)	DRAWN BY:	K. FRIEDLAND
FILE NAME:	s12a132bdr_ero.dur.dgn	CHECKED BY:	J. SALVATORI
DESIGNED BY:	W. LAMMER	SHEET	133 OF 166
EPSC DURING CONSTRUCTION SHEET 1			