


MATCHLINE STA 352+75.00

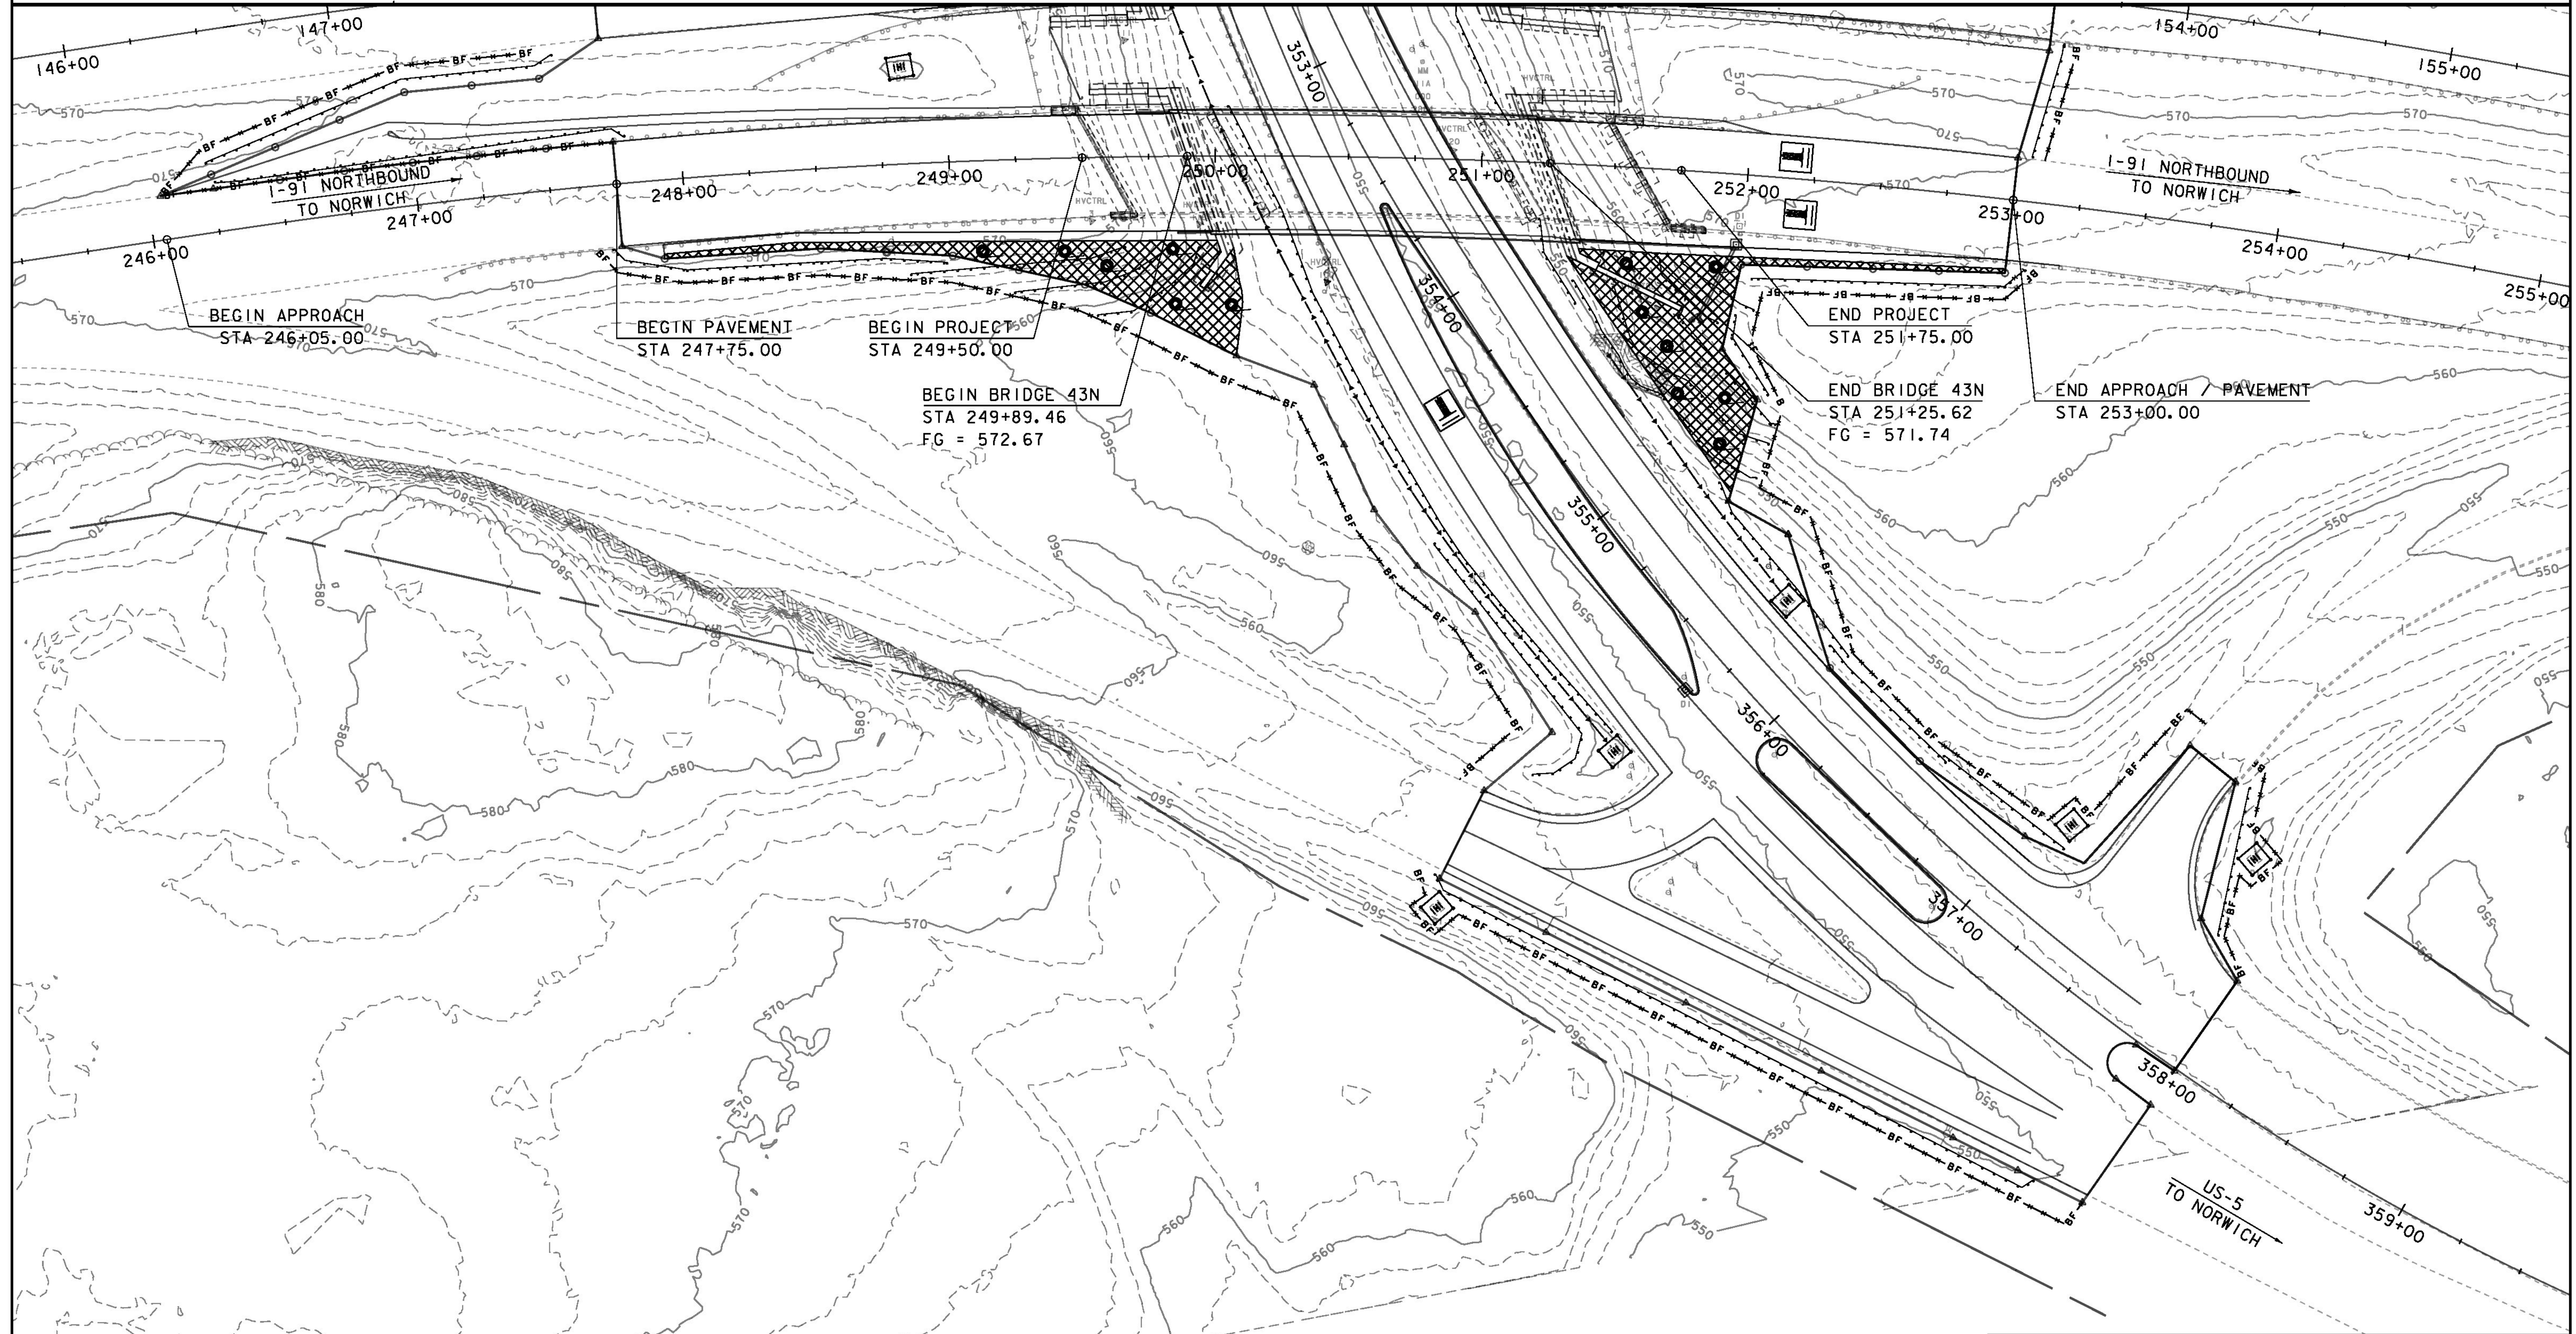

NOTES:  
1. TEMPORARY CRANE PAD TO BE DESIGNED BY CONTRACTOR.

**EPSC DURING CONSTRUCTION SHEET 2**

SCALE 1" = 30'-0"  
30 0 30

|                                  |                        |             |              |
|----------------------------------|------------------------|-------------|--------------|
| PROJECT NAME:                    | HARTFORD               | PLOT DATE:  | 15-DEC-2014  |
| PROJECT NUMBER:                  | IM 091-2(79)           | DRAWN BY:   | K. FRIEDLAND |
| FILE NAME:                       | st2a132bdr_ero.dur.dgn | CHECKED BY: | J. SALVATORI |
| DESIGNED BY:                     | W. LAMMER              | SHEET       | 134 OF 166   |
| EPSC DURING CONSTRUCTION SHEET 2 |                        |             |              |