


MATCHLINE STA 352+75.00

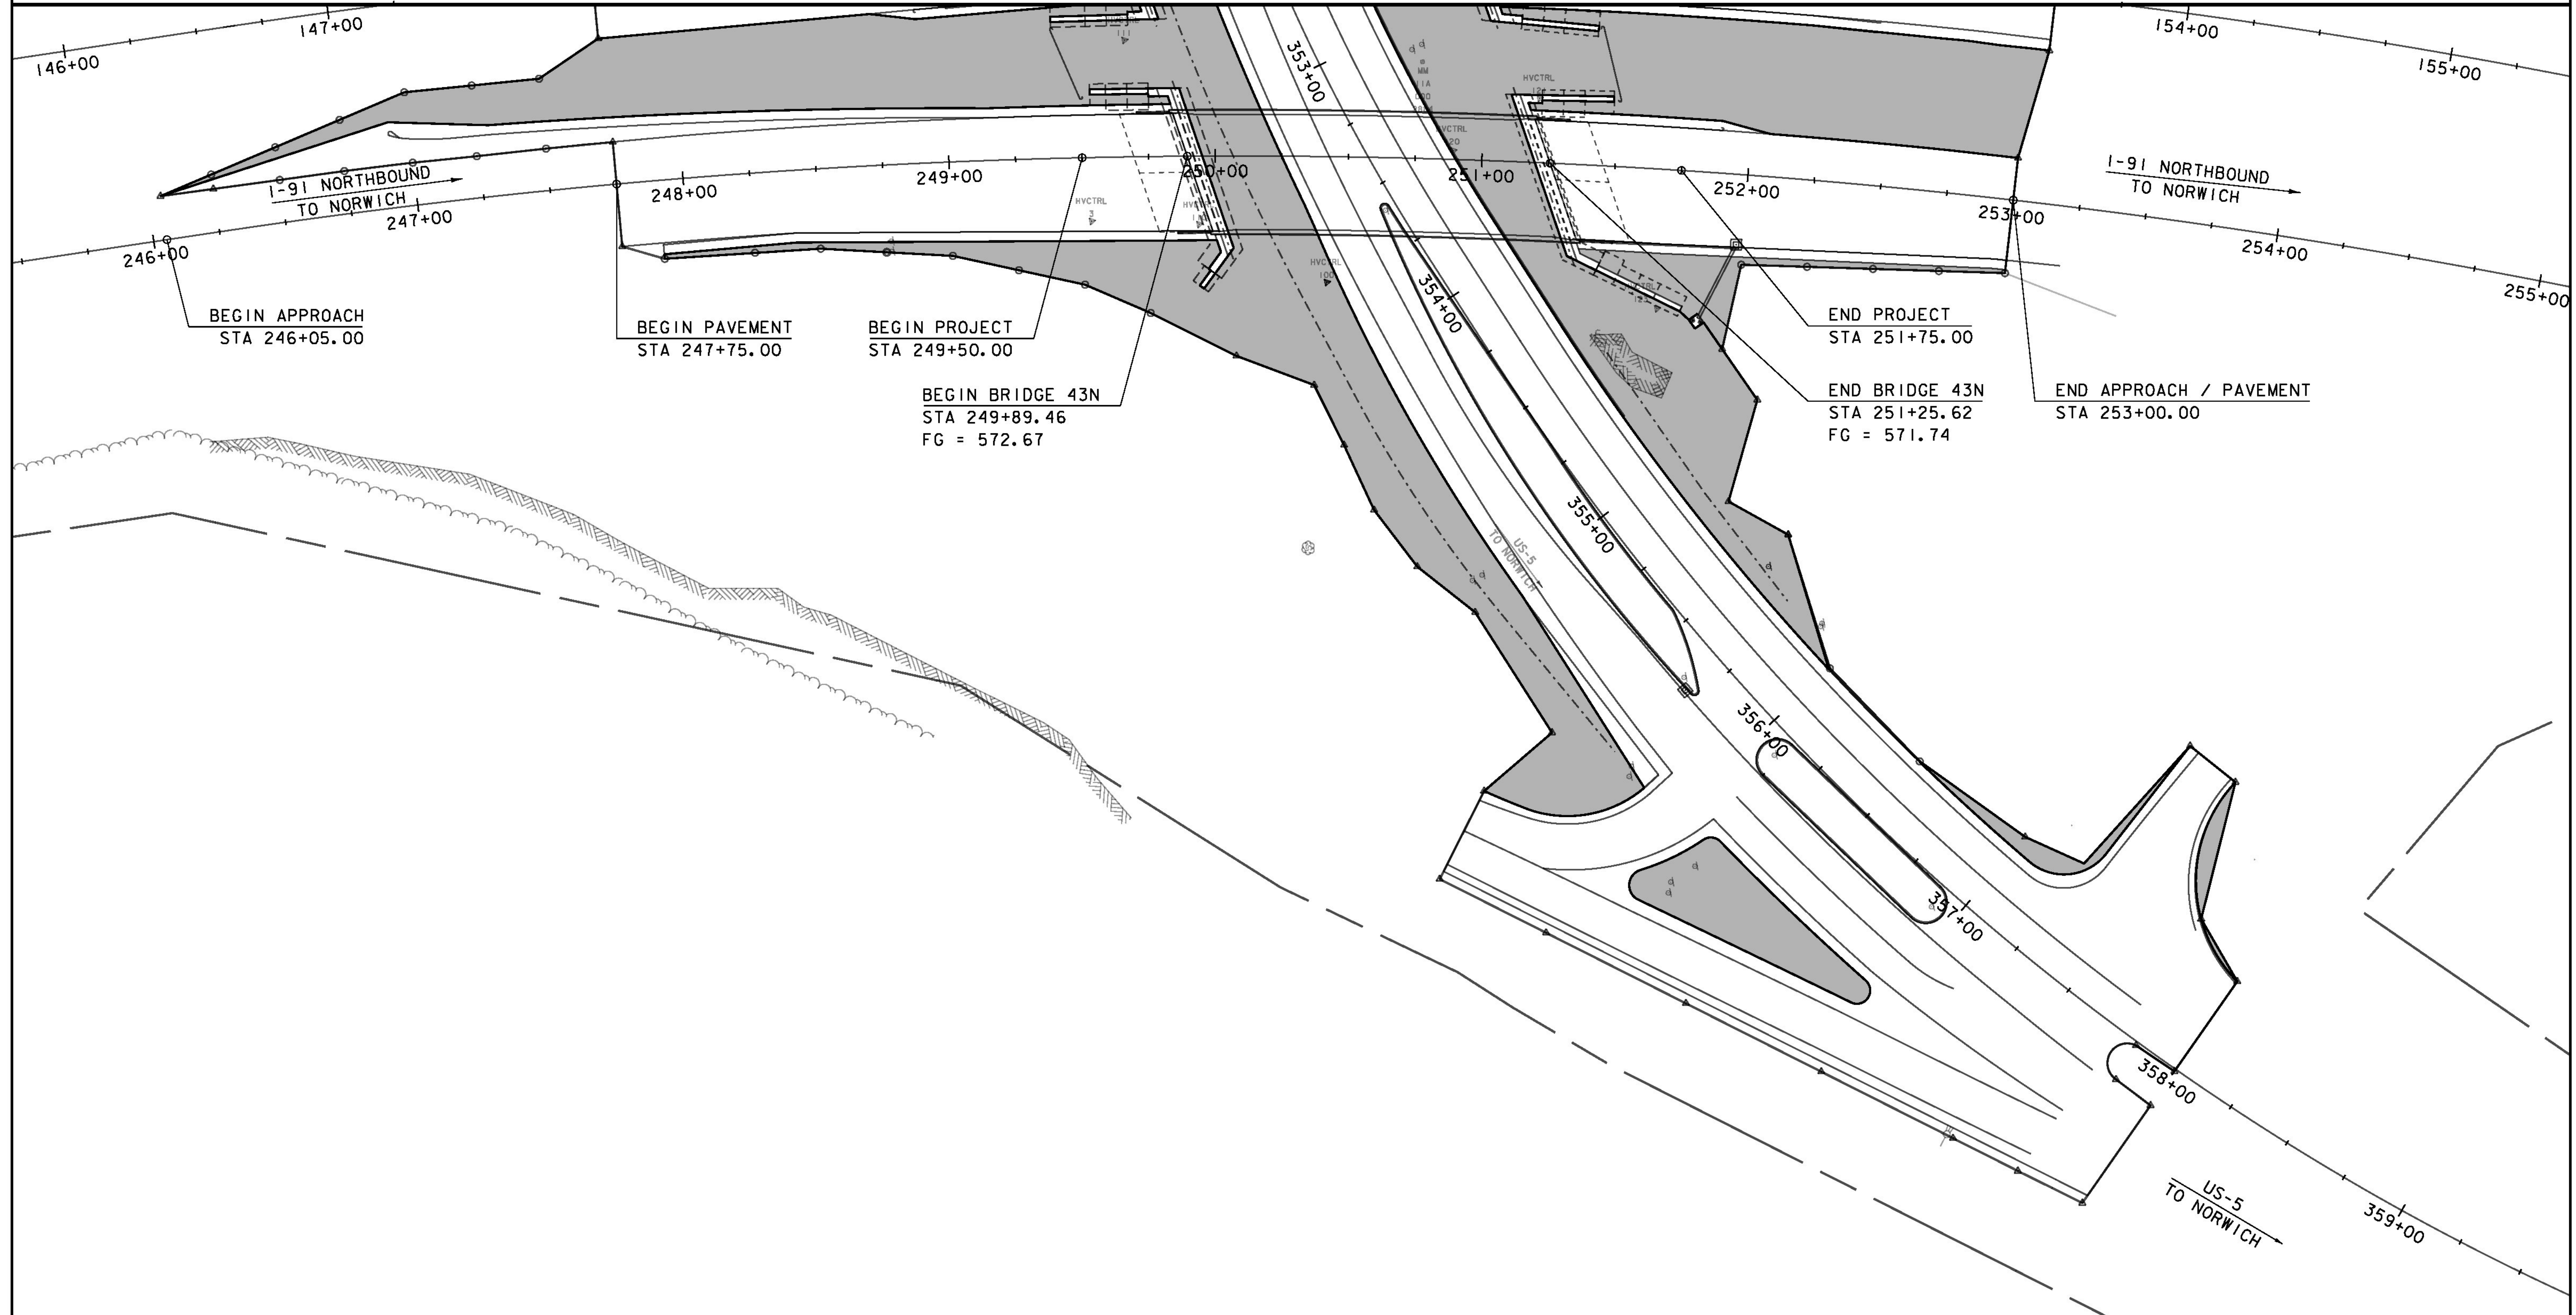

■ AREAS OF EARTH DISTURBANCE THAT WILL REQUIRE REVEGETATION.

EPSC FINAL CONDITIONS SHEET 2

SCALE 1" = 30'-0"
30 0 30

PROJECT NAME:	HARTFORD	PLOT DATE:	15-DEC-2014
PROJECT NUMBER:	IM 091-2(79)	DRAWN BY:	K. FRIEDLAND
FILE NAME:	s12a132bdr_ero_final.dgn	CHECKED BY:	J. SALVATORI
DESIGNED BY:	W. LAMMER	SHEET	136 OF 166
EPSC FINAL CONDITIONS SHEET 2			