




148+50

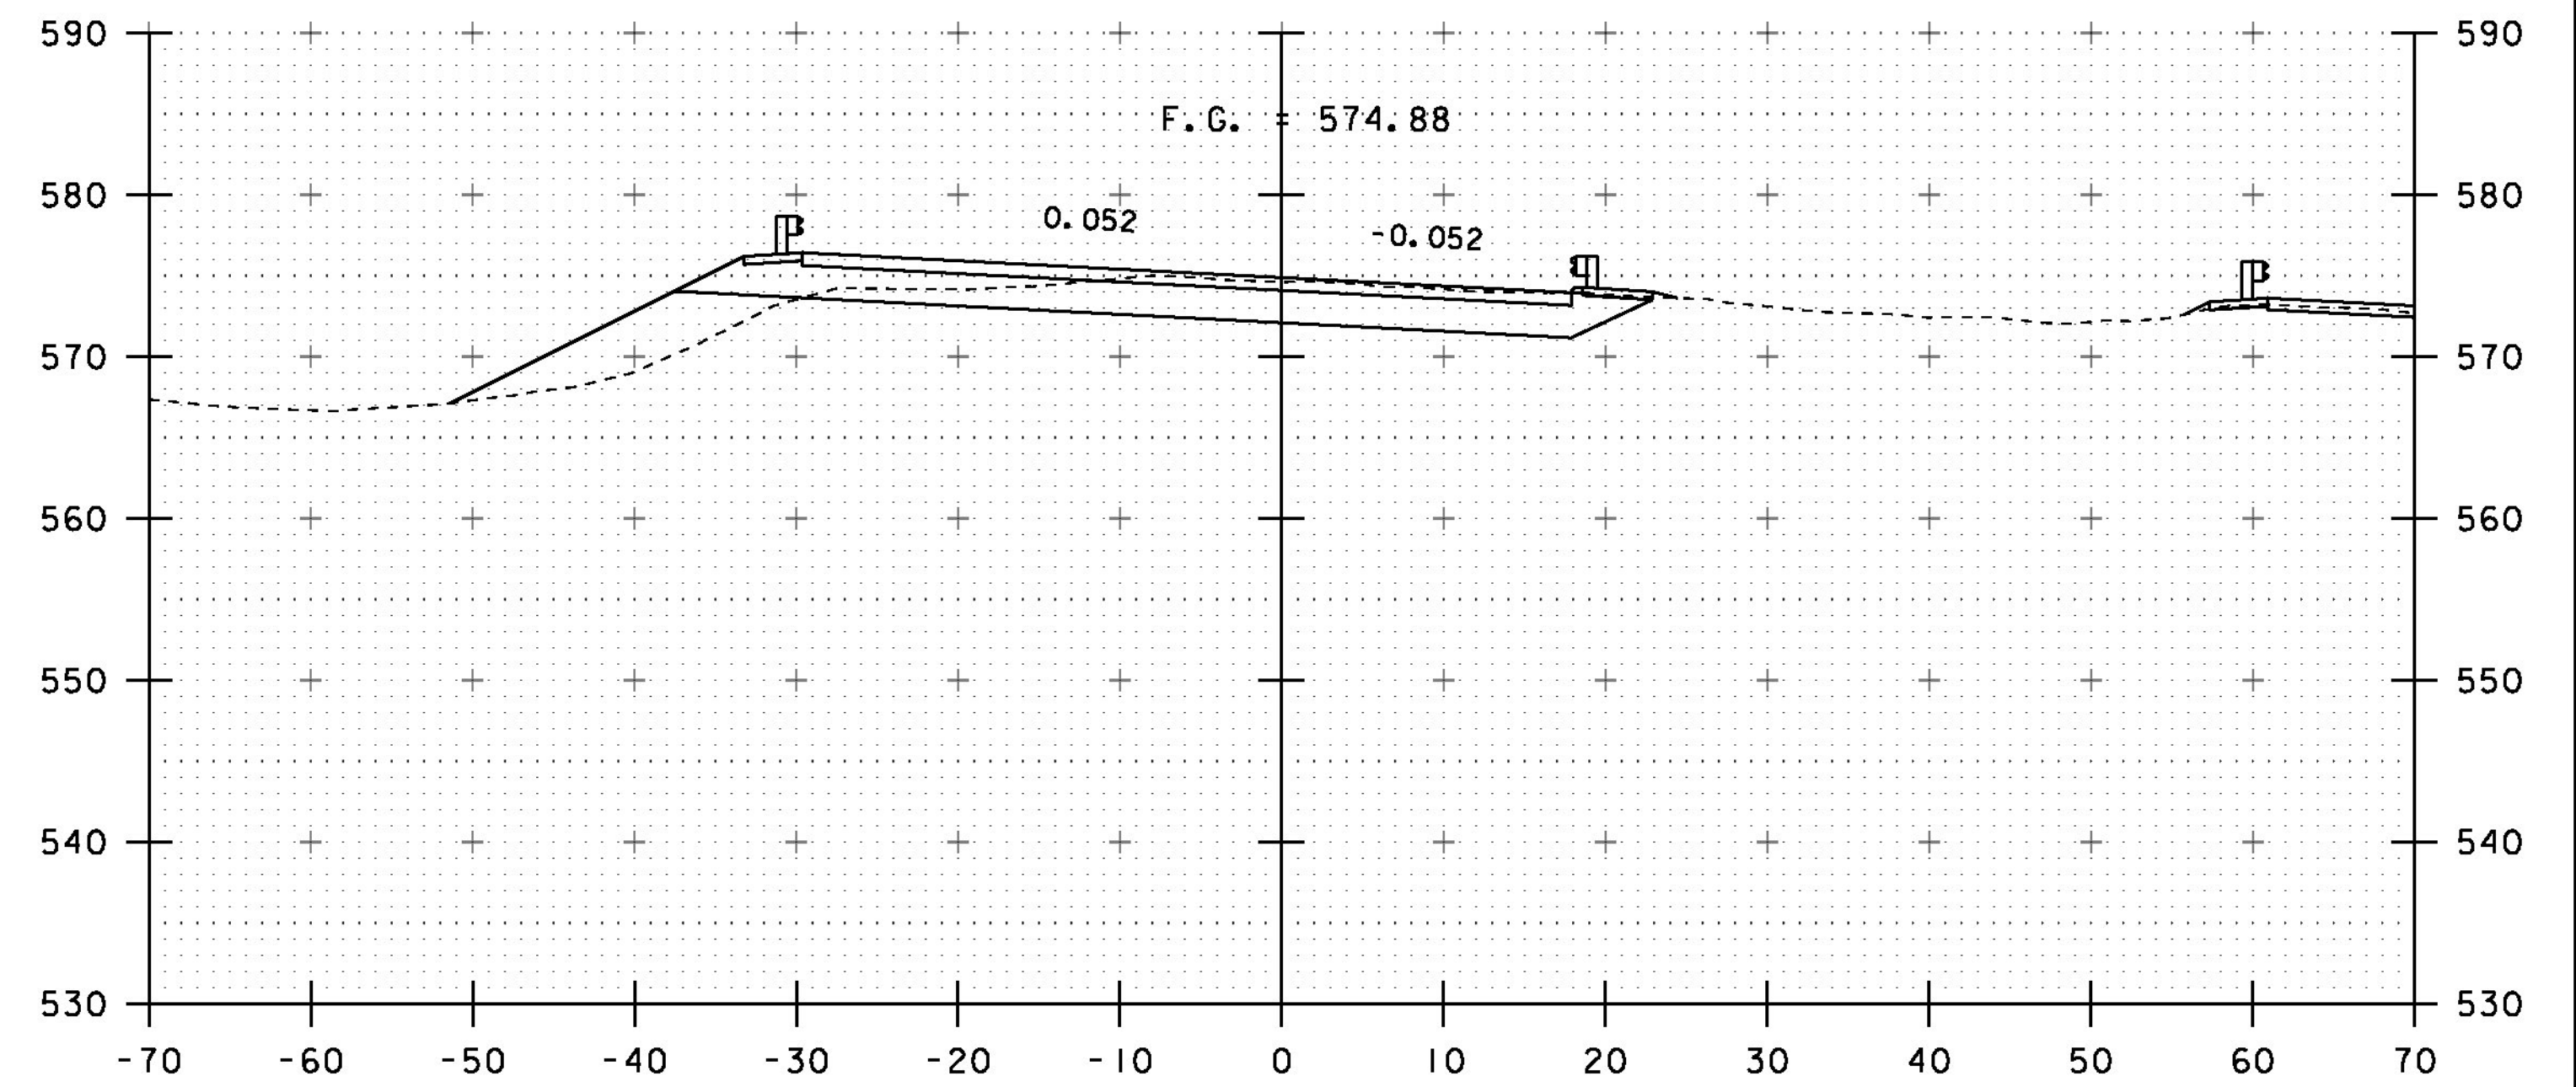

149+50  
BEGIN PROJECT

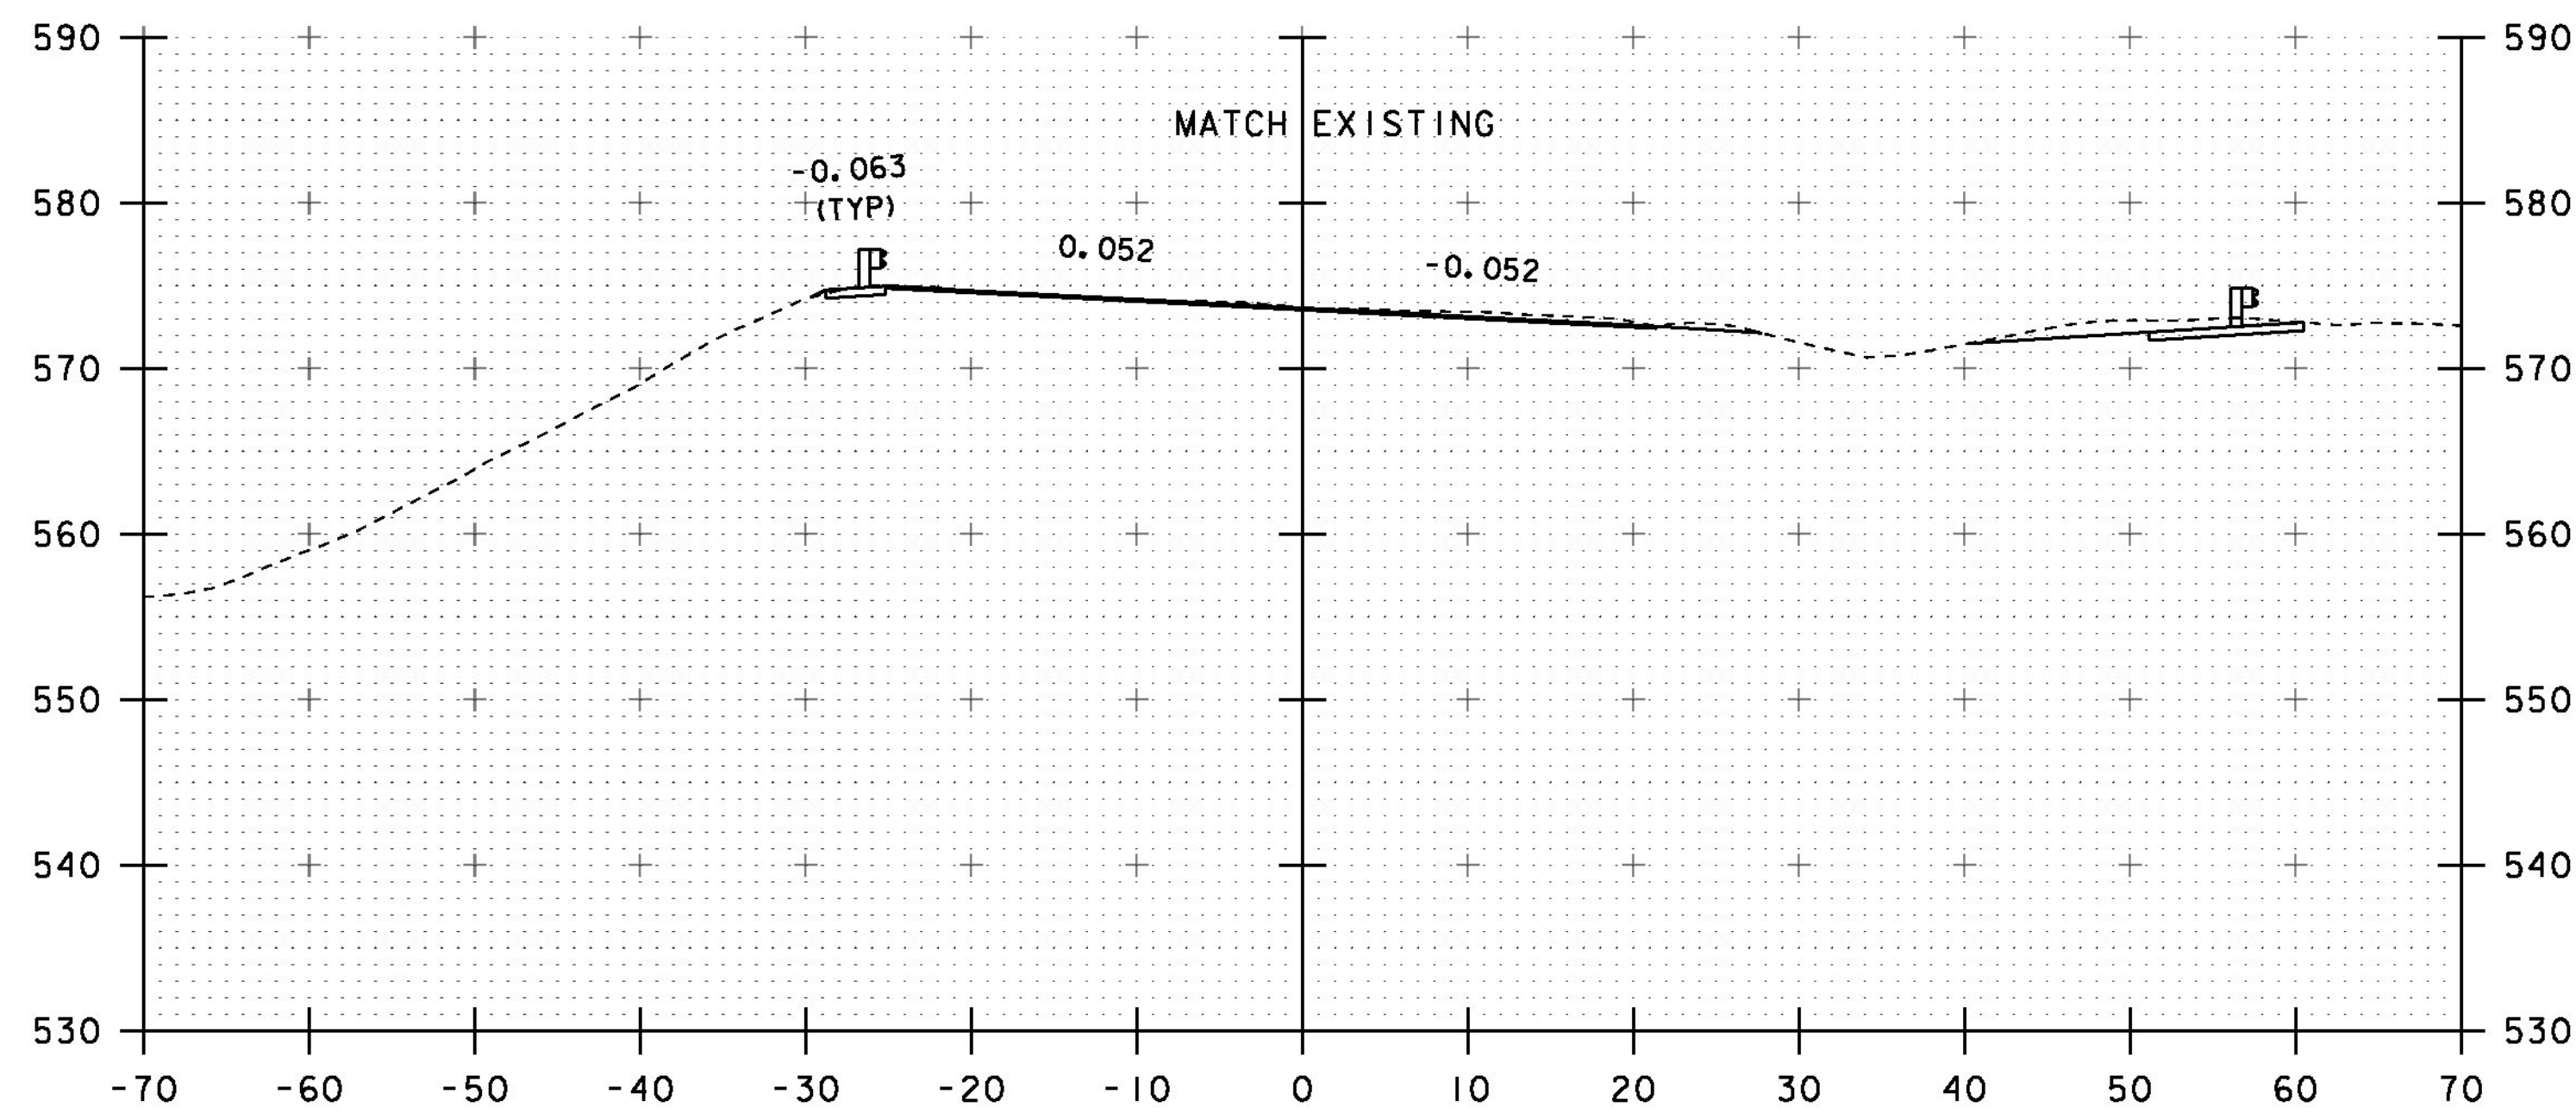

148+00  
BEGIN APPROACH / PAVEMENT

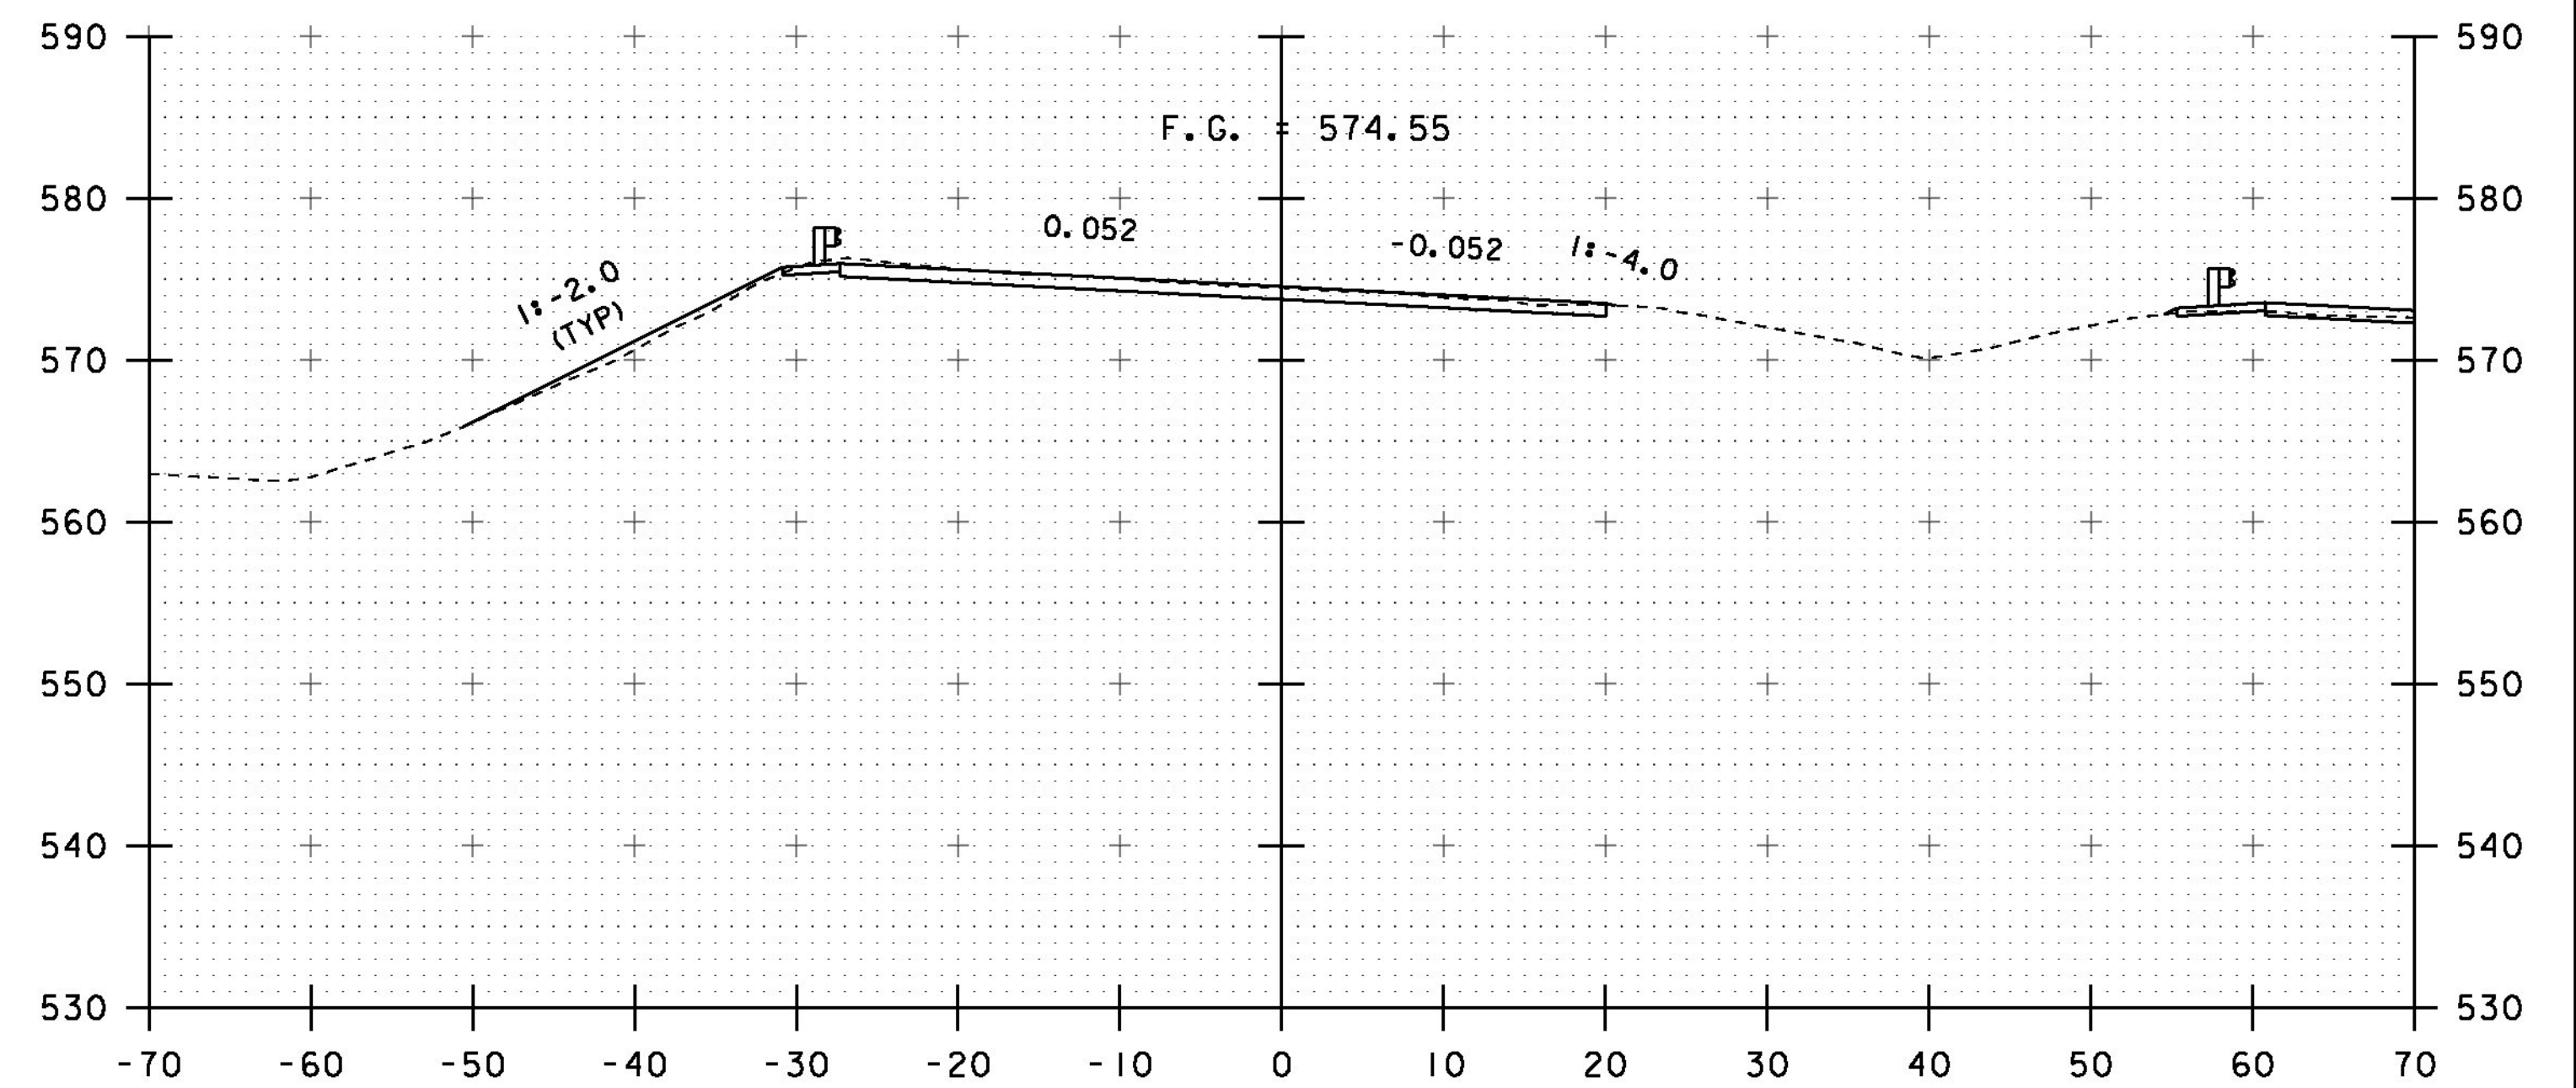

149+00

PROJECT NAME: HARTFORD  
PROJECT NUMBER: IM 09I-2(79)

FILE NAME: s12a132xsec.dgn PLOT DATE: 15-DEC-2014  
PROJECT LEADER: K. HIGGINS DRAWN BY: K. FRIEDLAND  
DESIGNED BY: G. LAROCHE CHECKED BY: W. LAMMER  
I-91 SOUTHBOUND CROSS SECTIONS SHEET 141 OF 166

STA. 148+00 TO STA. 149+50