




150+00  
BEGIN BRIDGE 149+97.96

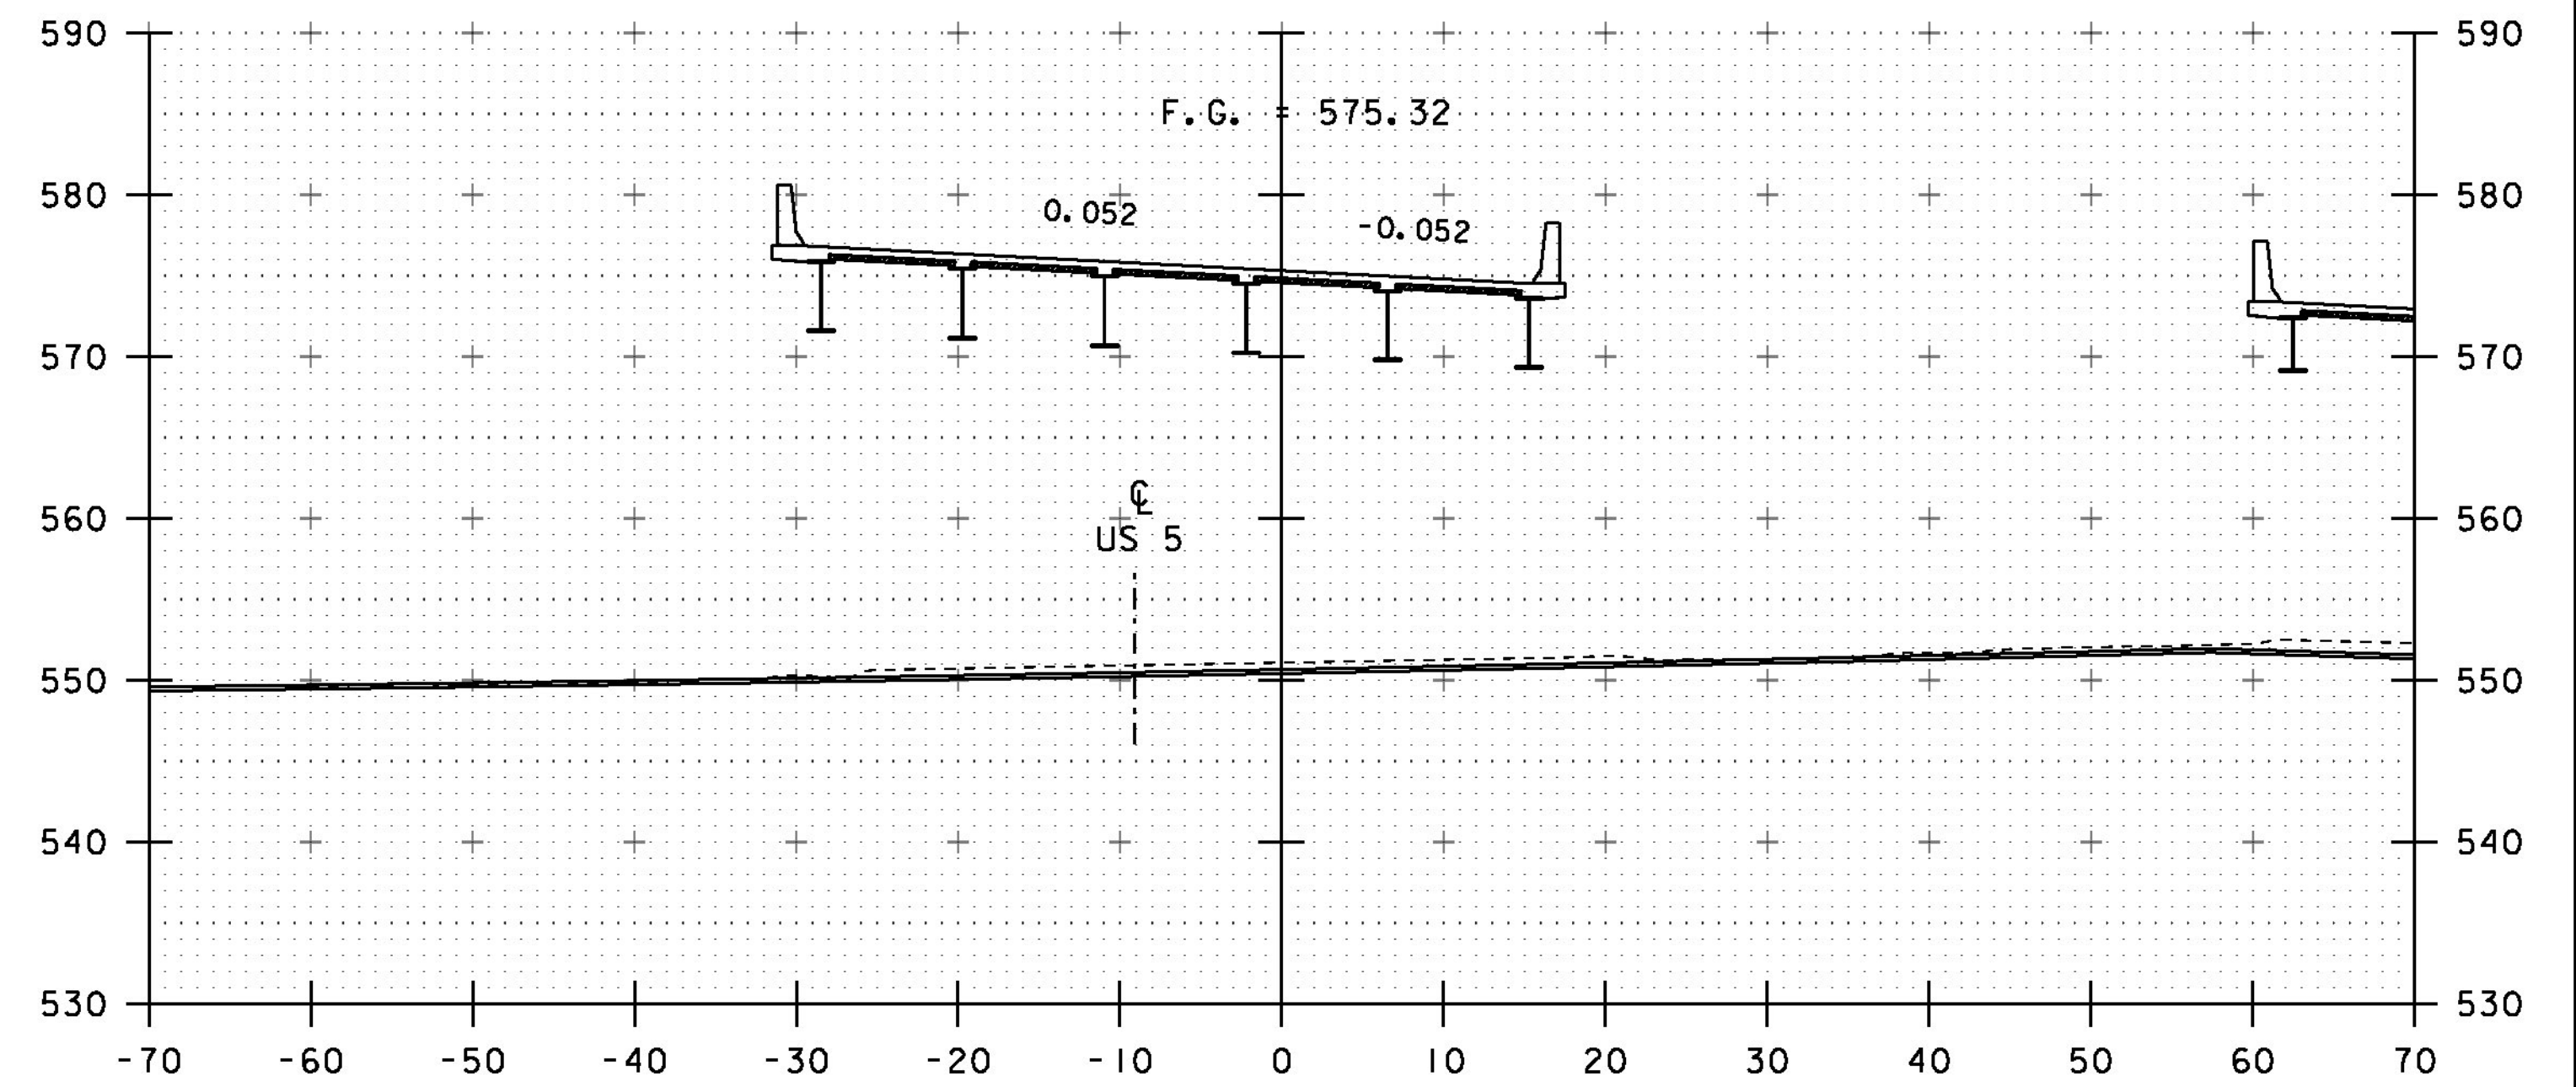

150+50

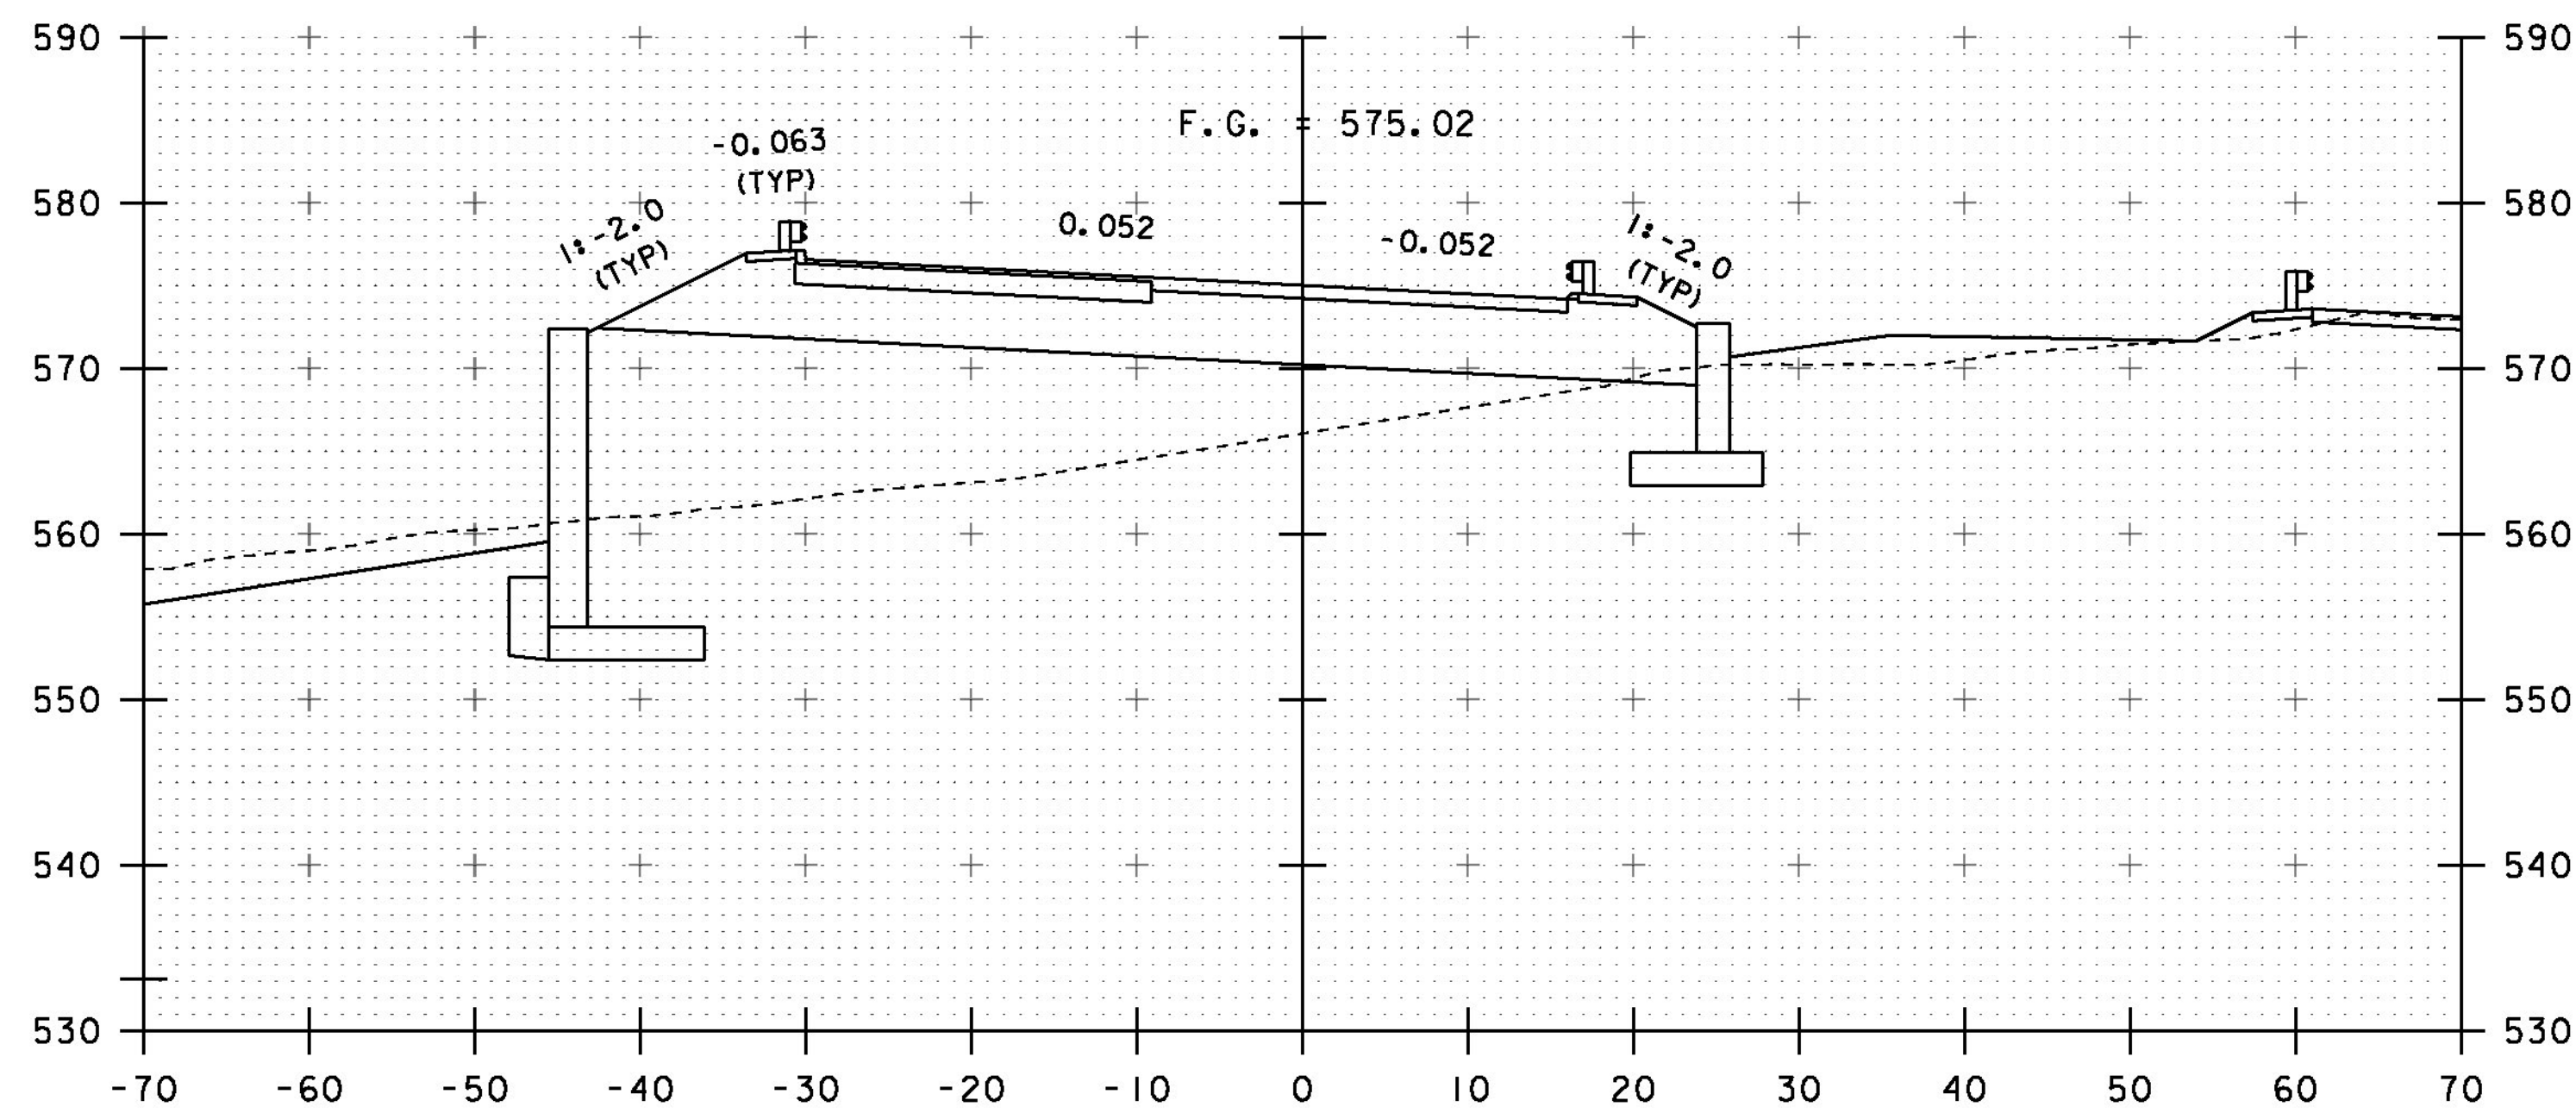

149+75

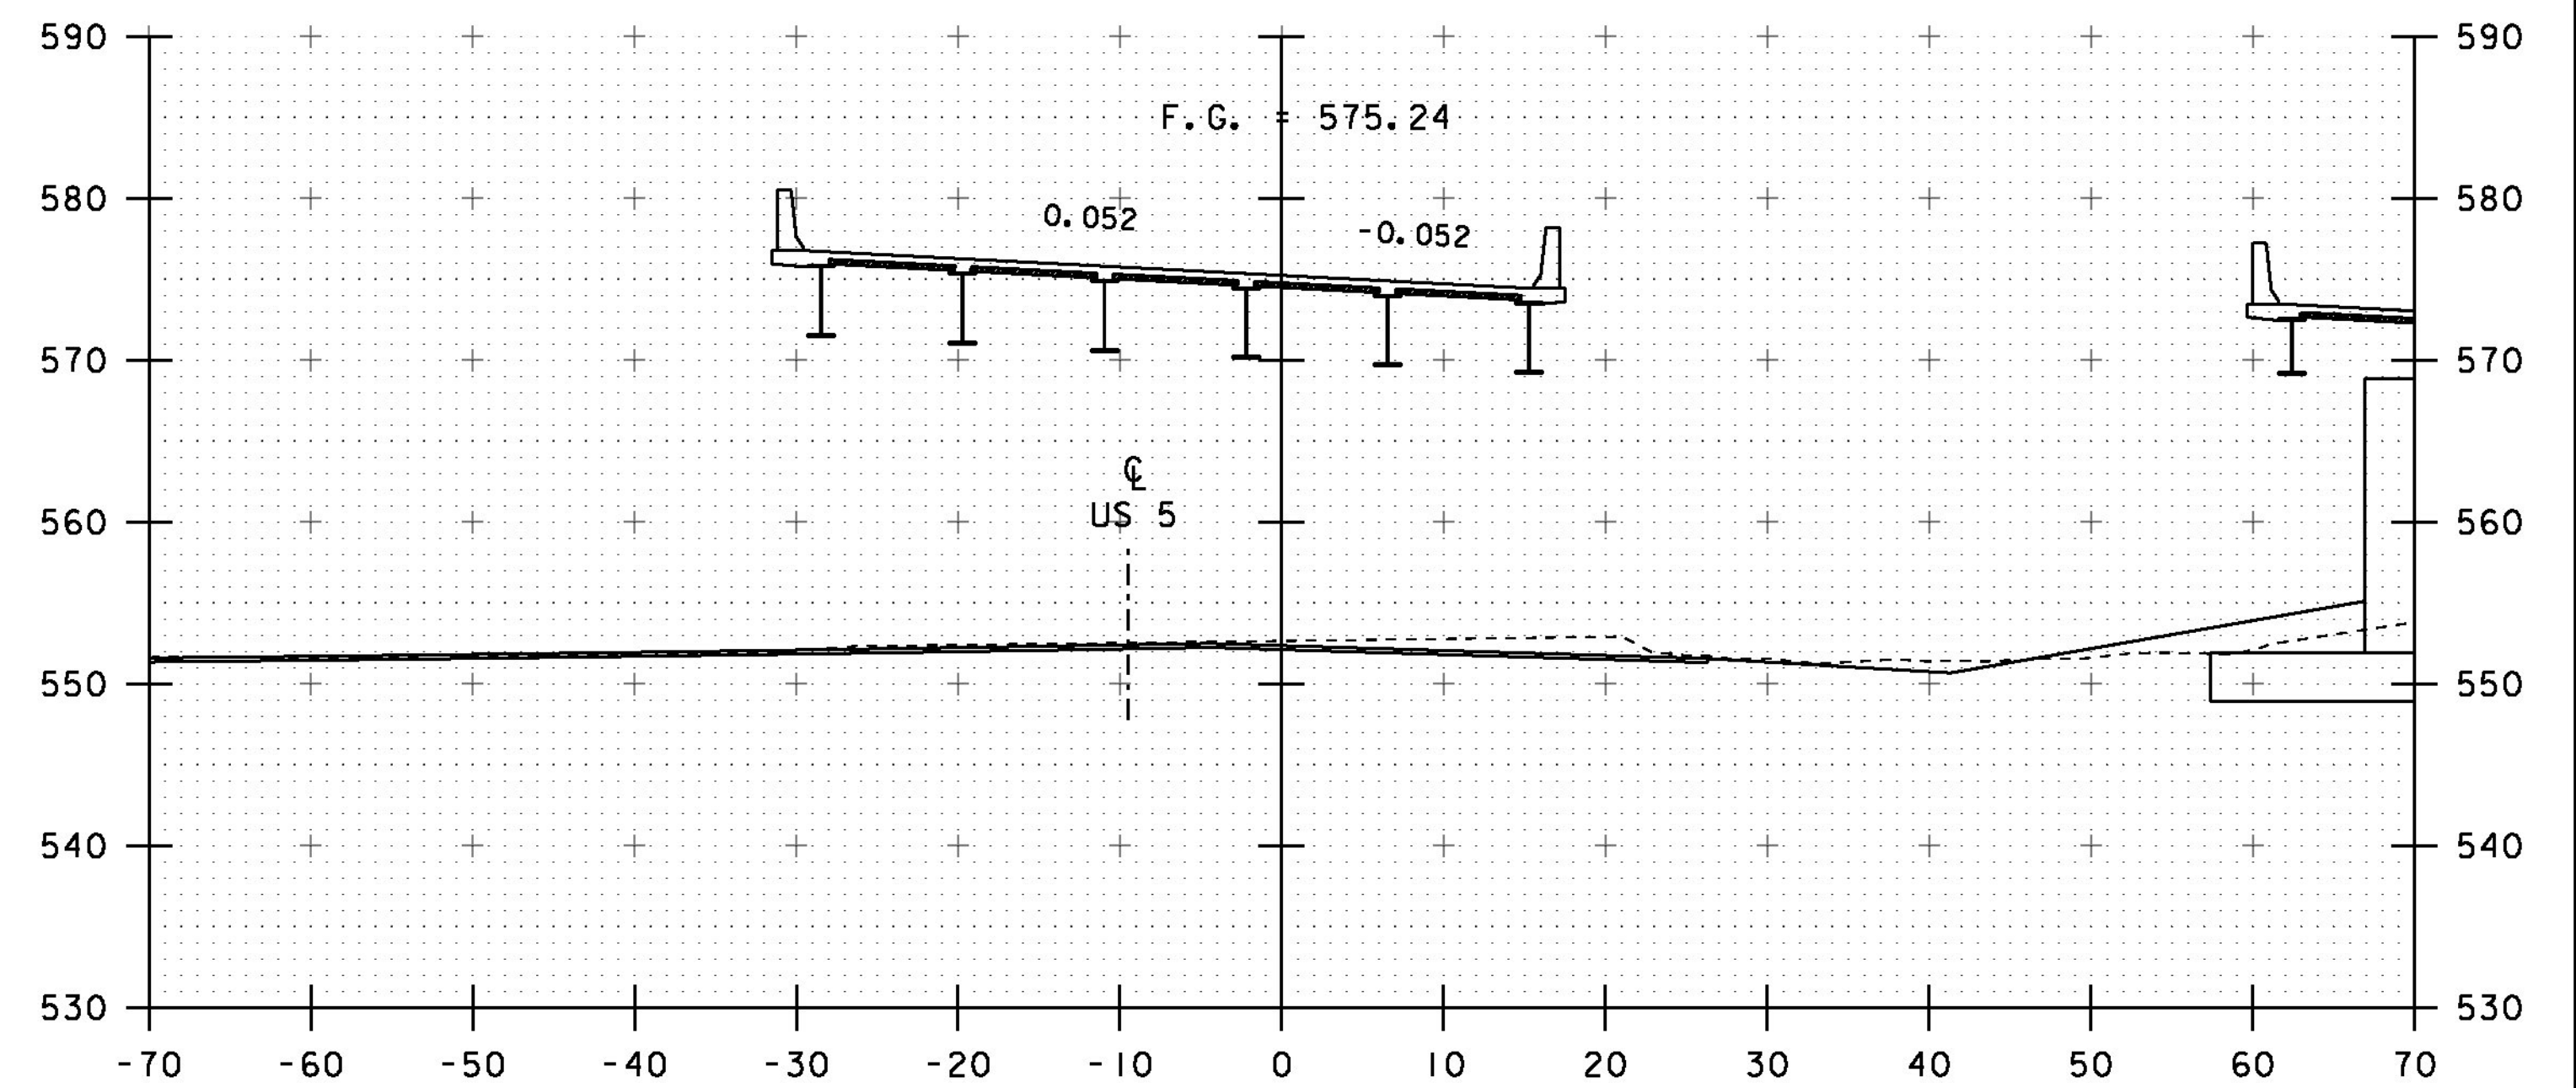

150+25

STA. 149+75 TO STA. 150+50

PROJECT NAME: HARTFORD	PLOT DATE: 15-DEC-2014
PROJECT NUMBER: IM 09I-2(79)	DRAWN BY: K. FRIEDLAND
FILE NAME: s12a132xsec.dgn	DESIGNED BY: G. LAROCHE
PROJECT LEADER: K. HIGGINS	CHECKED BY: W. LAMMER
I-91 SOUTHBOUND CROSS SECTIONS	SHEET 142 OF 166