




151+00

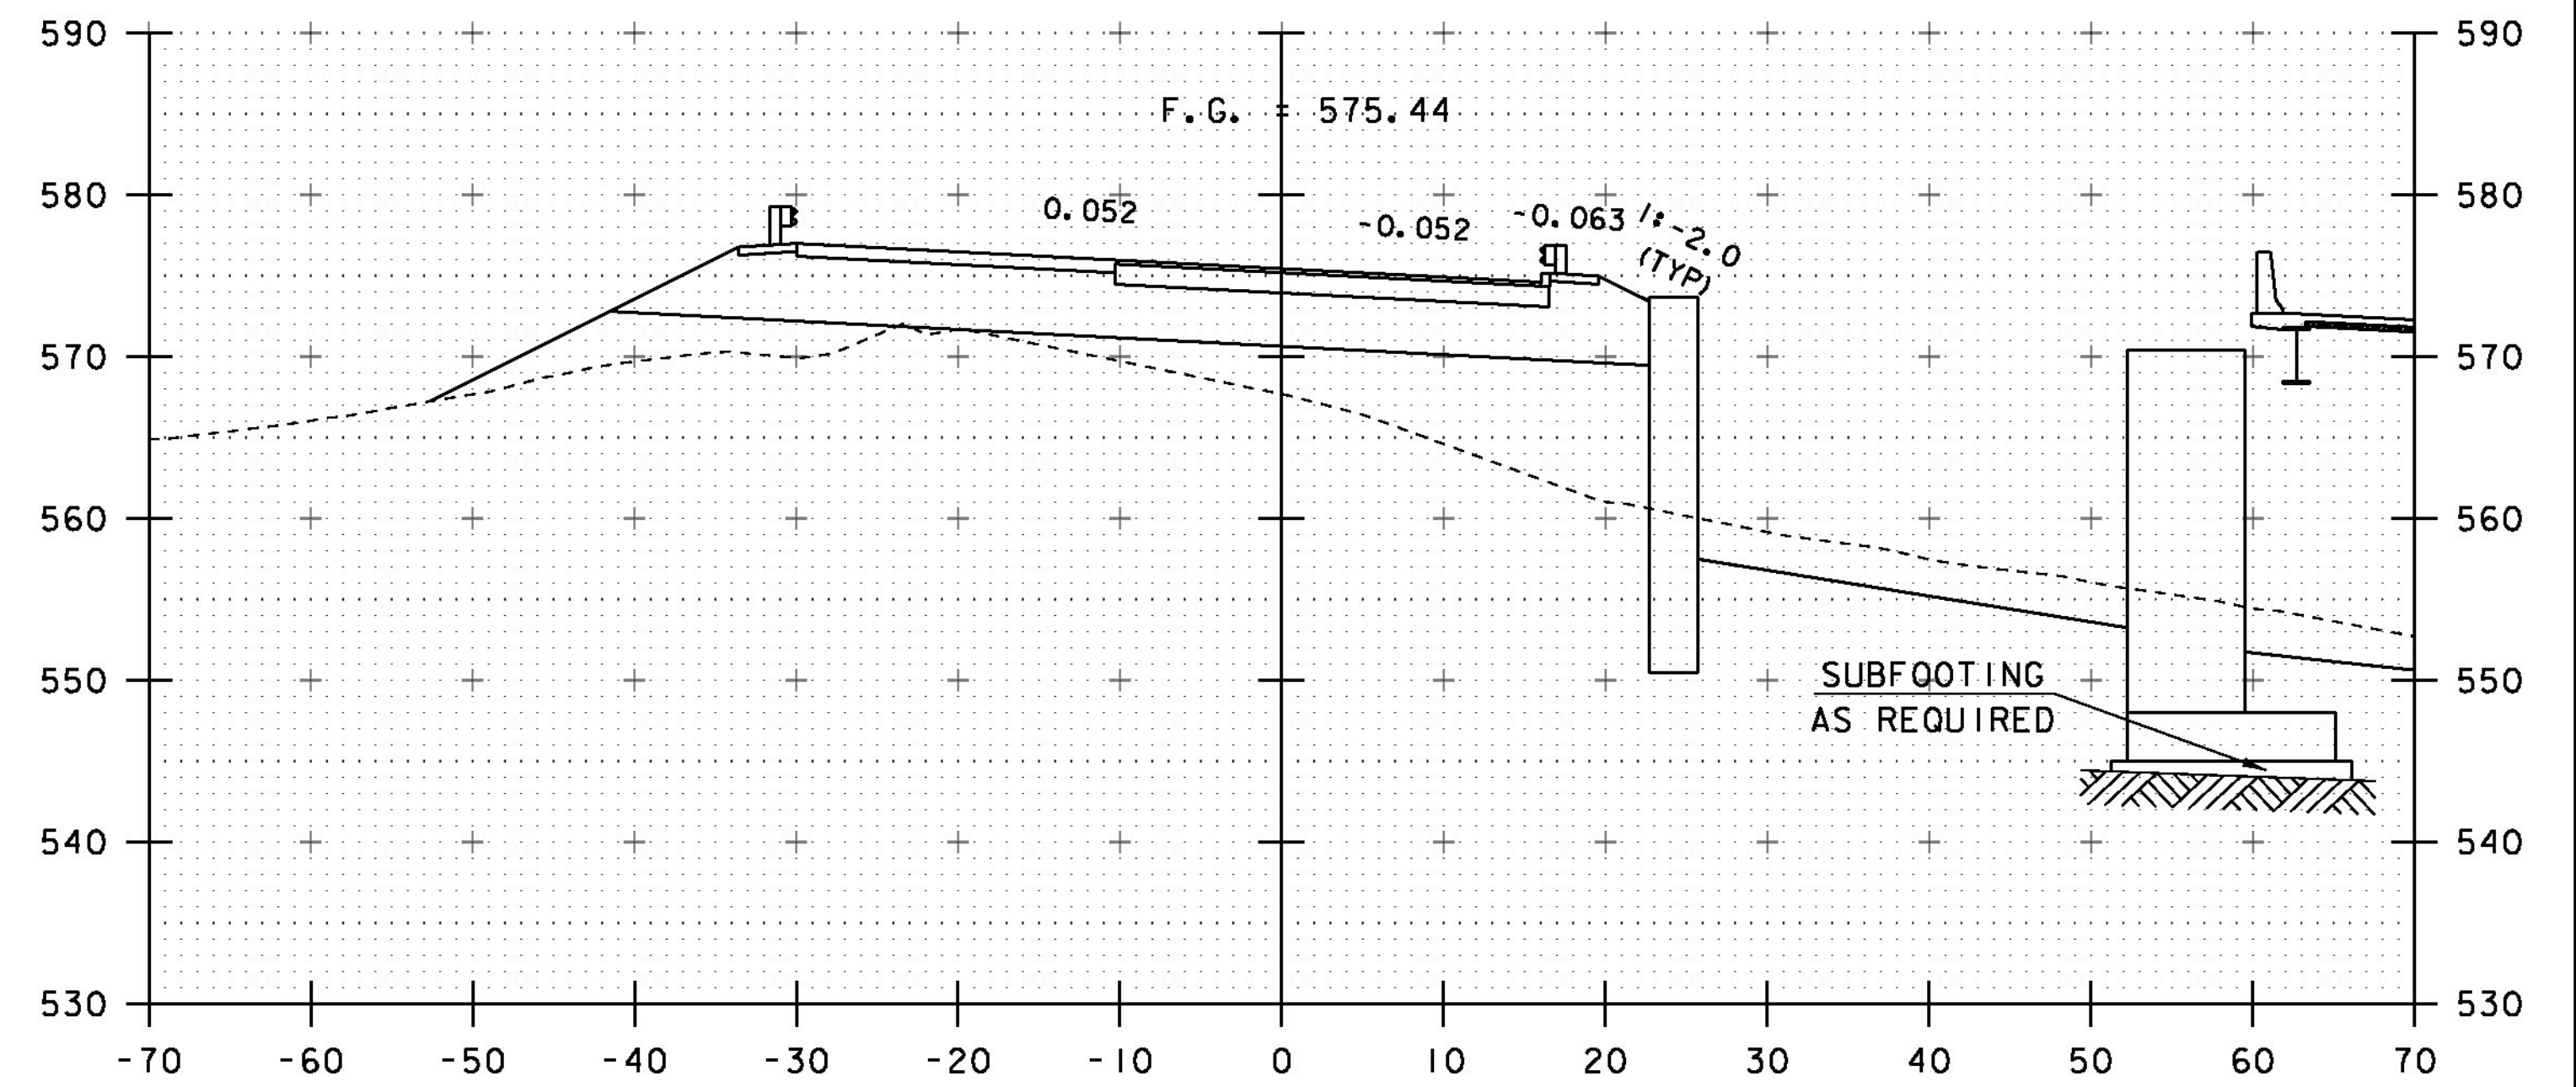

151+50

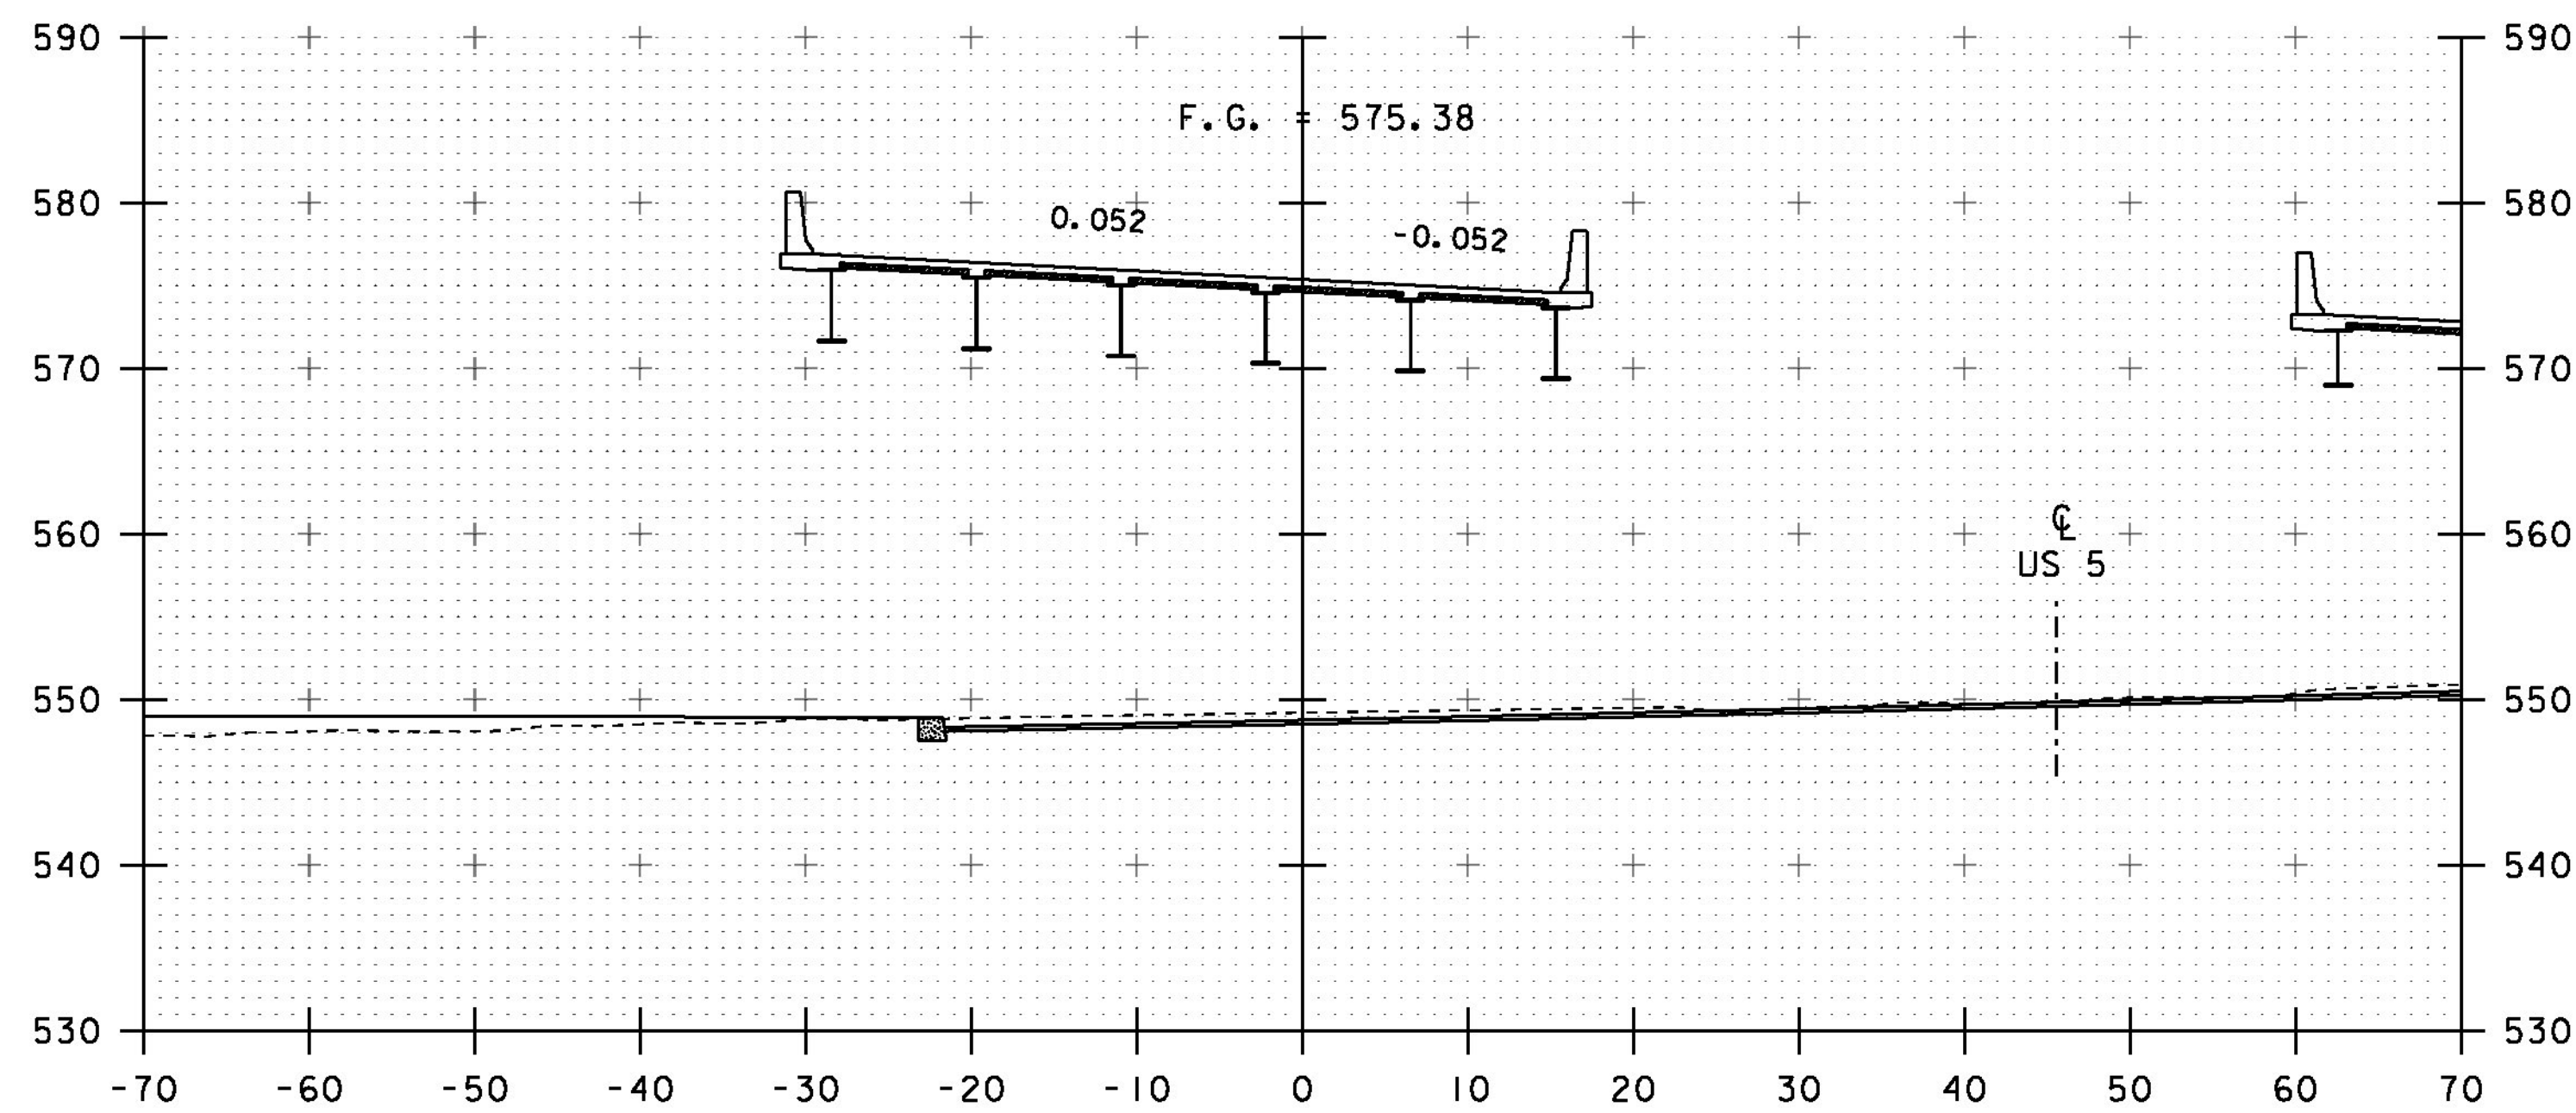

150+75

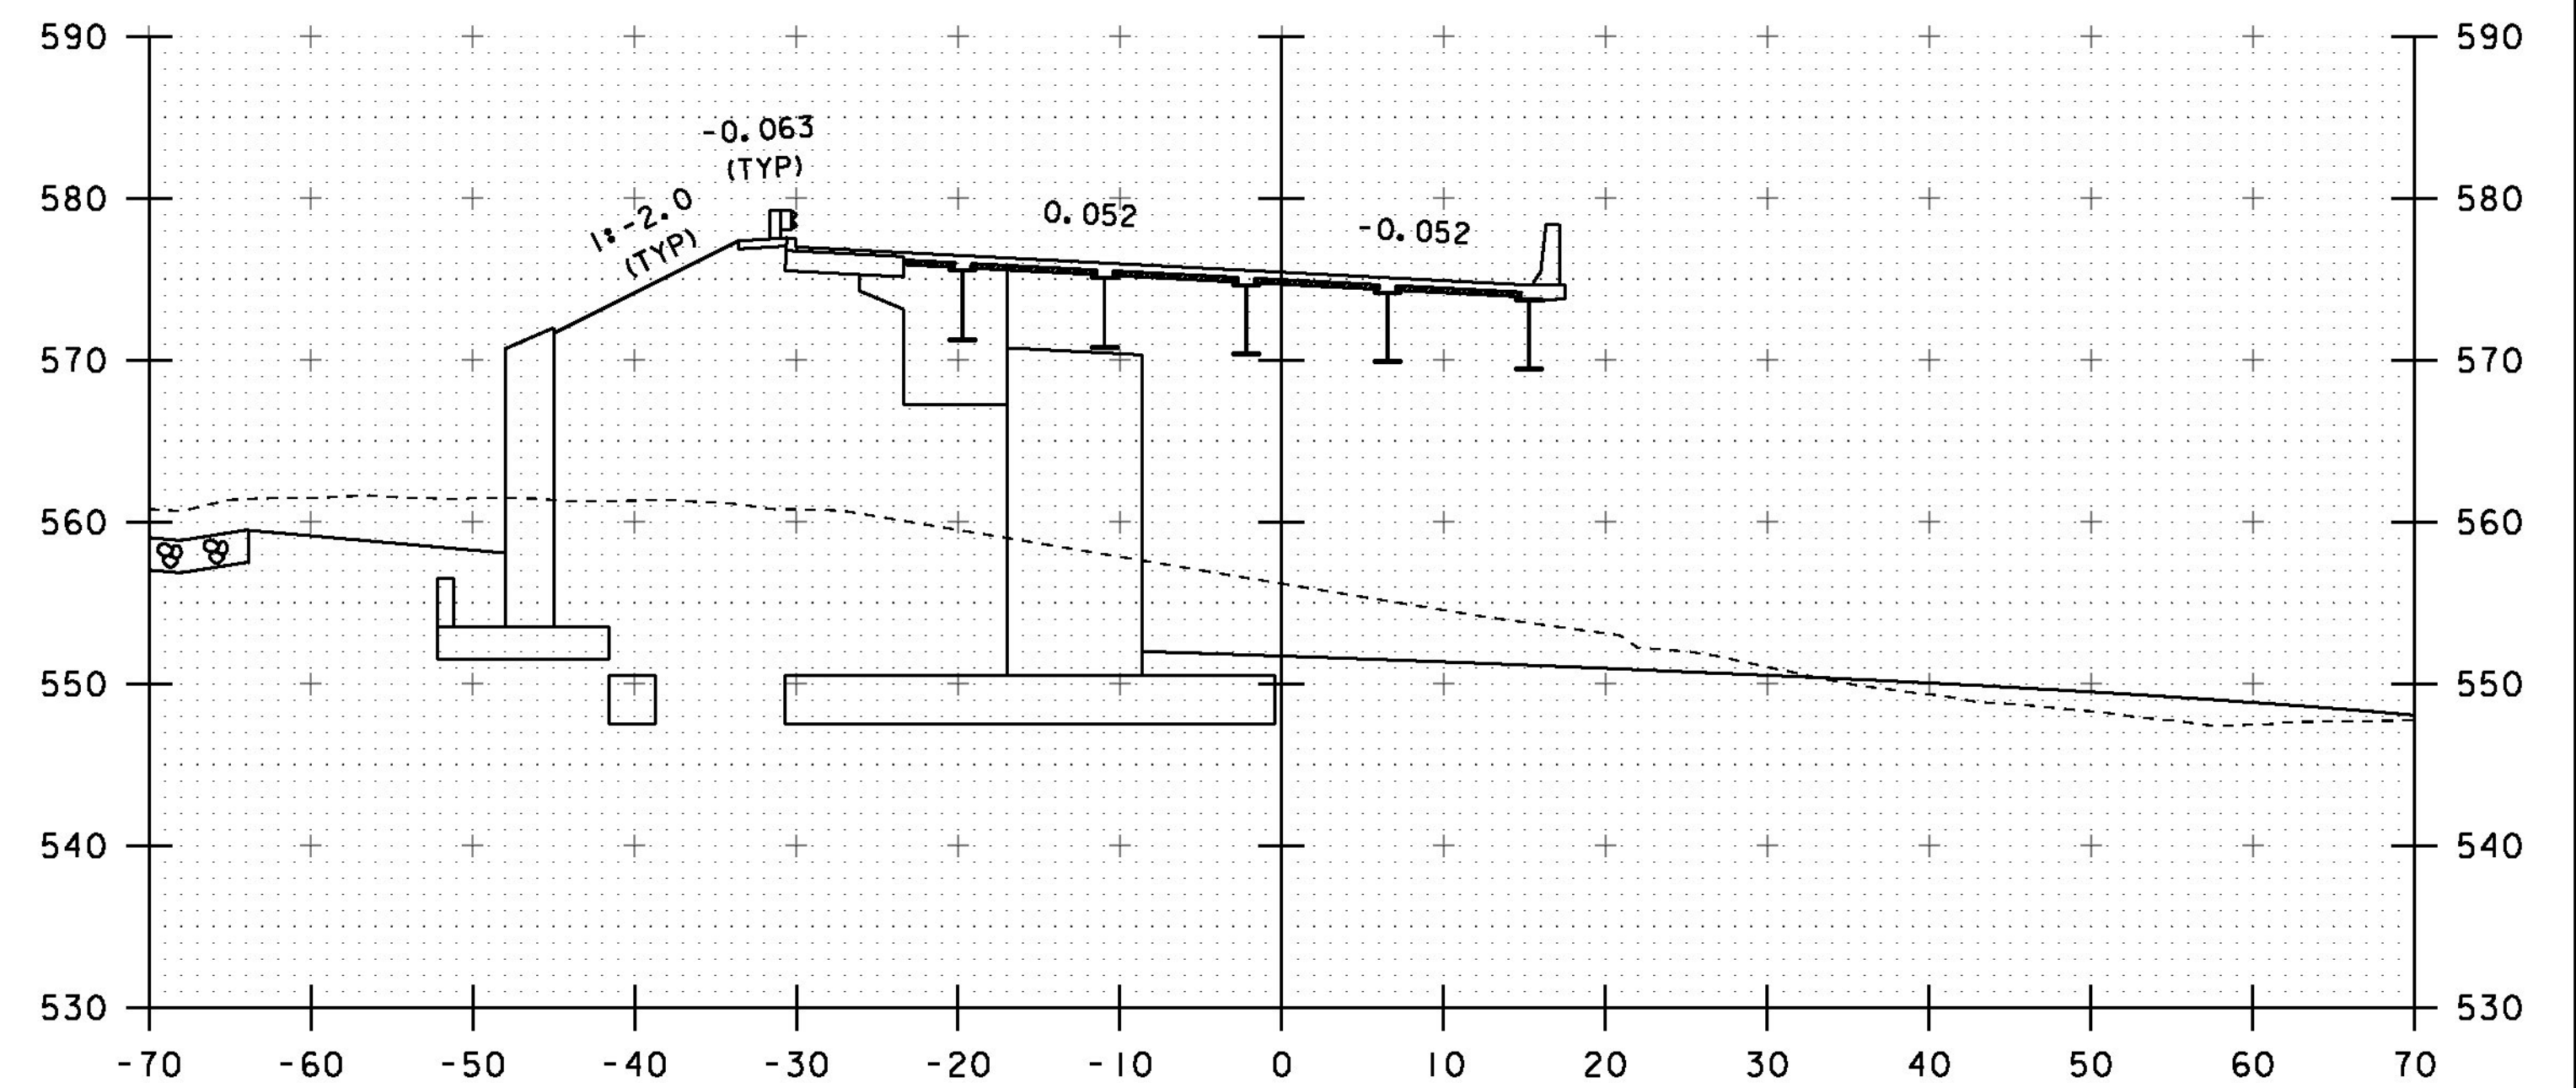

151+25
 END BRIDGE 151+34.12

PROJECT NAME: HARTFORD
 PROJECT NUMBER: IM 091-2(79)

FILE NAME: s12a132xsec.dgn
 PROJECT LEADER: K. HIGGINS
 DESIGNED BY: G. LAROCHE
 I-91 SOUTHBOUND CROSS SECTIONS

PLOT DATE: 15-DEC-2014
 DRAWN BY: K. FRIEDLAND
 CHECKED BY: W. LAMMER
 SHEET 143 OF 166

STA. 150+75 TO STA. 151+50