




154+00

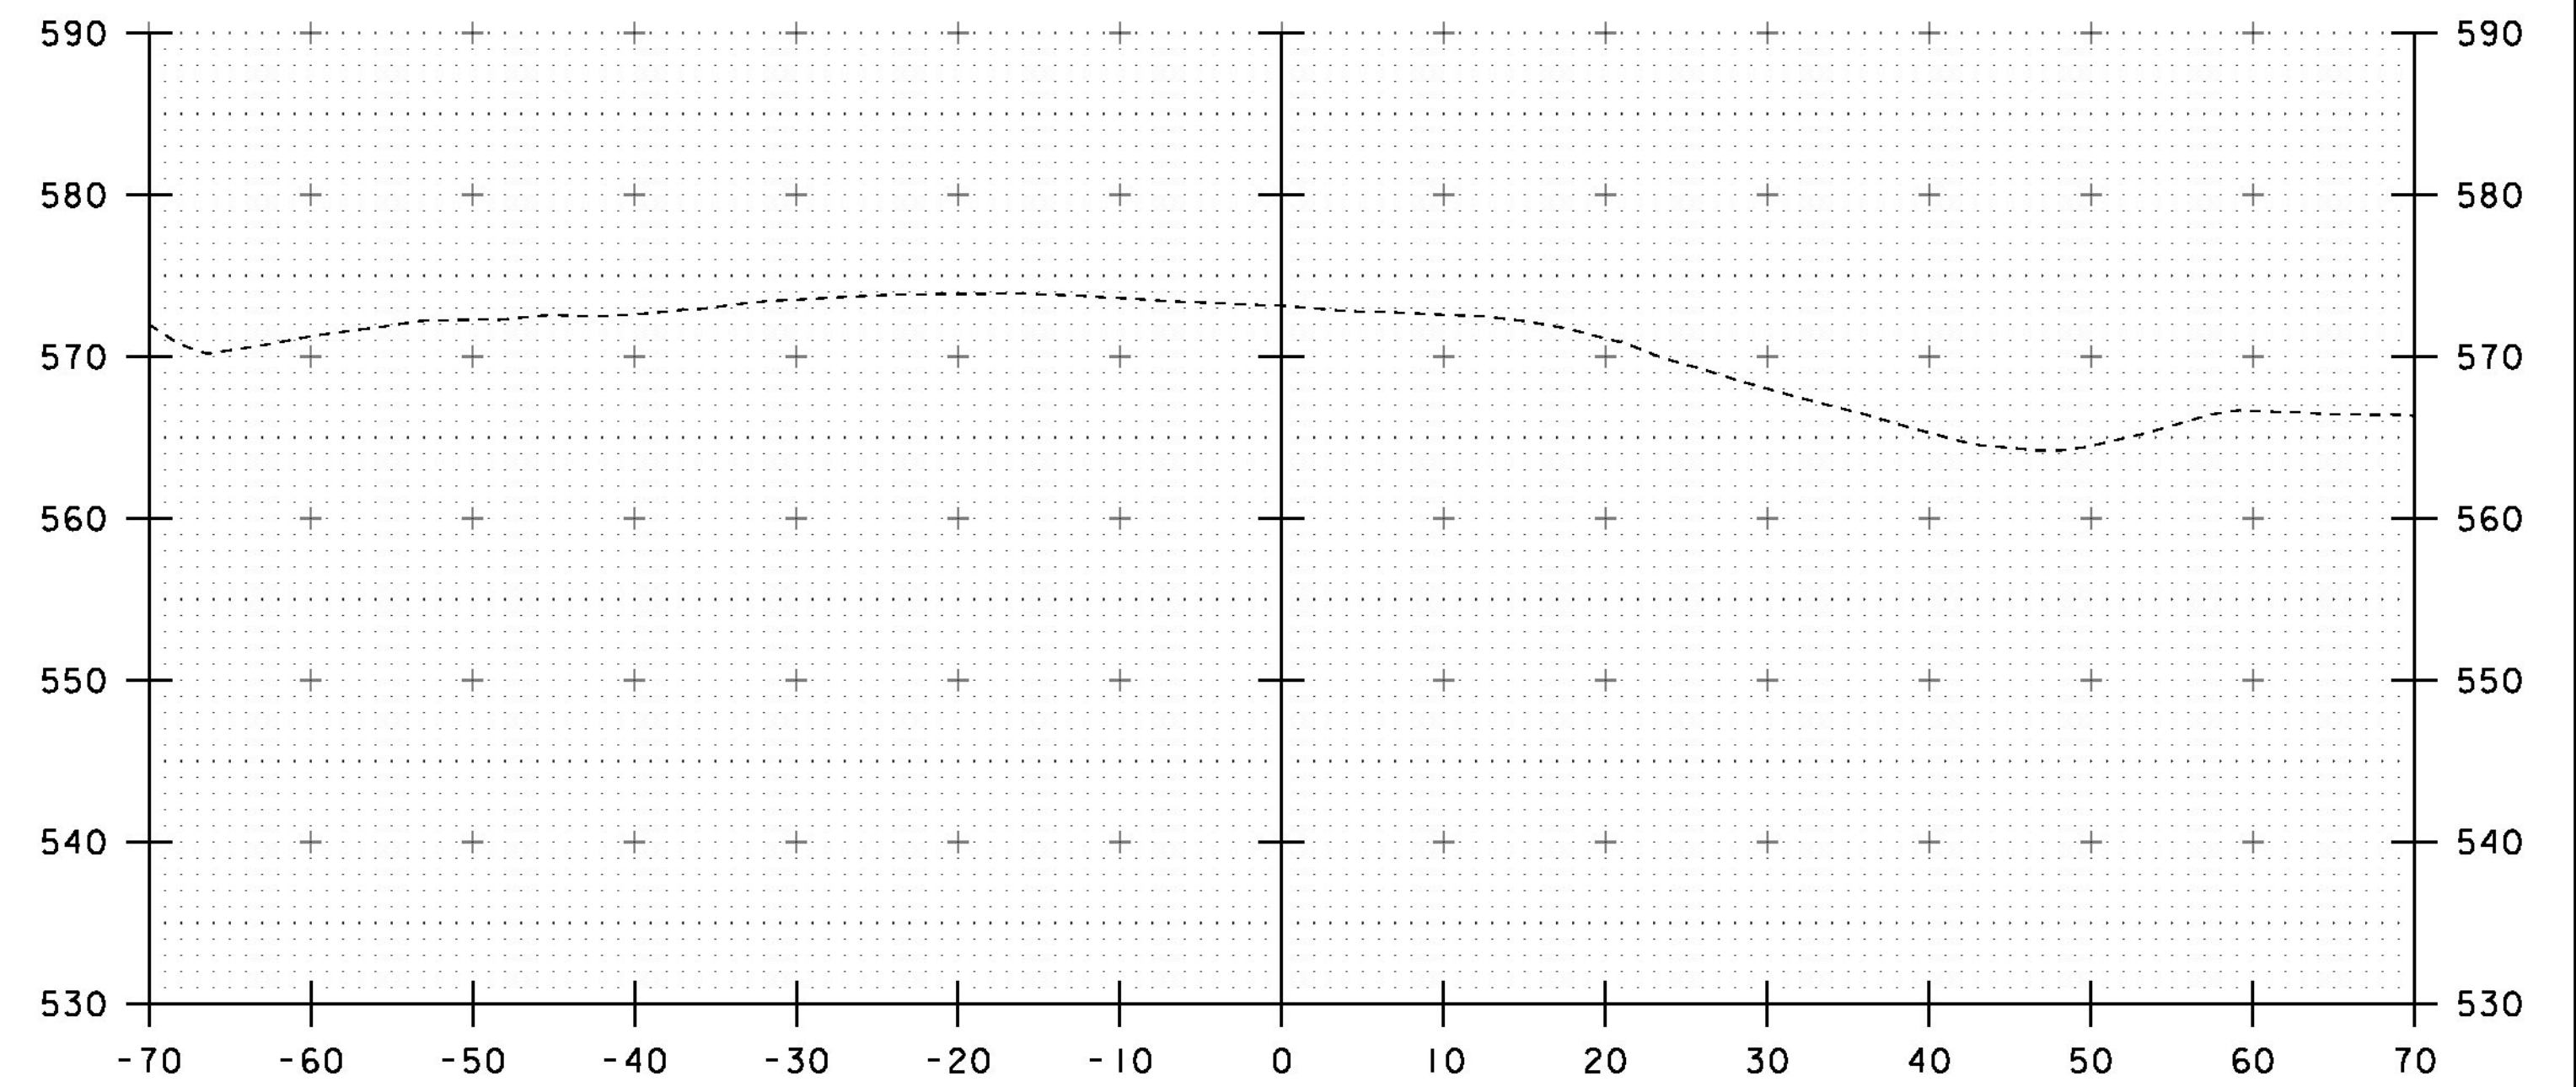

155+00

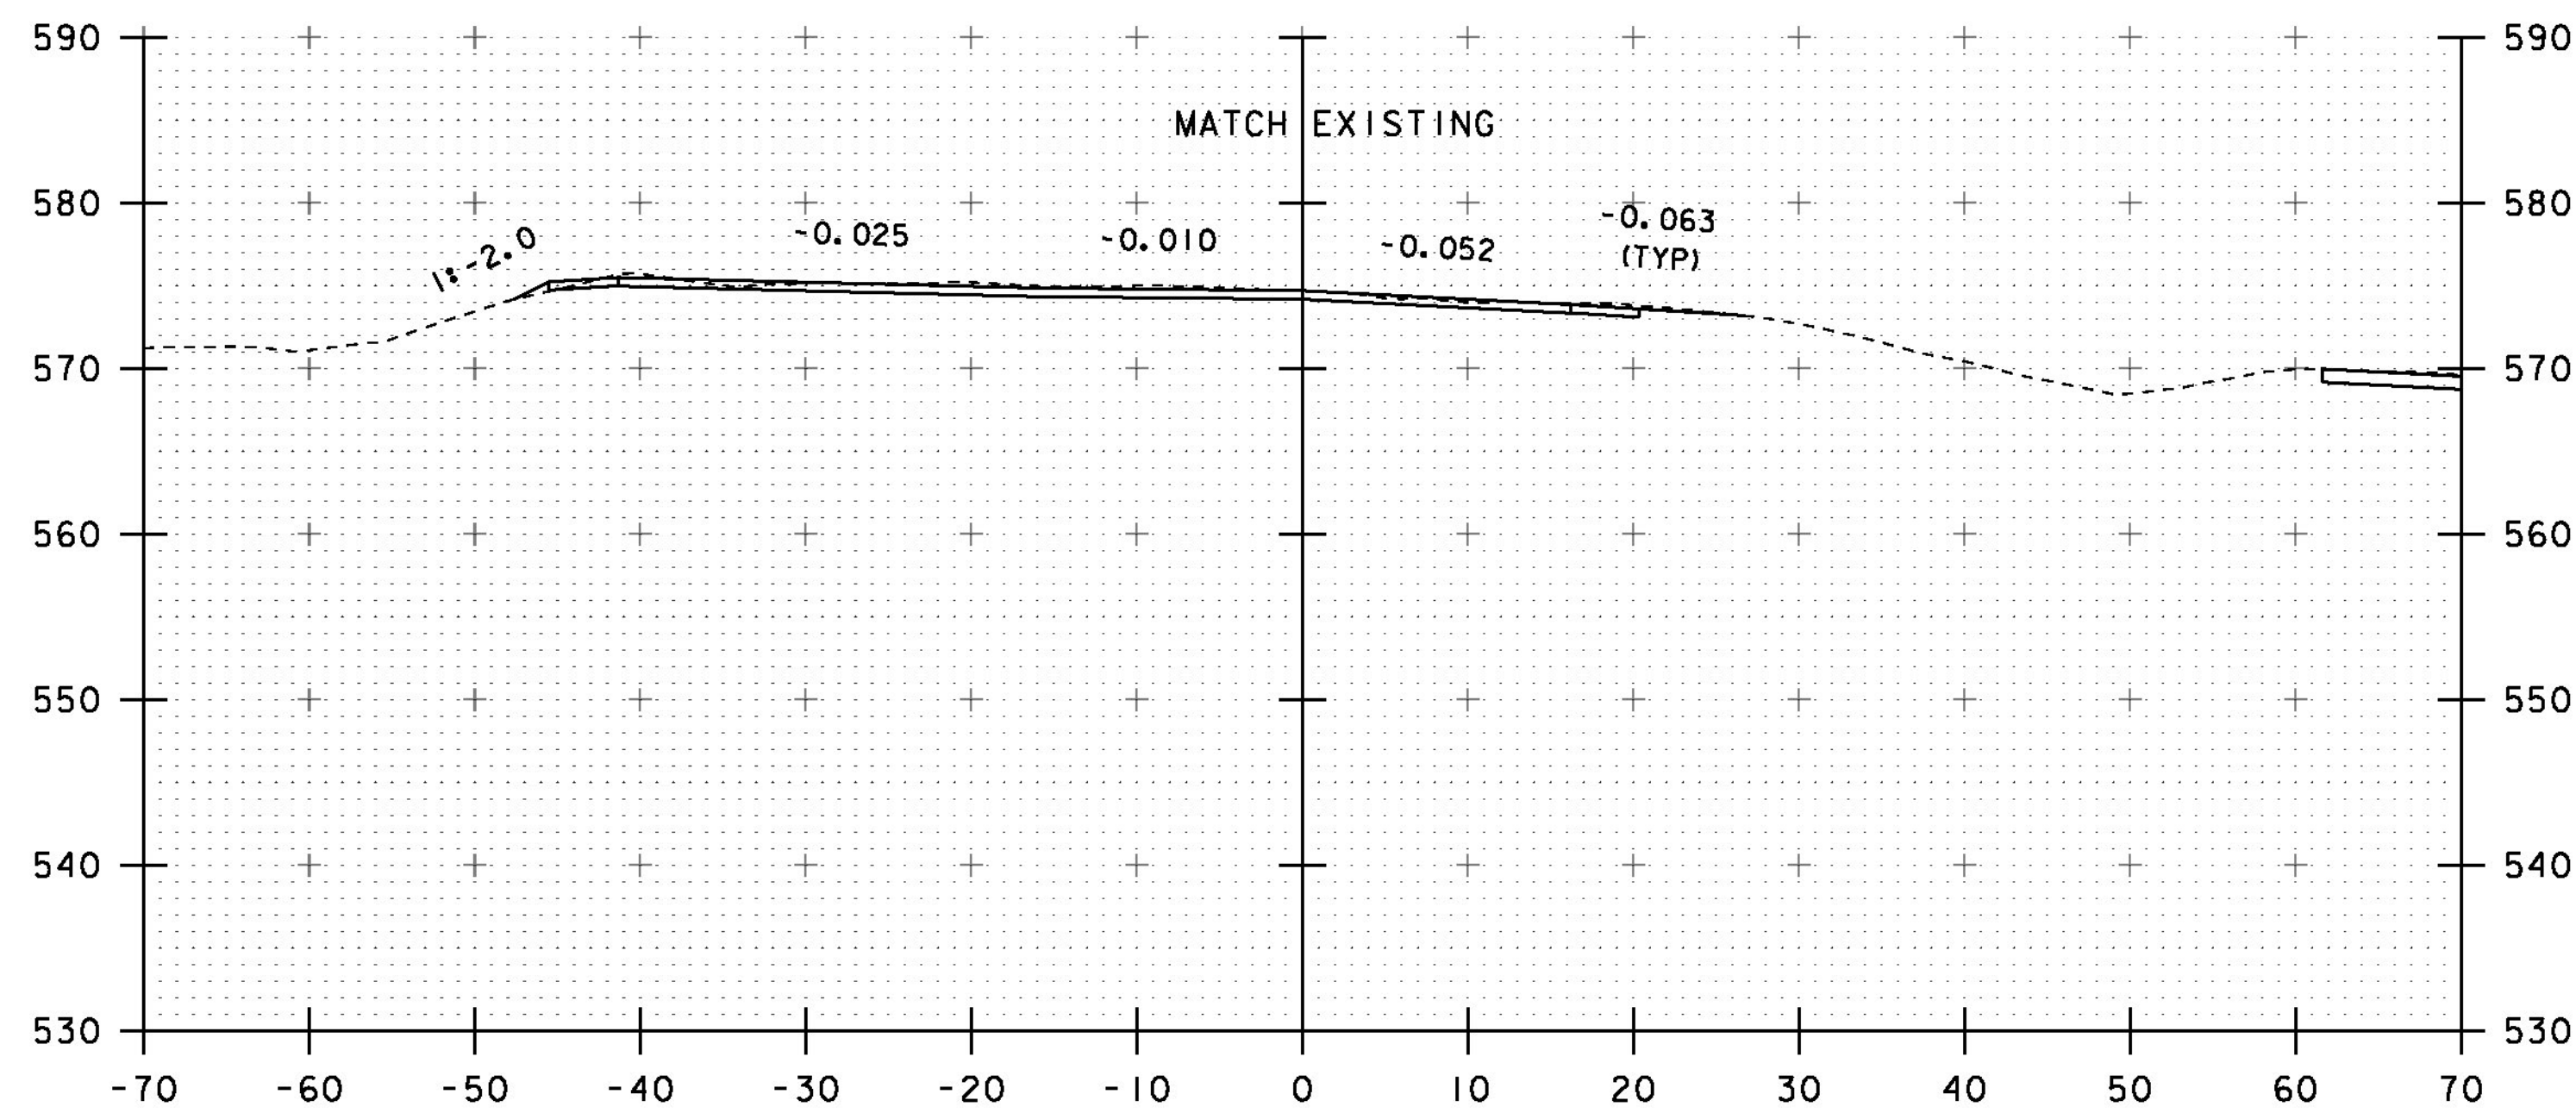

153+50
END APPROACH / PAVEMENT

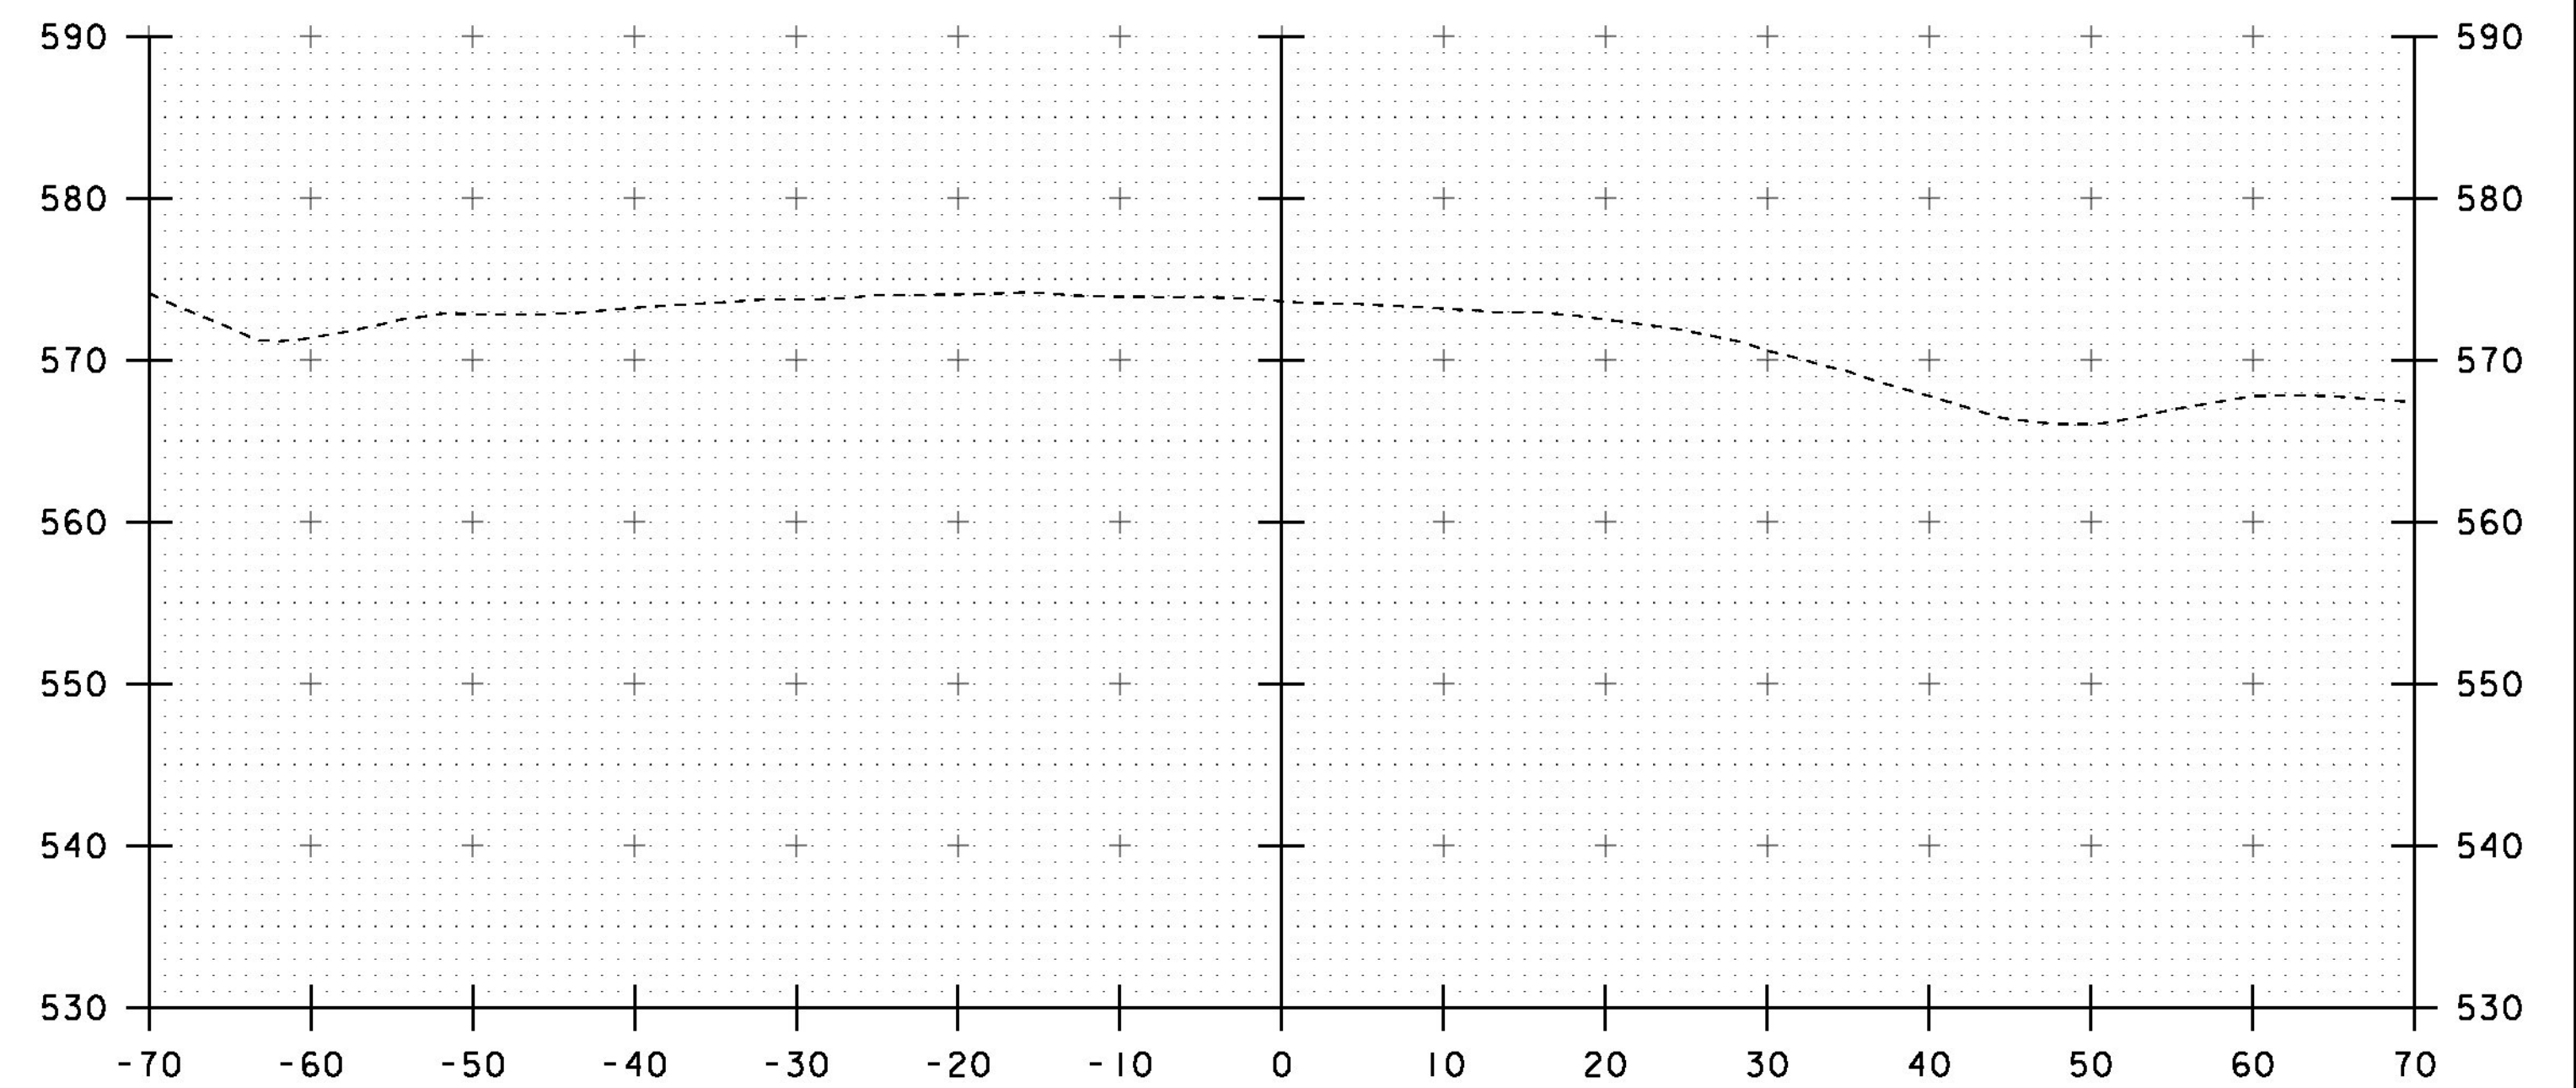

154+50

PROJECT NAME:	HARTFORD
PROJECT NUMBER:	IM 09I-2(79)
FILE NAME:	s12a132xsec.dgn
PROJECT LEADER:	K. HIGGINS
DESIGNED BY:	G. LAROCHE
1-9I SOUTHBOUND CROSS SECTIONS	
PLOT DATE:	15-DEC-2014
DRAWN BY:	K. FRIEDLAND
CHECKED BY:	W. LAMMER
SHEET	145 OF 166

STA. 153+50 TO STA. 155+00