




248+50

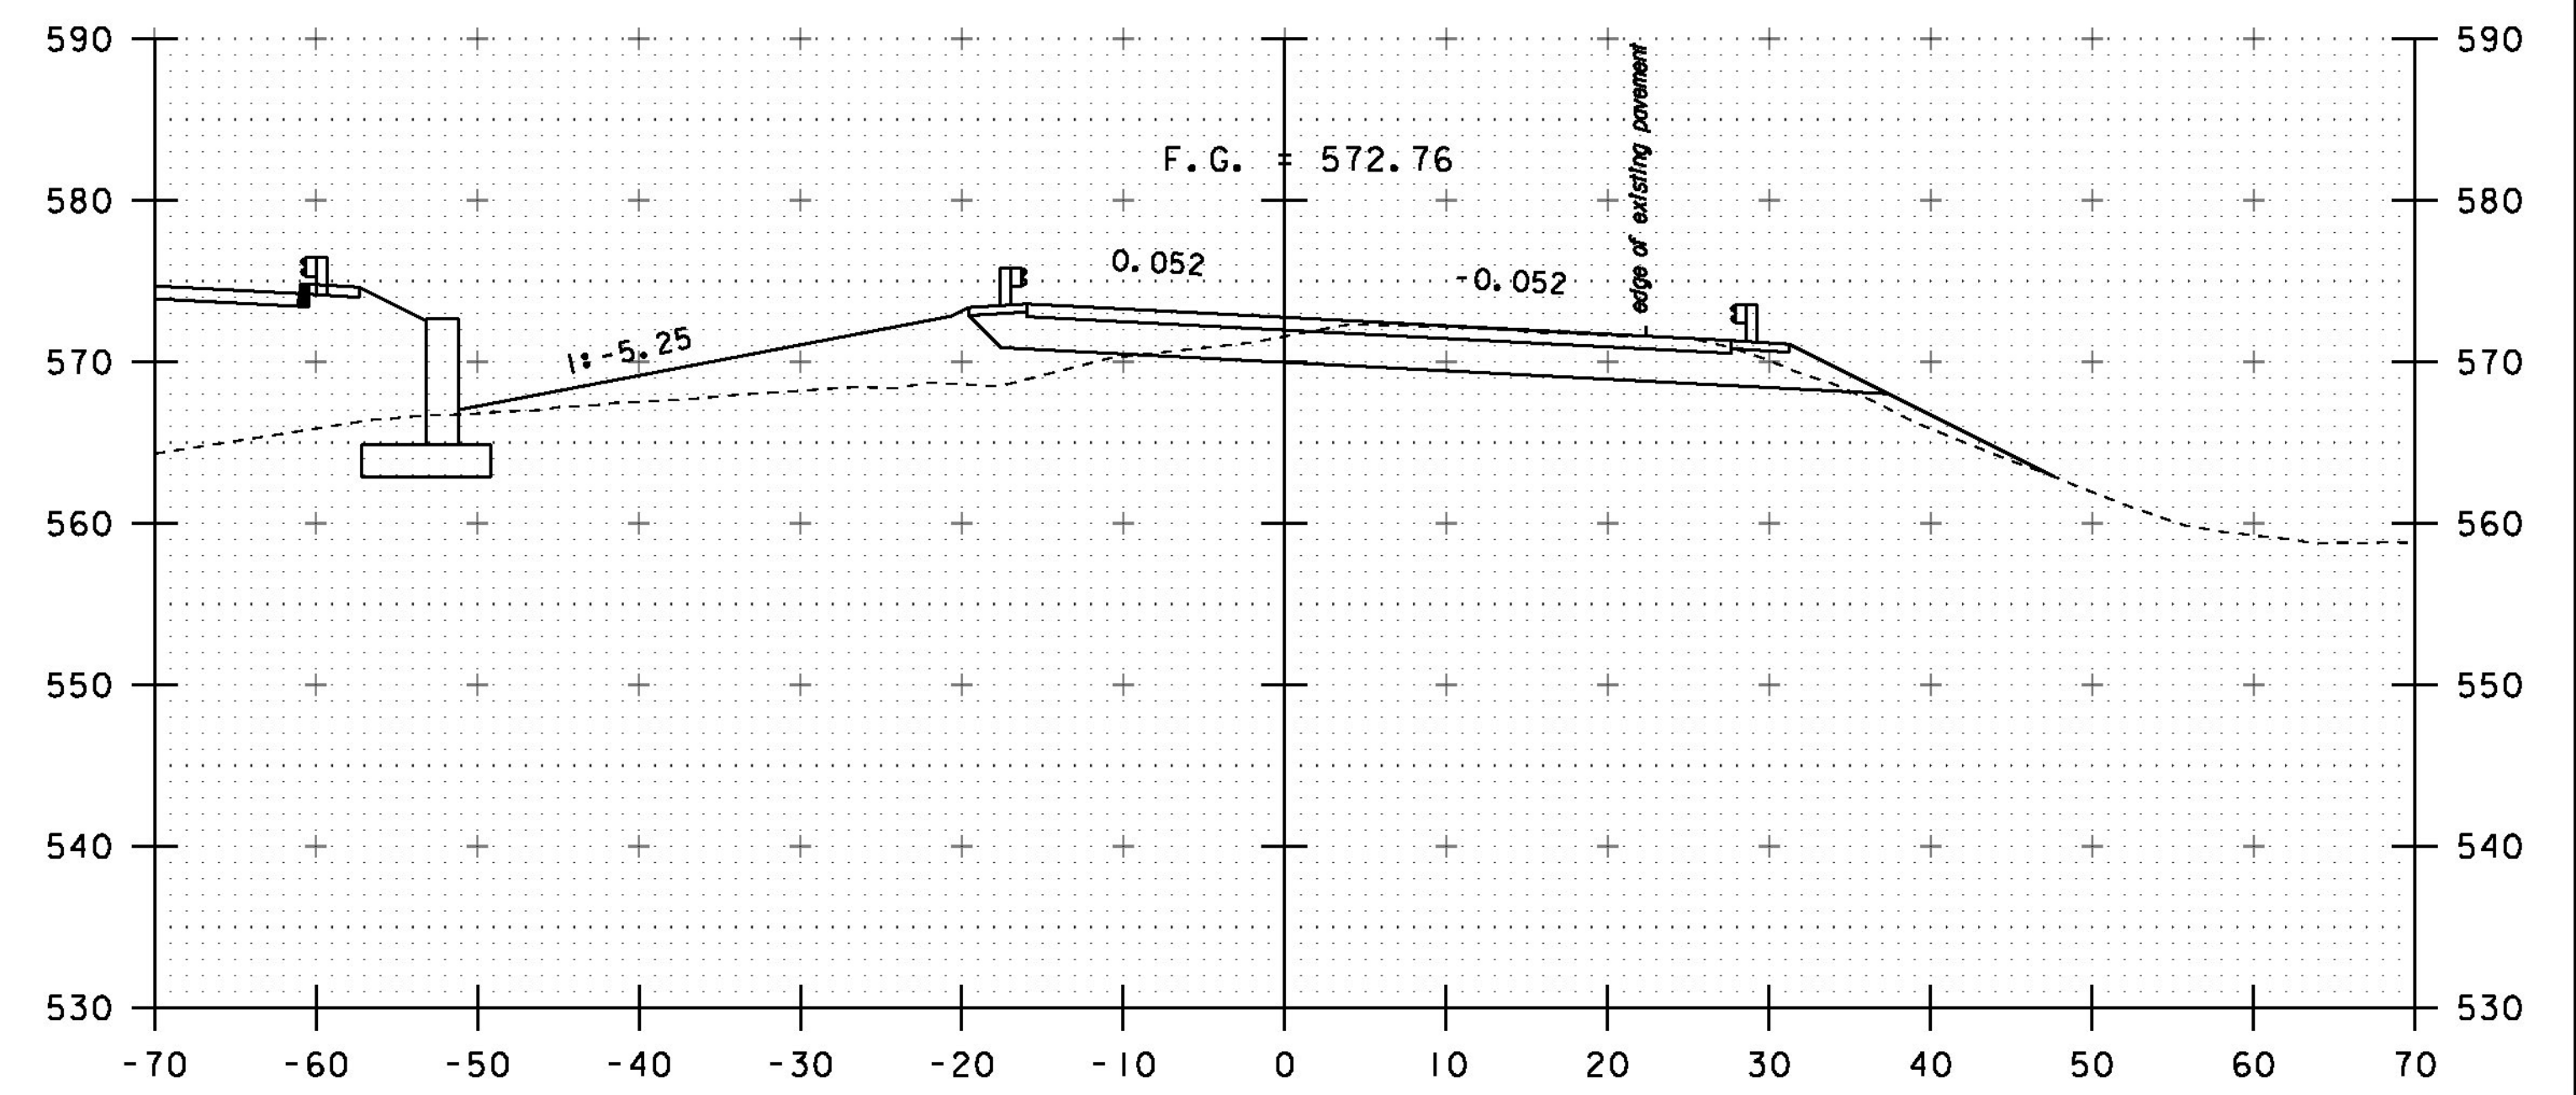

249+50
BEGIN PROJECT

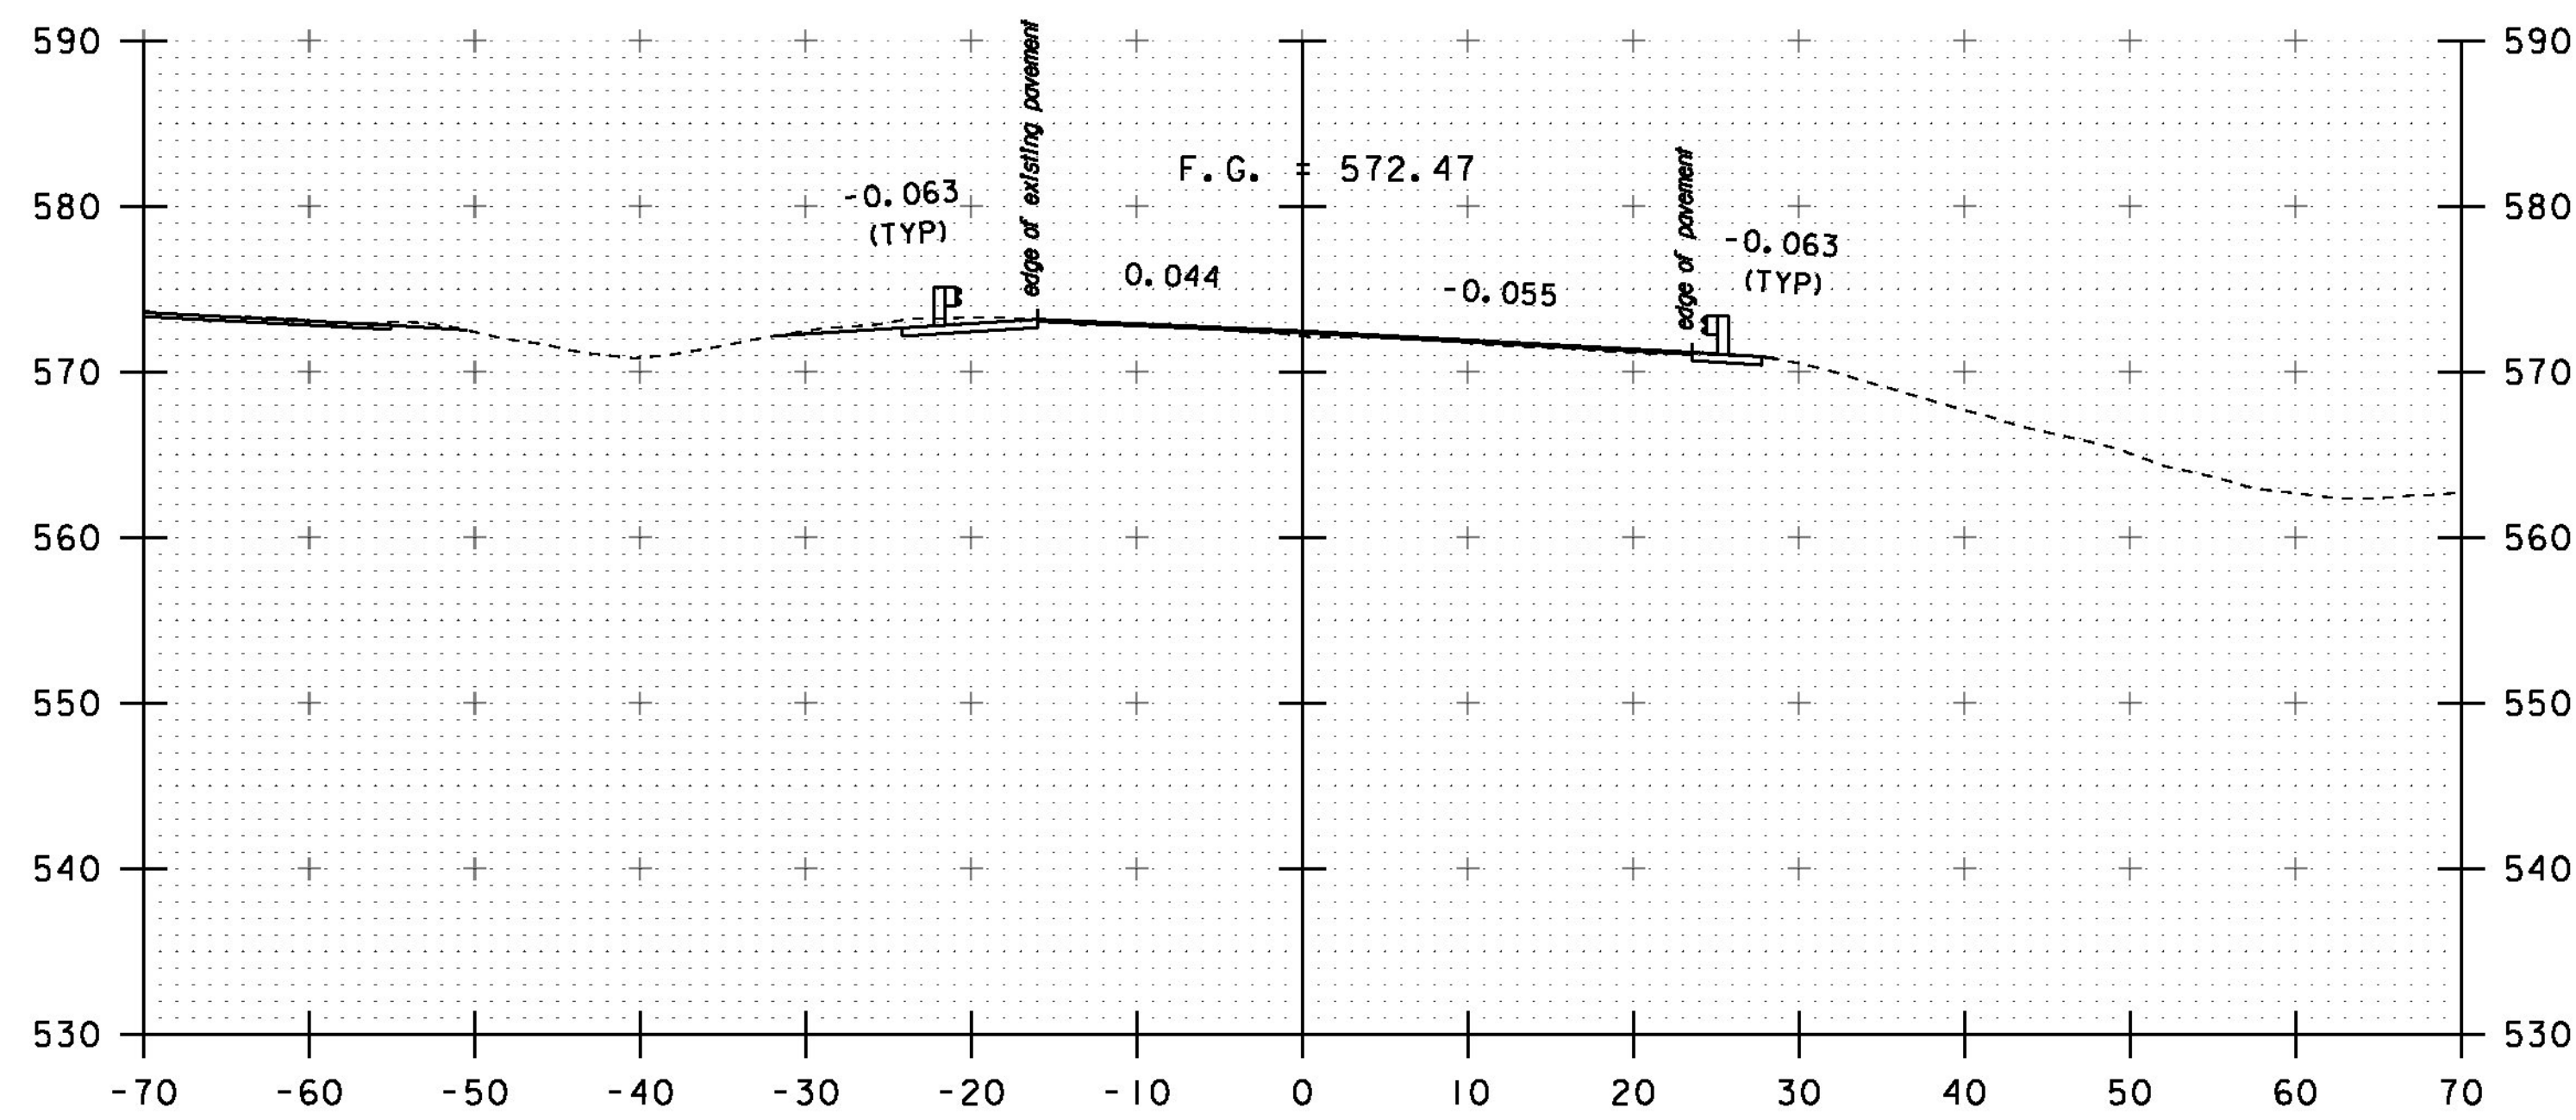

248+00
BEGIN PAVEMENT 247+75

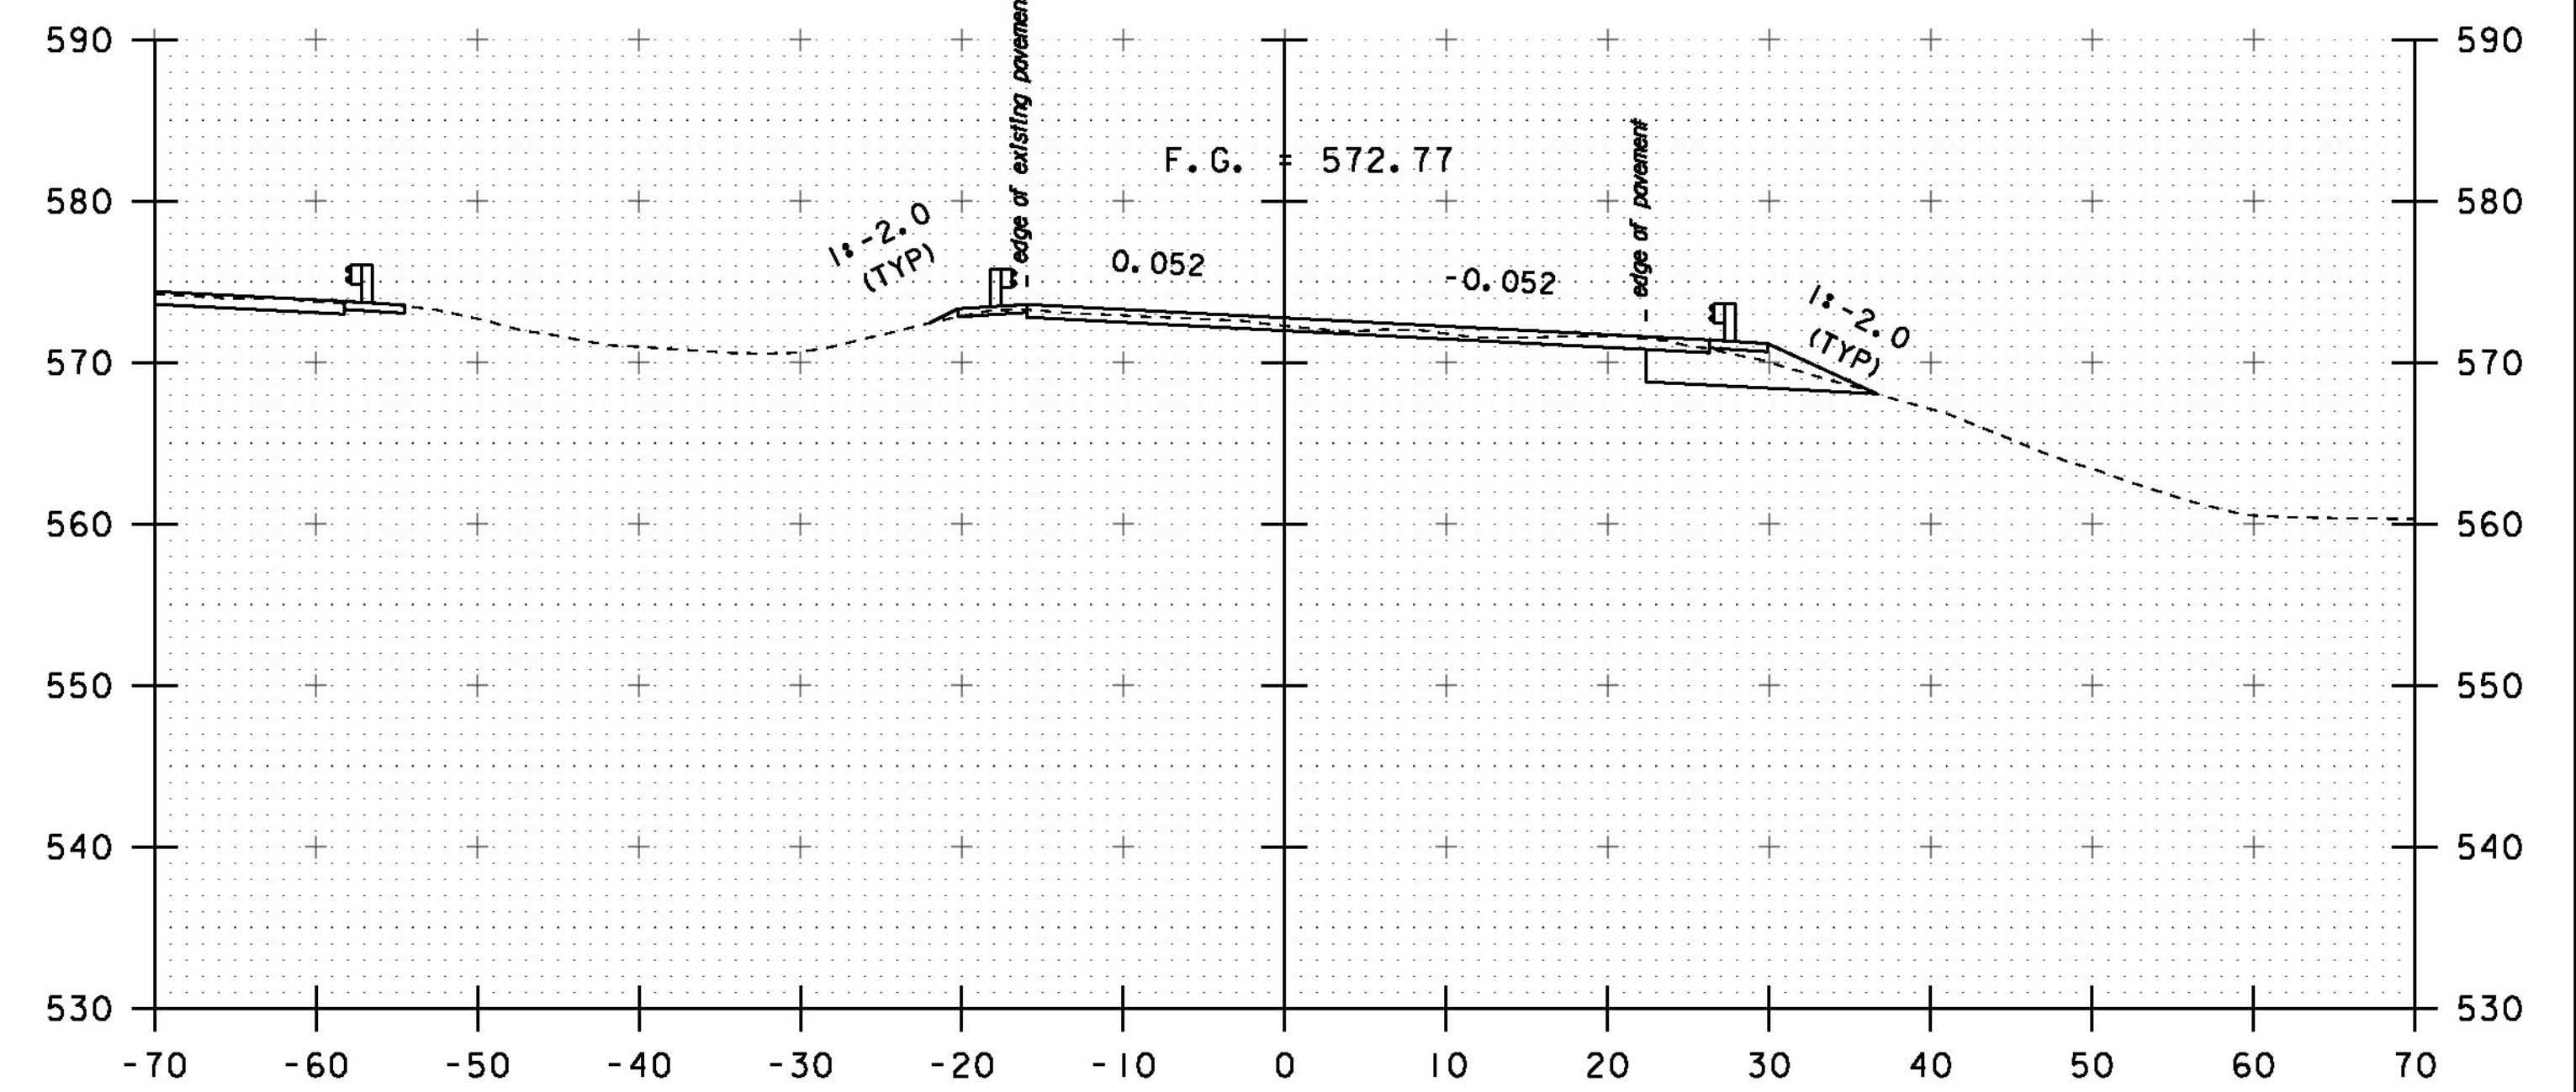

249+00

STA. 248+00 TO STA. 249+50

PROJECT NAME:	HARTFORD	PLOT DATE:	15-DEC-2014
PROJECT NUMBER:	IM 09I-2(79)	DRAWN BY:	K. FRIEDLAND
FILE NAME:	si2a132xsec.dgn	DESIGNED BY:	G. LAROCHE
PROJECT LEADER:	K. HIGGINS	CHECKED BY:	W. LAMMER
I-91 NORTHBOUND CROSS SECTIONS		SHEET 147 OF 166	