




250+00
BEGIN BRIDGE 249+89.46

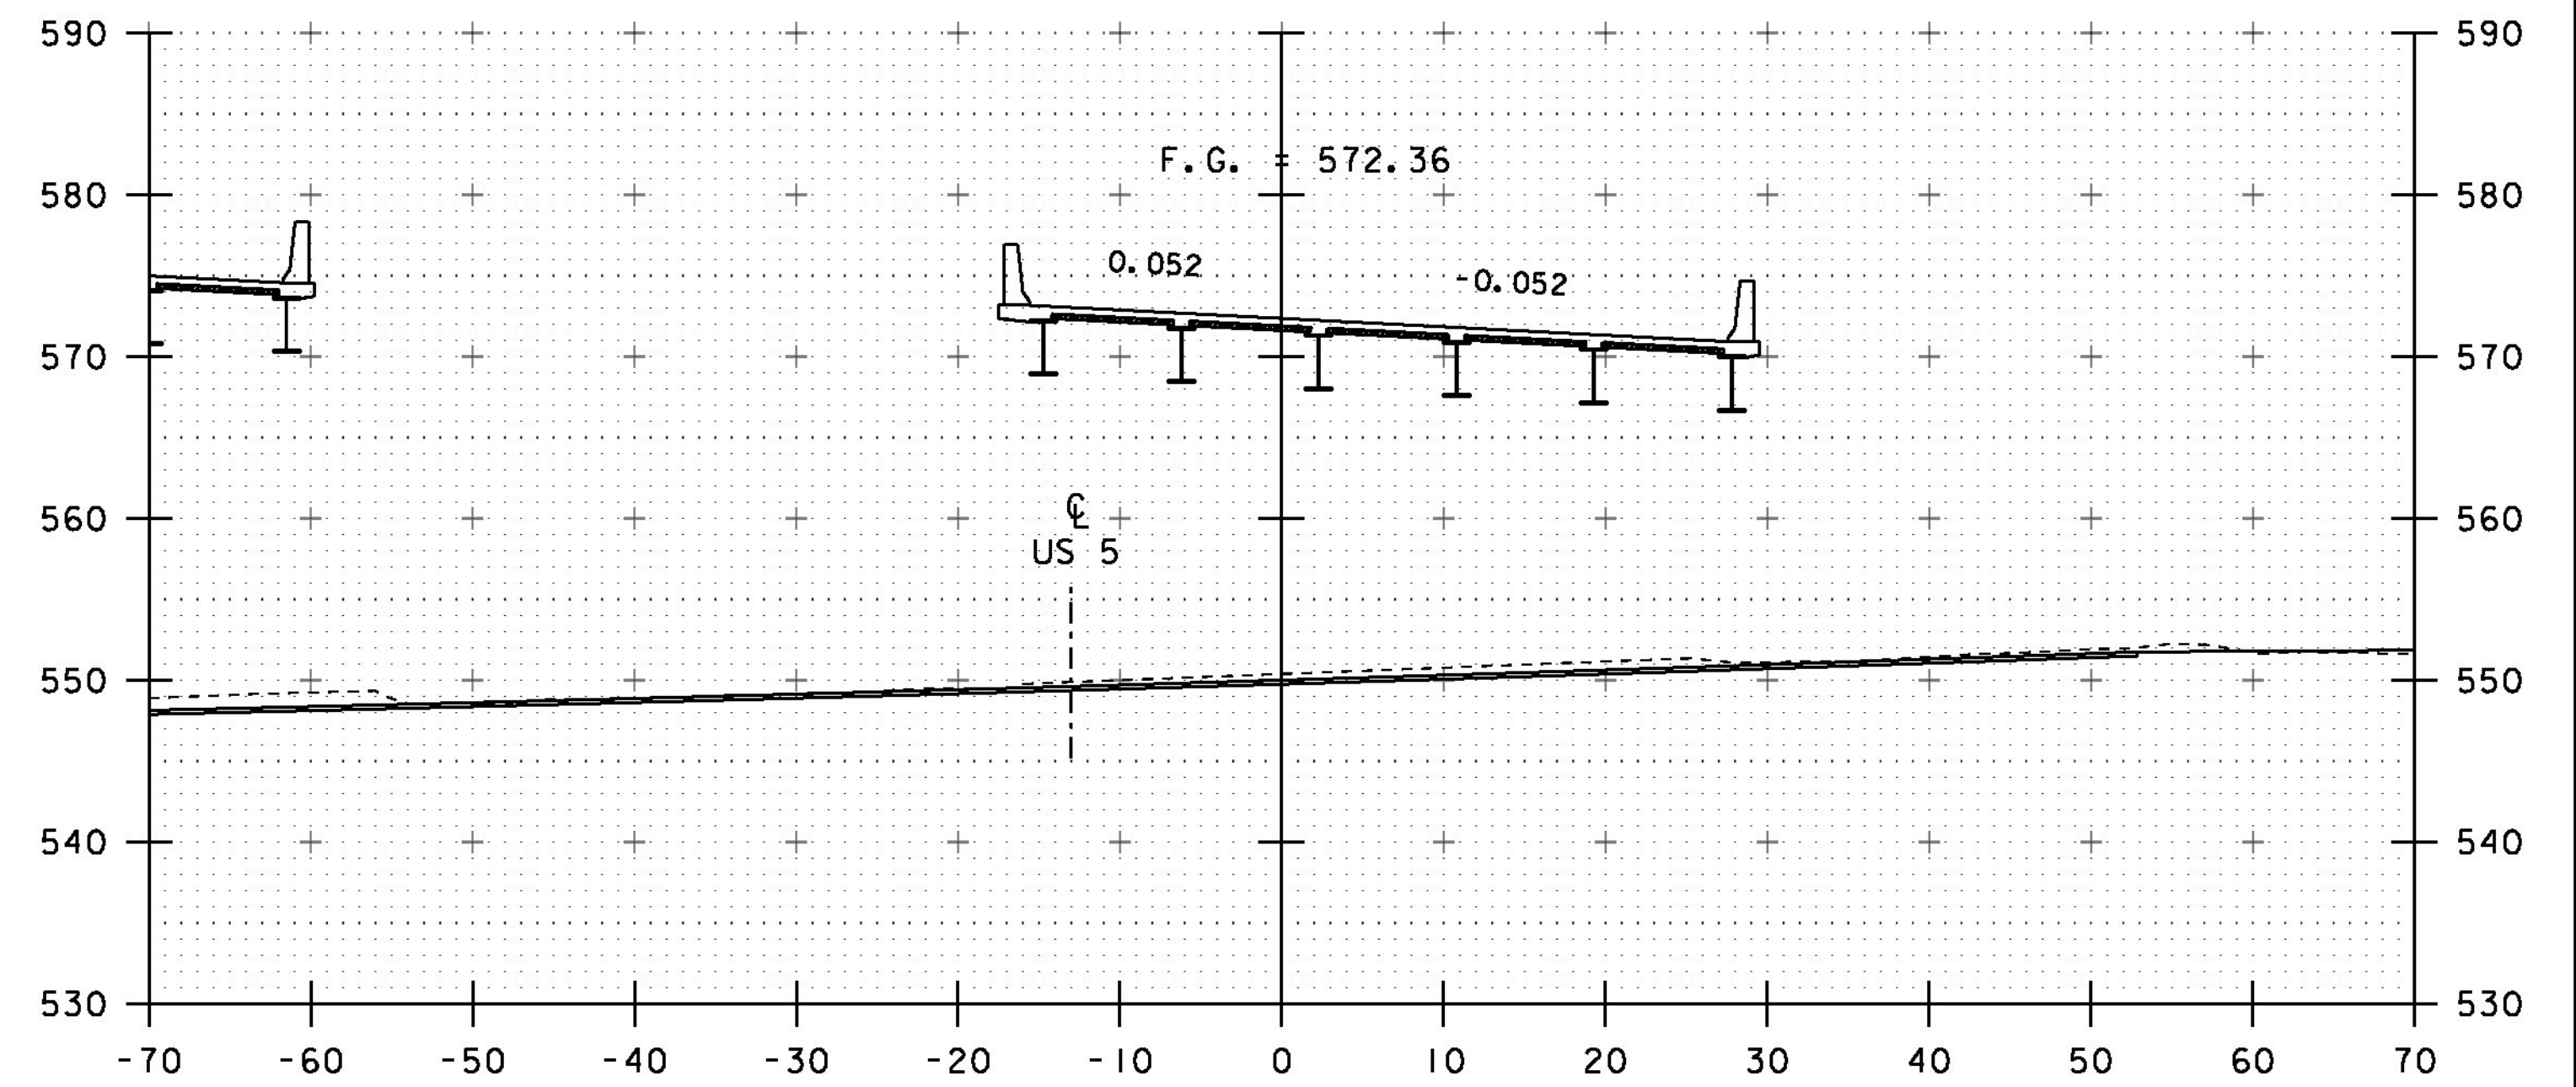

250+50

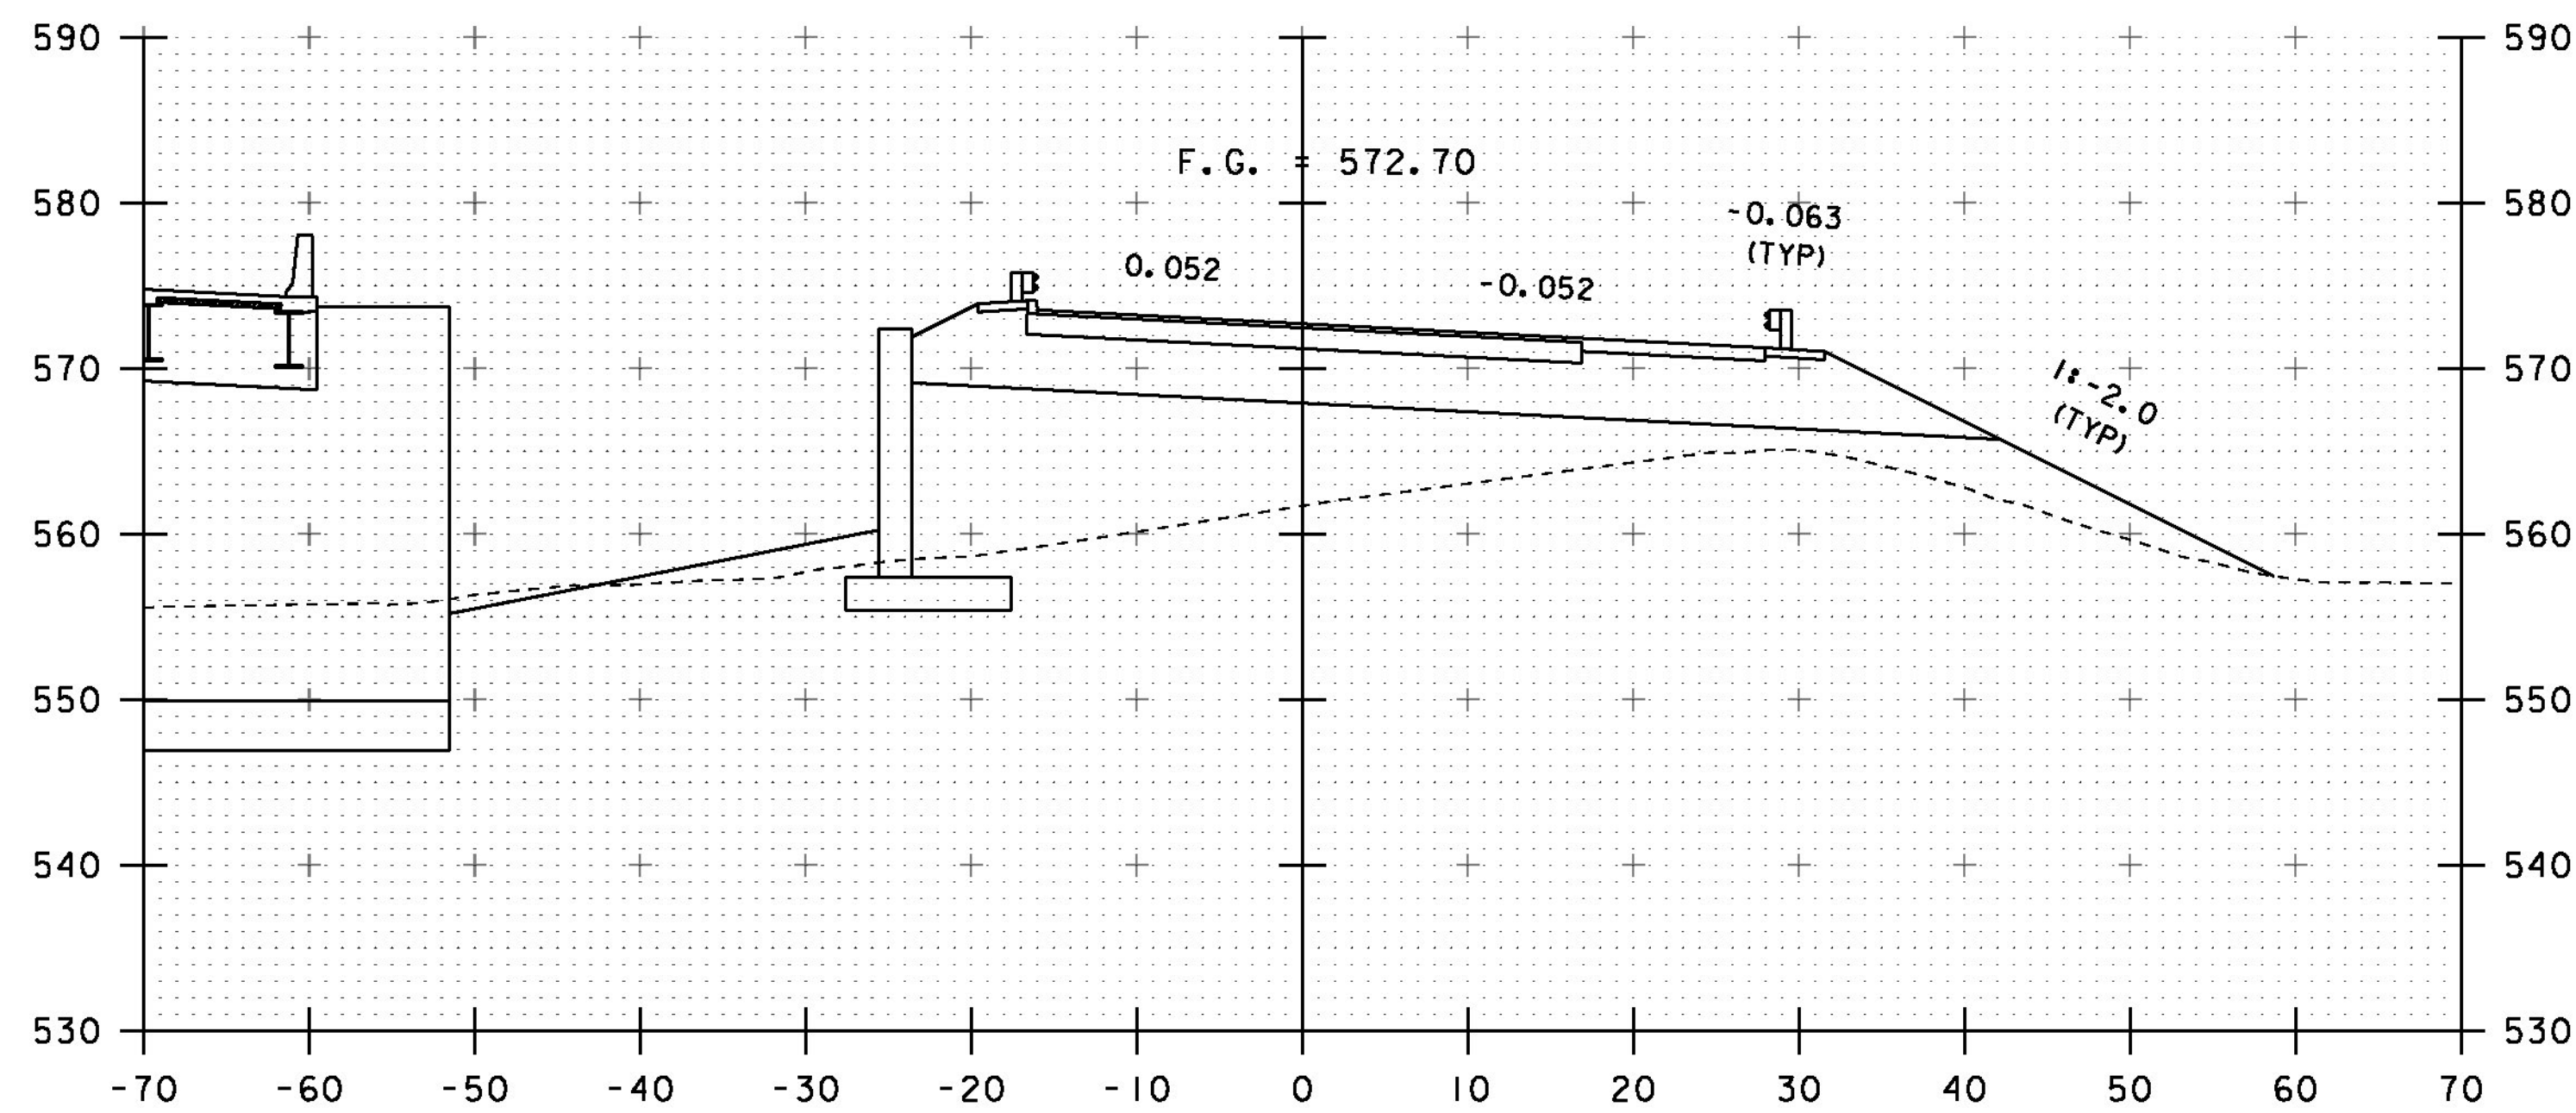

249+75

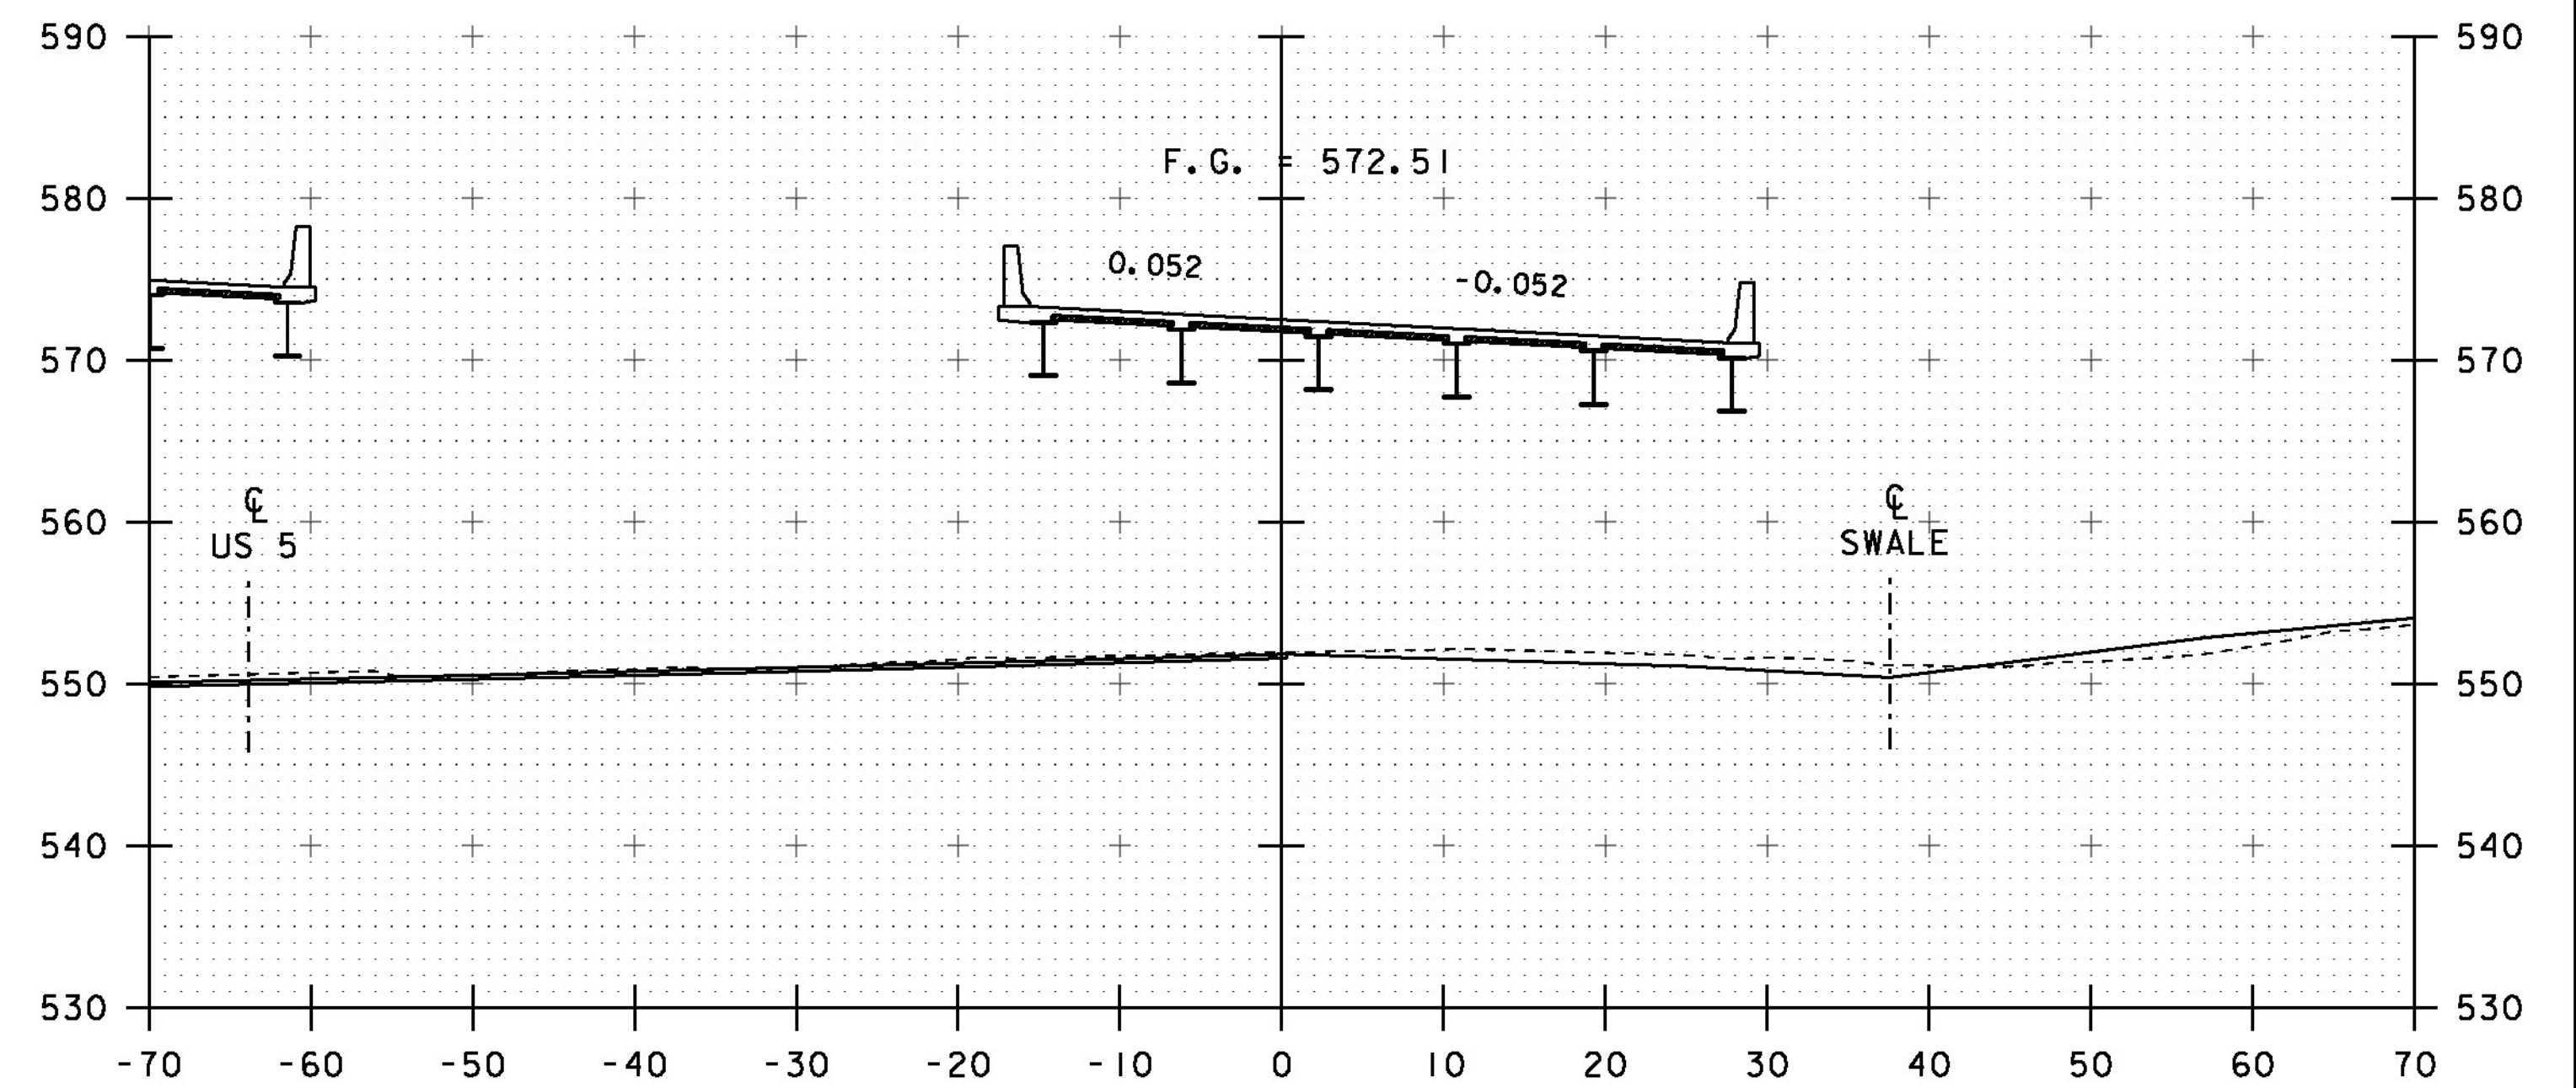

250+25

STA. 249+75 TO STA. 250+50

PROJECT NAME:	HARTFORD
PROJECT NUMBER:	IM 09I-2(79)
FILE NAME:	s12a132xsec.dgn
PROJECT LEADER:	K. HIGGINS
DESIGNED BY:	G. LAROCHE
I-91 NORTHBOUND CROSS SECTIONS	
PLOT DATE:	15-DEC-2014
DRAWN BY:	K. FRIEDLAND
CHECKED BY:	W. LAMMER
SHEET	148 OF 166