


354+75

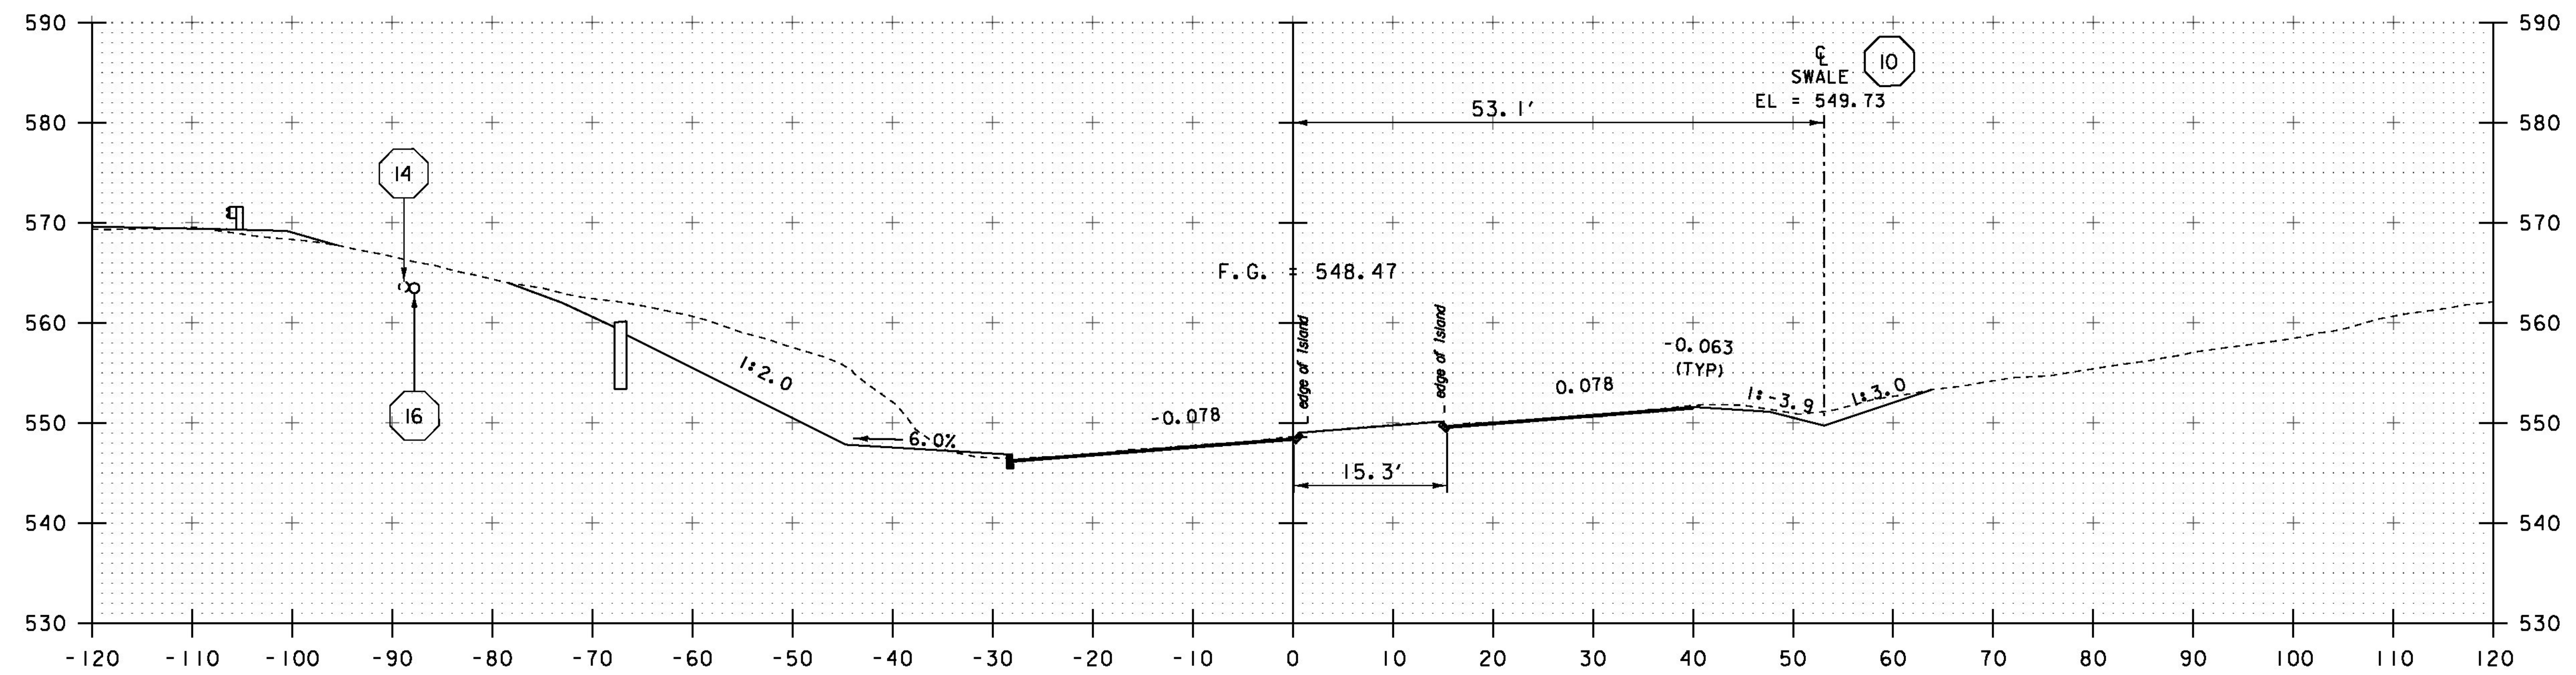

354+50

PROJECT NAME: HARTFORD
 PROJECT NUMBER: IM 091-2(79)

FILE NAME: s12a132xsec.dgn
 PROJECT LEADER: K. HIGGINS
 DESIGNED BY: G. LAROCHE
 US 5 CROSS SECTIONS

PLOT DATE: 15-DEC-2014
 DRAWN BY: K. FRIEDLAND
 CHECKED BY: W. LAMMER
 SHEET 162 OF 166

STA. 354+50 TO STA. 354+75