


356+50

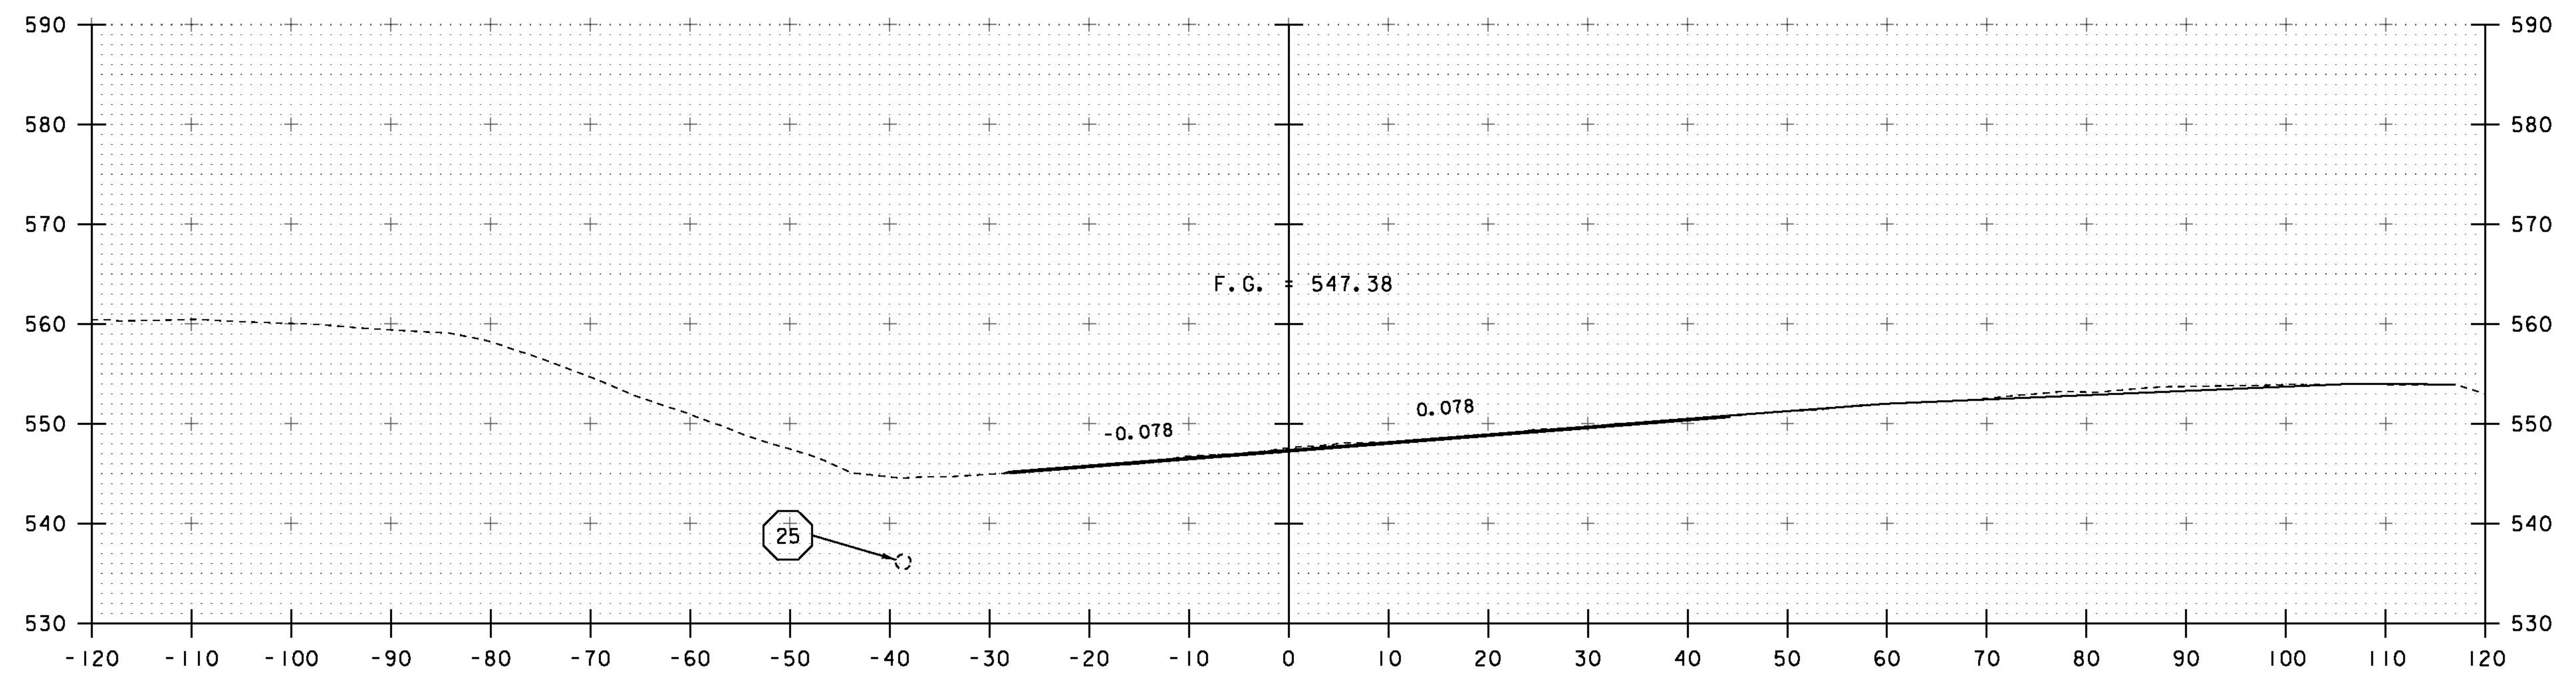

356+00

PROJECT NAME: HARTFORD
PROJECT NUMBER: IM 09I-2(79)

FILE NAME: s12a132xsec.dgn
PROJECT LEADER: K. HIGGINS
DESIGNED BY: G. LAROCHE
US 5 CROSS SECTIONS

PLOT DATE: 15-DEC-2014
DRAWN BY: K. FRIEDLAND
CHECKED BY: W. LAMMER
SHEET 164 OF 166

STA. 356+00 TO STA. 356+50