




1 TRANSVERSE SECTION (BRIDGE 43S)  
F2 3/8" = 1'-0"

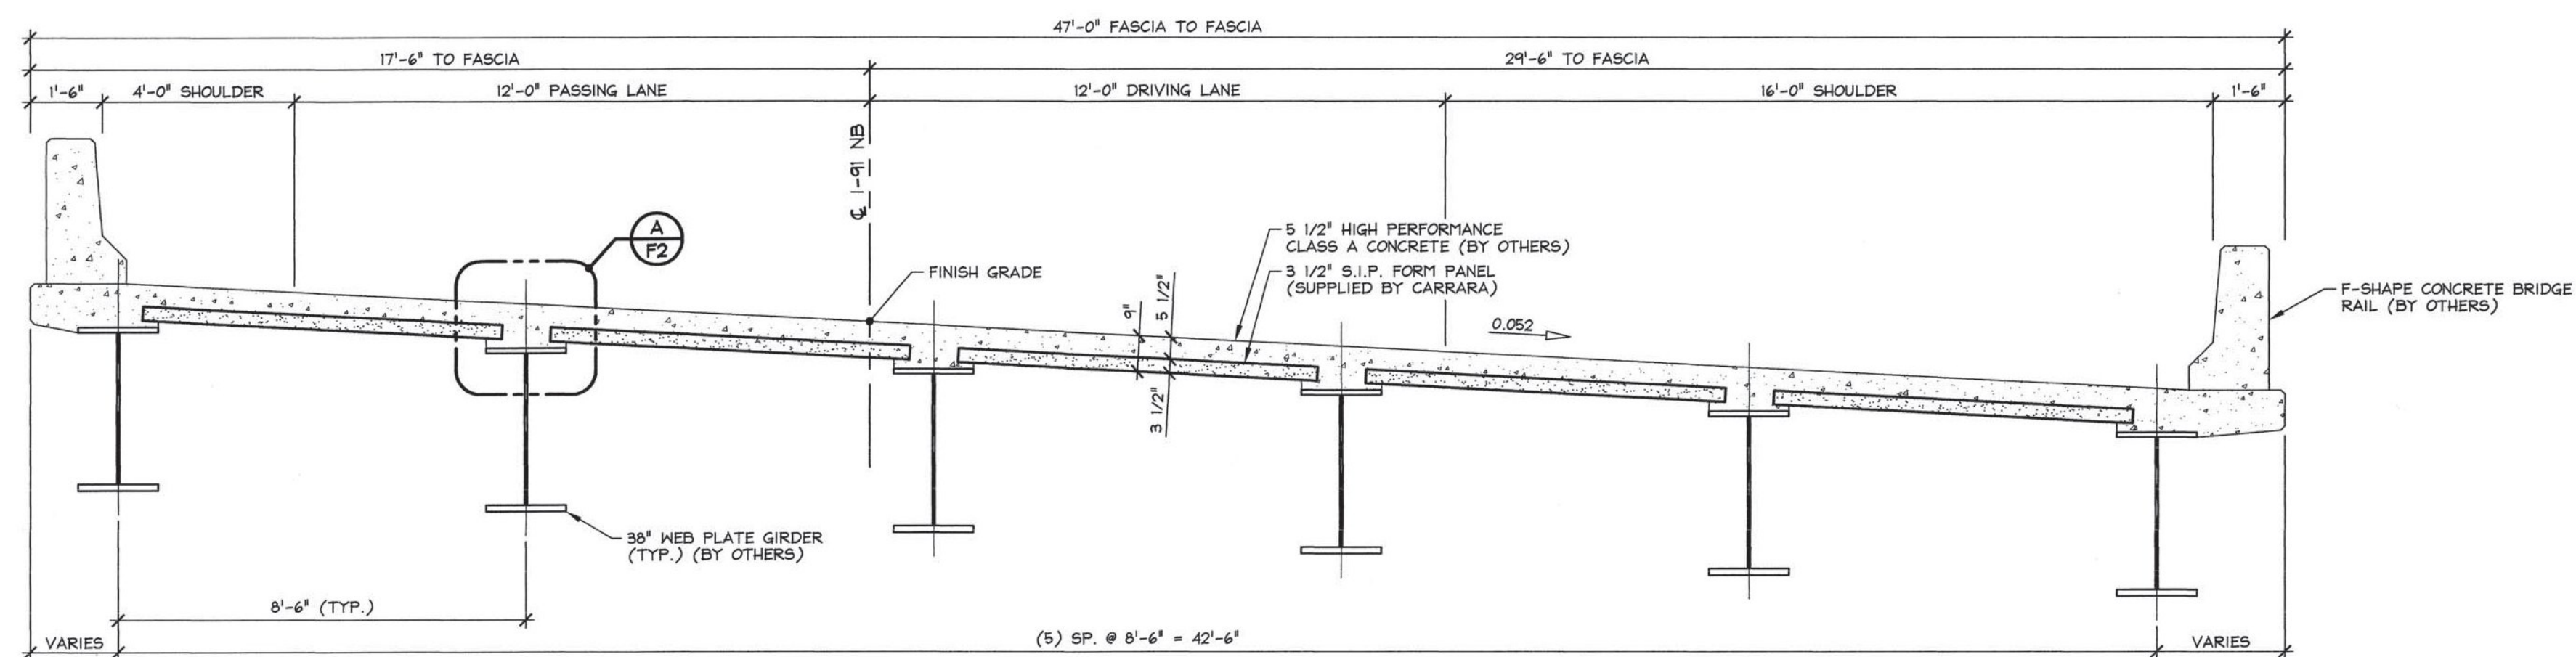

2 TRANSVERSE SECTION (BRIDGE 43N)  
F2 3/8" = 1'-0"

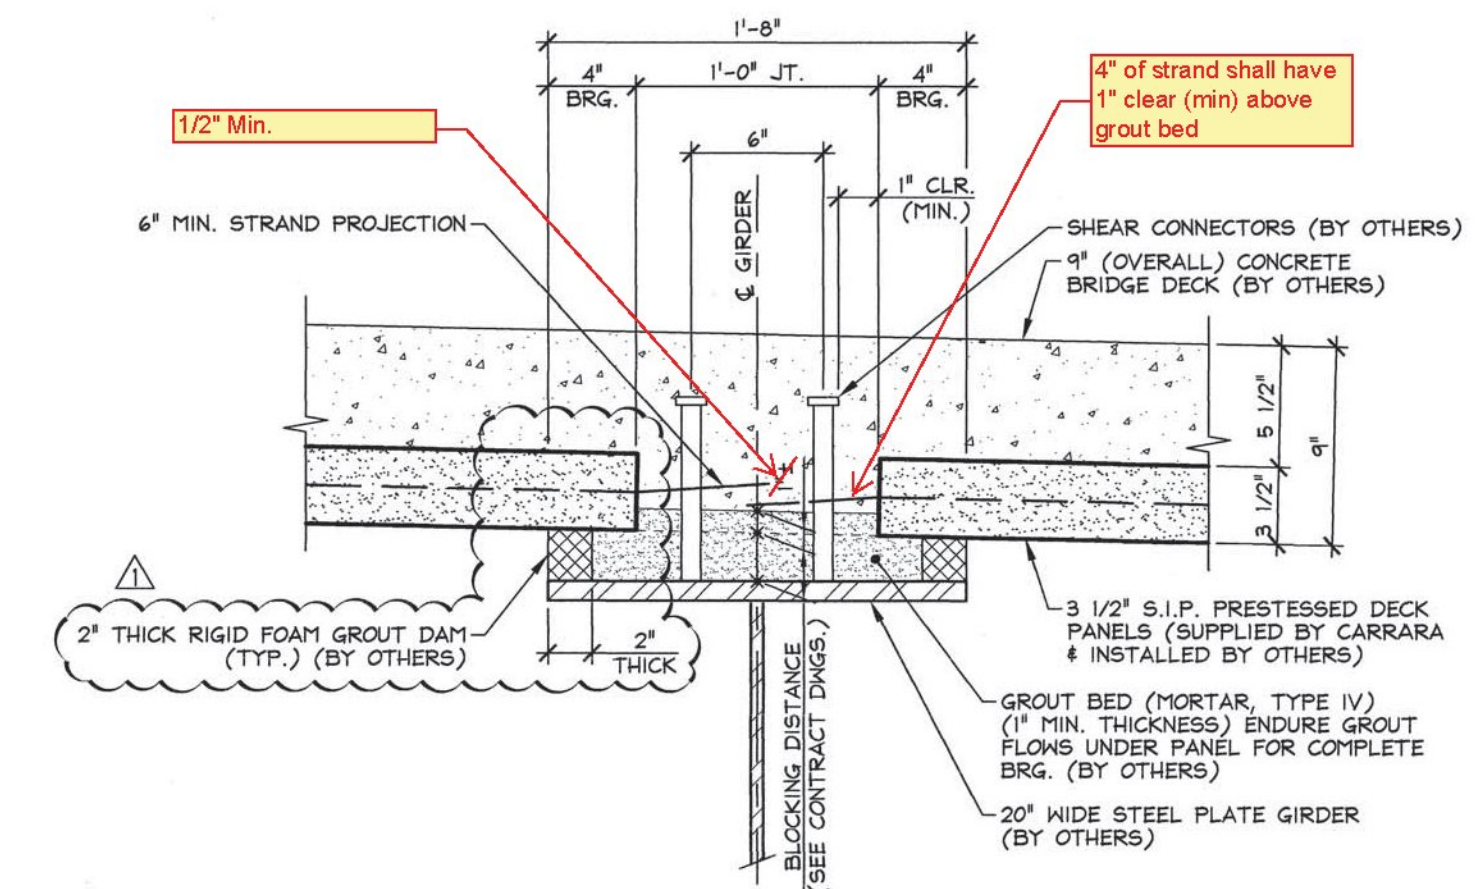

A SECTION  
F2 1 1/2" = 1'-0"

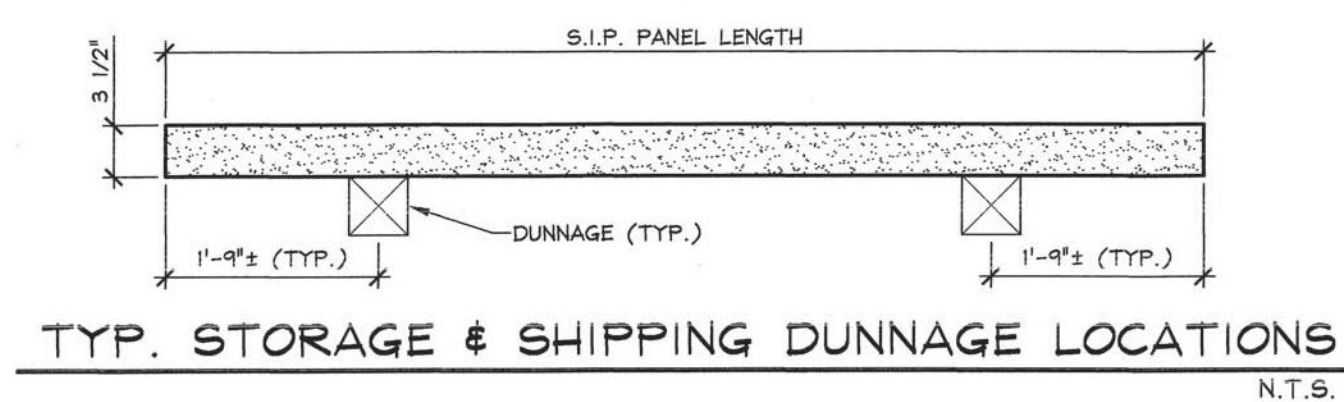

1-23-15 REVISED AS NOTED

APPROVAL STAMP:

Vermont Agency of Transportation  
**RECEIVED**

CK'D BY RK OK'D BY WL

January 23, 2015

RESUBMIT NO Approved AsNoted  
BY KH DATE 2-18-2015

<b>J.P. CARRARA &amp; SONS INC.</b> Precast & Prestress Manufacturer <small>244 C&amp;S DR., WOODBURY, VERMONT 05753 Phone: (802) 388-5361 Fax: (802) 388-9010</small>		<b>PCL CONSTRUCTION</b> CONTRACTOR TAMPA, FLORIDA	
STATE OF VERMONT AGENCY OF TRANSPORTATION COUNTY OF WINDSOR		DATE: JAN. 20, 2015 SCALE: NOTED	
TOWN OF HARTFORD INTERSTATE 91 EXIT 11 BRIDGE NO.: 43 N/S PROJECT NO.: IM 091-2(79)		CHKD: - DFTM: B.L. JOB NO: 23455-015	
<b>SUPERSTRUCTURE</b> <b>SECTIONS &amp; DETAILS</b>		DWG. NO: <b>F2</b>	