


APPROACH SLAB 1 PLAN
SCALE 1/4" = 1'-0"

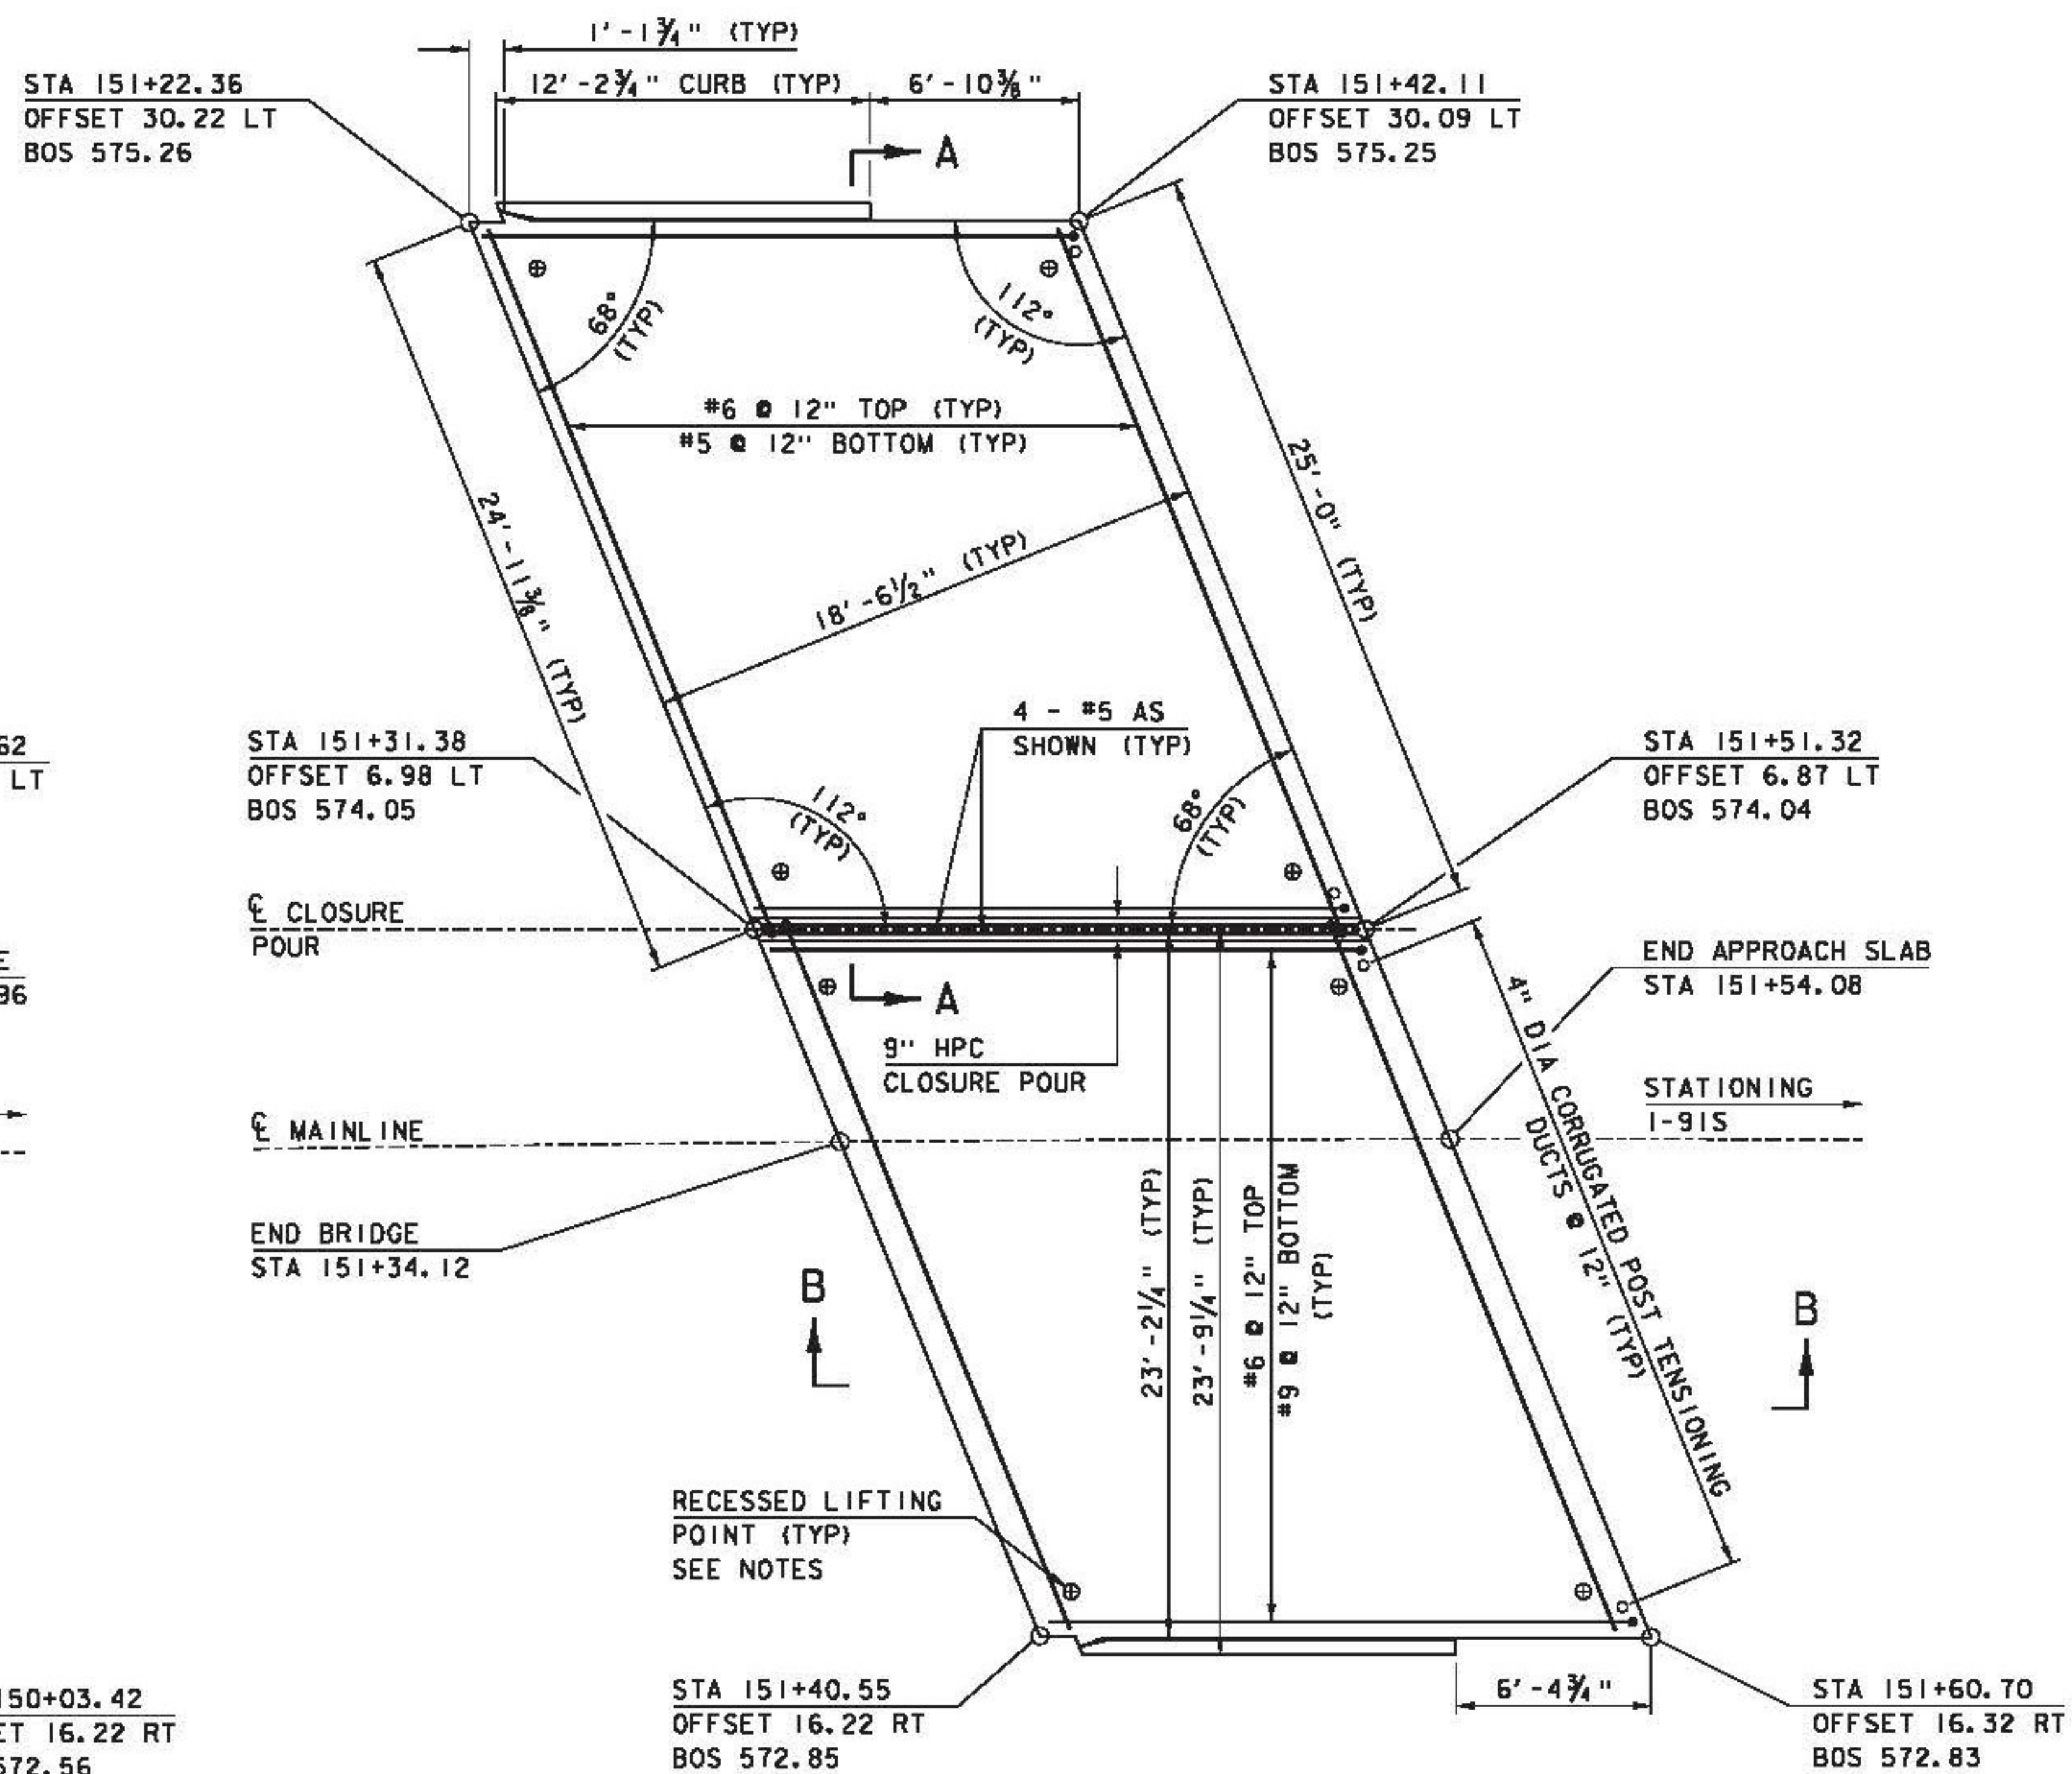

APPROACH SLAB 2 PLAN
SCALE 1/4" = 1'-0"

NOTES:

- 1) ALL APPROACH SLAB REINFORCING STEEL SHALL BE LEVEL II OR HIGHER.
- 2) BOS = BOTTOM OF SLAB
- 3) LIFTING POINTS SHALL BE DESIGNED BY OTHERS AND CALCULATIONS INCLUDED WITH SUBMITTAL.

NOTE:

- NF = NEAR FACE
- FF = FAR FACE
- EF = EACH FACE
- 3" CLEAR, UNLESS OTHERWISE SPECIFIED ON THE PLANS.
- 2'-2" BAR LAP UNLESS OTHERWISE SPECIFIED ON THE PLANS.

PROJECT NAME:	HARTFORD	PLOT DATE:	15-DEC-2014
PROJECT NUMBER:	IM 091-2(79)	DRAWN BY:	K. FRIEDLAND
FILE NAME:	sl2al32apalabs_43S.dgn	CHECKED BY:	W. LAMMER
PROJECT LEADER:	K. HIGGINS	SHEET	97 OF 166
DESIGNED BY:	G. LAROCHE		
APPROACH SLAB DETAILS 43S			