

# STATE OF VERMONT AGENCY OF TRANSPORTATION




## PROPOSED IMPROVEMENT BRIDGE PROJECT TOWN OF SWANTON COUNTY OF FRANKLIN

ROUTE NO : INTERSTATE 89      BRIDGE NO : 97N, 97S, 98N, 98S

PROJECT LOCATION :    BRIDGE 97 N & S OVER RECREATION PATH (MM 123.118)  
   BRIDGE 98 N & S OVER VT ROUTE 78 (EXIT 21) (MM 123.368)

PROJECT DESCRIPTION : PAVE AND MEMBRANE BRIDGES 97N, 97S, 98N WITH  
   SUBSTRUCTURE WORK ON BRIDGES 97N, 97S, 98N, 98S

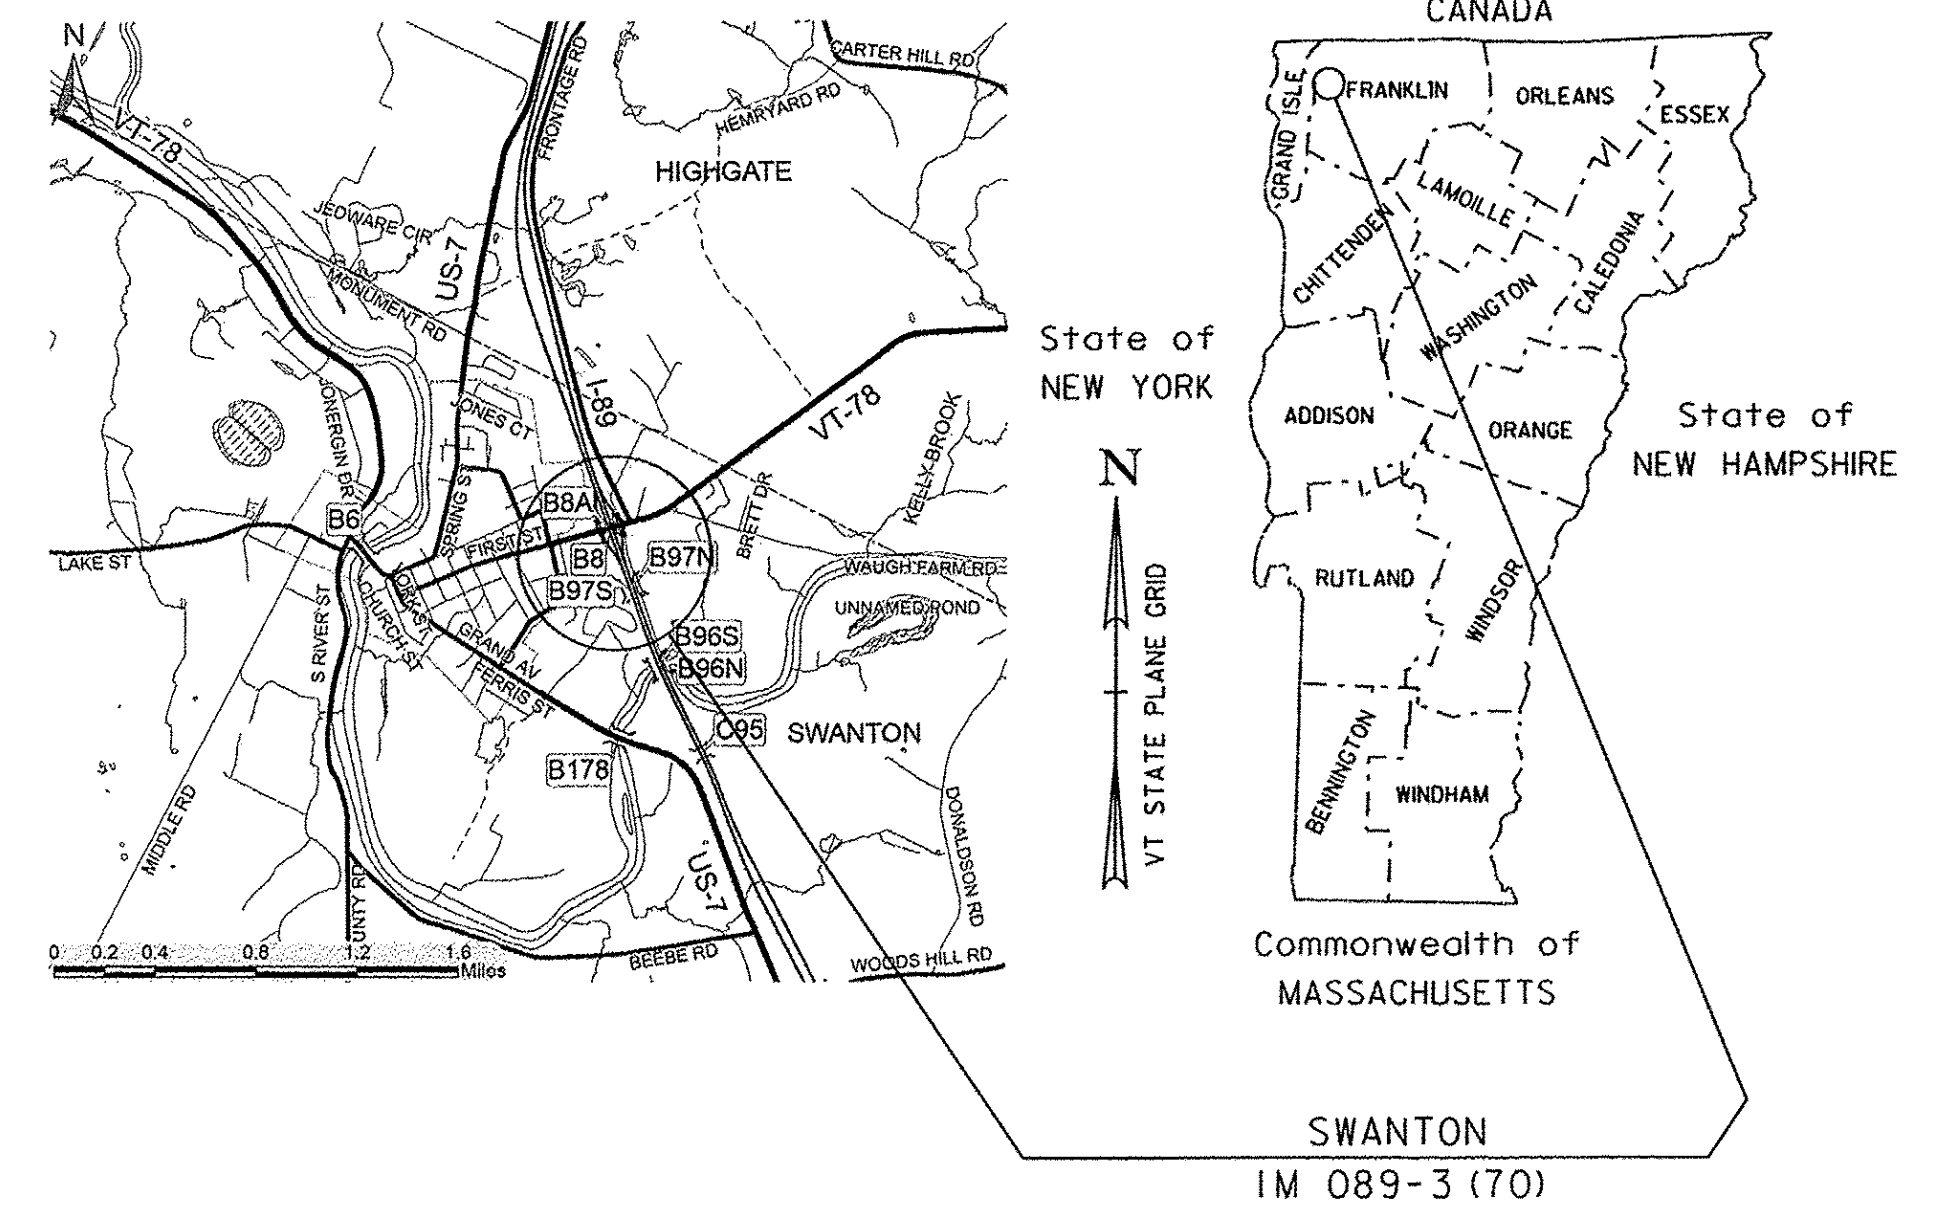


RECORD PLANS	
CONTRACTOR:	COLD RIVER BRIDGES, LLC- KEENE, NH
RESIDENT ENGINEER:	SCOTT WHEATLEY
CONSTRUCTION BEGAN:	JUNE 20, 2013
CONSTRUCTION COMPLETE:	JUNE 5, 2014
RECORD PLANS BY:	SCOTT WHEATLEY & CRAIG PIERCE
I HEREBY CERTIFY THAT ALL THE CONSTRUCTION REQUIRED BY THIS SET OF DRAWINGS HAS BEEN ACCOMPLISHED AS INDICATED HEREIN.	
BY	RESIDENT ENGINEER
DATE <u>2-23-16</u>	
NOTE: Any further information concerning final quantities, amounts or other details relative to this project may be found at Central Files in the electronic archives.	

LENGTH OF STRUCTURES :	BR 97 N	192 FT
	BR 97 S	192 FT
	BR 98 N	202 FT
TOTAL LENGTH OF STRUCTURES:		586 FT

QUALITY ASSURANCE PROGRAM: LEVEL 1

CONVENTIONAL SYMBOLS	
COUNTY LINE	
TOWN LINE	
LIMITS OF ACCESS	
POINT OF ACCESS	
FENCE LINE	
STONE WALL	
TRAVELED WAY	
GUARD RAIL	
RAILROAD	
SURVEY LINE	
CULVERT	
POWER POLE	
TELEPHONE POLE	
TREES	
CONTROL OF ACCESS	
PROPERTY LINE	
R.O.W. TAKING LINE	
SLOPE RIGHTS	
TOP OF CUT	
TOE OF SLOPE	

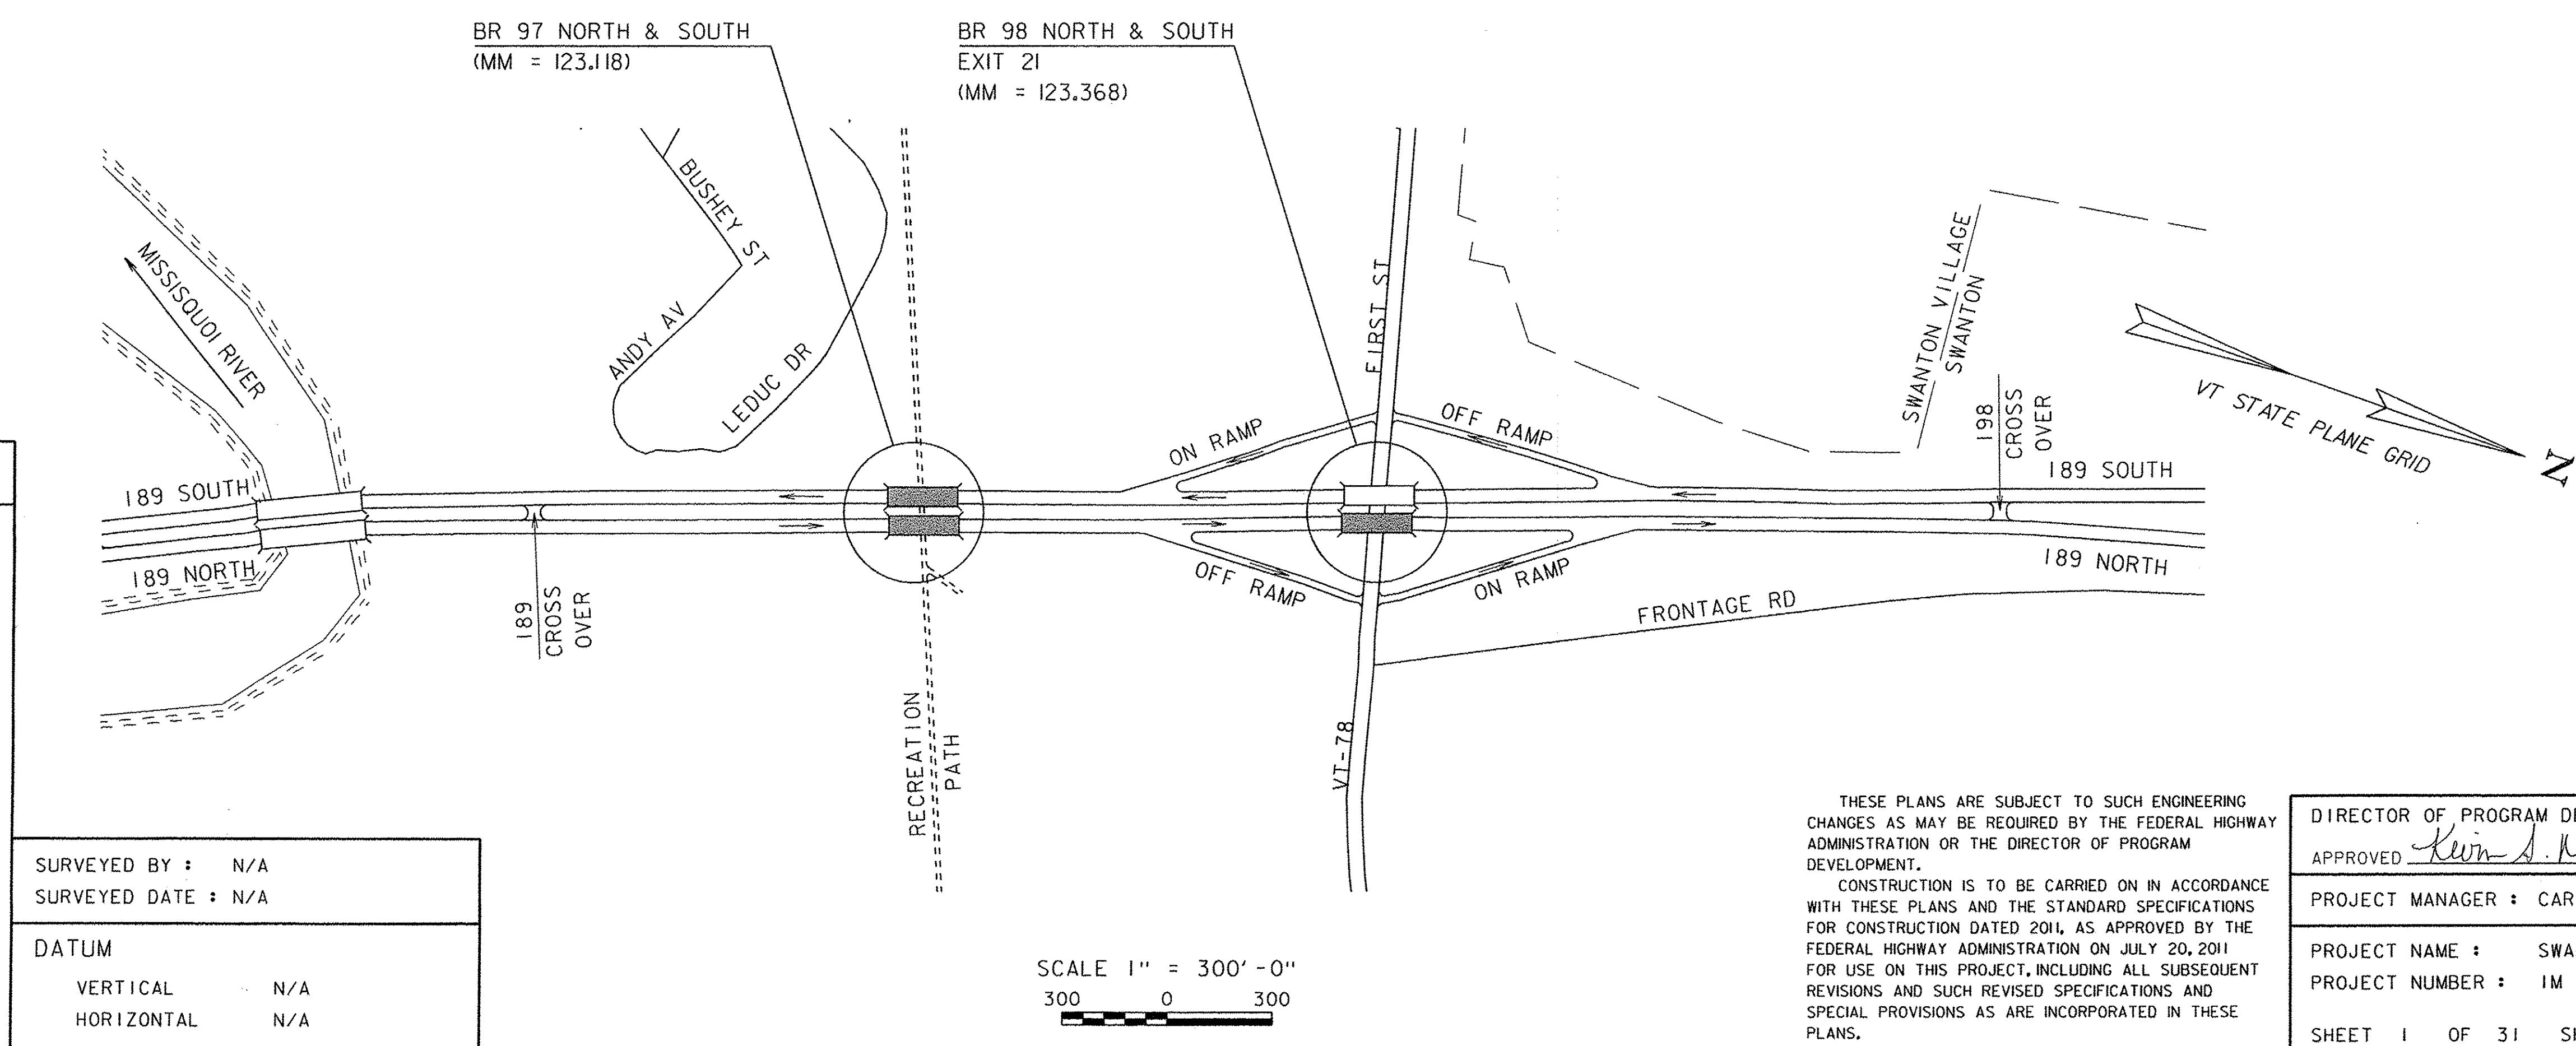

SURVEYED BY :	N/A
SURVEYED DATE :	N/A
DATUM	
VERTICAL	N/A
HORIZONTAL	N/A

SCALE 1" = 300'-0"  
300 0 300

THESE PLANS ARE SUBJECT TO SUCH ENGINEERING CHANGES AS MAY BE REQUIRED BY THE FEDERAL HIGHWAY ADMINISTRATION OR THE DIRECTOR OF PROGRAM DEVELOPMENT.

CONSTRUCTION IS TO BE CARRIED ON IN ACCORDANCE WITH THESE PLANS AND THE STANDARD SPECIFICATIONS FOR CONSTRUCTION DATED 2011, AS APPROVED BY THE FEDERAL HIGHWAY ADMINISTRATION ON JULY 20, 2011 FOR USE ON THIS PROJECT, INCLUDING ALL SUBSEQUENT REVISIONS AND SUCH REVISED SPECIFICATIONS AND SPECIAL PROVISIONS AS ARE INCORPORATED IN THESE PLANS.

DIRECTOR OF PROGRAM DEVELOPMENT	
APPROVED	DATE 3/21/13
PROJECT MANAGER : CAROLYN CARLSON	
PROJECT NAME : SWANTON	
PROJECT NUMBER : IM 089-3 (70)	
SHEET 1 OF 31 SHEETS	