



CLEAN AND REPOINT THE GRANITE CURBS; THIS WORK WILL BE PAID FOR UNDER ITEM 616.225 REPOINTING GRANITE BRIDGE CURB (TYP)

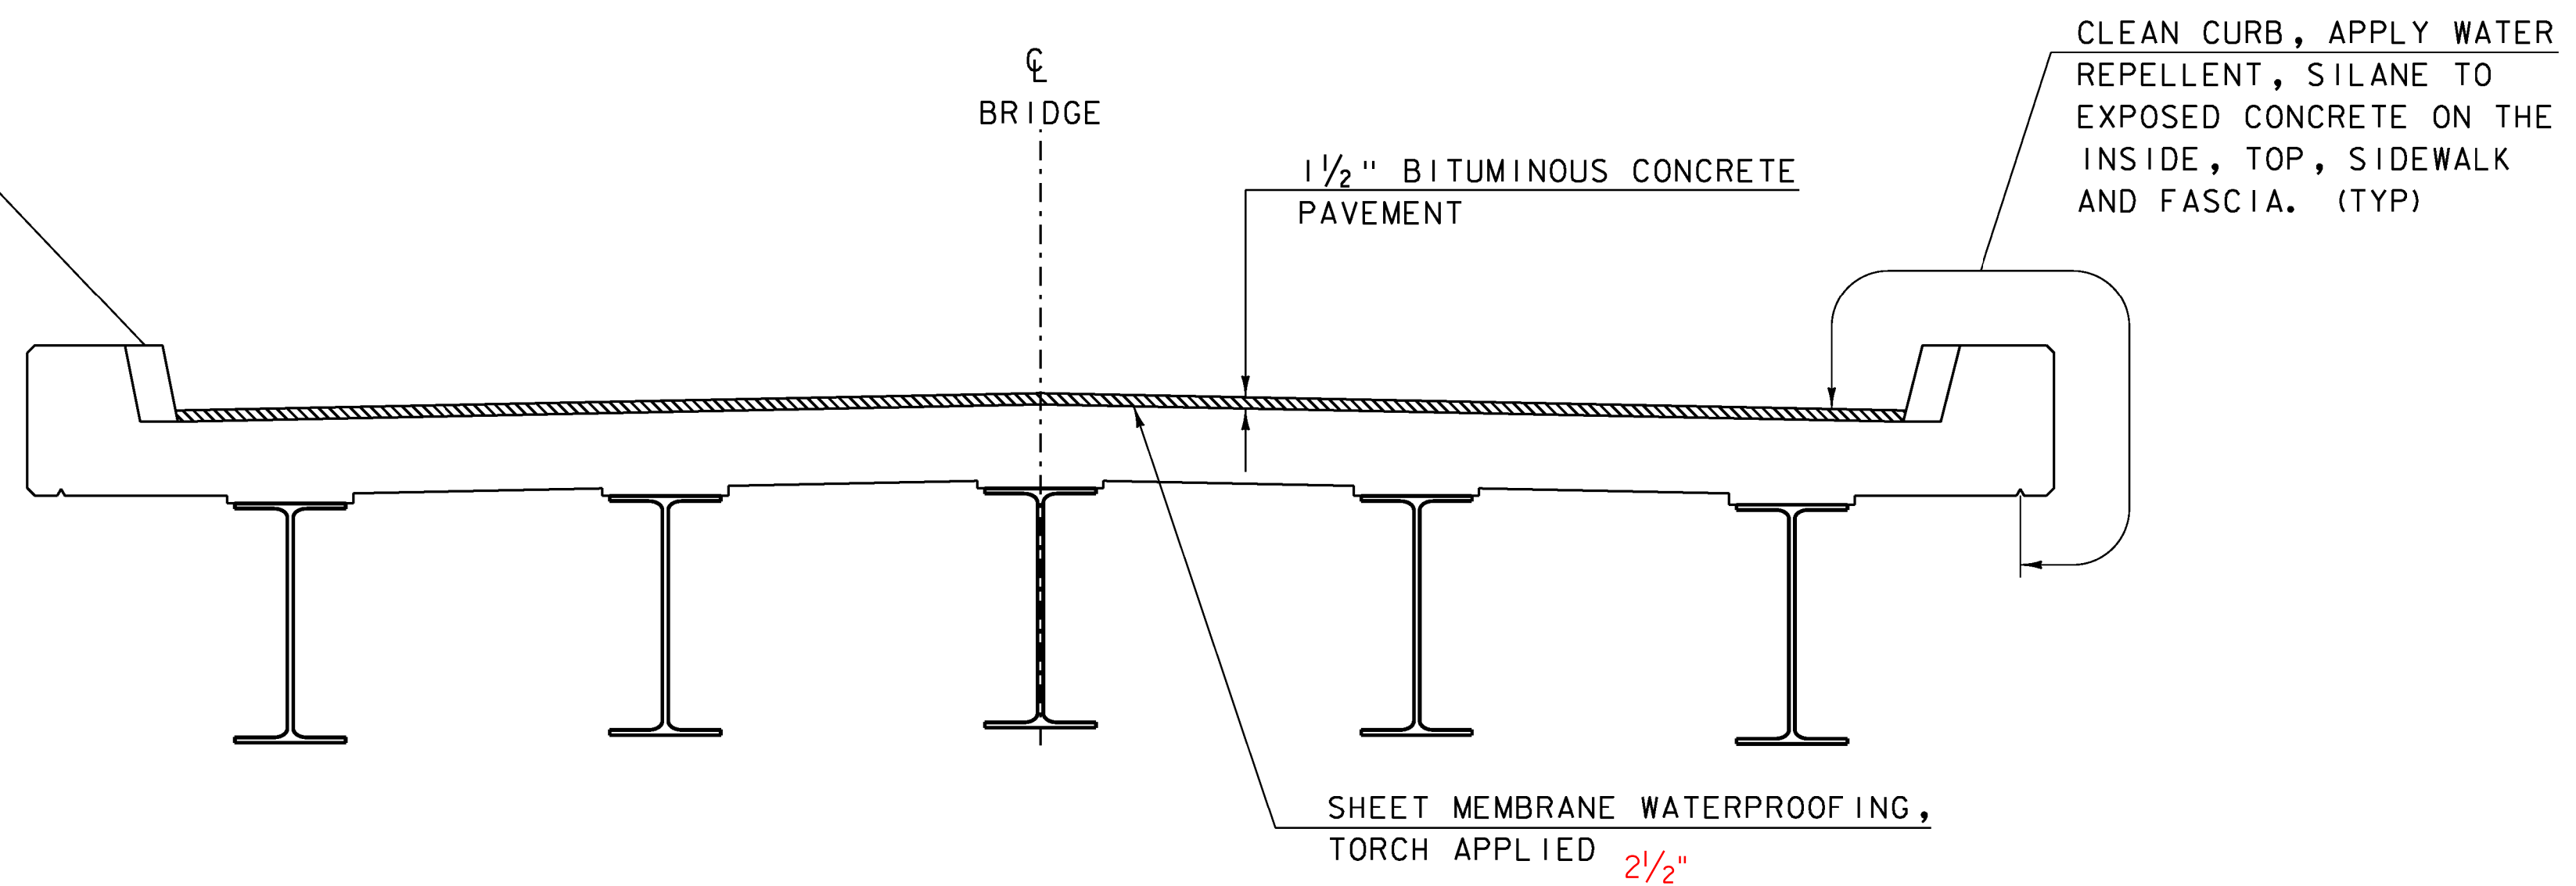

TYPICAL BRIDGE SECTION


NOTE: EXISTING BRIDGE GEOMETRY VARIES BY LOCATION
TYPICAL SECTION SHOWN FOR SCHEMATIC PURPOSES ONLY.

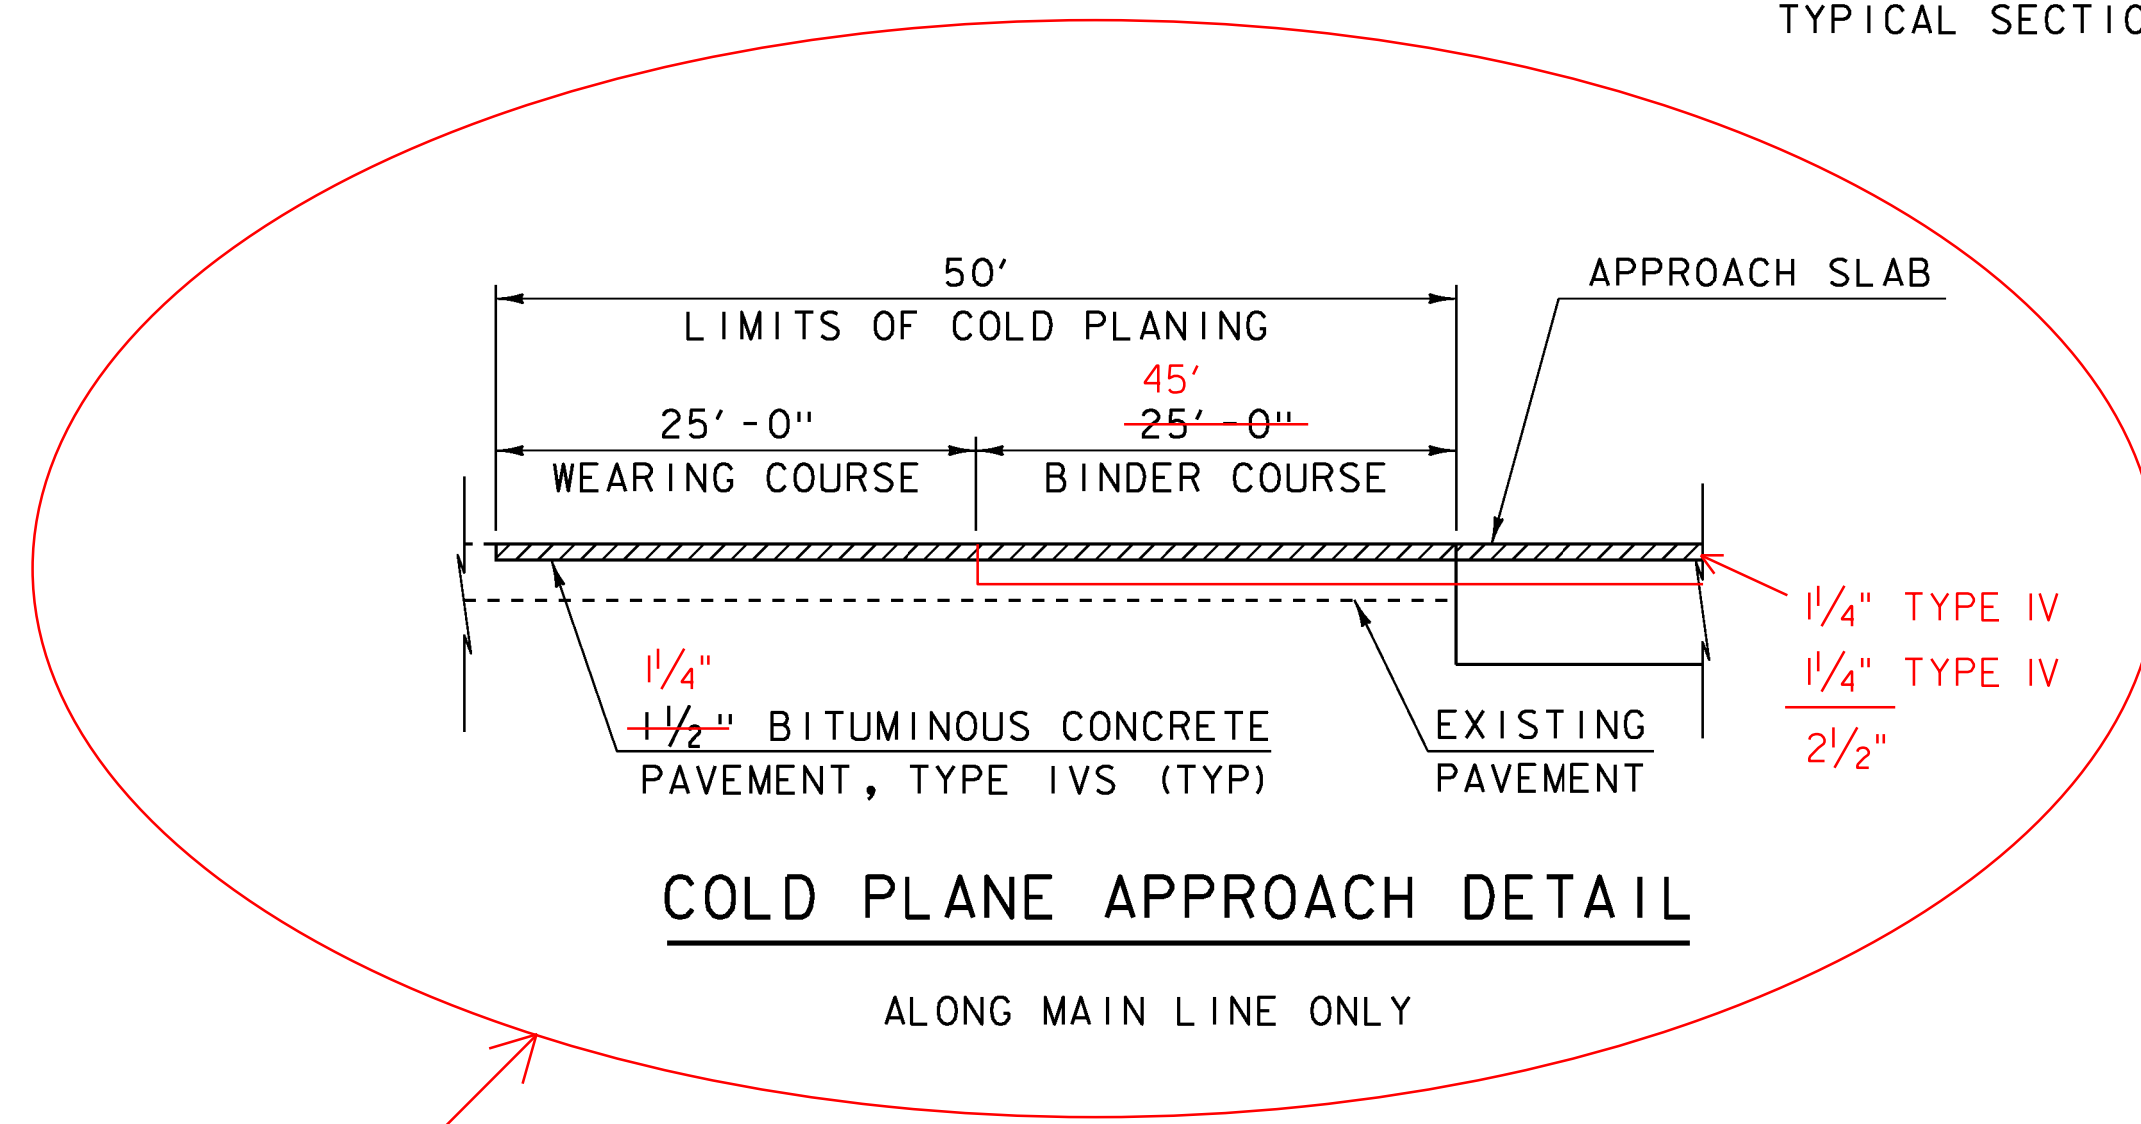

COLD PLANE APPROACH DETAIL

ALONG MAIN LINE ONLY

SEE NEW TYPICAL DETAILED IN WRITTEN ORDER #6. (8-23-13)

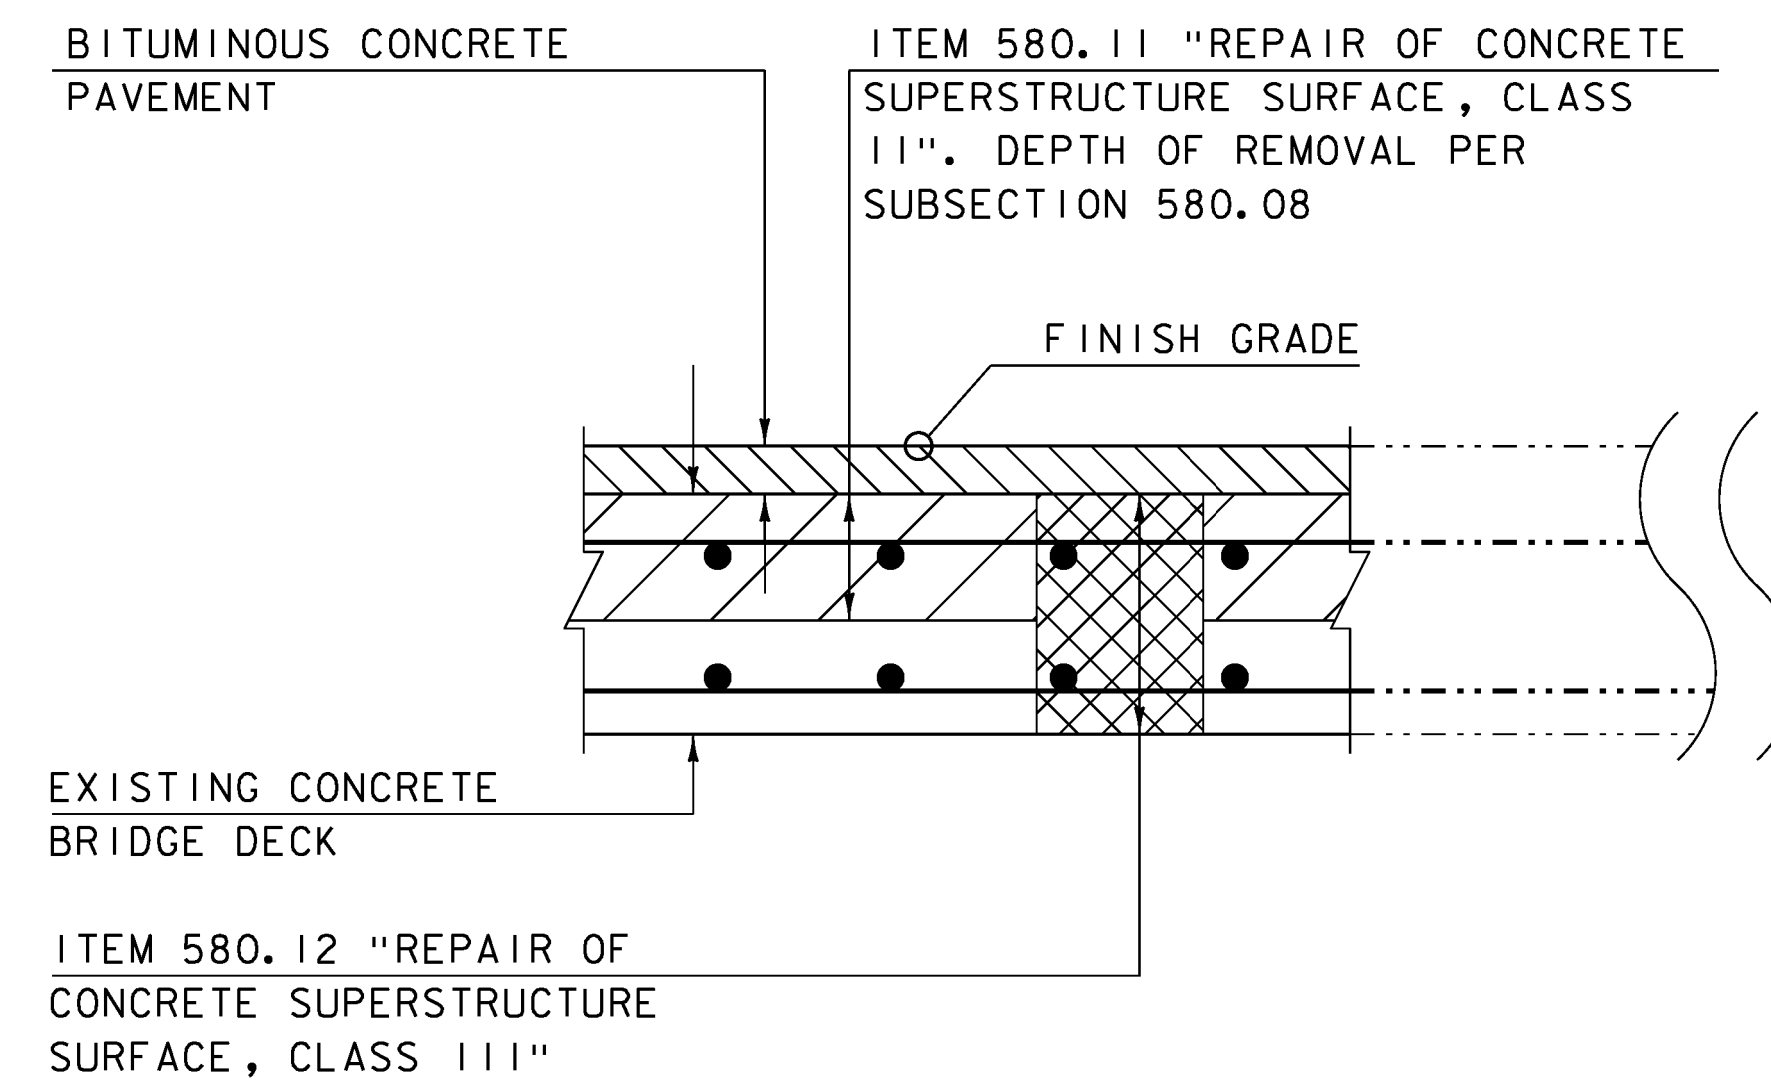

CONCRETE REPLACEMENT
PAY LIMIT DETAIL

BRIDGE NUMBER	CROSSING OVER	LENGTH OF BRIDGE (FT)	CURB TO CURB PAVEMENT WIDTH (FT)	TOWN	MILE MARKER
1 89 BR 97 N	RECREATION PATH	152.00	30.00	SWANTON	123.118
1 89 BR 97 S	RECREATION PATH	152.00	42.00	SWANTON	123.118
1 89 BR 98 N	VT 78	162.00	30.00	SWANTON	123.368
1 89 BR 98 S	VT 78	162.00	30.00	SWANTON	123.368

BRIDGE LOCATION TABLE

NOTE:
NF = NEAR FACE
FF = FAR FACE
EF = EACH FACE
▲ = CUT TO FIT IN FIELD
3" CLEAR, UNLESS OTHERWISE SPECIFIED ON THE PLANS.
2'-2" BAR LAP UNLESS OTHERWISE SPECIFIED ON THE PLANS.

PROJECT NAME: SWANTON
PROJECT NUMBER: IM 089-3(70)

FILE NAME: s12q276sup.dgn
PROJECT LEADER: C. CARLSON
DESIGNED BY: H. SALLS
SUPERSTRUCTURE DETAILS
PLOT DATE: 11-APR-2013
DRAWN BY: R. PELLETT
CHECKED BY: H. SALLS
SHEET 6 OF 31

DRAWING NOT TO SCALE UNLESS NOTED OTHERWISE