

PLAN
SCALE 3/8" = 1'-0"

SUBSTRUCTURE NOTES

IT IS ANTICIPATED THAT 30% OF THE SUBSTRUCTURE WILL REQUIRE A CLASS I SUBSTRUCTURE REPAIR; WHILE 10% WILL REQUIRE A CLASS II SUBSTRUCTURE REPAIR. THE ENGINEER WILL DETERMINE THE LEVEL OF REPAIR NEEDED.

THE PICTURES REPRESENT THE EXISTING CONDITION OF THE SUBSTRUCTURES BUT DO NOT SHOW ALL THE AFFECTED AREAS.

PICTURE 4




PICTURE 5



PICTURE 6



PICTURE 7

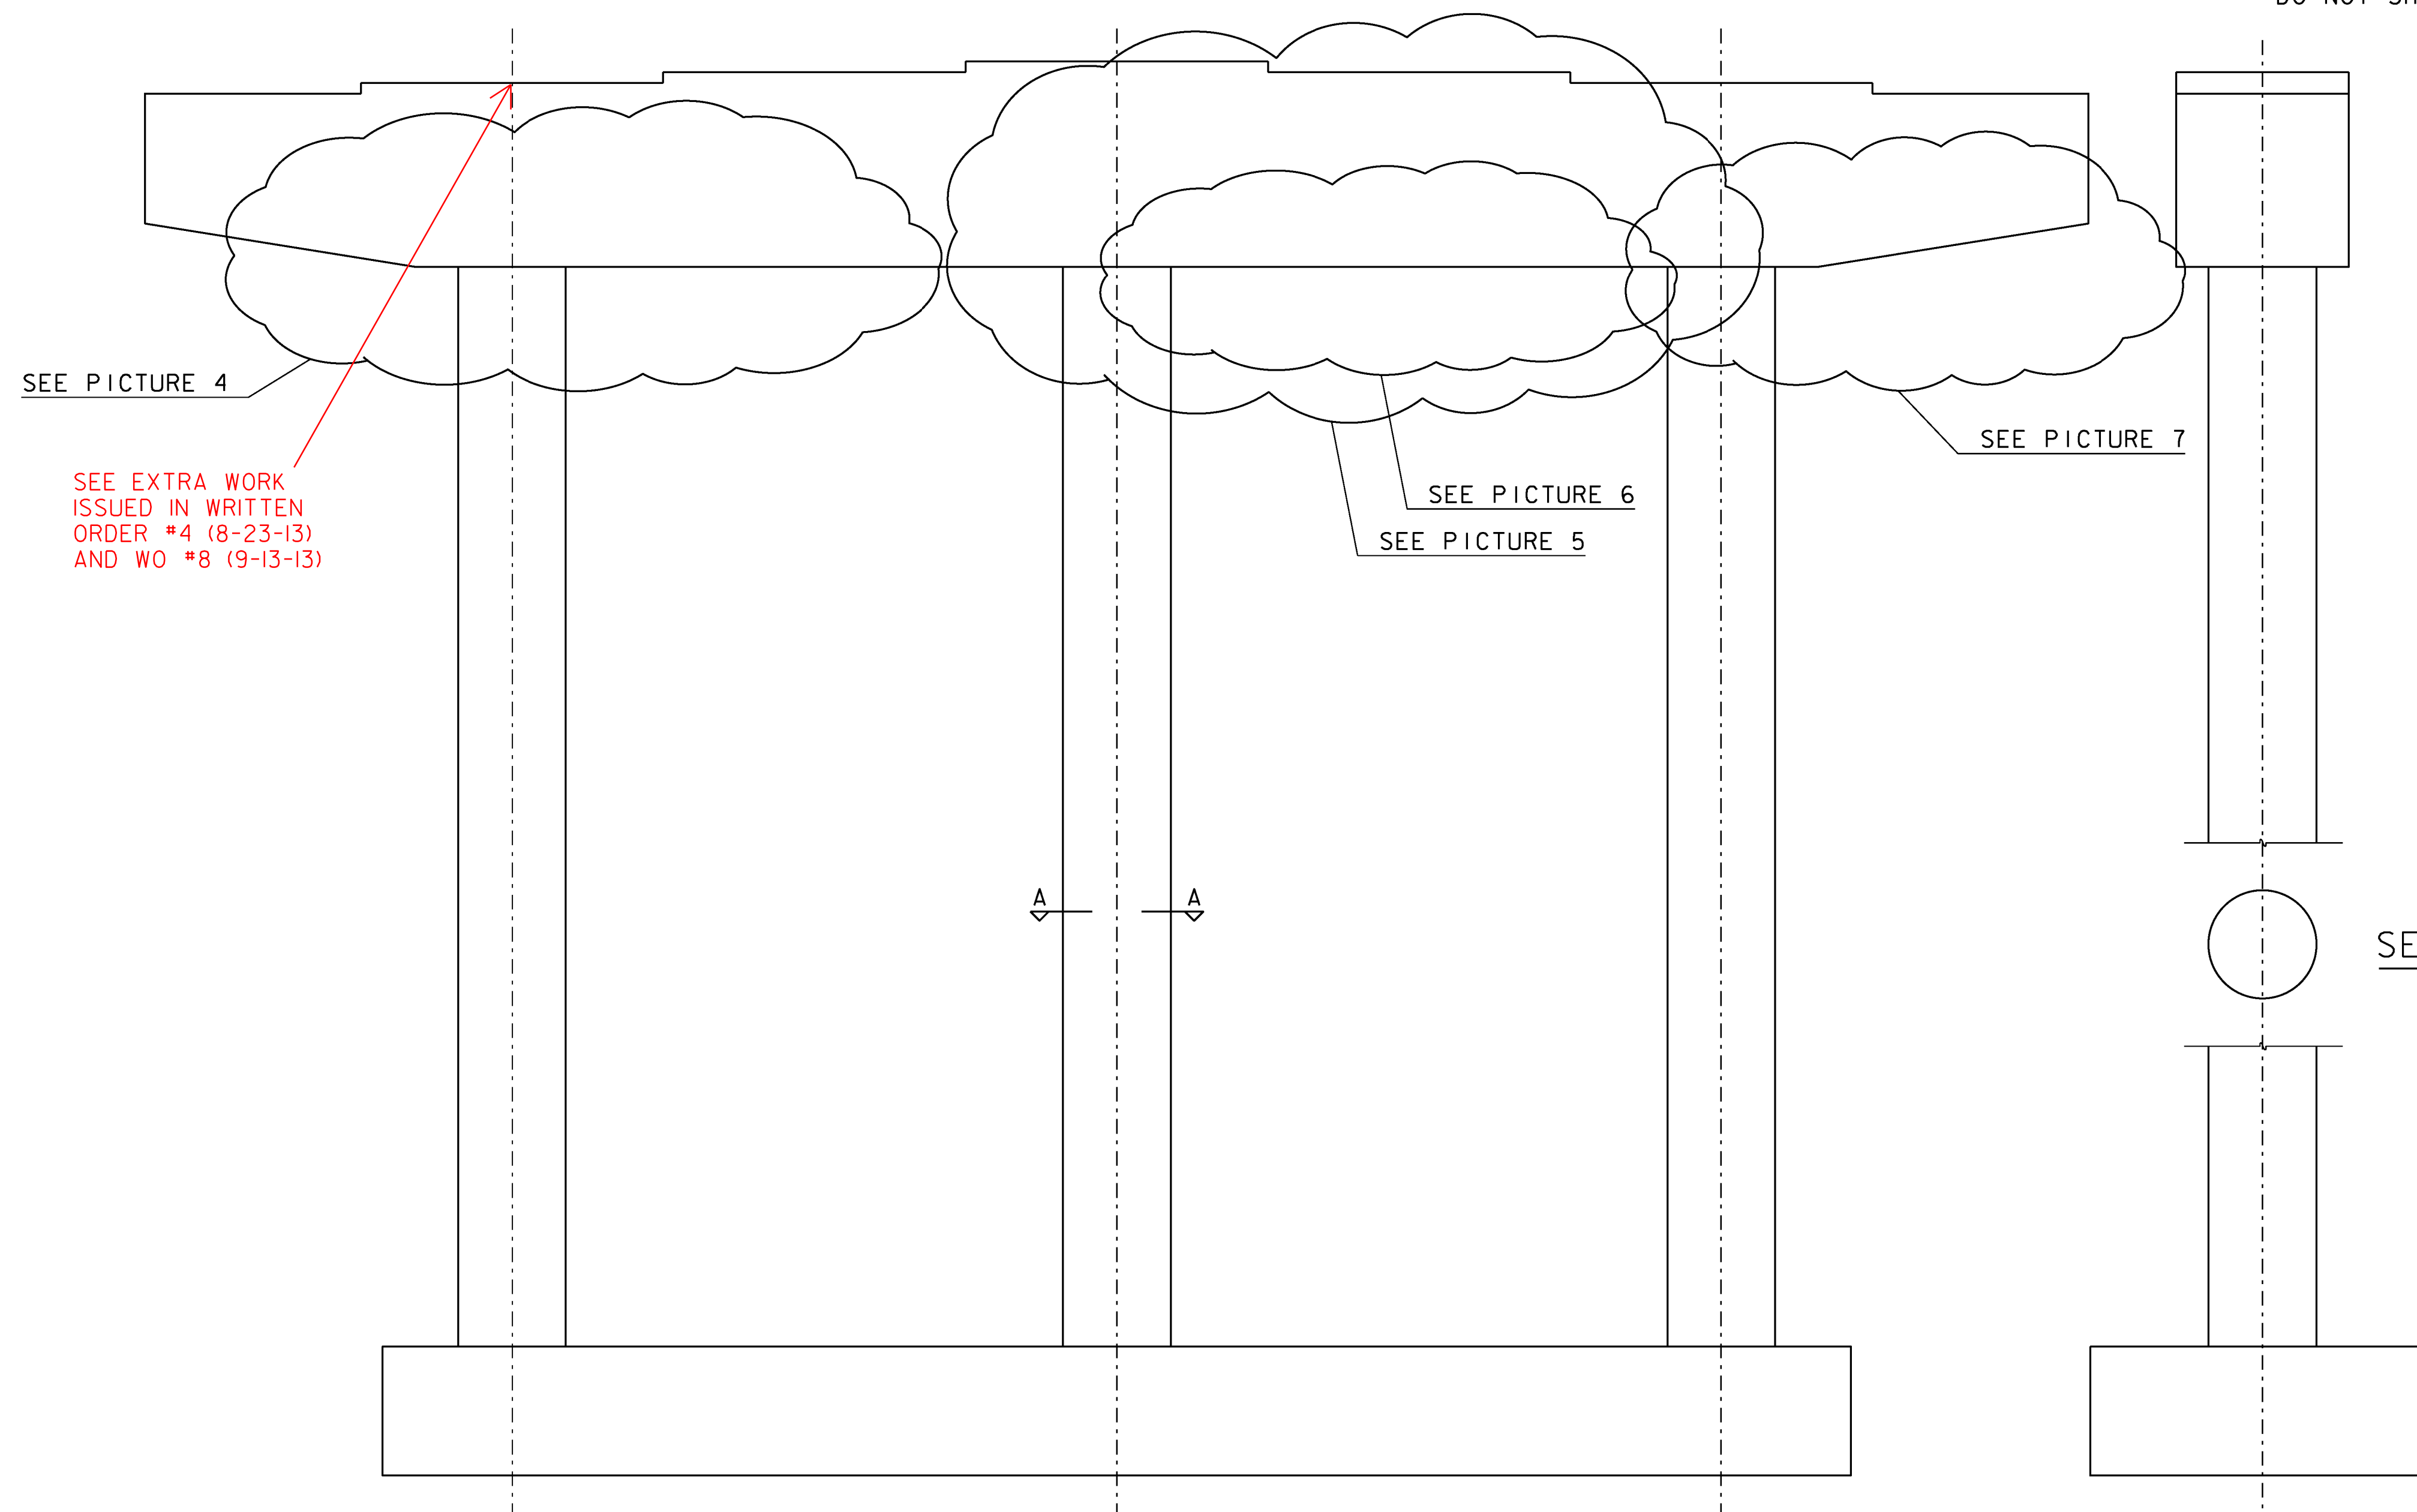

ELEVATION
SCALE 3/8" = 1'-0"

TYPICAL SECTION
SCALE 3/8" = 1'-0"

NOTE:
FOR MORE DETAILED INFORMATION VIEW THE REFERENCE PLANS.

PROJECT NAME: SWANTON
PROJECT NUMBER: IM 089-3(70)

FILE NAME: sl2a276sub.dgn
PROJECT LEADER: C. CARLSON
DESIGNED BY: H. SALLS
BRIDGE 97 SOUTH - PIERS NO. 1 & 2

PLOT DATE: 19-MAR-2013
DRAWN BY: DZENAN K.
CHECKED BY: H. SALLS
SHEET 10 OF 31