


PLAN

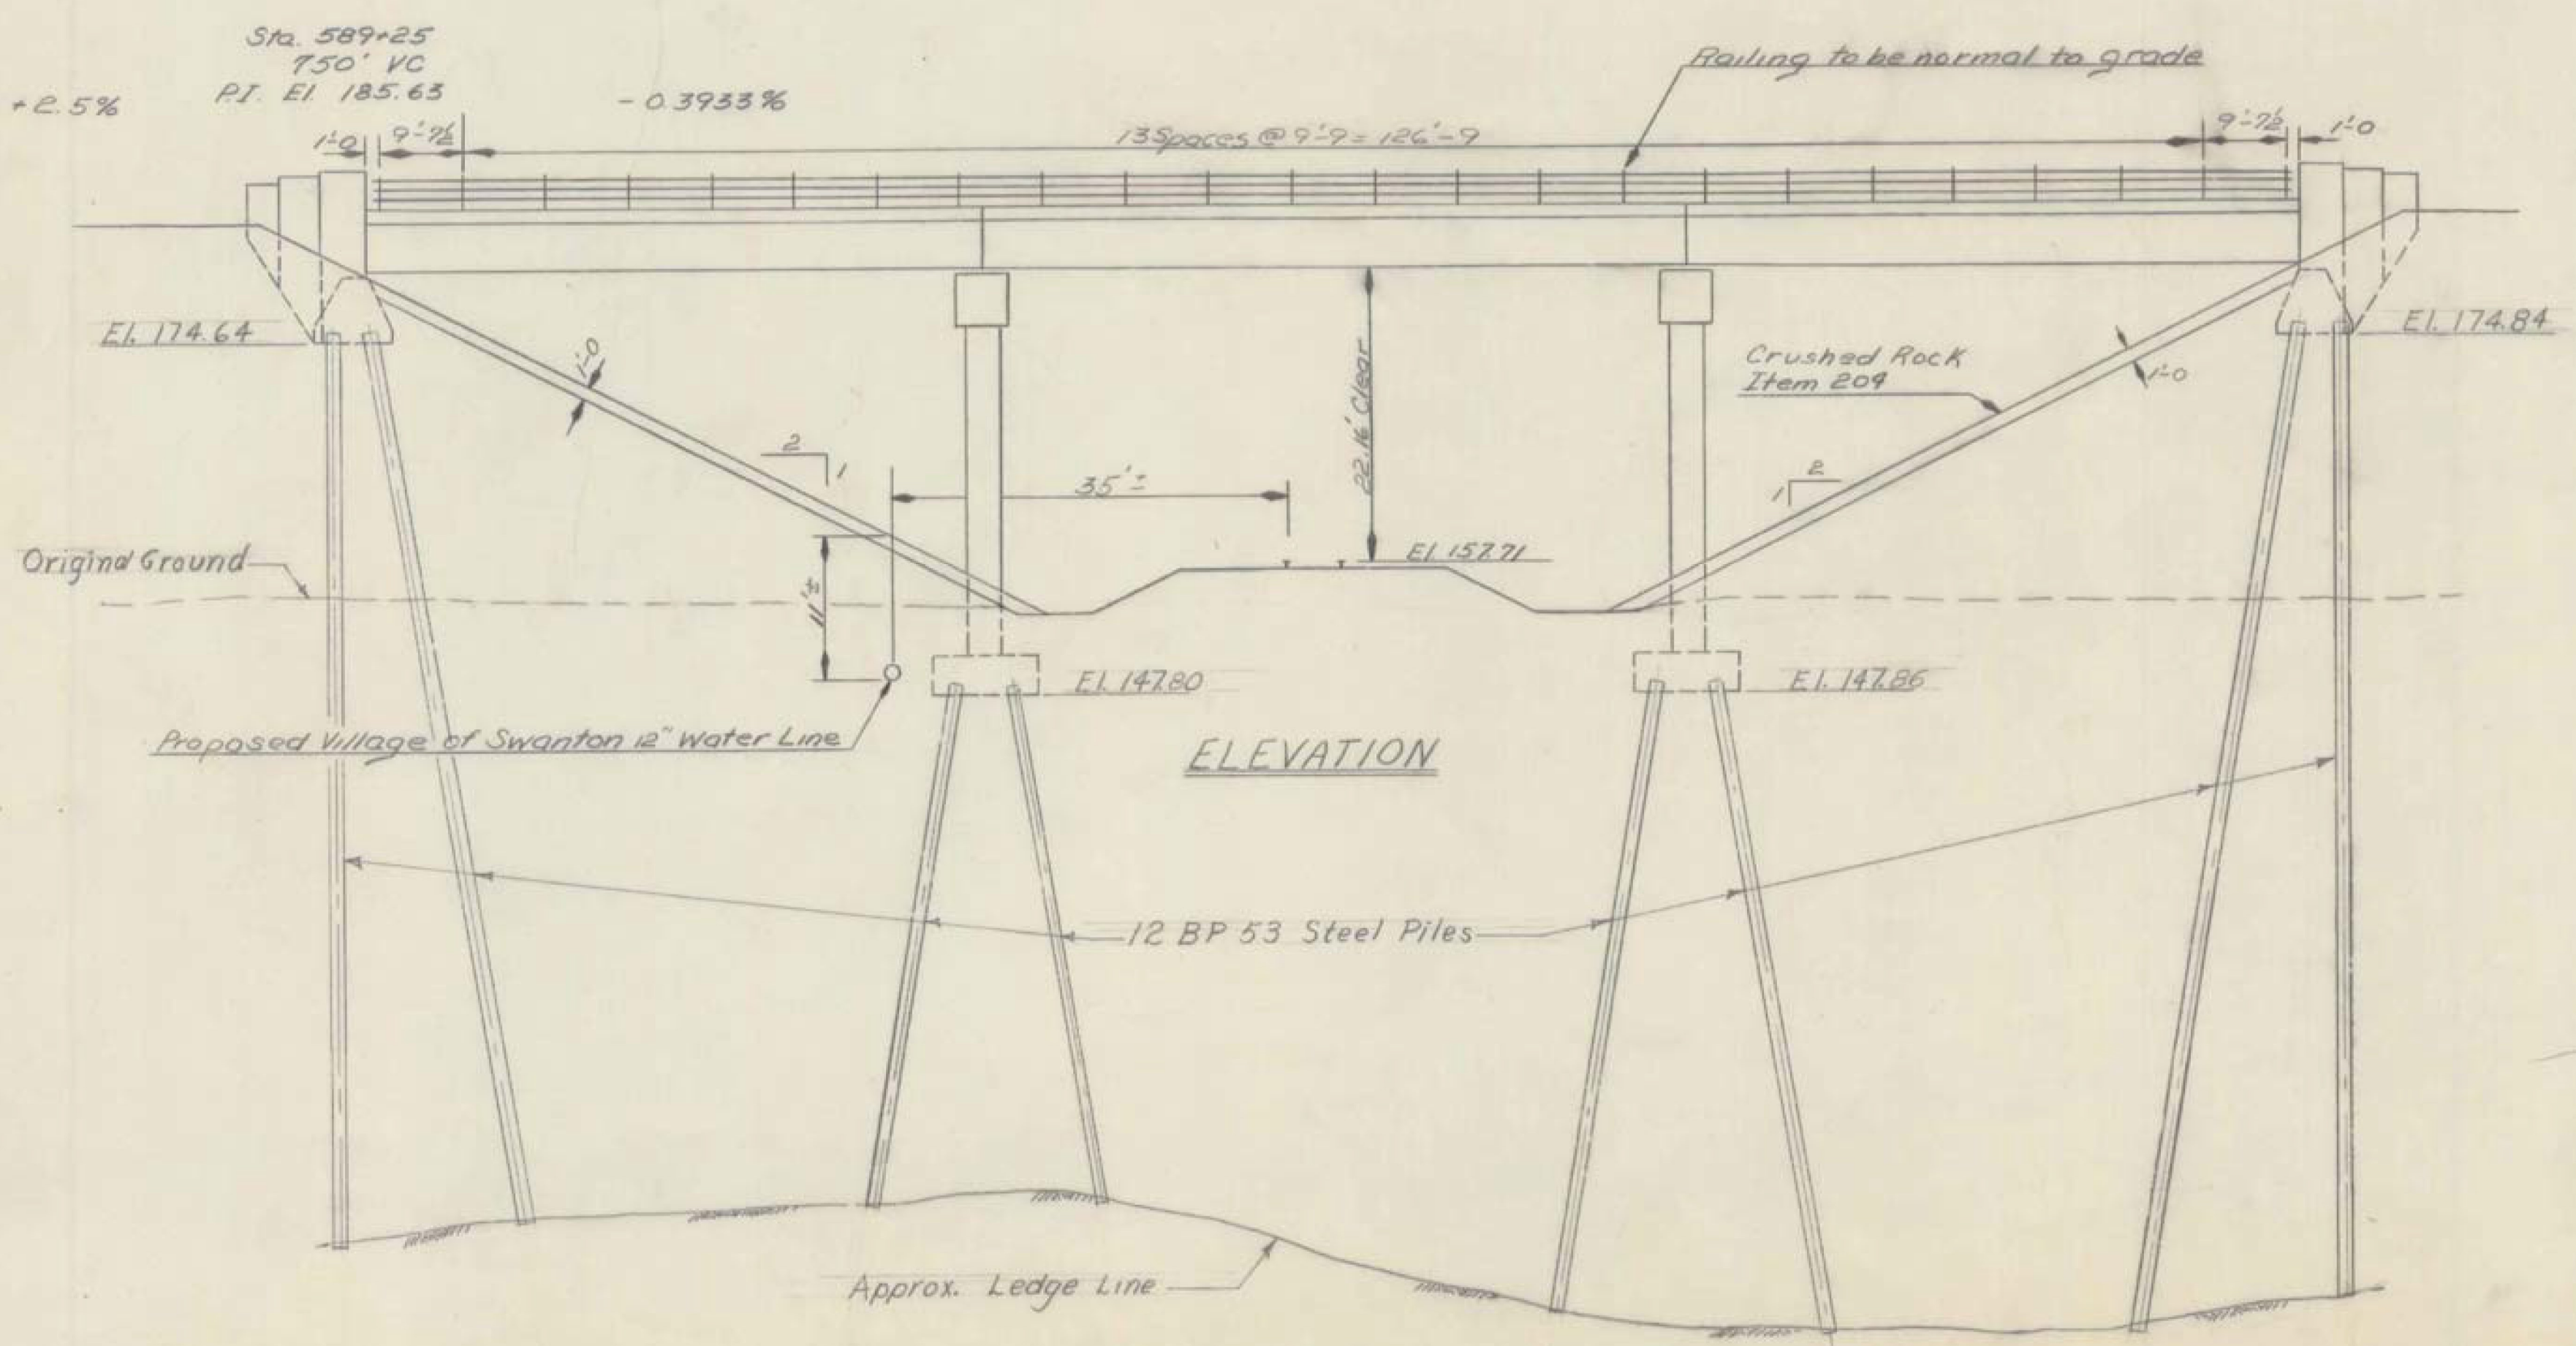

ELEVATION

Abut. #3	Pier #3	Pier #4	Abut. #4			
179.69	179.80	179.79	179.86	179.87	179.89	1
179.92	180.07	180.07	180.19	180.15	180.11	2
180.02	180.17	180.17	180.23	180.29	180.21	3 Beam
179.92	180.07	180.07	180.14	180.15	180.11	4 NO.
179.69	179.80	179.79	179.86	179.87	179.89	5
Bearing Device Fix.		Exp. Fix.		Exp. Fix.		Exp.

Bridge Seat Elevations

- LIST OF SHEETS -

- Br. 301 Plan and Elevation
- Br. 302 Bridge Quantity Sheet
- Br. 303 Preliminary Information Sheet
- Br. 304 Boring Logs
- Br. 305 Approach Slabs #3 and #4
- Br. 306 Abutments #3 and #4
- Br. 307 Piers #3 and #4
- Br. 308 Reinforcing Steel Schedule

- BRIDGE STANDARDS -

- SCB-30-62
- SCB-D1 thru D9-62
- SB-5G-62 Sheets #1 & #2

- GENERAL NOTES -

- Elevation datum sea level based on nearest U.S. Government Vertical Control.
- For additional notes see SCB-D1-62.
- For Bearing Devices see SCB-DB-62, Detail A.
- Bridge Railing Item 572 shall be the Galvanized Metal as indicated in detail @ on sheet 2 of 2 of standard SB-5G-62.

SWANTON
IM 089-3(70)
SHEET 16 OF 31
FOR REFERENCE
ONLY

ITEM NO.	ITEM	UNIT	NET	TOTAL	FINAL
	CHAN. EXCAV. OF EARTH	C.Y.			
	CHAN. EXCAV. OF ROCK	C.Y.			
	UNCLASS. CHAN. EXCAV.	C.Y.			
	STRUCT. EXCAV.	C.Y.			
	CONC. CLASS AA (MOD.)	C.Y.			
	CONC. CLASS B (MOD.)	C.Y.			
	REINF. STEEL	LBS.			
	ASPHALTIC-ASB. COATING	S.Y.			
	TREATED TIMBER PILING	L.F.			
	SPLICES FOR STEEL PILING	EA.			
	STEEL PILING	L.F.			
	UNTREATED TIMBER PILING	L.F.			

BR. 301 OF 308

STATE OF VERMONT
 DEPARTMENT OF HIGHWAYS

TOWN OF SWANTON-HIGHGATE
 ROAD NO. _____ BRIDGE NO. _____
 NBI-89 OVER ST. J. & L.C. R.R.

PLAN AND ELEVATION
 SCALE 1"=10'

SURVEYED BY _____
 DRAWN BY SHS:K CHECKED BY RLO

PROJECT NO. I-89-3 (30)
 SHEET 165 OF 246

Sheet 715 of 122