


Elev. of B.M. = Top of Rail = 158.0 @ Sta 590+88.6

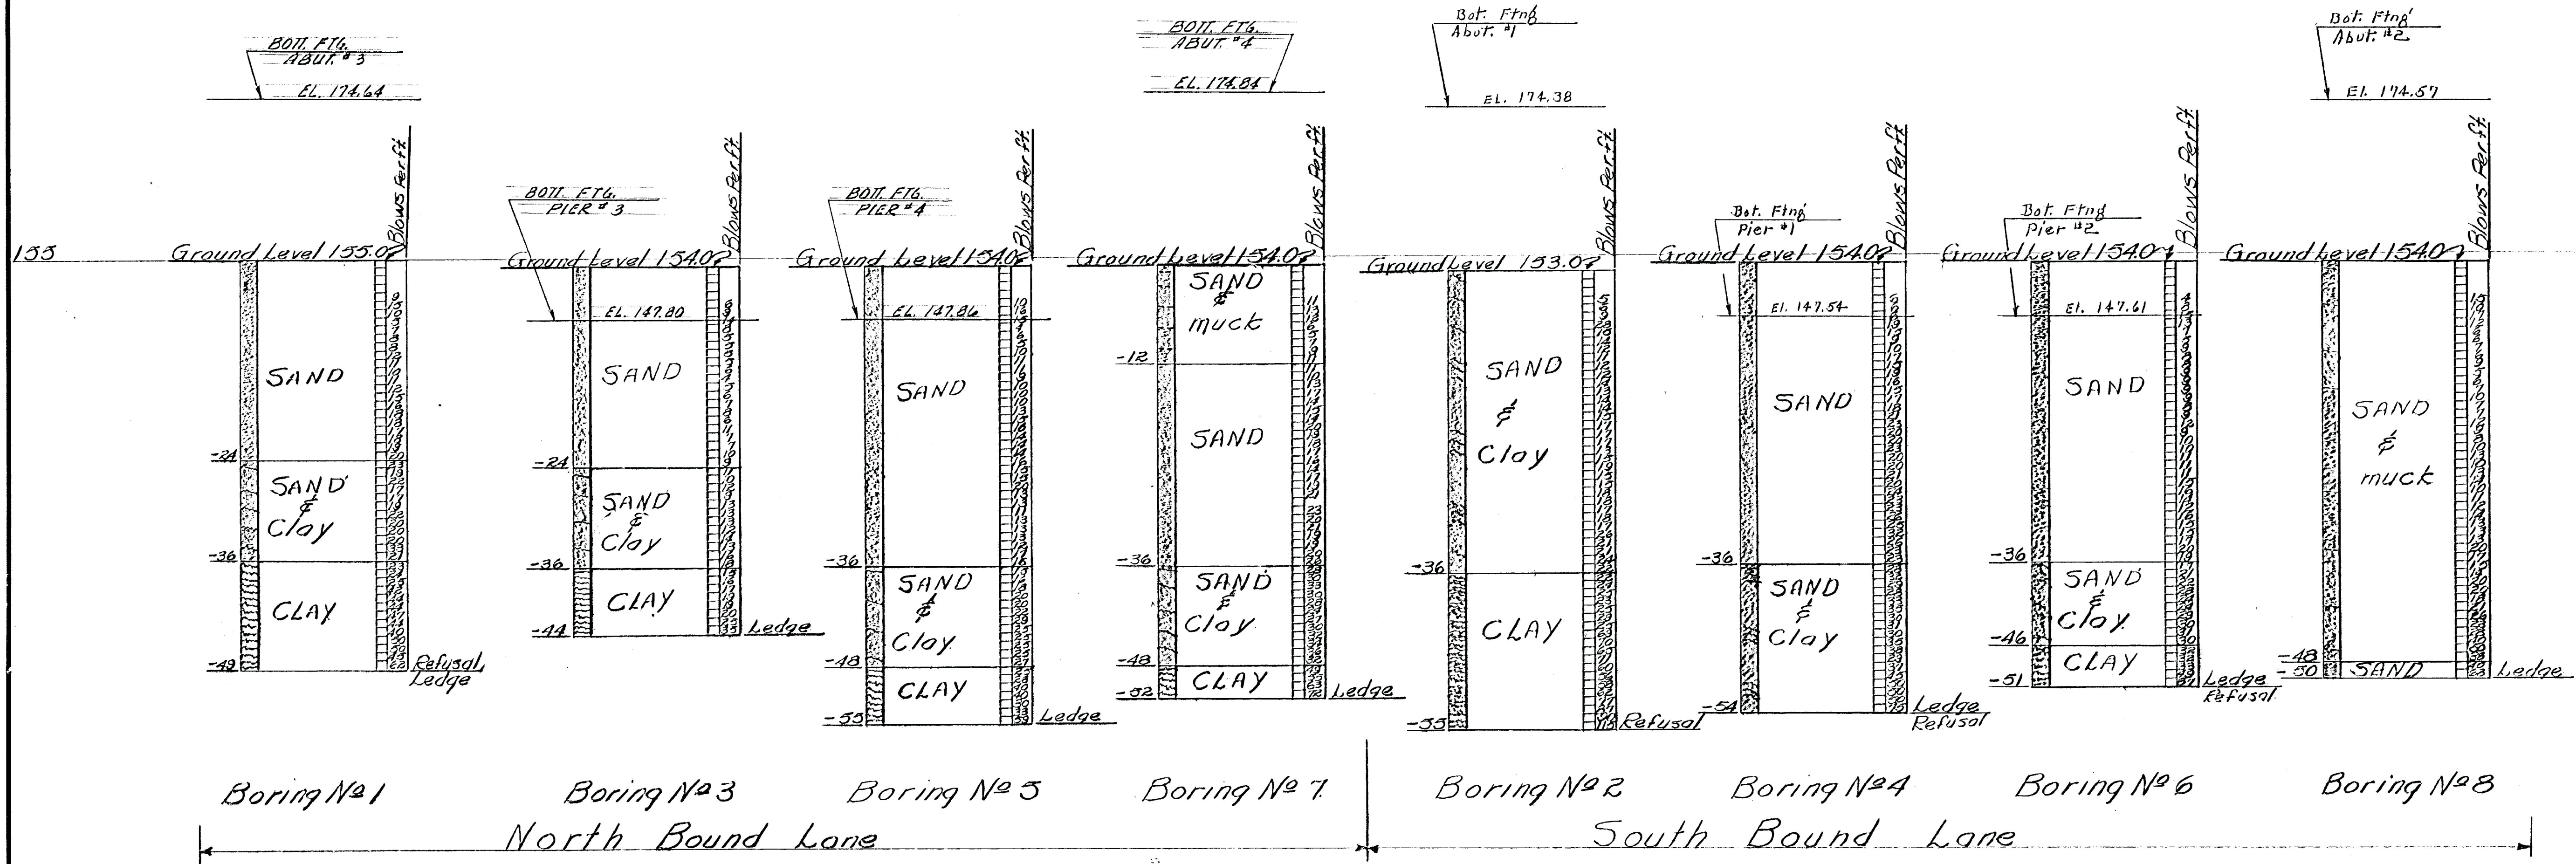

BR. 304 OF 308

STATE OF VERMONT
DEPARTMENT OF HIGHWAYS

TOWN OF Swanton - Highgate
ROUTE No. 89 LOG STA. 591+66
Over St. J. & L.C. Railroad
Borings

SCALE 1" = 10'-0"
SURVEYED BY Stratton
DRAWN BY Hopkins CHECKED BY EAB
PROJECT No. 187-3(32)
SHEET 138 OF 242

SWANTON
IM 089-3(70)
SHEET 19 OF 31
FOR REFERENCE
ONLY