


**ESTIMATED QUANTITIES (BRIDGE ONLY)**

ITEM*	ITEM	UNIT	NET	TOTAL STAGE I	TOTAL STAGE II	FINAL #
107	STRUCTURE EXCAVATION	C.Y.	<del>160</del>			130
204	SUB-BASE OF CRUSHED ROCK MOD. UNDER STRUCTURE	C.Y.	<del>97</del>			109
222	Gravel Backfill	C.Y.	<del>36</del>			0
* 318	TAR EMULSION FOR BRIDGE FLOORS	GAL.		270		0
* 373	RUBBER JOINT MATERIAL	L.F.	<del>128</del>			122
* 361-B	BIT. CONC. PAV'T.	TON		66		0
401-B	CONCRETE CLASS B, MOD.	C.Y.	<del>242</del>			245
402	REINFORCING STEEL	LB.	<del>66,560</del>			66,499
403	SPIRAL REINFORCEMENT @2040	LB.	<del>1,074</del>			1
404-A	STRUCTURAL STEEL	LB.	<del>156,220</del>			156,172
407	ASPHALTIC-ASBESTOS COATING	S.Y.	<del>35</del>			36
501	FURNISHING EQUIPMENT FOR DRIVING PILES	L.S.		14		14
401-AA	CONCRETE CLASS AA, MOD.	C.Y.	<del>784</del>			183
503	SPLICES FOR STEEL PILING	EA.	<del>32</del>			20
504	STEEL PILING (123P53)	L.F.	<del>3,620</del> (In place)			3,287
556-C	GRANITE BRIDGE CURB MOD.	L.F.	<del>356</del>			355
572	BRIDGE RAILING (GALVANIZED METAL)	L.F.	<del>315</del>			315
* 372-A	JOINT SEALER HOT BURIED	L.F.		60		0
594	UNIFORMED TRAFFIC OFFICERS	MAN HR.				0
* 102-A	GRANULAR BORROW	C.Y.		2160		0
* Note:	These items to be included in roadway quantities					
	Cut-offs @ 50% Unit Price	L.F.		0		333

- GENERAL NOTES**
- All material and construction shall conform to the State of Vermont Department of Highway, Standard Specifications for Road and Bridge Construction dated Jan. 1956 and the AASHTO Standard Specs. dated 1957. Designed for AASHTO leading modified for National System of Interstate Highways applied in accordance with the provision of the AASHTO Standard Specifications, Article 1.2.B.
  - Where rock is encountered no footing shall be poured until all blasting in an area 300 feet from the structure has been completed.
  - Final coat of field paint shall be green unless otherwise directed by the Engineer.
  - All dimensions given are measured horizontally or vertically unless otherwise noted.
  - All dimensions given at 68°F.
  - All reinforcing steel to have a clearance of 3" unless otherwise noted.
  - All exposed edges of concrete shall be chamfered 1" x 1" unless otherwise noted.
  - Borings indicated on the drawings have been made for design purposes only and are not warranted to show actual subsurface conditions.
  - Elevation sea level based on nearest U.S. Government Vertical Control.
  - Steel bearing piles shall be driven to ledge rock unless otherwise approved by the Engineer. When piles are driven in till, the material should be such as to have no stones large enough to interfere with the driving of piles.
  - Cross slope of approach slab to conform with the cross slope of bridge.
  - The top surfaces of all piers and abutments shall be sloped 4" per foot from the front edge of abutment curtain wall or center line of piers, except for bearing pads projecting 1" or more above the general area, which surfaces shall be level. The entire exposed top surface of abutment and piers shall be coated with asphaltic Asbestos coating 6" thick as per item 407 of the specs. The application of this item shall be after all painting and incidental items are completed.
  - Unless otherwise called for all beams shall be cambered as specified on Standard Structures ~~SCB-DI-G2~~ SCB-DI-G2
  - All expansion material shall be premoised cork containing no Tar or asphalt.

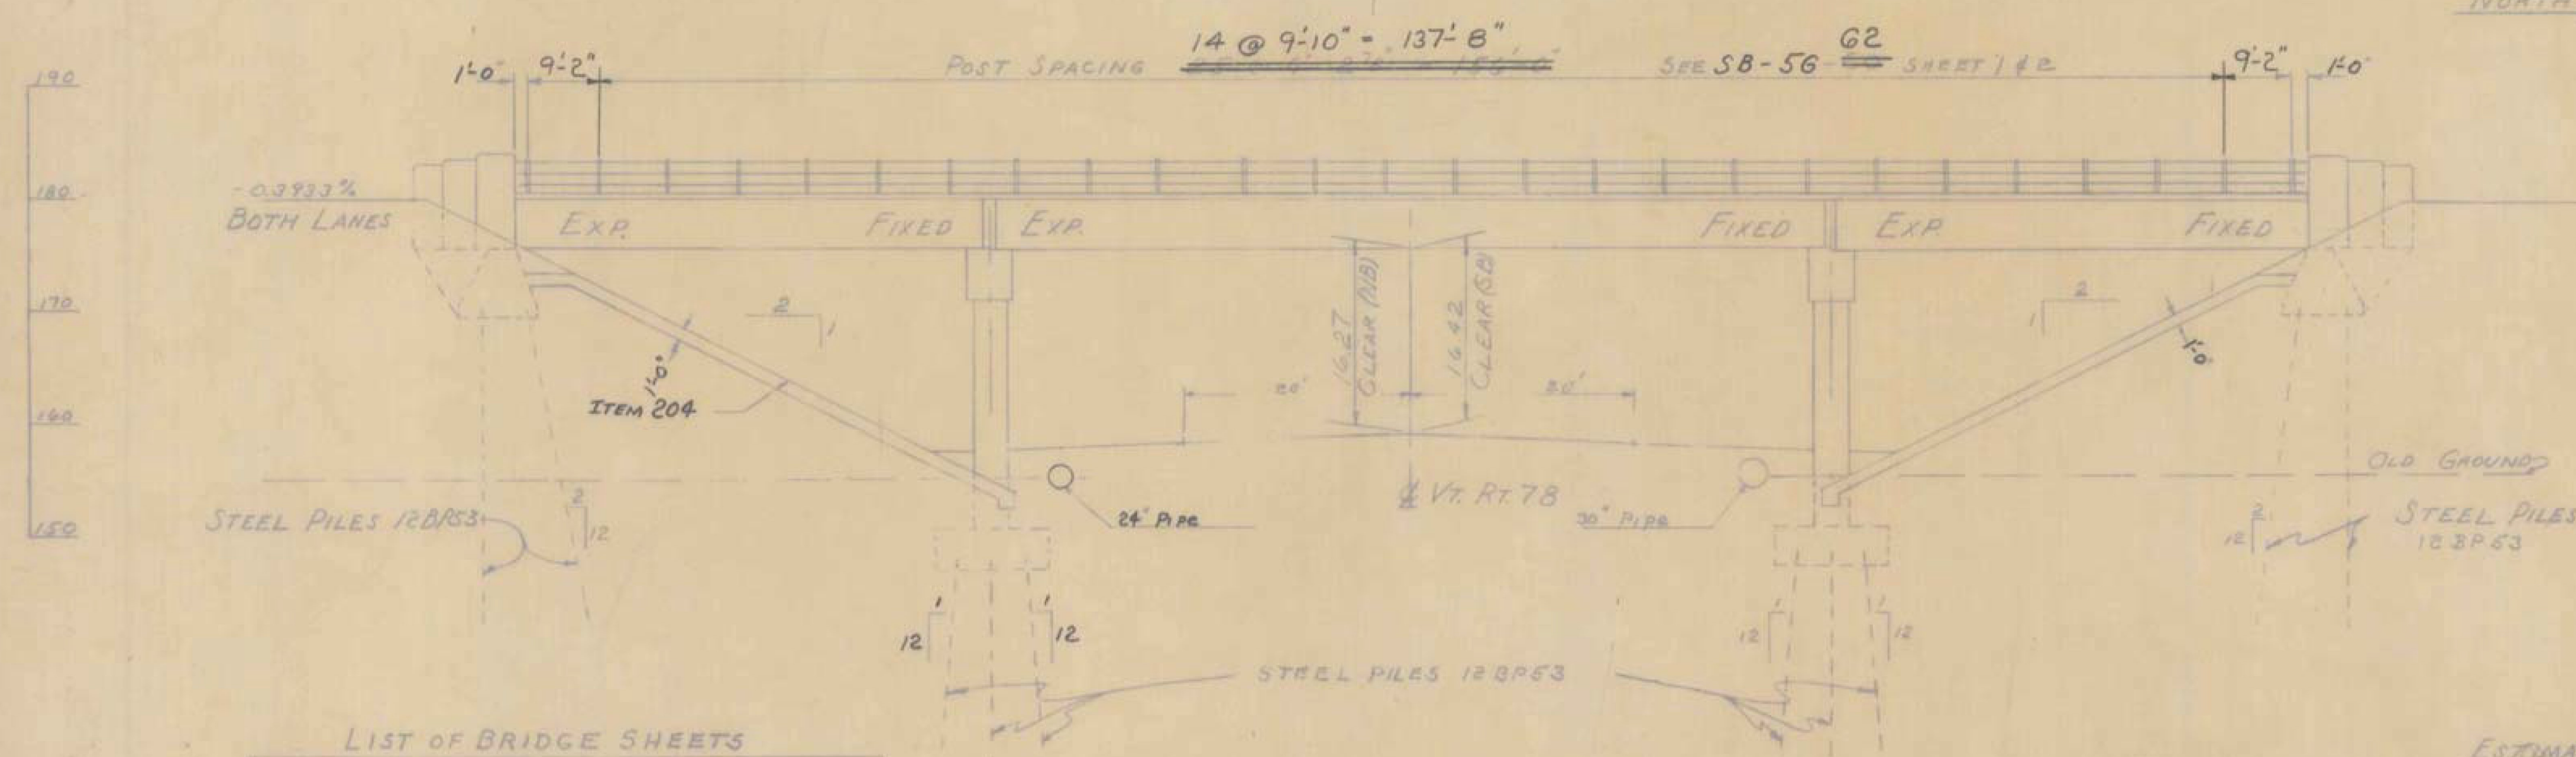

**LIST OF BRIDGE SHEETS**

SHEET NO.	TITLE
BR # 400	PRELIMINARY INFORMATION
BR # 401	PLAN & ELEVATION
BR # 402	BORINGS
BR # 403	DETAILS OF ABUTTS. (NORTH)
BR # 404	DETAILS OF PIER 1 & 2
BR # 405	REINFORCING STEEL SCHEDULE
BR # 406-407	SB-AS G2
	SCB-30-G2
	SCB-DI-G2 THRU SCB-D9-G2
	SB-56-G2 SHEET 1 & 2
	Std. E-2, Barricades, Signs & Lights (for Bridges)

**ELEVATION**  
**BR98N&S**

**SWANTON**  
**IM 089-3(70)**  
**SHEET 25 OF 31**  
**FOR REFERENCE**  
**ONLY**

**ESTIMATED SUPERSTRUCTURE QUANTITIES**

ITEM*	ITEM	UNIT	NET	FINAL #
* 361-B	BIT. CONC. PAVEMENT	TON	54	
401-AA	CONCRETE CLASS AA MOD.	C.Y.	<del>784</del>	183
402	REINFORCING STEEL @2040	LB.	SEE REINF. SCHEDULE	
403	SPIRAL REINFORCEMENT @2040	LB.	1	1
* 318	TAR EMULSION FOR BRIDGE FLOORS	GAL.	216	
404-A	STRUCTURAL STEEL	LB.	<del>156,220</del>	156,172
556-C	GRANITE BRIDGE CURB MOD.	L.F.	324	323
572	BRIDGE RAILING (GALVANIZED METAL)	L.F.	315	315
* 372-A	JOINT SEALER HOT BURIED	L.F.	60	
373	RUBBER JOINT MATERIAL	L.F.	122	122
<b>APPROACH SLAB QUANTITIES</b>				
* 361-B	BIT. CONC. PAVE.	TON	12	
401-B	CONCRETE CLASS B, MOD.	C.Y.	<del>57</del>	49
402	REINFORCING STEEL	LB.	SEE REINF. SCHEDULE	
556-C	GRANITE BRIDGE CURB MOD.	L.F.	32	32
* 318	TAR EMULSION FOR BRIDGE FLOORS	GAL.	54	
* Note:	These items to be included in roadway quantities			

**STATE OF VERMONT**  
DEPARTMENT OF HIGHWAYS

TOWN OF SWANTON - HIGHGATE

ROAD NO. I-89 BRIDGE NO. \_\_\_\_\_

INTERSTATE OVER ROUTE 78

PLAN & ELEVATION (N.B.)

SCALE 1" = 10'-0"

SURVEYED BY WHEELER & WHEELER A.J.C. (N.B.) J.J.C. (N.B.)

DRAWN BY A.J.C. CHECKED BY WHEELER

PROJECT NO. I-89-3 (3a)

SHEET 25 OF 246

BR401 of 407 Sheet 120 of 122