


BORING SCALE 1" = 10' VERTICAL

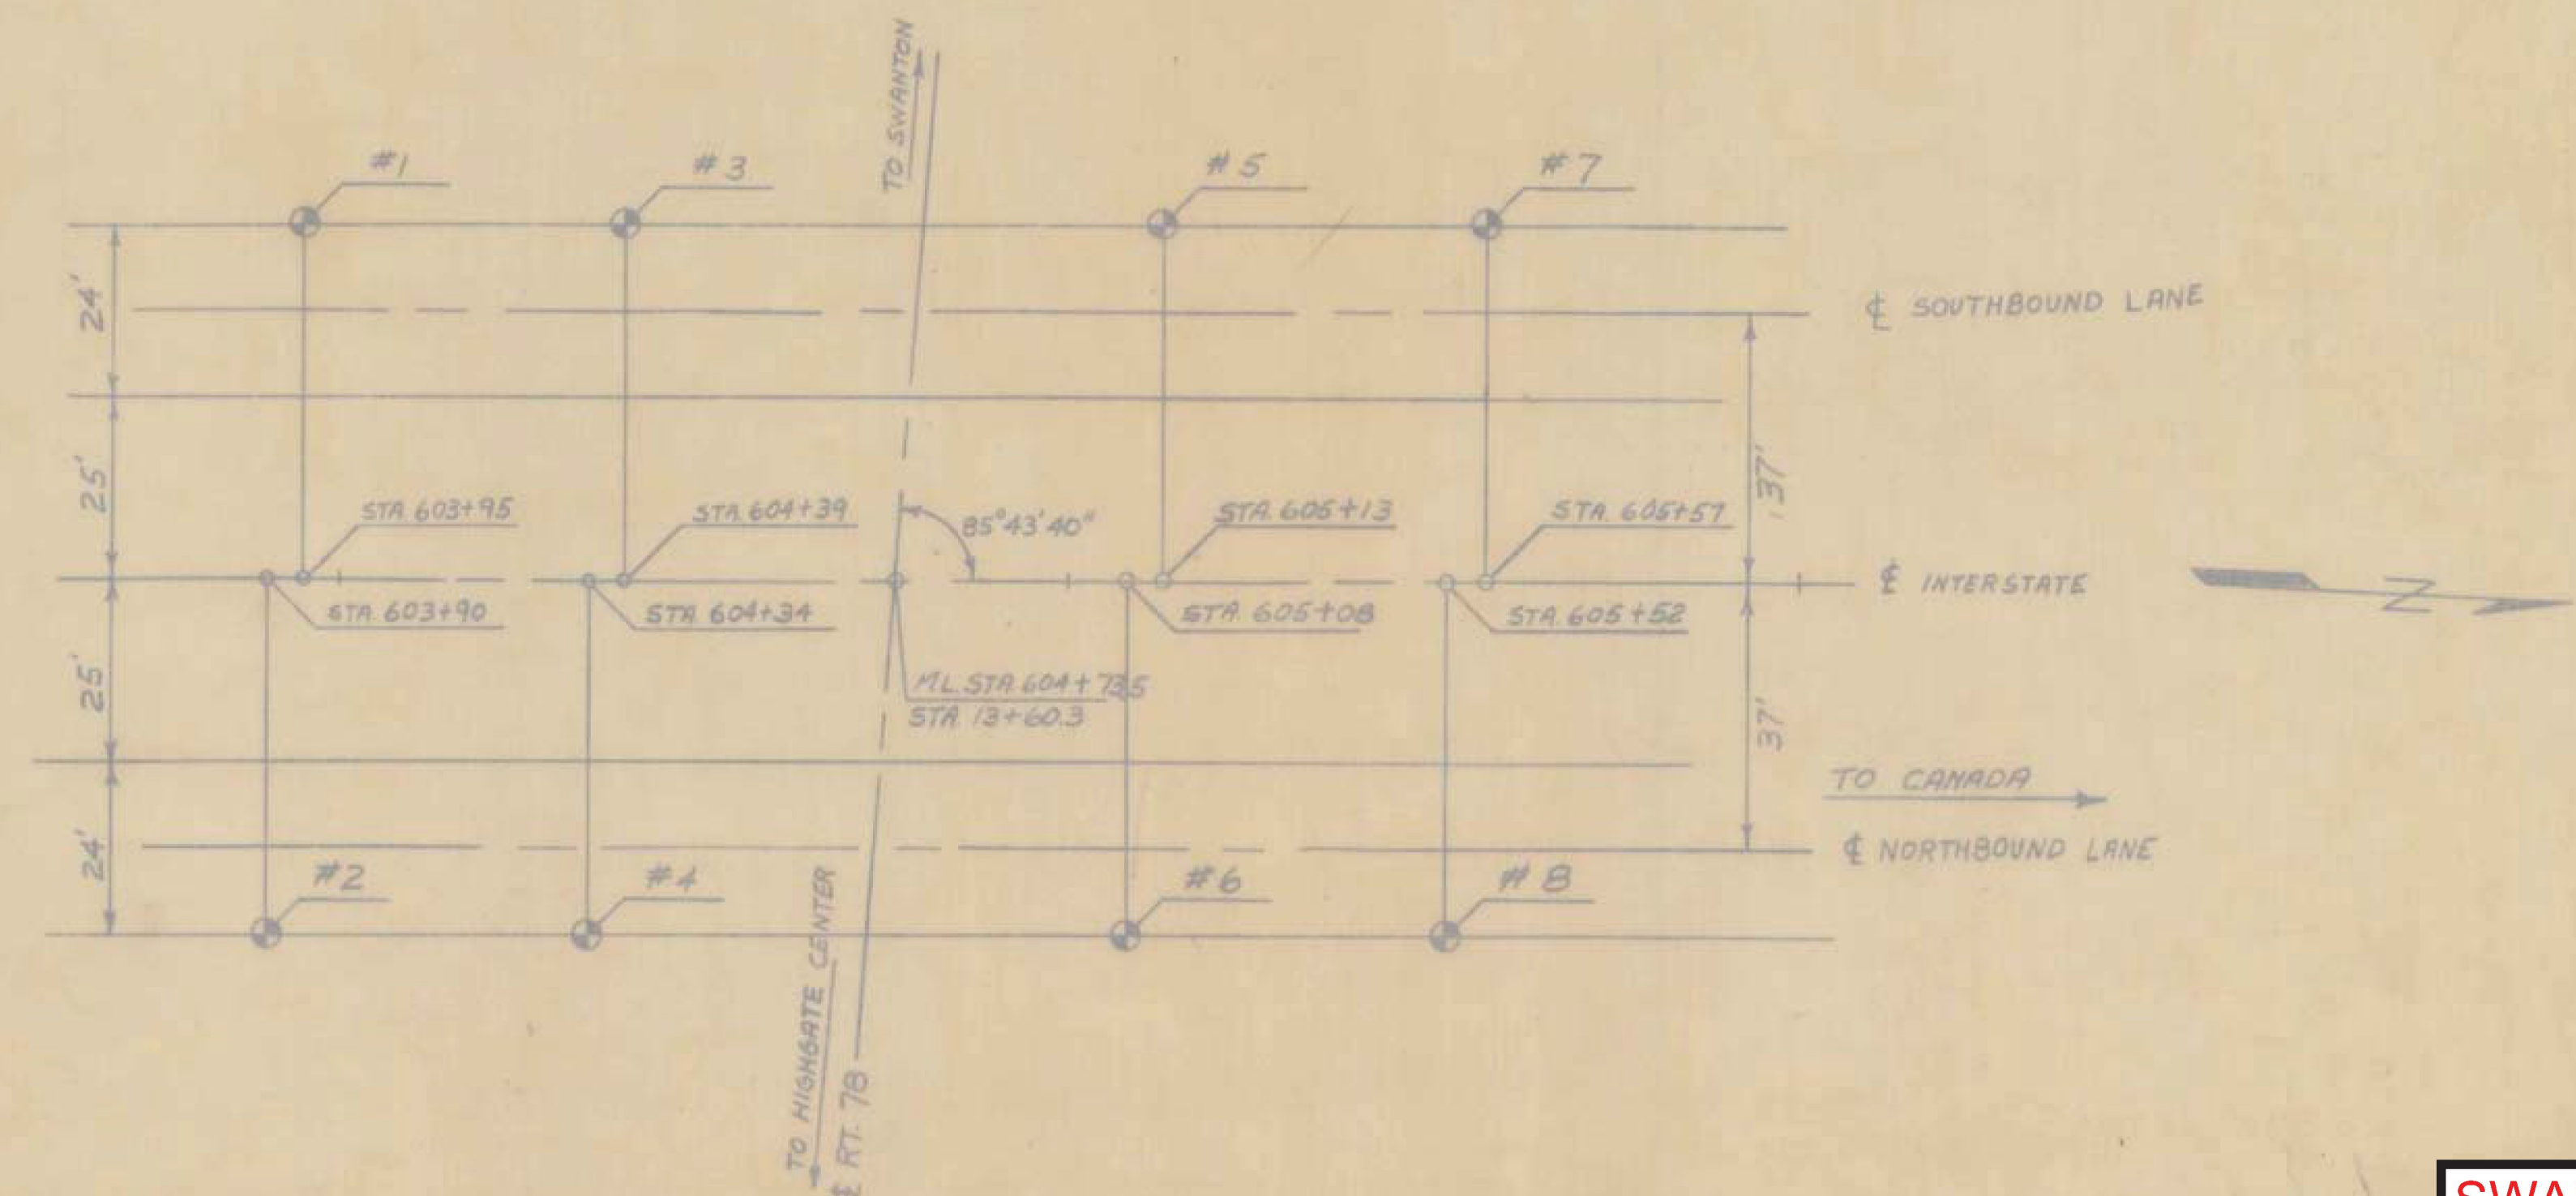

PLAN BORING LOCATIONS SCALE 1" = 20'

SWANTON  
 IM 089-3(70)  
 SHEET 26 OF 31  
 FOR REFERENCE  
 ONLY

STATE OF VERMONT  
 DEPARTMENT OF HIGHWAYS

TOWN OF SWANTON-HESBEGATE  
 ROUTE No. I-89 LOG STA  
 BORINGS  
 ML STA 604+735 - RT. 78 STA 605+52  
 SCALE AS NOTED  
 SURVEYED BY STANTON  
 DRAWN BY PPA  
 PROJECT No. I-89-3(32)  
 SHEET 125 OF 246