



# INDEX & PROJECT NOTES SHEET

**INDEX OF SHEETS**

**PLAN SHEETS**

- 1 TITLE SHEET
- 2 INDEX & PROJECT NOTES SHEET
- 3 & 4 QUANTITY SHEET 1 & 2
- 5 BITUMINOUS CONCRETE REMOVAL PLAN
- 6 SUPERSTRUCTURE DETAILS
- 7 JOINT DETAILS
- 8 RUMBLE STRIP DETAILS
- 9 BRIDGE 97 NORTH - PIERS NO. 3 & 4
- 10 BRIDGE 97 SOUTH - PIERS NO. 1 & 2
- 11 BRIDGE 98 NORTH - PIERS NO. 1 & 2
- 12 BRIDGE 98 SOUTH - PIERS NO. 3 & 4
- 13 SUBSTRUCTURE DETAILS

- 14 - 31 REFERENCE PLANS

**STANDARD LIST**

E-100	CONSTRUCTION APPROACH SIGNS	01/02/04
E-100A	SIDE ROAD CONSTRUCTION - APPROACH SIGNS	01/02/04
E-101	CONSTRUCTION SIGN DETAILS	05/30/03
E-102	CONSTRUCTION SIGN DETAILS	06/30/03
E-102A	CONSTRUCTION SIGN DETAILS	05/01/04
E-103	MAINLINE TRAFFIC CONTROL DIVIDED HIGHWAY ONE LANE CLOSED	03/01/04
E-106	TRAFFIC CONTROL- MISCELLANEOUS DETAILS	03/01/04
E-107	DELINEATION, BARRICADES AND DETOURS FOR CONSTRUCTION AREAS	06/30/03
E-107A	BREAKAWAY BARRICADE DETAILS	06/08/09
E-108A	CONSTRUCTION ZONE LONGITUDINAL DROP OFFS FOR PAVING	06/08/09
E-110	MAJOR MAINTENANCE OPERATION LANE CLOSURE	08/08/95
E-120	STANDARD SIGN PLACEMENT - EXPRESSWAY & FREEWAY	08/08/95
E-121	STANDARD SIGN PLACEMENT - CONVENTIONAL ROAD	08/08/95

**GENERAL**

- 1 ALL MATERIALS AND CONSTRUCTION SHALL CONFORM TO THE STATE OF VERMONT AGENCY OF TRANSPORTATION STANDARD SPECIFICATIONS FOR CONSTRUCTION DATED 2011, AND ITS LATEST REVISIONS, THE AASHTO LRFD BRIDGE DESIGN SPECIFICATIONS FIFTH EDITION, DATED 2010 AND ITS LATEST REVISIONS, AND THE AASHTO LRFD BRIDGE CONSTRUCTION SPECIFICATIONS THIRD EDITION, DATED 2010 AND ITS LATEST REVISIONS.
- 2 DIMENSIONS, ANGLES, BEARINGS, AND ELEVATIONS OF THE EXISTING BRIDGES SHOWN ON THESE PLANS HAVE BEEN OBTAINED FROM PLANS OF THE EXISTING STRUCTURES AND LIMITED FIELD INVESTIGATION. THE CONTRACTOR SHALL BE RESPONSIBLE FOR MAKING FIELD MEASUREMENTS OF ALL EXISTING STRUCTURE COMPONENTS TO ASSURE CONSISTENCY WITH THE PROPOSED MODIFICATIONS. ANY DISCREPANCIES IN DIMENSIONS, CHARACTER OR EXTENT OF THE EXISTING FEATURES SHALL BE BROUGHT TO THE ATTENTION OF THE RESIDENT ENGINEER, BEFORE ADVANCING THE WORK. ALL REFERENCE SHEETS WERE SCANNED IN, AND ARE NO LONGER TO SCALE.
- 3 UNLESS OTHERWISE PROVIDED, ALL REMOVED MATERIAL SHALL BECOME PROPERTY OF THE CONTRACTOR AND SHALL BE DISPOSED OF/RECYCLED AS AUTHORIZED BY THE ENGINEER.
- 4 THE PLANS AND PICTURES SHOW THE TYPE OF WORK REQUIRED BUT DO NOT NECESSARILY SHOW ALL WORK NEEDED.
- 5 BRIDGES 97 NORTH AND SOUTH PASS OVER RECREATION PATH AND BRIDGES 98 NORTH AND SOUTH PASS OVER VT-78, THESE FEATURES WILL NEED TO BE PROTECTED FROM CONSTRUCTION ACTIVITIES. THIS WORK WILL BE PAID FOR UNDER ITEM 900.645, "SPECIAL PROVISION (PUBLIC PROTECTION FOR BRIDGE PROJECTS)".
- 6 THE INTENTION OF THESE PLANS IS TO SHOW THE TYPE OF CONCRETE REPAIR WORK NEEDED. QUANTITIES FOR CONCRETE REPAIR HAVE BEEN ESTIMATED BASED ON SITE VISITS.

**PAVEMENT REMOVAL NOTES**

- 7 THE FINAL ONE HALF INCH OF PAVEMENT ON THE BRIDGE DECK AND APPROACH SLABS SHALL BE REMOVED BY LOADER, GRADER, OR EQUIPMENT APPROVED BY THE ENGINEER. USE OF COLD PLANER TO REMOVE BRIDGE AND APPROACH SLAB PAVEMENT SHALL BE INCIDENTAL TO ITEM 529.10 "REMOVAL OF BRIDGE PAVEMENT". THE REMOVAL OF EXISTING SHEET MEMBRANE SHALL BE INCIDENTAL TO ITEM 580.16 SURFACE PREPARATION FOR MEMBRANE.

8 DURING BRIDGE AND APPROACH SLAB PAVEMENT REMOVAL, THE CONTRACTOR SHALL EXERCISE CARE TO ENSURE THAT NO DAMAGE OCCURS TO THE EXISTING PORTLAND CEMENT CONCRETE DECK OR THE APPROACH SLABS. IF THE CONTRACTOR DAMAGES AREAS OF THE DECK OR APPROACH SLABS, THEN THE REQUIRED REPAIRS SHALL BE AS PER SECTION 580 OF THE SPECIFICATION AND WILL BE AT THE CONTRACTOR'S EXPENSE.

9 WHERE TRAFFIC IS TO BE MAINTAINED ON ONE LANE OF A BRIDGE WHILE THE OTHER LANE IS BEING REPAIRED, THE EXISTING PAVEMENT SHALL BE RETAINED TO ENSURE A SMOOTH RIDE AND LESS IMPACT DAMAGE TO THE REPAIRS MADE.

**DECK REPAIR NOTES**

10 AN ESTIMATED QUANTITY OF 3CY HAS BEEN INCLUDED FOR ITEM 580.12 "REPAIR OF CONCRETE SUPERSTRUCTURE SURFACE, CLASS III" FOR ANY AREAS THAT REQUIRE FULL DEPTH REPAIR. THIS SHALL INCLUDE ANY AREAS INDICATED BY POP OUTS ON THE SOFFIT, FASCIA, AND CURBS; OR ANY SECTION OF THE DECK THAT THE ENGINEER DETERMINES TO REQUIRE FULL DEPTH REPAIR AFTER CLASS II REMOVAL.

11 AFTER CLASS II AND CLASS III REMOVAL THE REINFORCING STEEL SHALL BE INSPECTED AND ANY REMAINING RUST SHALL BE CLEANED OFF OF THE BARS BEFORE ANY CONCRETE IS PLACED. ANY SECTIONS OF REINFORCING STEEL ORDERED REMOVED BE THE ENGINEER SHALL BE REMOVED AND REPLACED WITH #5 BARS, CUT TO FIT. AN ESTIMATED QUANTITY OF 1000 LBS OF ITEM 507.11 "REINFORCING STEEL, LEVEL 1" IS INCLUDED FOR THIS PURPOSE.

12 IF THERE IS INSUFFICIENT COMPETENT EXISTING STEEL FOR LAPPING WITH THE NEW STEEL, THE TWO BARS SHALL BE CONNECTED USING MECHANICAL BAR CONNECTORS UNDER ITEM 507.19 "MECHANICAL BAR CONNECTORS", AN ESTIMATED QUANTITY OF 50 MECHANICAL BAR CONNECTORS ARE INCLUDED FOR THIS PURPOSE, INCLUDING 3 CONNECTORS FOR TESTING UNDER SUBSECTION 713.02.

13 A QUANTITY OF 30 FEET OF DRILLING AND GROUTING DOWELS WAS ADDED IN THE EVENT THERE IS NOT ENOUGH REBAR TO LAP SPLICE OR TO USE MECHANICAL BAR CONNECTORS AT THE CURB LINES.

**WATER PROOFING NOTES**

14 FOLLOWING REMOVAL OF BRIDGE PAVEMENT, THE CONCRETE BRIDGE DECK SHALL BE CLEANED AND PREPARED IN ACCORDANCE WITH SUBSECTION 580.04 AND TO THE SATISFACTION OF THE ENGINEER. THIS WORK SHALL BE PAID FOR AS ITEM 580.16 "SURFACE PREPARATION FOR MEMBRANE".

15 ANY AREA OF THE BRIDGE THAT IS DAMAGED BY THE CONTRACTOR SHALL BE REPAIRED AT THE SOLE COST OF THE CONTRACTOR. ANY AREA OF CONCRETE BELOW THE MEMBRANE THAT IS FOUND TO BE UNSOUND SHALL BE IDENTIFIED BY THE CONTRACTOR AND BROUGHT TO THE ATTENTION OF THE ENGINEER. THE ENGINEER SHALL MAKE A DETERMINATION AS TO HOW TO REPAIR THE DETERIORATED PORTION OF THE DECK AND AS TO THE EXTENT OF REPAIRS.

16 UPON APPROVAL OF THE DECK CONDITION BY THE ENGINEER, SHEET MEMBRANE WATERPROOFING, TORCH APPLIED, SHALL BE INSTALLED IN ACCORDANCE WITH SECTION 519. IF THE DECK CANNOT BE WATERPROOFED AND PAVED IN ITS ENTIRETY, IN A CONTINUOUS OPERATION, OR IF TRAFFIC IS TO BE MAINTAINED ON ONE LANE WHILE THE OTHER LANE IS BEING REPAIRED, THE FOLLOWING SHALL APPLY:

- a. THE MEMBRANE SHALL EXTEND 1 +/- FOOT BEYOND THE LANE LINE OF THE REPAIRED LANE SO THAT THE MEMBRANE CAN BE LAPPED ONTO WHEN WATERPROOFING THE SECOND LANE OF WHEN CONSTRUCTION OPERATIONS HAVE RESUMED.
- b. PAVEMENT SHALL BE PLACED ON THE NEWLY INSTALLED MEMBRANE FOR THE ENTIRE LENGTH OF THE BRIDGE PRIOR TO ALLOWING TRAFFIC ONTO THIS LANE.
- c. THAT PART (1 +/-) OF THE MEMBRANE THAT EXTENDS BEYOND THE NECESSARY LANE WIDTH TO MAINTAIN TRAFFIC SHALL BE COVERED WITH RELEASE PAPER AND BITUMINOUS CONCRETE PAVEMENT. WHEN WATERPROOFING THE SECOND LANE, REMOVAL OF THE PAVEMENT ON THE RELEASE PAPER IN ORDER TO OVERLAP THE MEMBRANE SHALL BE INCLUDED IN THE UNIT PRICE BID FOR ITEM 900.680 "SPECIAL PROVISION (BITUMINOUS CONCRETE PAVEMENT, SMALL QUANTITY)".

17 WATER REPELLENT, SILANE, SHALL BE APPLIED TO ALL EXPOSED CONCRETE, EXCEPT FOR THE UNDERSIDE OF THE DECK BETWEEN THE DRIP NOTCHES. THIS WORK SHALL BE PAID FOR AS ITEM 514.10 "WATER REPELLENT, SILANE".

**AIR HAMMER REMOVAL NOTES**

18 THE ANGLE BETWEEN THE DECK AND AIR HAMMER AXIS SHALL BE FROM ZERO (0) DEGREES TO FORTY-FIVE (45) DEGREES. AIR HAMMERS USED FOR THE REMOVAL OF UNSOUND AND DETERIORATED CONCRETE SHALL HAVE A MAXIMUM RATING OF THIRTY (30) POUNDS AND SHALL USE CHISEL POINTS ONLY. IF REINFORCING STEEL IS DAMAGED, OR IF CONCRETE IS DEBONDED, DELAMINATED, OR OTHERWISE DAMAGED BEYOND THE DEFINED LIMITS OF REMOVAL BECAUSE OF THE IMPROPER USE OF THE AIR HAMMER, THEN THE CONTACTOR SHALL REPAIR THE DAMAGED AREAS BY REMOVING AND REPLACING THE CONCRETE AND/OR REINFORCING STEEL AT THEIR OWN EXPENSE.

**PAVEMENT NOTES**

19 FOLLOWING INSTALLATION OF SHEET MEMBRANE WATERPROOFING ON THE BRIDGE DECKS; THE BRIDGE DECKS AND AT-GRADE APPROACH SLABS SHALL BE PAVED CURB TO CURB WITH ITEM 900.680 "SPECIAL PROVISION (BITUMINOUS CONCRETE PAVEMENT, SMALL QUANTITY)".

20 CARE SHALL BE EXERCISED TO SMOOTHLY TRANSITION THE NEW APPROACH SLAB PAVEMENT INTO THE EXISTING PAVEMENT (50' MINIMUM, SEE SHEET 6). ANY COLD PLANING NECESSARY FOR SHAPING BRIDGE APPROACHES ALONG THE EXISTING MAIN LINE SHALL BE PAID FOR UNDER ITEM 210.10 "COLD PLANING, BITUMINOUS PAVEMENT". ANY COLD PLANING ALONG SIDE ROADS SHALL BE DONE AT THE RESIDENT ENGINEER'S DISCRETION.

21 LONGITUDINAL JOINTS IN THE PAVEMENT SHALL BE TAPERED IN ACCORDANCE WITH SECTION 490.

22 EMULSIFIED ASPHALT SHALL BE APPLIED TO TACK CONTACT SURFACES AT A RATE OF 0.025 GAL/SY.

23 TESTING FOR PAVEMENT DENSITY WILL REQUIRE CORES OF THE PAVEMENT ON THE BRIDGE DECK, POSSIBLY RESULTING IN DAMAGE TO THE MEMBRANE. THE CONTRACTOR SHALL BE RESPONSIBLE FOR REPAIR OF ANY DAMAGED MEMBRANE IN ACCORDANCE WITH THE MANUFACTURERS SPECIFICATIONS. THE COST FOR THIS WORK SHALL BE INCIDENTAL TO ITEM 900.680 "SPECIAL PROVISION (BITUMINOUS CONCRETE PAVEMENT, SMALL QUANTITY)".

**CONCRETE NOTES**

24 DUPLICATE PAYMENT WILL NOT BE MADE FOR REPAIR OF CONCRETE SURFACES IN ANY AREA. NO PAYMENT FOR ITEM 580.11 "REPAIR OF CONCRETE SUPERSTRUCTURE SURFACE, CLASS II" SHALL BE MADE WITHIN AREAS OF CLASS III REPAIR. FOR EXAMPLE, IF AN AREA IS ORIGINALLY TO BE REPAIRED AS CLASS II, AND THE ENGINEER ORDERS A CHANGE TO CLASS III DEPTH, THE AREA IN QUESTION WILL BE PAID AS CLASS III.

25 ALL EDGES OF REPAIR AREAS ARE TO BE SAWCUT SQUARE AND TO A MINIMUM DEPTH OF 1". EXCEPT AT THE CURB LINES WHERE THE EDGE WILL BE CHIPPED.

**ENVIRONMENTAL**

26 EROSION CONTROL MEASURES SHALL BE UTILIZED AS REQUIRED AND SHALL BE PER SECTION 105 OF THE STANDARD SPECIFICATIONS FOR CONSTRUCTION AND THE AGENCY OF NATURAL RESOURCES LOW-RISK HANDBOOK FOR CONSTRUCTION SITES. SEE SUBSECTION 105.23 FOR EROSION CONTROL PLAN REQUIREMENTS. PAYMENT FOR THIS WORK WILL BE CONSIDERED INCIDENTAL TO ALL OTHER CONTRACT ITEMS.

**TRAFFIC CONTROL**

1 A MINIMUM OF ONE WAY TRAFFIC SHALL BE MAINTAINED ON I-89 THROUGH OUT ALL PHASES OF THIS PROJECT. WORK IS TO BE PERFORMED IN ACCORDANCE WITH MUTCD(2011), AND THE APPROPRIATE VTRANS STANDARD DRAWINGS.

2 ALL SIGNS, BARRICADES, AND OTHER TRAFFIC CONTROL DEVICES SHALL BE CLEANED WEEKLY OR AS DIRECTED BY THE RESIDENT ENGINEER. EXISTING PERMANENT SIGNS THAT CONTRADICT TEMPORARY TRAFFIC CONTROL SIGNS SHALL BE REMOVED AND REPLACED OR COVERED FOR THE PERIOD OF TIME THAT THE TRAFFIC CONTROL PLAN IS IMPLEMENTED. COST FOR THIS WORK SHALL BE CONSIDERED INCIDENTAL TO ITEM 900.645 SPECIAL PROVISION (TRAFFIC CONTROL, ALL-INCLUSIVE)

3 THE COST FOR ALL ITEMS REQUIRED TO IMPLEMENT THE CONTRACTOR'S TRAFFIC CONTROL PLAN; INCLUDING BUT NOT LIMITED TO TEMPORARY TRAFFIC BARRIER, TEMPORARY PAVEMENT MARKINGS, AND CONSTRUCTION SIGNS, WILL BE INCLUDED UNDER CONTRACT ITEM 900.645, "SPECIAL PROVISION (TRAFFIC CONTROL, ALL-INCLUSIVE)".

4 THE CONTRACTOR SHALL BE RESPONSIBLE FOR THE DESIGN AND INSTALLATION OF A SITE SPECIFIC TRAFFIC CONTROL PLAN. THE CONTRACTOR SHALL BE RESPONSIBLE FOR SUPPLYING THE LOCAL TRAFFIC CONTROL PACKAGE IDENTIFYING THE PROJECT BEFORE, DURING AND AFTER THE CONSTRUCTION PERIOD. THE CONTRACTOR SHALL SUBMIT FOR APPROVAL A DETAILED TRAFFIC CONTROL PLAN TO THE ENGINEER FOR ALL STAGES OF CONSTRUCTION. NO WORK SHALL BEGIN UNTIL THE TRAFFIC CONTROL PLAN HAS BEEN APPROVED. SEE SPECIAL PROVISIONS FOR ADDITIONAL INFORMATION AND REQUIREMENTS. ALL COST SHALL BE INCLUDED IN ITEM 900.645 "SPECIAL PROVISION (TRAFFIC CONTROL, ALL-INCLUSIVE)".

5 THE CONTRACTOR SHALL ADD SIGN G20-5AP TO THE TOP OF ALL TEMPORARY SPEED LIMIT SIGNS AS DETAILED IN THE MUTCD.

6 A MINIMUM OF TWO WAY TRAFFIC SHALL BE MAINTAINED ON VT 78 THROUGH OUT ALL PHASES OF THIS PROJECT. WORK IS TO BE PERFORMED IN ACCORDANCE WITH MUTCD(2011), AND THE APPROPRIATE VTRANS STANDARD DRAWINGS.

PROJECT NAME: SWANTON  
PROJECT NUMBER: IM 089-3(70)

FILE NAME: sl2a276pi.dgn  
PROJECT LEADER: C. CARLSON  
DESIGNED BY: H. SALLS  
INDEX & PROJECT NOTES SHEET

PLOT DATE: 26-MAR-2013  
DRAWN BY: R. PELLETT  
CHECKED BY: H. SALLS  
SHEET 2 OF 31

AS BUILT "REBAR" DETAIL		
LEVEL I	LEVEL II	LEVEL III
TYPE:	TYPE:	TYPE:
GRADE:	GRADE:	GRADE:

# QUANTITY SHEET 1

SUMMARY OF ESTIMATED QUANTITIES										TOTALS		DESCRIPTIONS				DETAILED SUMMARY OF QUANTITIES			
					ROADWAY	BRIDGE 97N	BRIDGE 97S	BRIDGE 98N	BRIDGE 98S	FULL C.E. ITEMS	GRAND TOTAL	FINAL	UNIT	ITEMS	ITEM NUMBER	ROUND	QUANTITIES	UNIT	ITEMS
						1					1		CY	TRENCH EXCAVATION OF EARTH, EXPLORATORY (N.A.B.I.)	204.22				
						468	654	468			1590		SY	COLD PLANING, BITUMINOUS PAVEMENT	210.10				
						200	200	200			600		LF	MILLED RUMBLE STRIPS	213.10				
						12	17	12			41		CWT	EMULSIFIED ASPHALT	404.65				
					1						1		LU	PRICE ADJUSTMENT, ASPHALT CEMENT (N.A.B.I.)	406.50				
						250	250	500			1000		LB	REINFORCING STEEL, LEVEL I	507.11				
						10	10	10			30		LF	DRILLING AND GROUTING DOWELS	507.16				
						10	10	30			50		EACH	MECHANICAL BAR CONNECTOR	507.19				
						50	50	50	50		200		GAL	WATER REPELLENT, SILANE	514.10				
						120	168	120			408		LF	BRIDGE EXPANSION JOINT, ASPHALTIC PLUG	516.10				
						510	710	540			1760		SY	SHEET MEMBRANE WATERPROOFING, TORCH APPLIED	519.20				
														BEGIN OPTION AA					
						60	84	60			204		LF	JOINT SEALER, HOT POURED	524.11				
						60	84	60			204		LF	JOINT SEALER, COLD POURED	524.13				
														END OPTION AA					
						510	710	540			1760		SY	REMOVAL OF BRIDGE PAVEMENT	529.10				
						51	71	54			176		SY	REPAIR OF CONCRETE SUPERSTRUCTURE SURFACE, CLASS I	580.10				
						152	213	162			527		SY	REPAIR OF CONCRETE SUPERSTRUCTURE SURFACE, CLASS II	580.11				
						3	3	3			9		CY	REPAIR OF CONCRETE SUPERSTRUCTURE SURFACE, CLASS III	580.12				
						15	20	14	14		63		SY	REPAIR OF CONCRETE SUBSTRUCTURE SURFACE, CLASS I	580.13				
						5	7	5	5		22		SY	REPAIR OF CONCRETE SUBSTRUCTURE SURFACE, CLASS II	580.14				
						510	710	540			1760		SF	SURFACE PREPARATION FOR MEMBRANE	580.16				
						2	2	2	2		8		GAL	REPOINTING GRANITE BRIDGE CURB	616.225				
						250	250	250	250		1000		HR	UNIFORMED TRAFFIC OFFICERS	630.10				
						100	100	400	400		1000		HR	FLAGGERS	630.15				
										1	1		LS	FIELD OFFICE, ENGINEERS	631.10				
										1	1		LS	TESTING EQUIPMENT, CONCRETE	631.16				
										1	1		LS	TESTING EQUIPMENT, BITUMINOUS	631.17				
										3000	3000		DL	FIELD OFFICE TELEPHONE (N.A.B.I.)	631.26				
					1						1		LS	MOBILIZATION/DEMOBILIZATION	635.11				
						588	588	603			1779		LF	6 INCH WHITE LINE	646.214				
						292	292	302			886		LF	6 INCH YELLOW LINE	646.215				
								126	126		252		LF	SPECIAL PROVISION (FIBER REINFORCED POLYMER (FRP), SAFSTRIP)	900.640				
						1					1		LS	SPECIAL PROVISION (PUBLIC PROTECTION FOR BRIDGE PROJECTS)(I-89 BRIDGE NO. 97N)	900.645				
							1				1		LS	SPECIAL PROVISION (PUBLIC PROTECTION FOR BRIDGE PROJECTS)(I-89 BRIDGE NO. 97S)	900.645				
								1			1		LS	SPECIAL PROVISION (PUBLIC PROTECTION FOR BRIDGE PROJECTS)(I-89 BRIDGE NO. 98N)	900.645				
									1		1		LS	SPECIAL PROVISION (PUBLIC PROTECTION FOR BRIDGE PROJECTS)(I-89 BRIDGE NO. 98S)	900.645				
									1		1		LS	SPECIAL PROVISION (TRAFFIC CONTROL ALL-INCLUSIVE TRAFFIC)(I-89 BRIDGE NO. 98S)	900.645				

PROJECT NAME: SWANTON  
PROJECT NUMBER: IM 089-3(70)


FILE NAME: sl2a276qs.dgn  
PROJECT LEADER: C. CARLSON  
DESIGNED BY: H. SALLS  
QUANTITY SHEET 1

PLOT DATE: 11-APR-2013  
DRAWN BY: R. PELLETT  
CHECKED BY: H. SALLS  
SHEET 3 OF 31

# QUANTITY SHEET 2

SUMMARY OF ESTIMATED QUANTITIES										TOTALS		DESCRIPTIONS				DETAILED SUMMARY OF QUANTITIES			
					ROADWAY	BRIDGE 97N	BRIDGE 97S	BRIDGE 98N	BRIDGE 98S	FULL C.E. ITEMS	GRAND TOTAL	FINAL	UNIT	ITEMS	ITEM NUMBER	ROUND	QUANTITIES	UNIT	ITEMS
						1					1		LS	SPECIAL PROVISION (TRAFFIC CONTROL ALL-INCLUSIVE)(I-89 BRIDGE NO. 97N)	900.645				
							1				1		LS	SPECIAL PROVISION (TRAFFIC CONTROL ALL-INCLUSIVE)(I-89 BRIDGE NO. 97S)	900.645				
								1			1		LS	SPECIAL PROVISION (TRAFFIC CONTROL ALL-INCLUSIVE)(I-89 BRIDGE NO. 98N)	900.645				
					1	1	1				3		LU	SPECIAL PROVISION (MAT DENSITY PAY ADJUSTMENT, SMALL QUANTITY)(N.A.B.I.)	900.650				
					1	1	1				3		LU	SPECIAL PROVISION (MIXTURE PAY ADJUSTMENT)(N.A.B.I.)	900.650				
					83	116	85				284		TON	SPECIAL PROVISION (BITUMINOUS CONCRETE PAVEMENT, SMALL QUANTITY)	900.680				


PROJECT NAME: SWANTON  
 PROJECT NUMBER: IM 089-3(70)  
 FILE NAME: sl2a276qs.dgn  
 PROJECT LEADER: C. CARLSON  
 DESIGNED BY: H. SALLS  
 QUANTITY SHEET 2  
 PLOT DATE: 11-APR-2013  
 DRAWN BY: R. PELLETT  
 CHECKED BY: H. SALLS  
 SHEET 4 OF 31

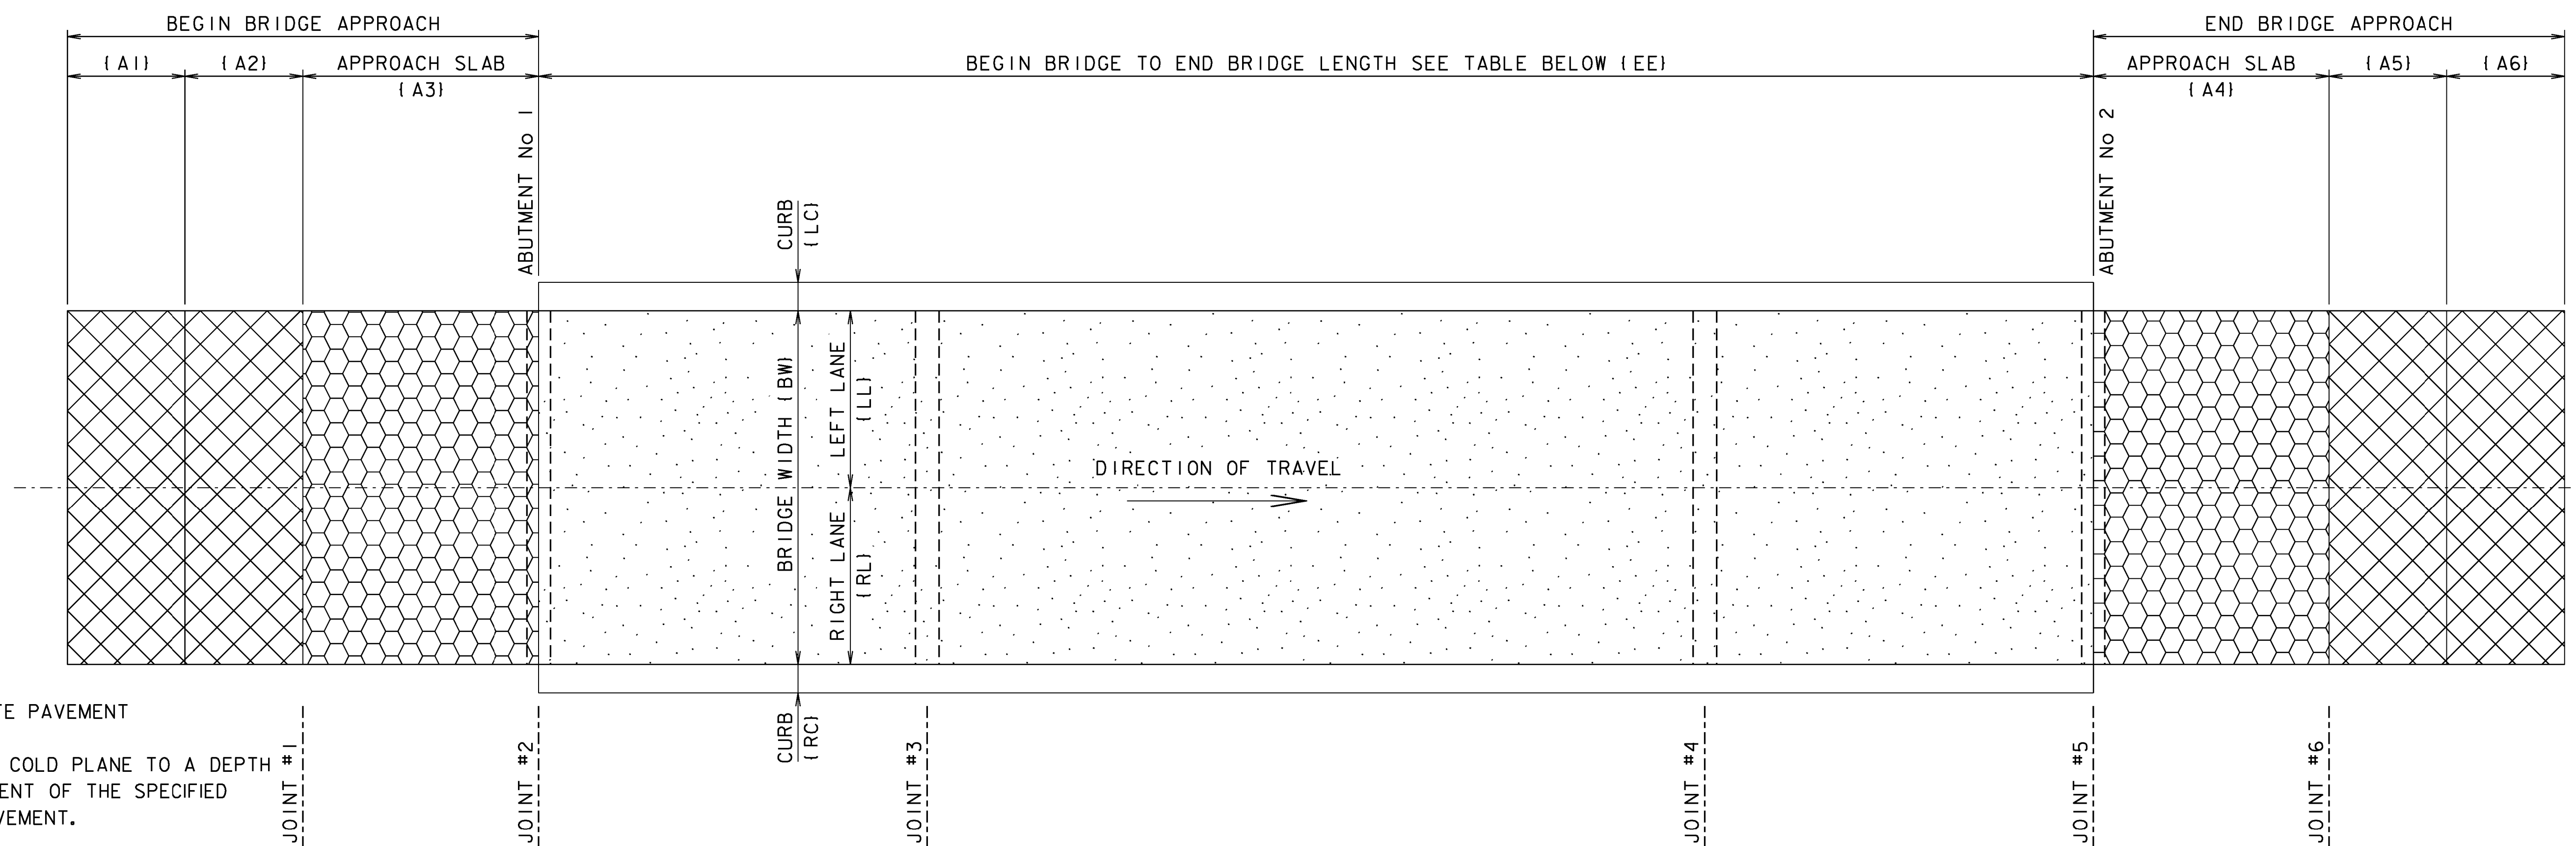

NOTES:

BCP - BITUMINOUS CONCRETE PAVEMENT

THE INTENTION IS TO ONLY COLD PLANE TO A DEPTH THAT ALLOWS FOR PLACEMENT OF THE SPECIFIED LIFT OR LIFTS OF NEW PAVEMENT.

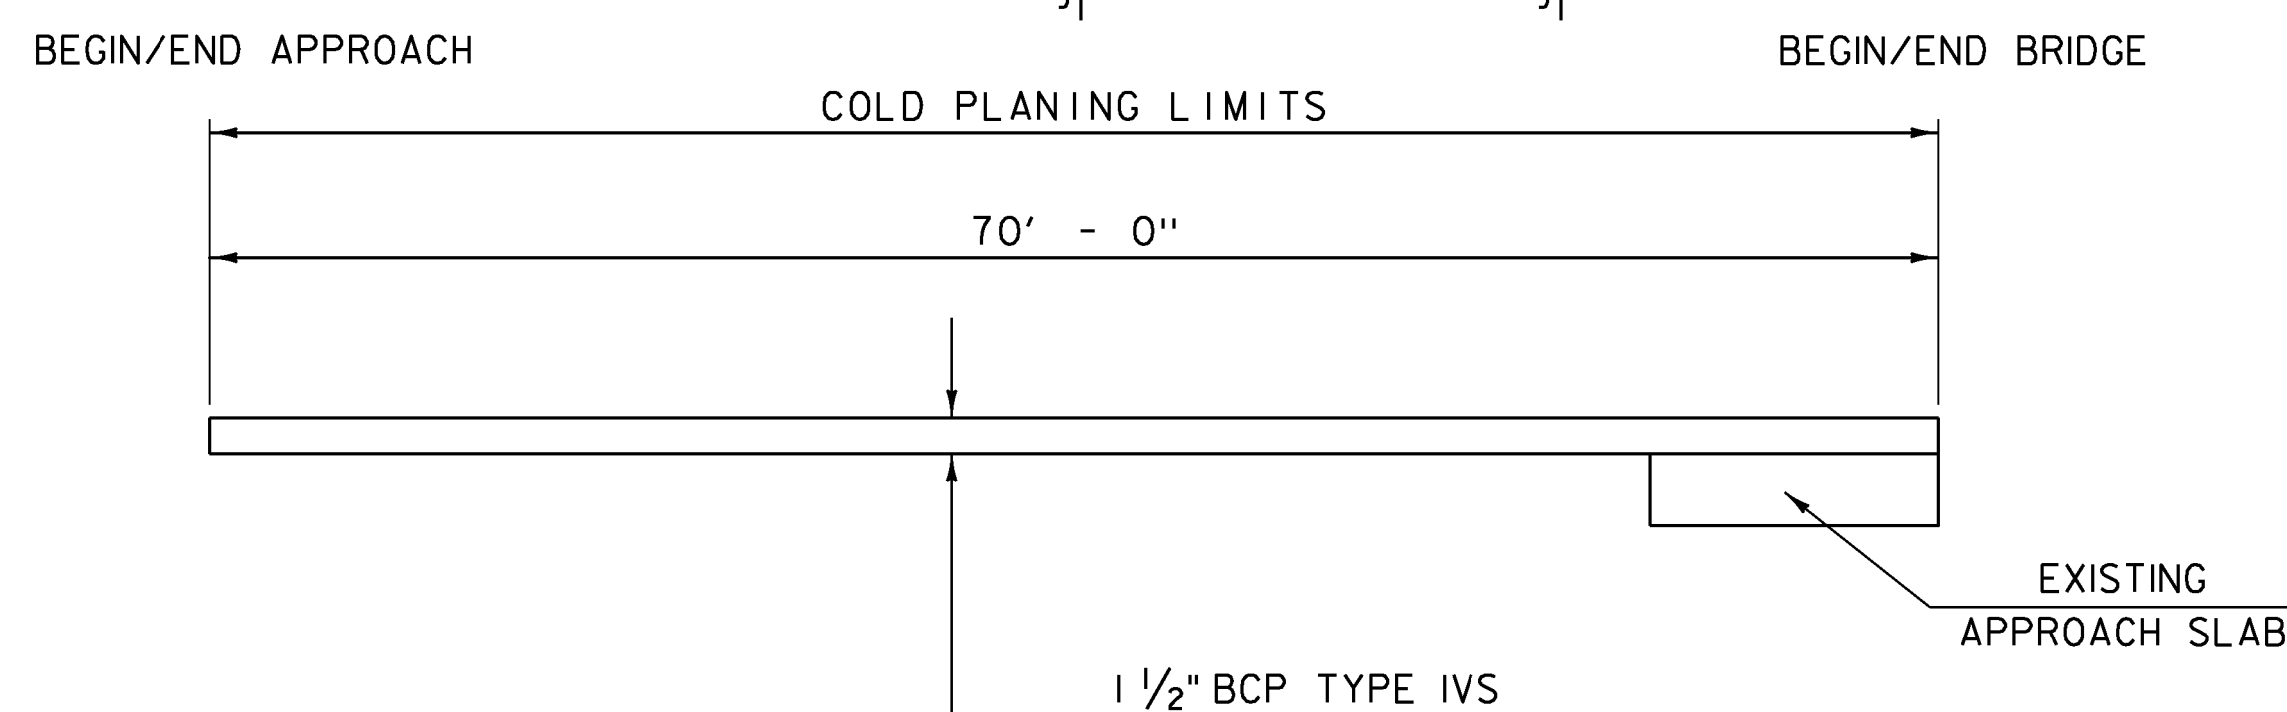

MATERIAL TRANSITION DETAIL

BRIDGE TYPICAL BITUMINOUS CONCRETE REMOVAL & REPLACEMENT PLAN

BRIDGE No. 97 SOUTH & BRIDGE No. 97 NORTH & BRIDGE No. 98 NORTH

1. COLD PLANING WILL BE PAID FOR UNDER ITEM 210.10 EXCEPT AS OTHERWISE SPECIFIED.
  2. REMOVAL OF THE BITUMINOUS CONCRETE PAVEMENT AND MEMBRANE WILL BE PAID FOR UNDER ITEM 529.10.
  3. PREPARATION OF SURFACE FOR PLACEMENT OF MEMBRANE WILL BE PAID FOR UNDER ITEM 580.16.
  4. NEW MEMBRANE SHALL BE PLACED ON THE PREPARED BRIDGE DECK. PAYMENT WILL BE MADE UNDER ITEM 519.20.
  5. NEW PAVEMENT WILL BE PAID FOR UNDER ITEM 900.680 SPECIAL PROVISION (BITUMINOUS CONCRETE PAVEMENT, SMALL QUANTITY).
- WO #6 ADDED ITEM 406.27, MEDIUM DUTY BITUMINOUS CONCRETE PAVEMENT

- COLD PLANE - 1 1/2"
- COLD PLANE - 1 1/2" TO EXPOSE APPROACH SLAB
- REMOVE BITUMINOUS CONCRETE PAVEMENT TO TOP OF BRIDGE DECK. REMOVE EXISTING BARRIER MEMBRANE.

BRIDGE LAYOUT DIMENSION AND GEOMETRY TABLE

BRIDGE No.	LENGTH (FT)	WIDTH (FT)					BEGIN BRIDGE APPROACH			END BRIDGE APPROACH			EXPANSION JOINT (NEW PLUG JOINT)					EXPANSION JOINT (HOT POURED JOINT)				
		EE	BW	RL	LL	RC	LC	A1	A2	A3	A4	A5	A6	#2	#3	#4	#5	TOTAL EXP	LENGTH (FT)	#1	#6	TOTAL EXP
97 N	152.00	30.00	15.00	15.00	2.42	2.42	25.00	25.00	20.00	20.00	25.00	25.00	PLUG	PLUG	PLUG	PLUG	4	120.0	SAW	SAW	2	60.0
97 S	152.00	42.00	27.00	15.00	2.42	2.42	25.00	25.00	20.00	20.00	25.00	25.00	PLUG	PLUG	PLUG	PLUG	4	168.0	SAW	SAW	2	84.0
98 N	162.00	30.00	15.00	15.00	2.42	2.42	25.00	25.00	20.00	20.00	25.00	25.00	PLUG	PLUG	PLUG	PLUG	4	120.0	SAW	SAW	2	60.0


PROJECT NAME: SWANTON  
PROJECT NUMBER: IM 089-3(70)

FILE NAME: sl2a276sup.dgn  
PROJECT LEADER: C. CARLSON  
DESIGNED BY: H. SALLS  
BITUMINOUS CONCRETE REMOVAL PLAN

PLOT DATE: 19-MAR-2013  
DRAWN BY: M. LONGSTREET  
CHECKED BY: H. SALLS  
SHEET 5 OF 31


DRAWING NOT TO SCALE UNLESS NOTED OTHERWISE

CLEAN AND REPOINT THE GRANITE CURBS; THIS WORK WILL BE PAID FOR UNDER ITEM 616.225 REPOINTING GRANITE BRIDGE CURB (TYP)

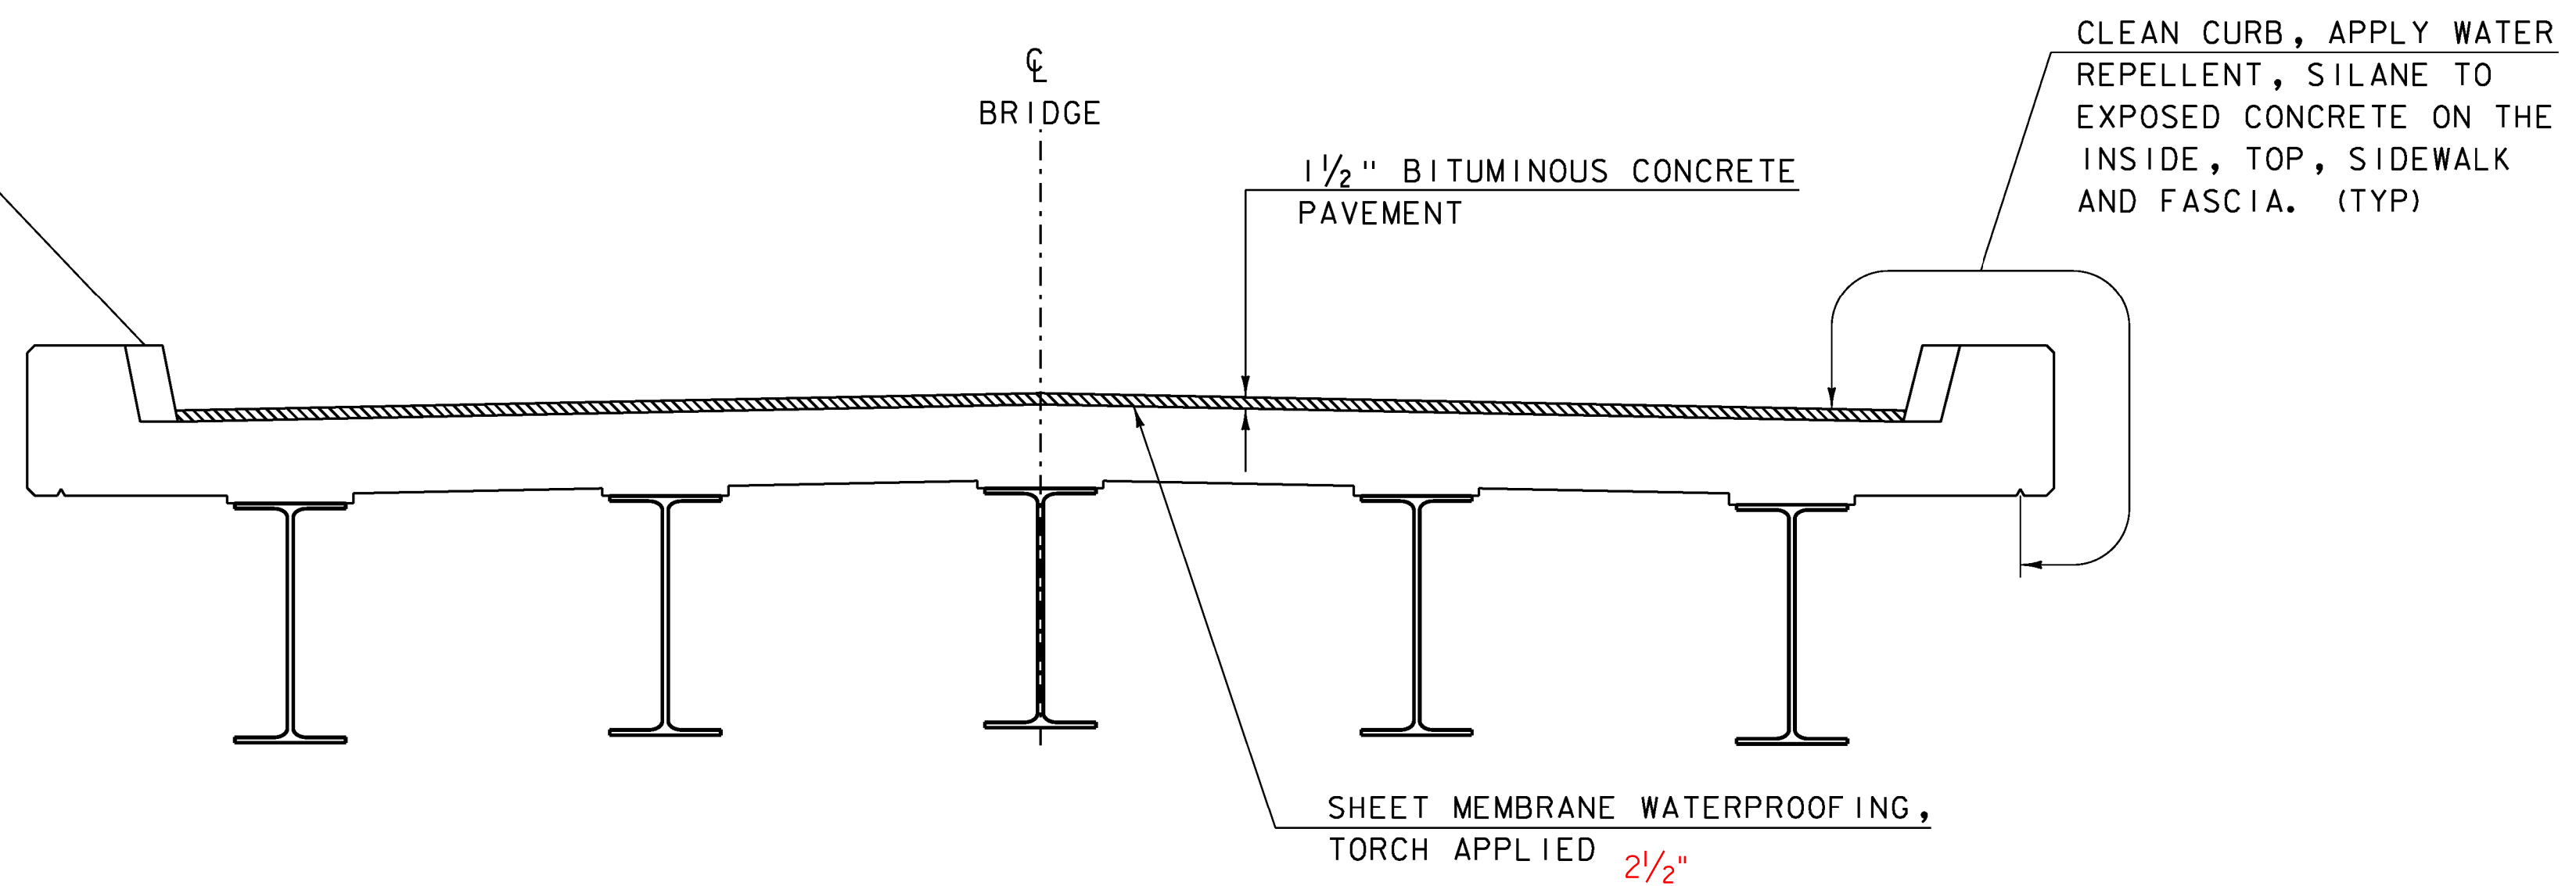


TYPICAL BRIDGE SECTION

NOTE: EXISTING BRIDGE GEOMETRY VARIES BY LOCATION  
TYPICAL SECTION SHOWN FOR SCHEMATIC PURPOSES ONLY.

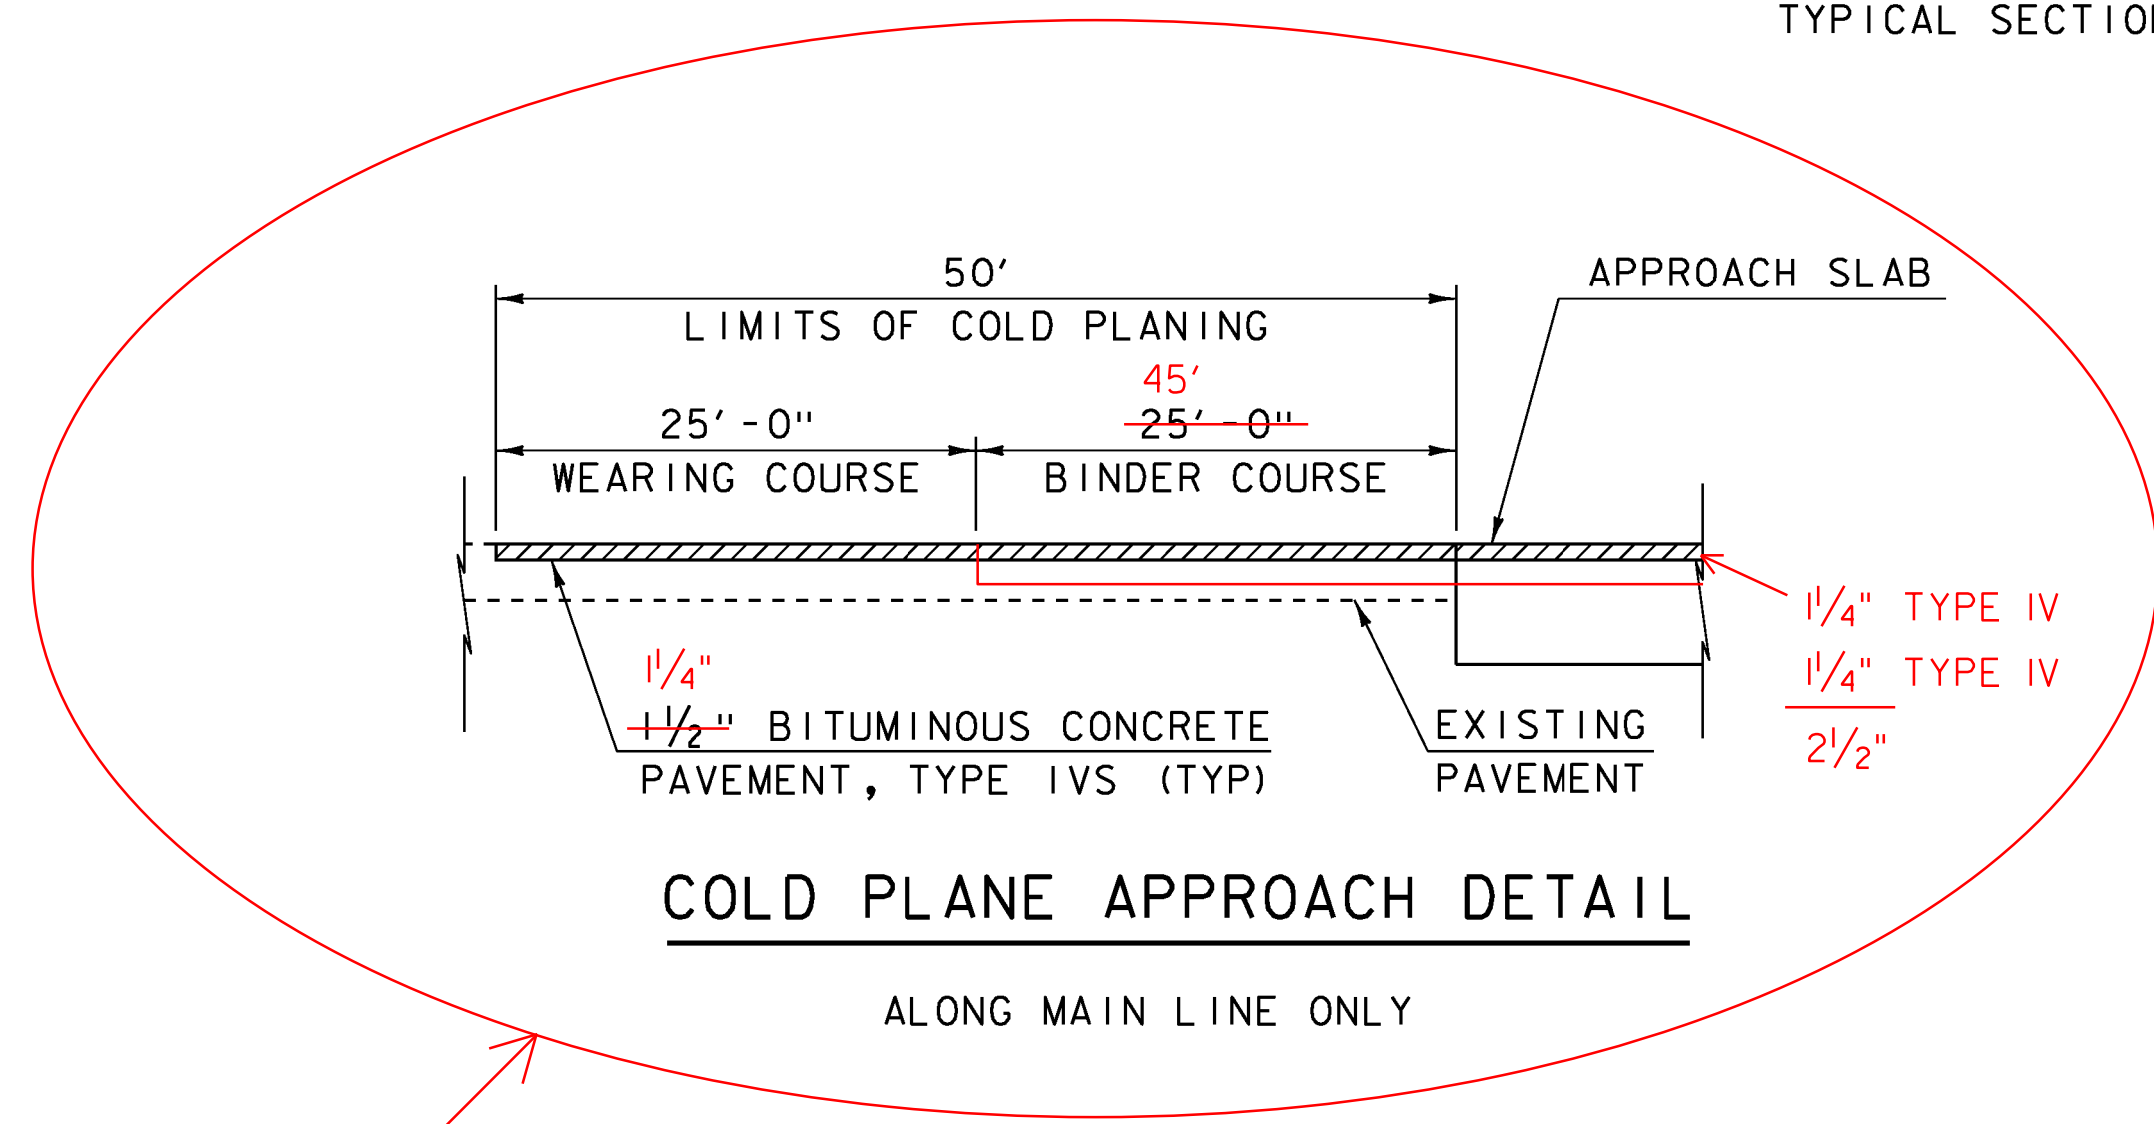

SEE NEW TYPICAL DETAILED IN WRITTEN ORDER #6. (8-23-13)

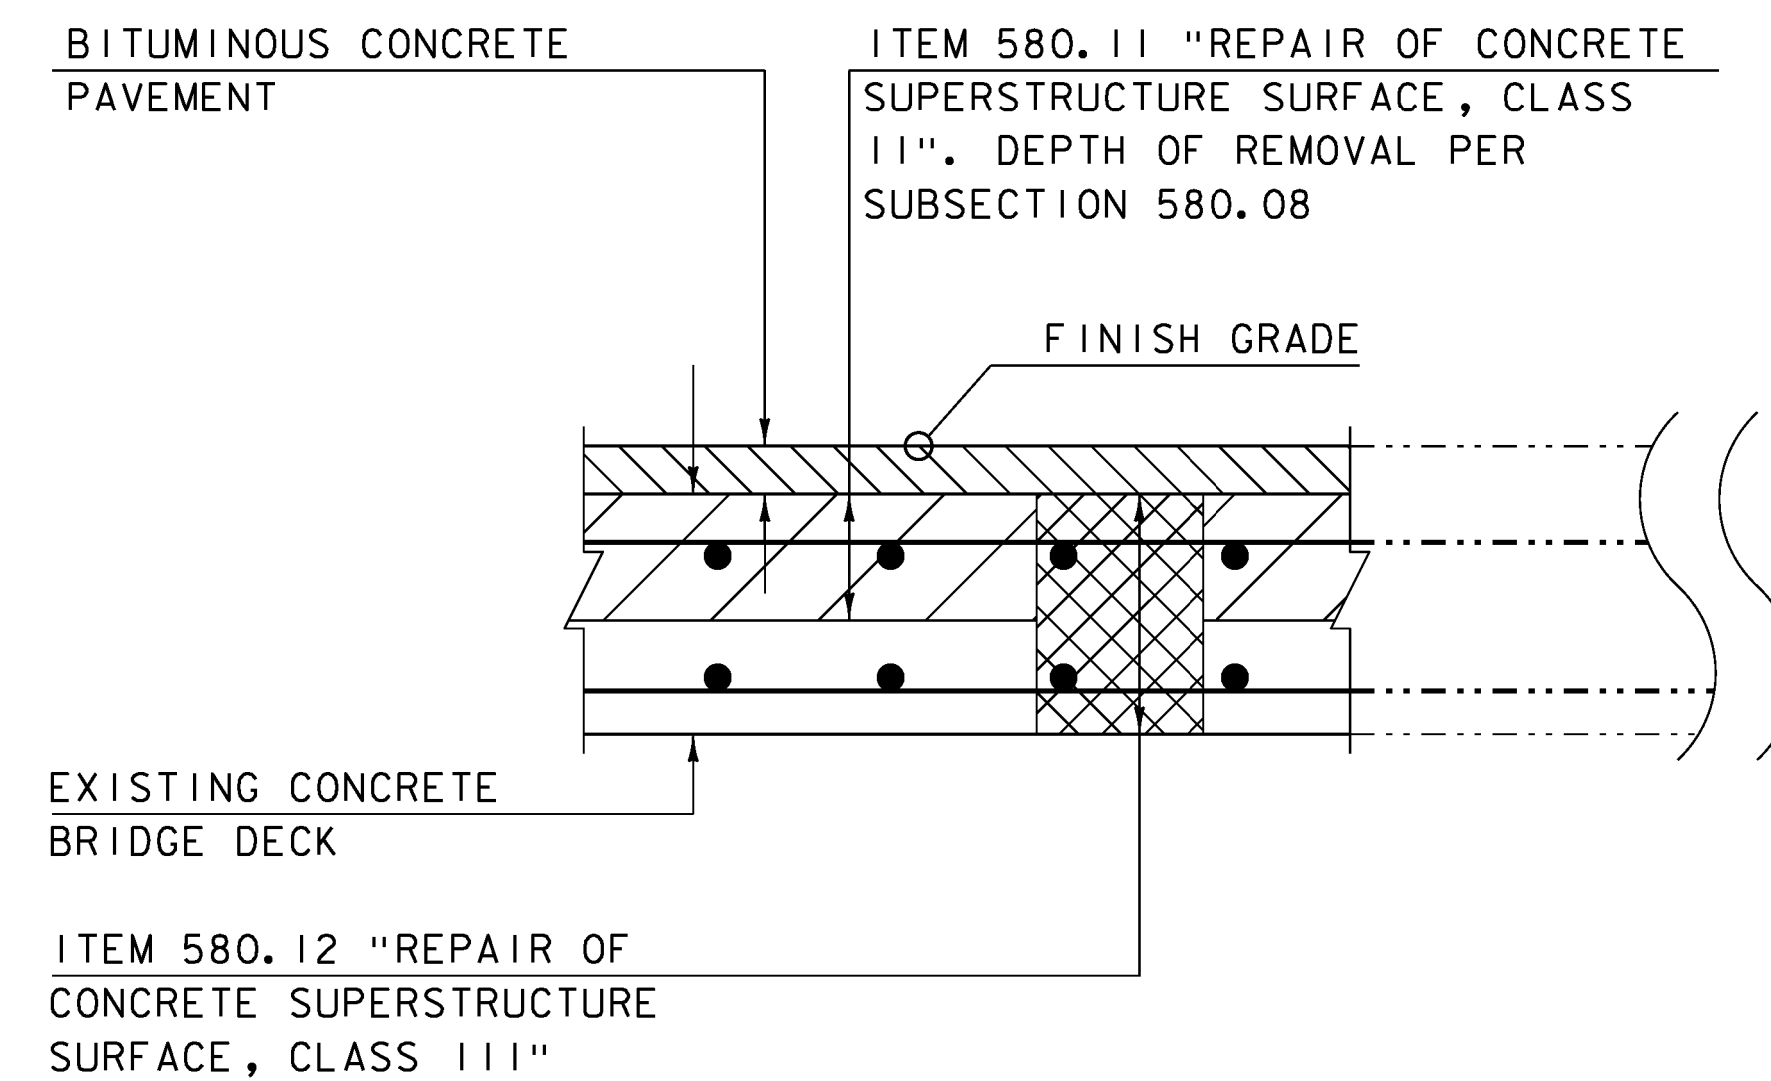

CONCRETE REPLACEMENT  
PAY LIMIT DETAIL

BRIDGE NUMBER	CROSSING OVER	LENGTH OF BRIDGE (FT)	CURB TO CURB PAVEMENT WIDTH (FT)	TOWN	MILE MARKER
1 89 BR 97 N	RECREATION PATH	152.00	30.00	SWANTON	123.118
1 89 BR 97 S	RECREATION PATH	152.00	42.00	SWANTON	123.118
1 89 BR 98 N	VT 78	162.00	30.00	SWANTON	123.368
1 89 BR 98 S	VT 78	162.00	30.00	SWANTON	123.368

BRIDGE LOCATION TABLE

NOTE:  
NF = NEAR FACE  
FF = FAR FACE  
EF = EACH FACE  
▲ = CUT TO FIT IN FIELD  
3" CLEAR, UNLESS OTHERWISE SPECIFIED ON THE PLANS.  
2'-2" BAR LAP UNLESS OTHERWISE SPECIFIED ON THE PLANS.

PROJECT NAME: SWANTON  
PROJECT NUMBER: IM 089-3(70)

FILE NAME: s12q276sup.dgn  
PROJECT LEADER: C. CARLSON  
DESIGNED BY: H. SALLS  
SUPERSTRUCTURE DETAILS  
PLOT DATE: 11-APR-2013  
DRAWN BY: R. PELLETT  
CHECKED BY: H. SALLS  
SHEET 6 OF 31

DRAWING NOT TO SCALE UNLESS NOTED OTHERWISE

## ASPHALTIC PLUG JOINT NOTES



### INSTALLATION:

1. LOCATE THE JOINT CENTRALLY OVER THE DECK OVERLAY EXPANSION GAP OR FIXED JOINT, MARKED OUT TO THE MANUFACTURER'S RECOMMENDED WIDTH.
2. REMOVE THE BITUMINOUS CONCRETE PAVEMENT FULL DEPTH AS SHOWN ON THE PLANS. THE PAVEMENT SHALL BE DRY AND SAW CUT TO THE LIMITS REQUIRED TO PLACE THE JOINT. A PNEUMATIC HAMMER AND CHISEL MAY BE USED ADJACENT TO THE CURB ONLY WHEN SAW CUTTING IS NOT POSSIBLE.
3. BLAST CLEAN THE JOINT AREA OF DEBRIS, ASPHALT AND SHEET MEMBRANE. THOROUGHLY DRY THE JOINT AREA WITH COMPRESSED AIR PRIOR TO APPLYING BINDER MATERIAL.
4. REPAIR MATERIAL GREATER THAN 4 INCHES FROM FINISHED GRADE WITH RAPID SETTING CONCRETE REPAIR MATERIAL WITH COARSE AGGREGATE MEETING THE REQUIREMENTS OF SUBSECTION 780.04.
5. PLACE PROPERLY SIZED HEAT RESISTANT BACKER ROD IN THE MOVEMENT GAP ALLOWING FOR 1" +/- OF BINDER ABOVE THE ROD.
6. HEAT AND PLACE THE BINDER MATERIAL AS RECOMMENDED BY THE MANUFACTURER.
7. PLACE 1/4" THICK BY 8" WIDE SECTIONS OF STEEL PLATE OVER THE CENTER OF THE MOVEMENT GAP. SECURE THE PLATES FROM MOVING BY INSERTING LOCATING PINS THROUGH THE PRE-STAMPED HOLES INTO BACKER ROD AND COVER WITH HOT BINDER. THE STEEL PLATES MAY BE OMITTED WHERE THE ENGINEER DETERMINES THAT THE APPROACH SLAB OR BRIDGE DECK WILL PROVIDE INADEQUATE SUPPORT AND WHERE VERTICAL MOVEMENT OF THE PLATES MIGHT OCCUR.
8. HEAT AND MIX THE BINDER MATERIAL AND AGGREGATE AS RECOMMENDED BY THE MANUFACTURER.
9. INSTALLATION OF MATERIAL, COMPACTION, AND TOP COATING SHALL BE AS RECOMMENDED BY THE MANUFACTURER.
10. IMMEDIATELY AFTER TOP COATING, CAST AN ANTI-SKID MATERIAL OVER THE JOINT TO REDUCE THE RISK OF TRACKING.
11. ONCE THE JOINT REACHES 82 DEG C (180 DEG F) +/-, WATER MAY BE USED TO EXPEDITE THE COOLING PROCESS.
12. PROTECT JOINT FROM TRAFFIC UNTIL THE MATERIAL HAS COOLED TO 51 DEG C (125 DEG F) +/-.


### WEATHER LIMITATIONS

APPLY BINDER MATERIAL ONLY WHEN THE FOLLOWING CONDITIONS PREVAIL OR AS RECOMMENDED BY THE MANUFACTURER:

1. THE AMBIENT AIR TEMPERATURE IS AT LEAST 10 DEG C (50 DEG F) AND RISING.
2. THE ROAD SURFACE IS DRY.
3. WEATHER CONDITIONS OR OTHER CONDITIONS ARE FAVORABLE AND ARE EXPECTED TO REMAIN SO FOR THE PERFORMANCE OF SATISFACTORY WORK.

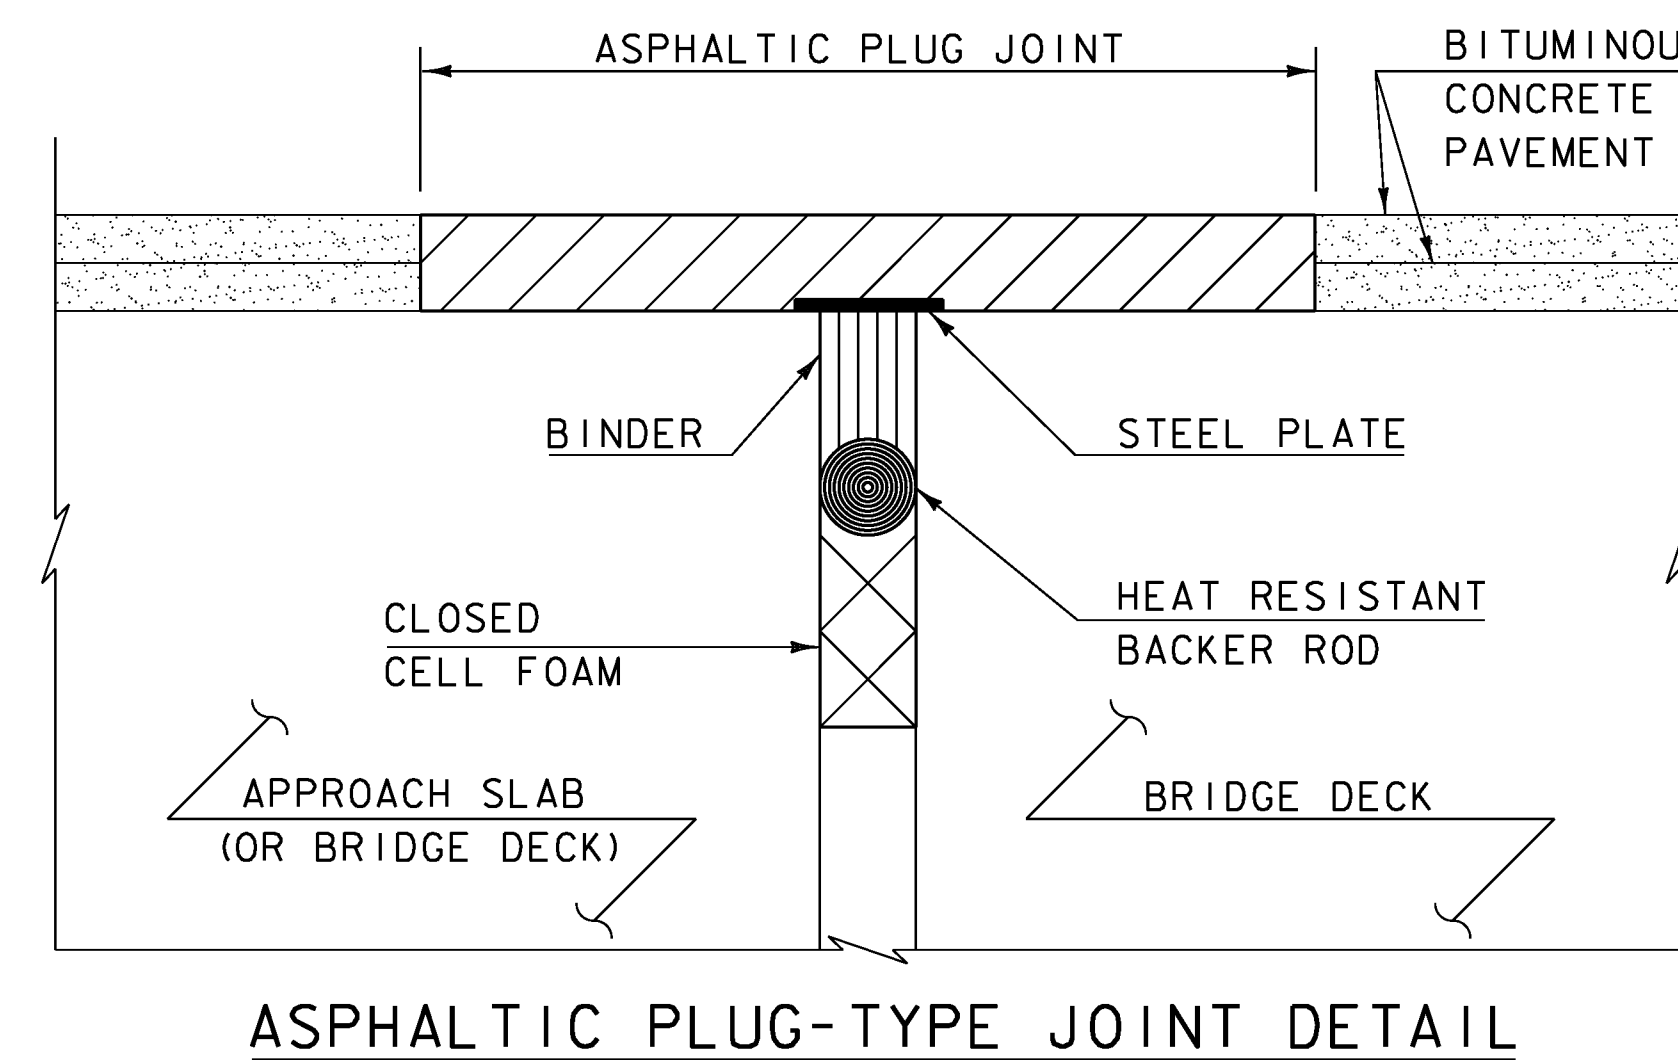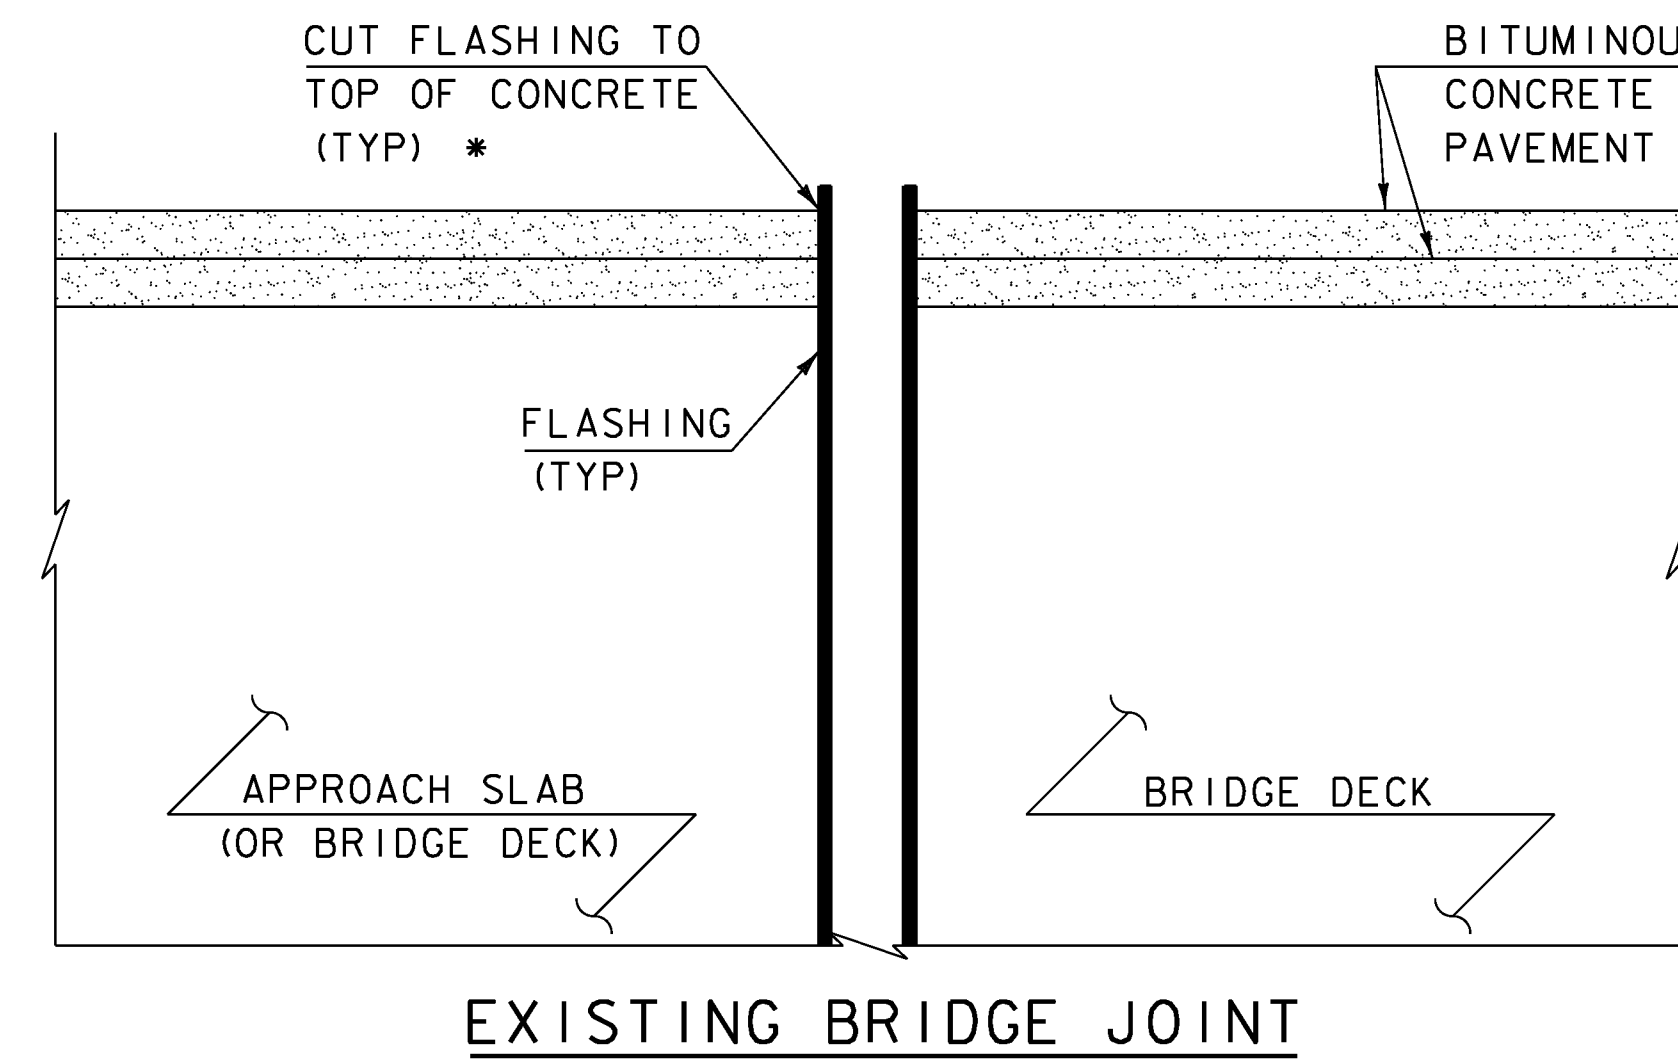

\* PAYMENT FOR CUTTING THE JOINT PLATES FLASH WILL BE PAID FOR UNDER ITEM 516.10 BRIDGE EXPANSION JOINT, ASPHALTIC PLUG

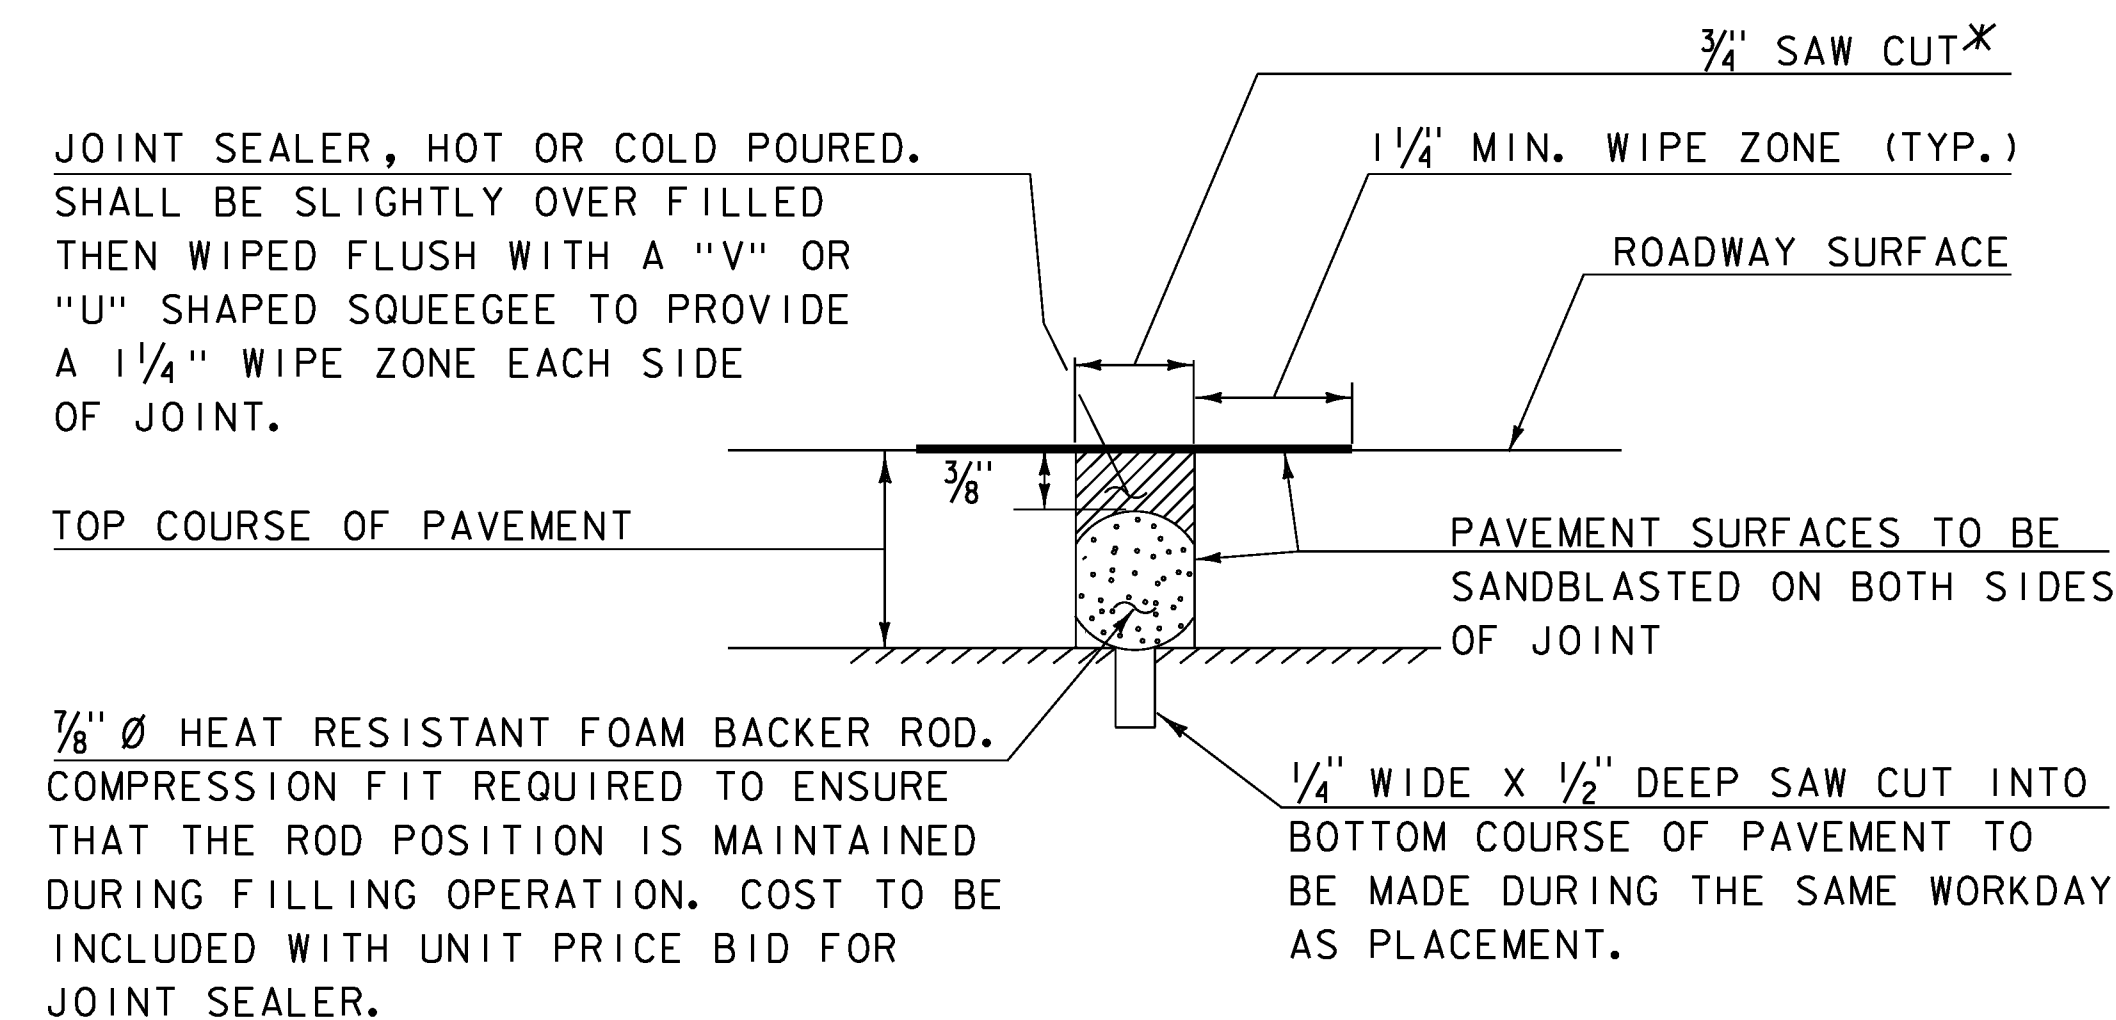


\* JOINT IS TO BE LOCATED ACCURATELY BY STRING LINING, OR OTHER MEANS, PRIOR TO PAVING, SO THAT THE SAW CUTS WILL BE MADE DIRECTLY OVER THE END OF CONCRETE DECK. JOINT SHALL BE CUT DRY IN A SINGLE PASS AND BE SEALED WITHIN 24 HOURS OR PRIOR TO EXPOSURE TO TRAFFIC. JOINT SHALL BE CLEANED PRIOR TO APPLYING THE JOINT SEALER.


DRAWING NOT TO SCALE UNLESS NOTED OTHERWISE

PROJECT NAME: SWANTON	
PROJECT NUMBER: IM 089-3(70)	
FILE NAME: sl2a276sup.dgn	PLOT DATE: 19-MAR-2013
PROJECT LEADER: C. CARLSON	DRAWN BY: R. PELLETT
DESIGNED BY: H. SALLS	CHECKED BY: H. SALLS
JOINT DETAILS	SHEET 7 OF 31




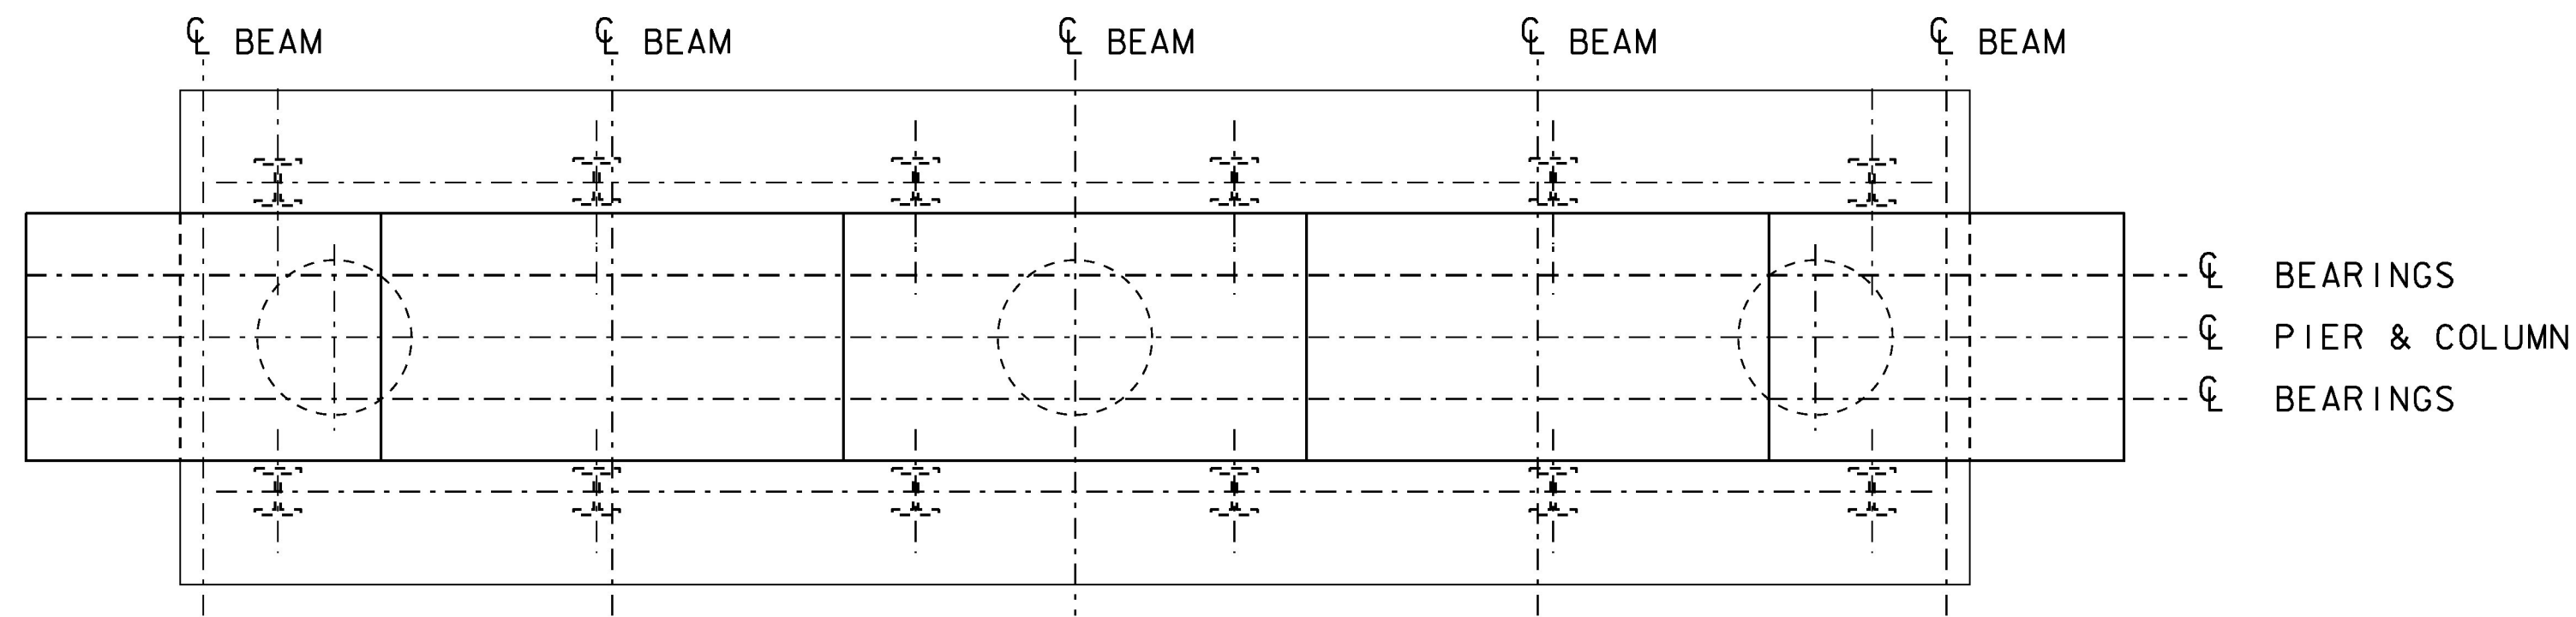

PLAN  
SCALE 3/8" = 1'-0"

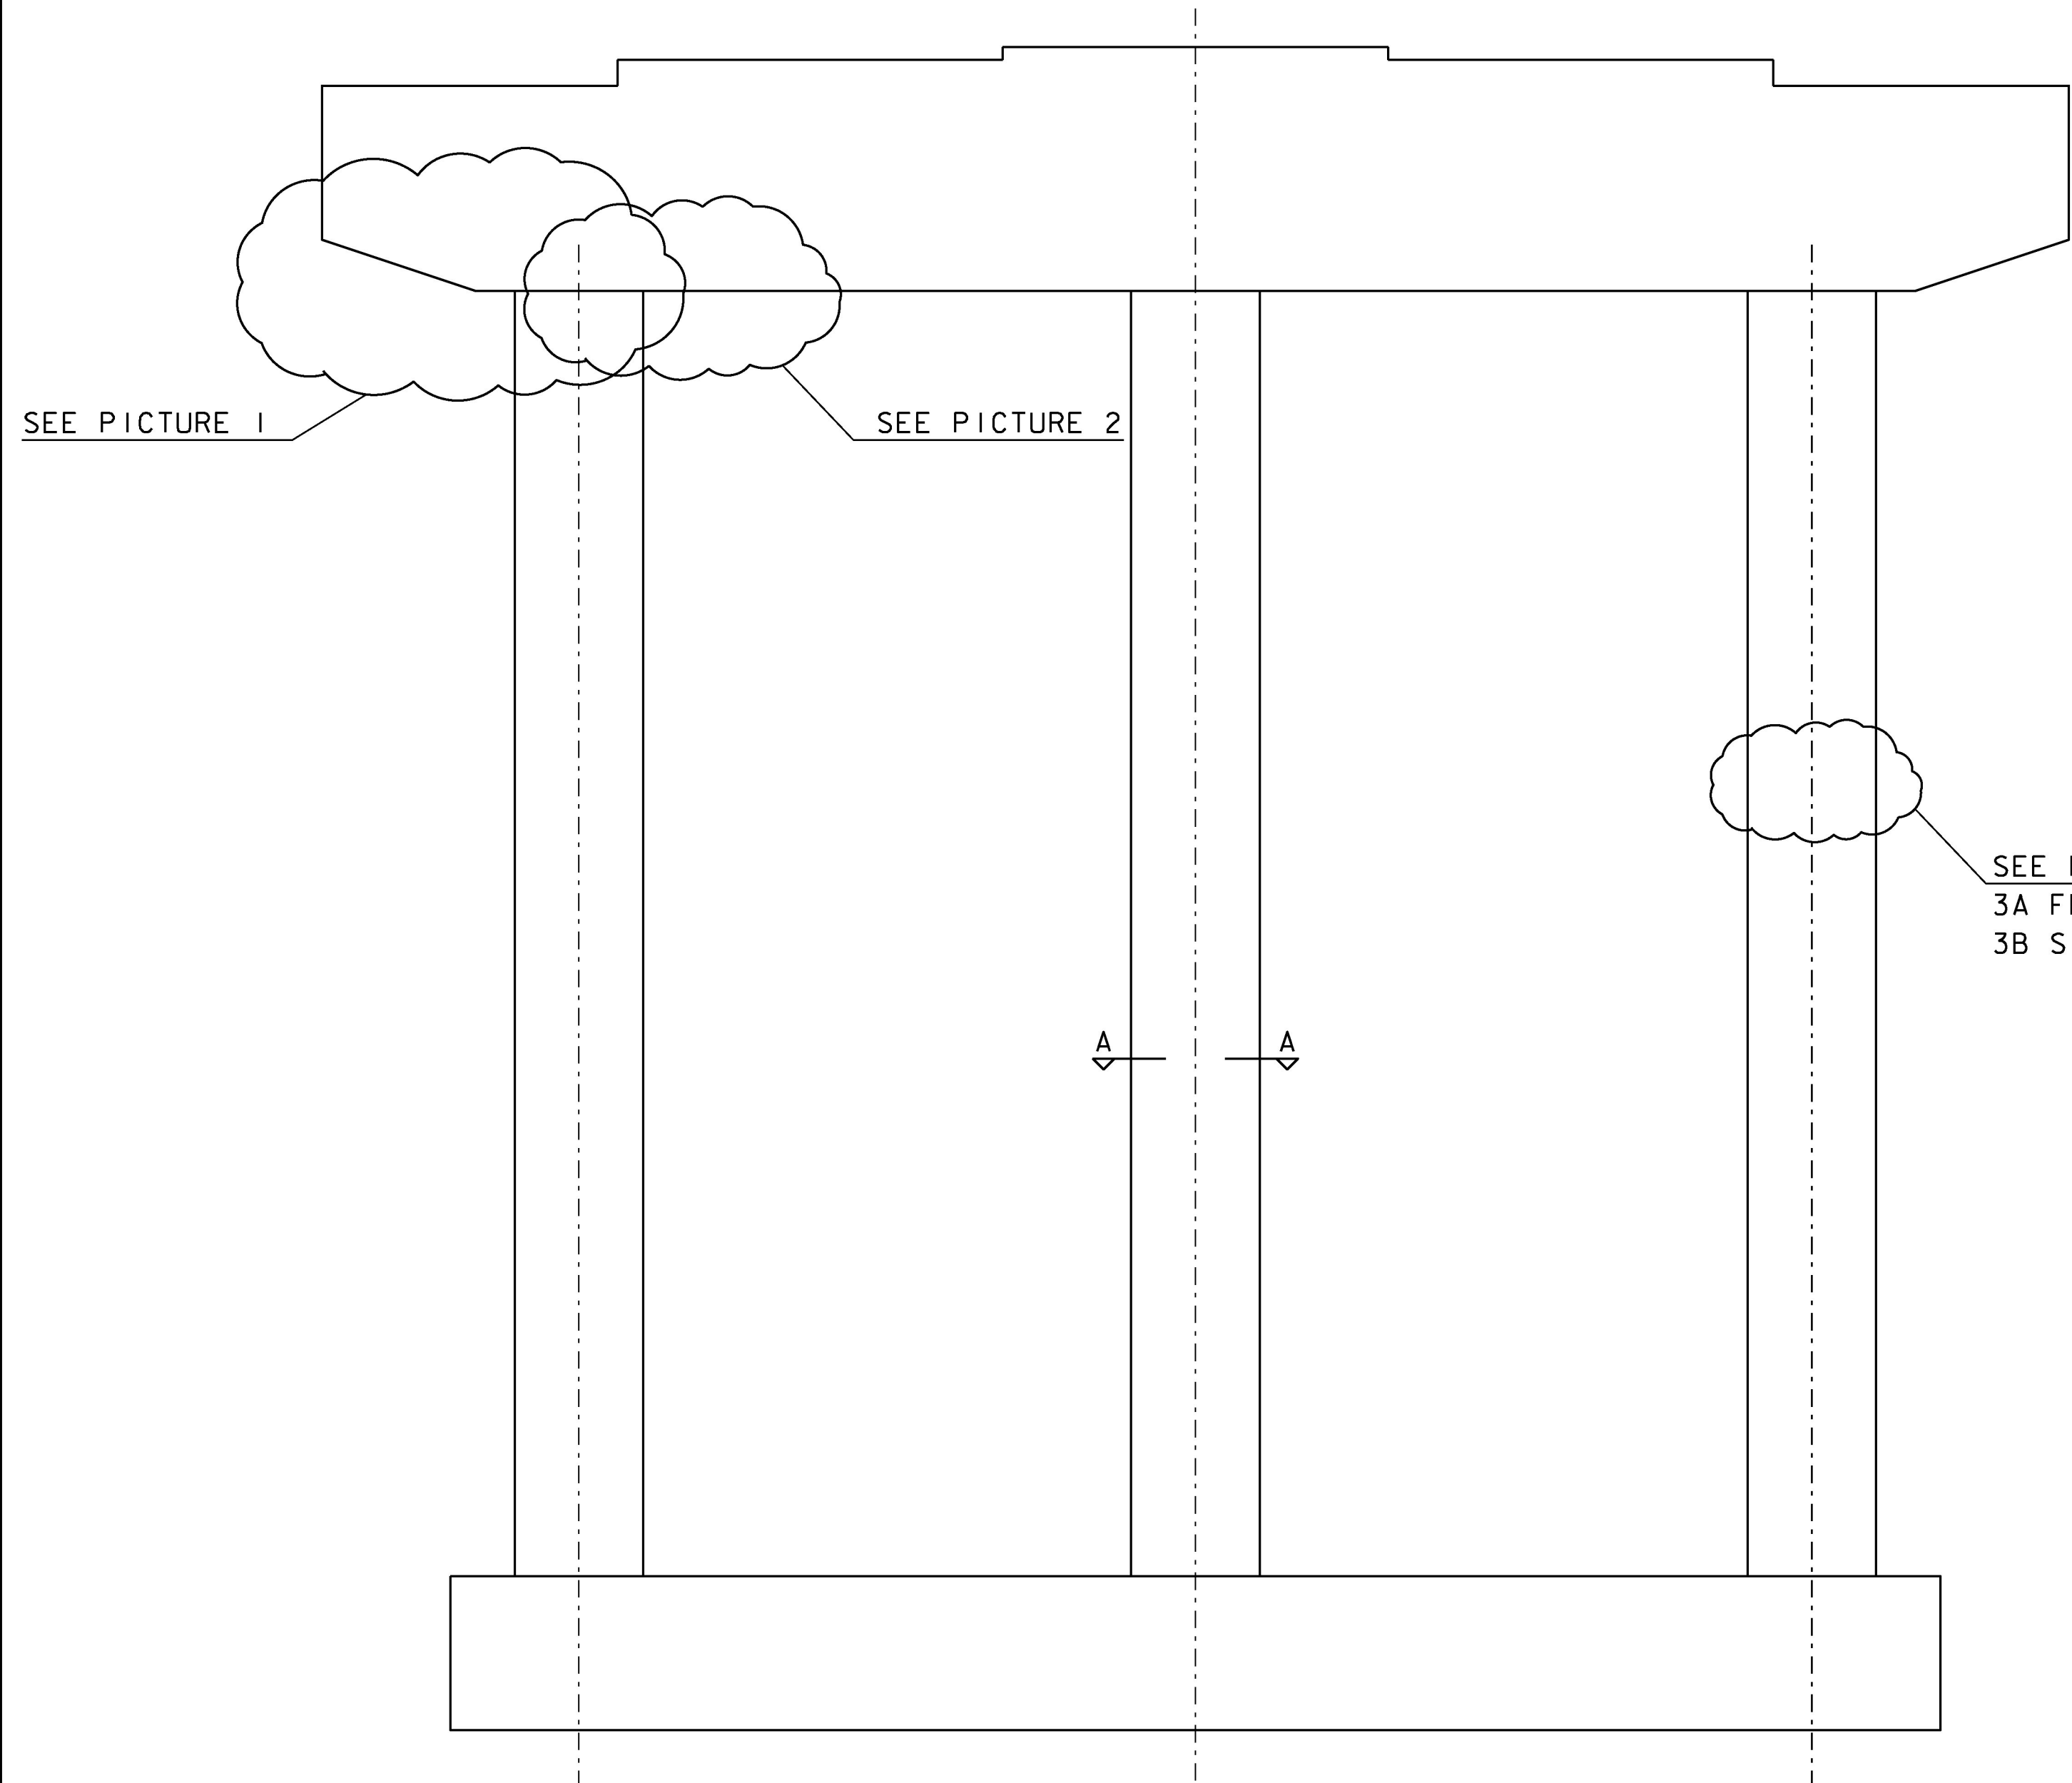

ELEVATION  
SCALE 3/8" = 1'-0"

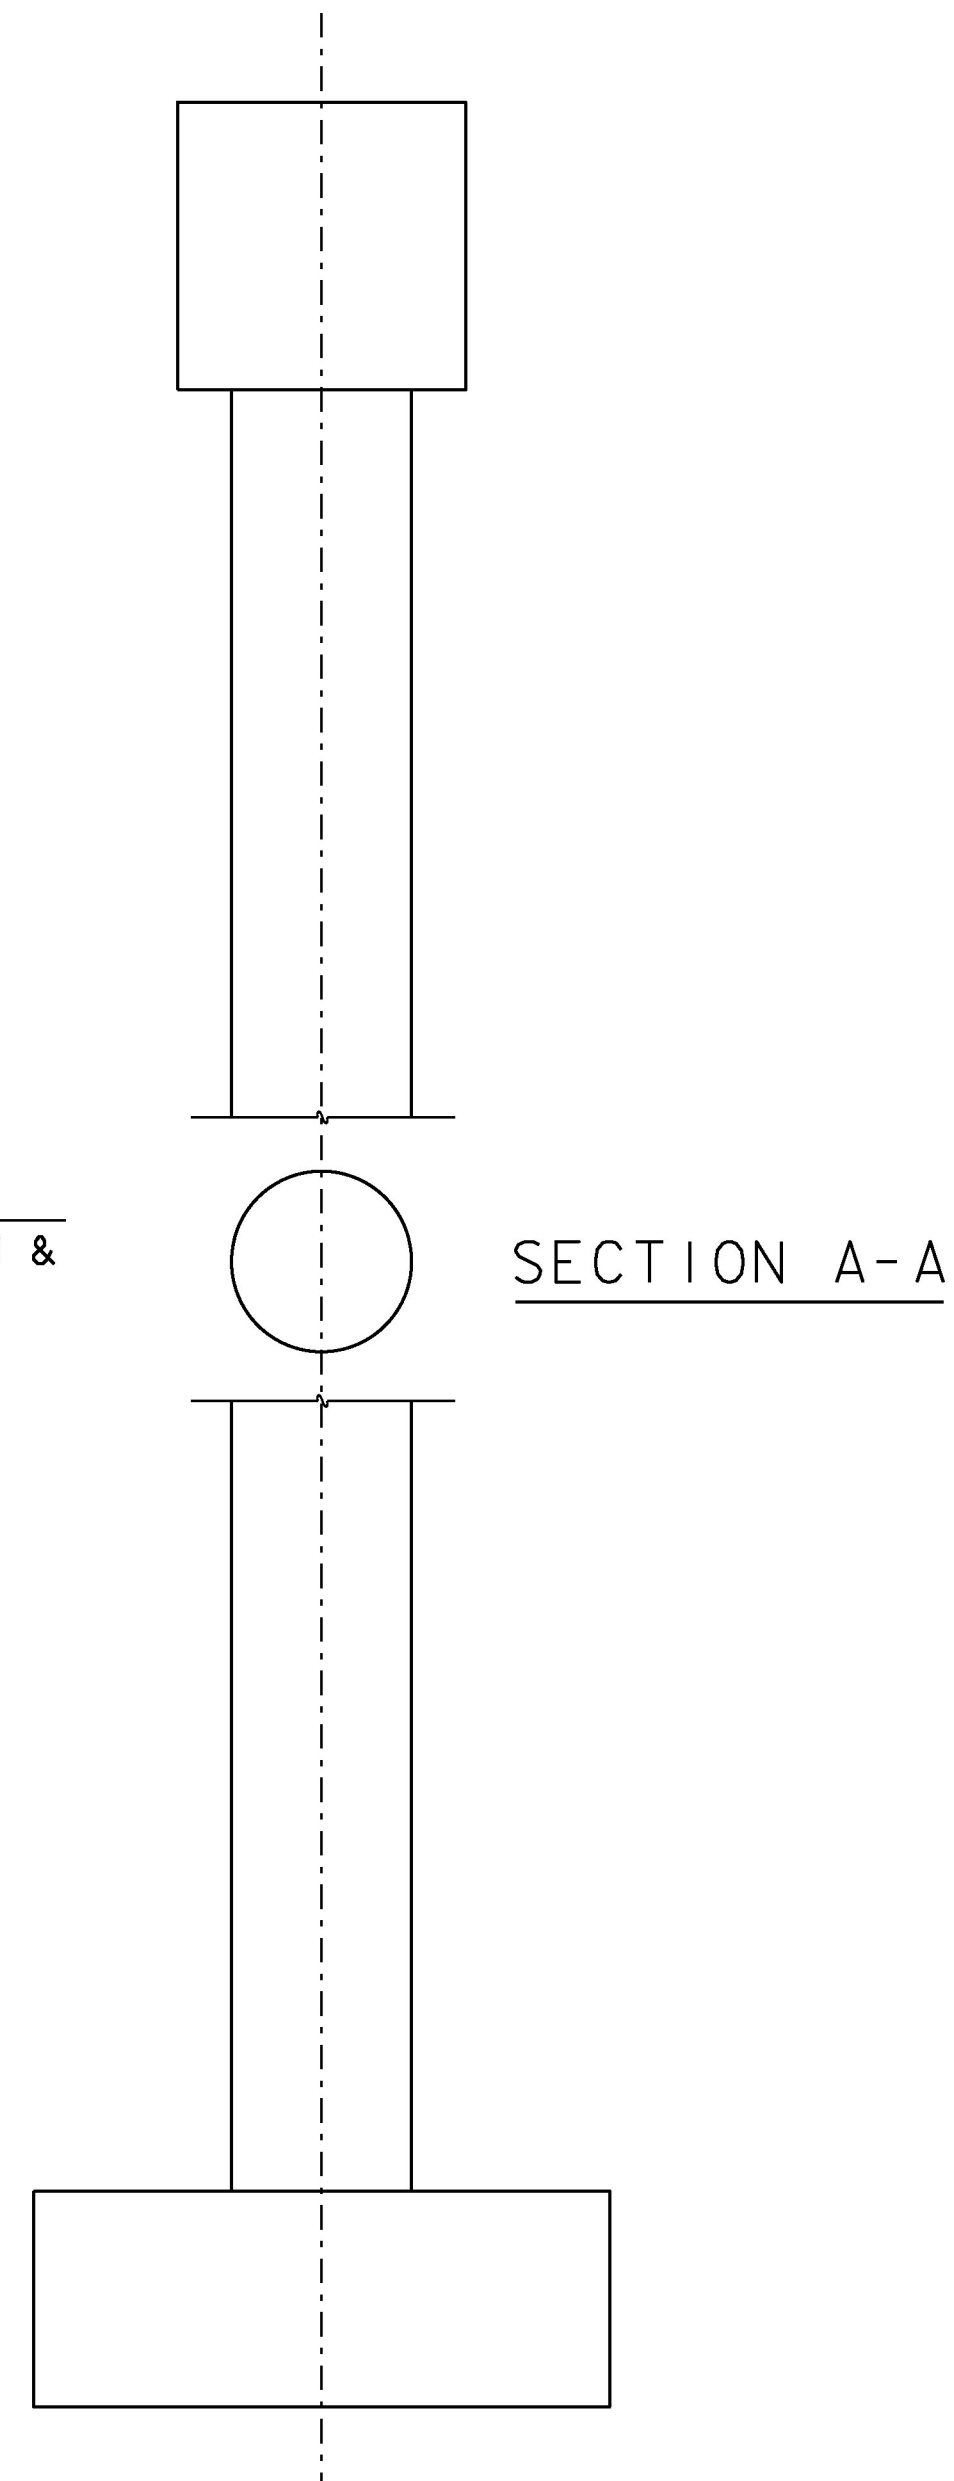

TYPICAL SECTION  
SCALE 3/8" = 1'-0"

SUBSTRUCTURE NOTES

IT IS ANTICIPATED THAT 30% OF THE SUBSTRUCTURE WILL REQUIRE A CLASS I SUBSTRUCTURE REPAIR; WHILE 10% WILL REQUIRE A CLASS II SUBSTRUCTURE REPAIR. THE ENGINEER WILL DETERMINE THE LEVEL OF REPAIR NEEDED.

THE PICTURES REPRESENT THE EXISTING CONDITION OF THE SUBSTRUCTURES BUT DO NOT SHOW ALL THE AFFECTED AREAS.

PICTURE 1



PICTURE 2



PICTURE 3A

FRONT VIEW



PICTURE 3B

SIDE VIEW




NOTE:  
FOR MORE DETAILED INFORMATION VIEW THE REFERENCE PLANS.

PROJECT NAME: SWANTON  
PROJECT NUMBER: IM 089-3(70)

FILE NAME: sl2a276sub.dgn  
PROJECT LEADER: C. CARLSON  
DESIGNED BY: H. SALLS  
BRIDGE 97 NORTH - PIERS NO. 3 & 4

PLOT DATE: 19-MAR-2013  
DRAWN BY: DZENAN K.  
CHECKED BY: H. SALLS  
SHEET 9 OF 31

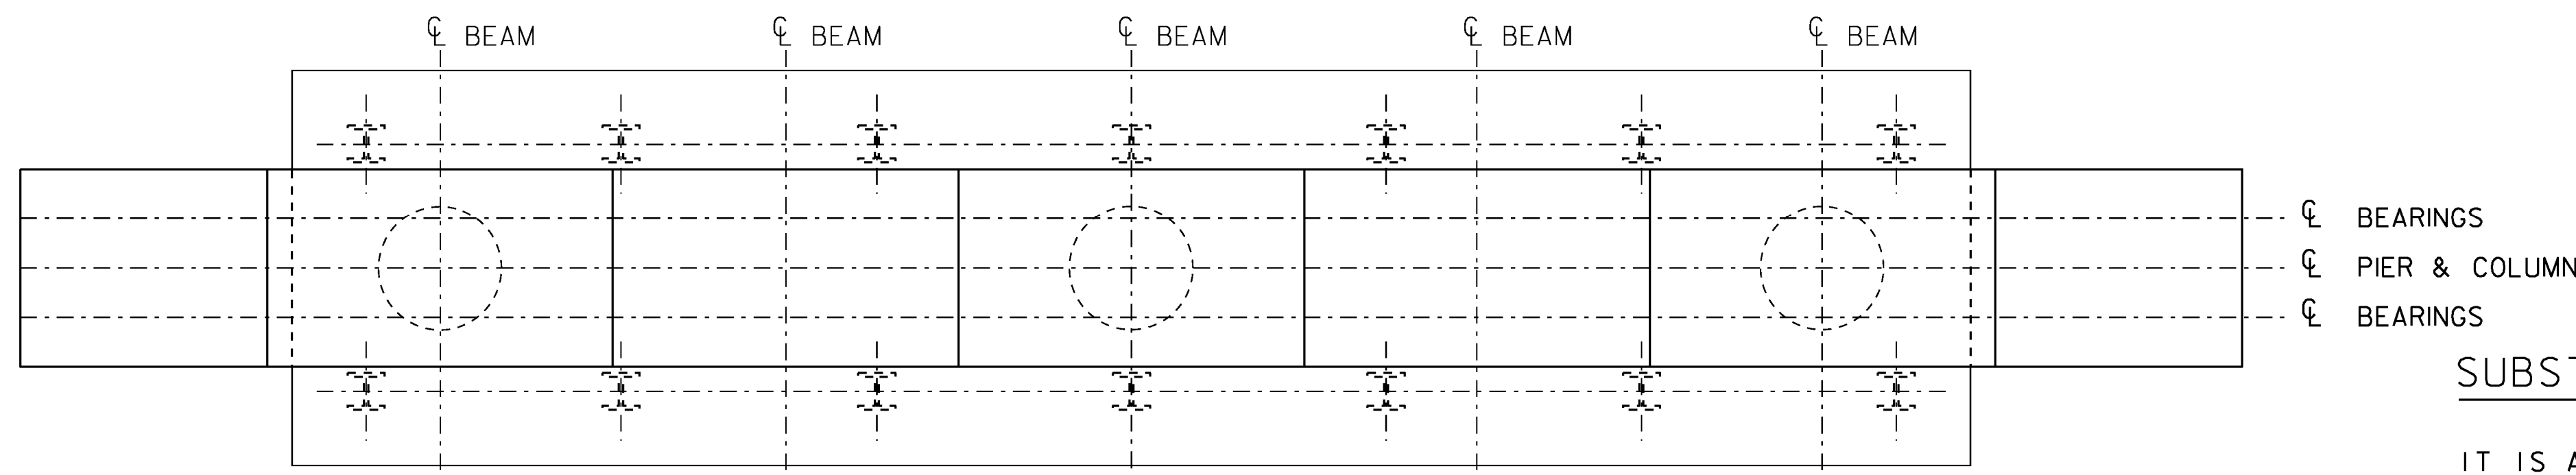

PLAN  
SCALE 3/8" = 1'-0"

SUBSTRUCTURE NOTES

IT IS ANTICIPATED THAT 30% OF THE SUBSTRUCTURE WILL REQUIRE A CLASS I SUBSTRUCTURE REPAIR; WHILE 10% WILL REQUIRE A CLASS II SUBSTRUCTURE REPAIR. THE ENGINEER WILL DETERMINE THE LEVEL OF REPAIR NEEDED.

THE PICTURES REPRESENT THE EXISTING CONDITION OF THE SUBSTRUCTURES BUT DO NOT SHOW ALL THE AFFECTED AREAS.

PICTURE 4




PICTURE 5



PICTURE 6



PICTURE 7

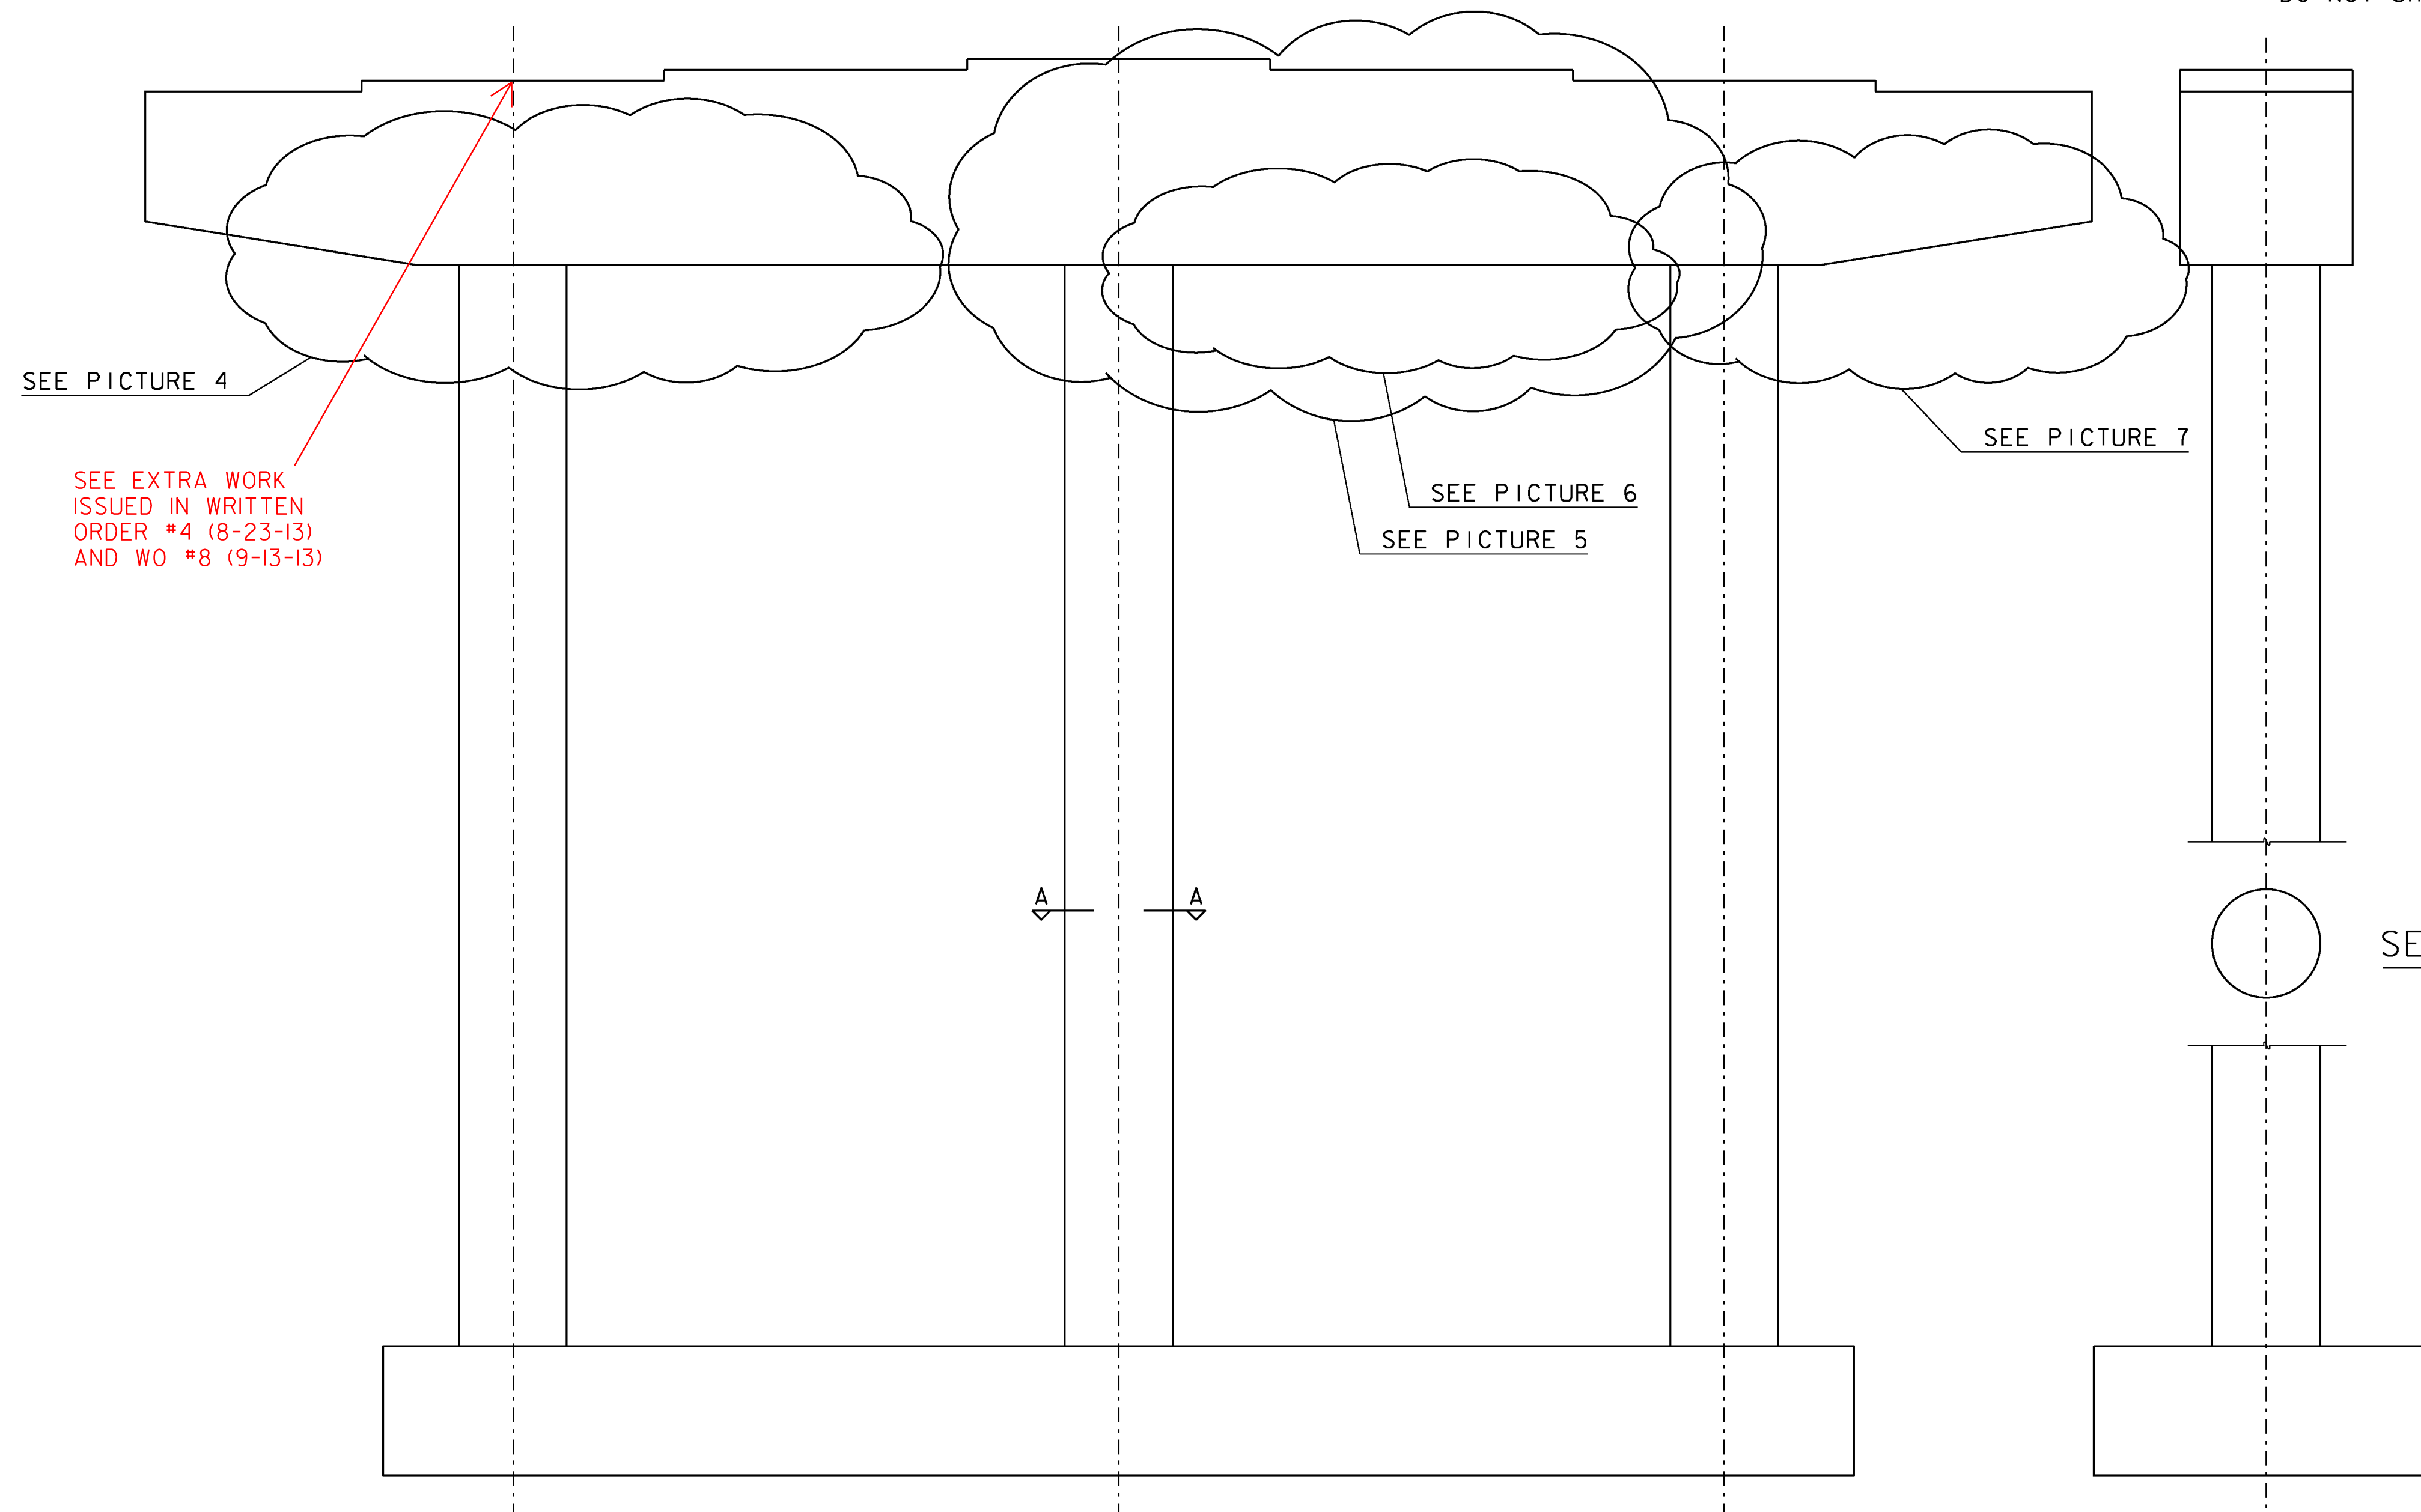

ELEVATION  
SCALE 3/8" = 1'-0"



TYPICAL SECTION  
SCALE 3/8" = 1'-0"

NOTE:  
FOR MORE DETAILED INFORMATION VIEW THE REFERENCE PLANS.

PROJECT NAME: SWANTON  
PROJECT NUMBER: IM 089-3(70)

FILE NAME: sl2a276sub.dgn  
PROJECT LEADER: C. CARLSON  
DESIGNED BY: H. SALLS  
BRIDGE 97 SOUTH - PIERS NO. 1 & 2

PLOT DATE: 19-MAR-2013  
DRAWN BY: DZENAN K.  
CHECKED BY: H. SALLS  
SHEET 10 OF 31

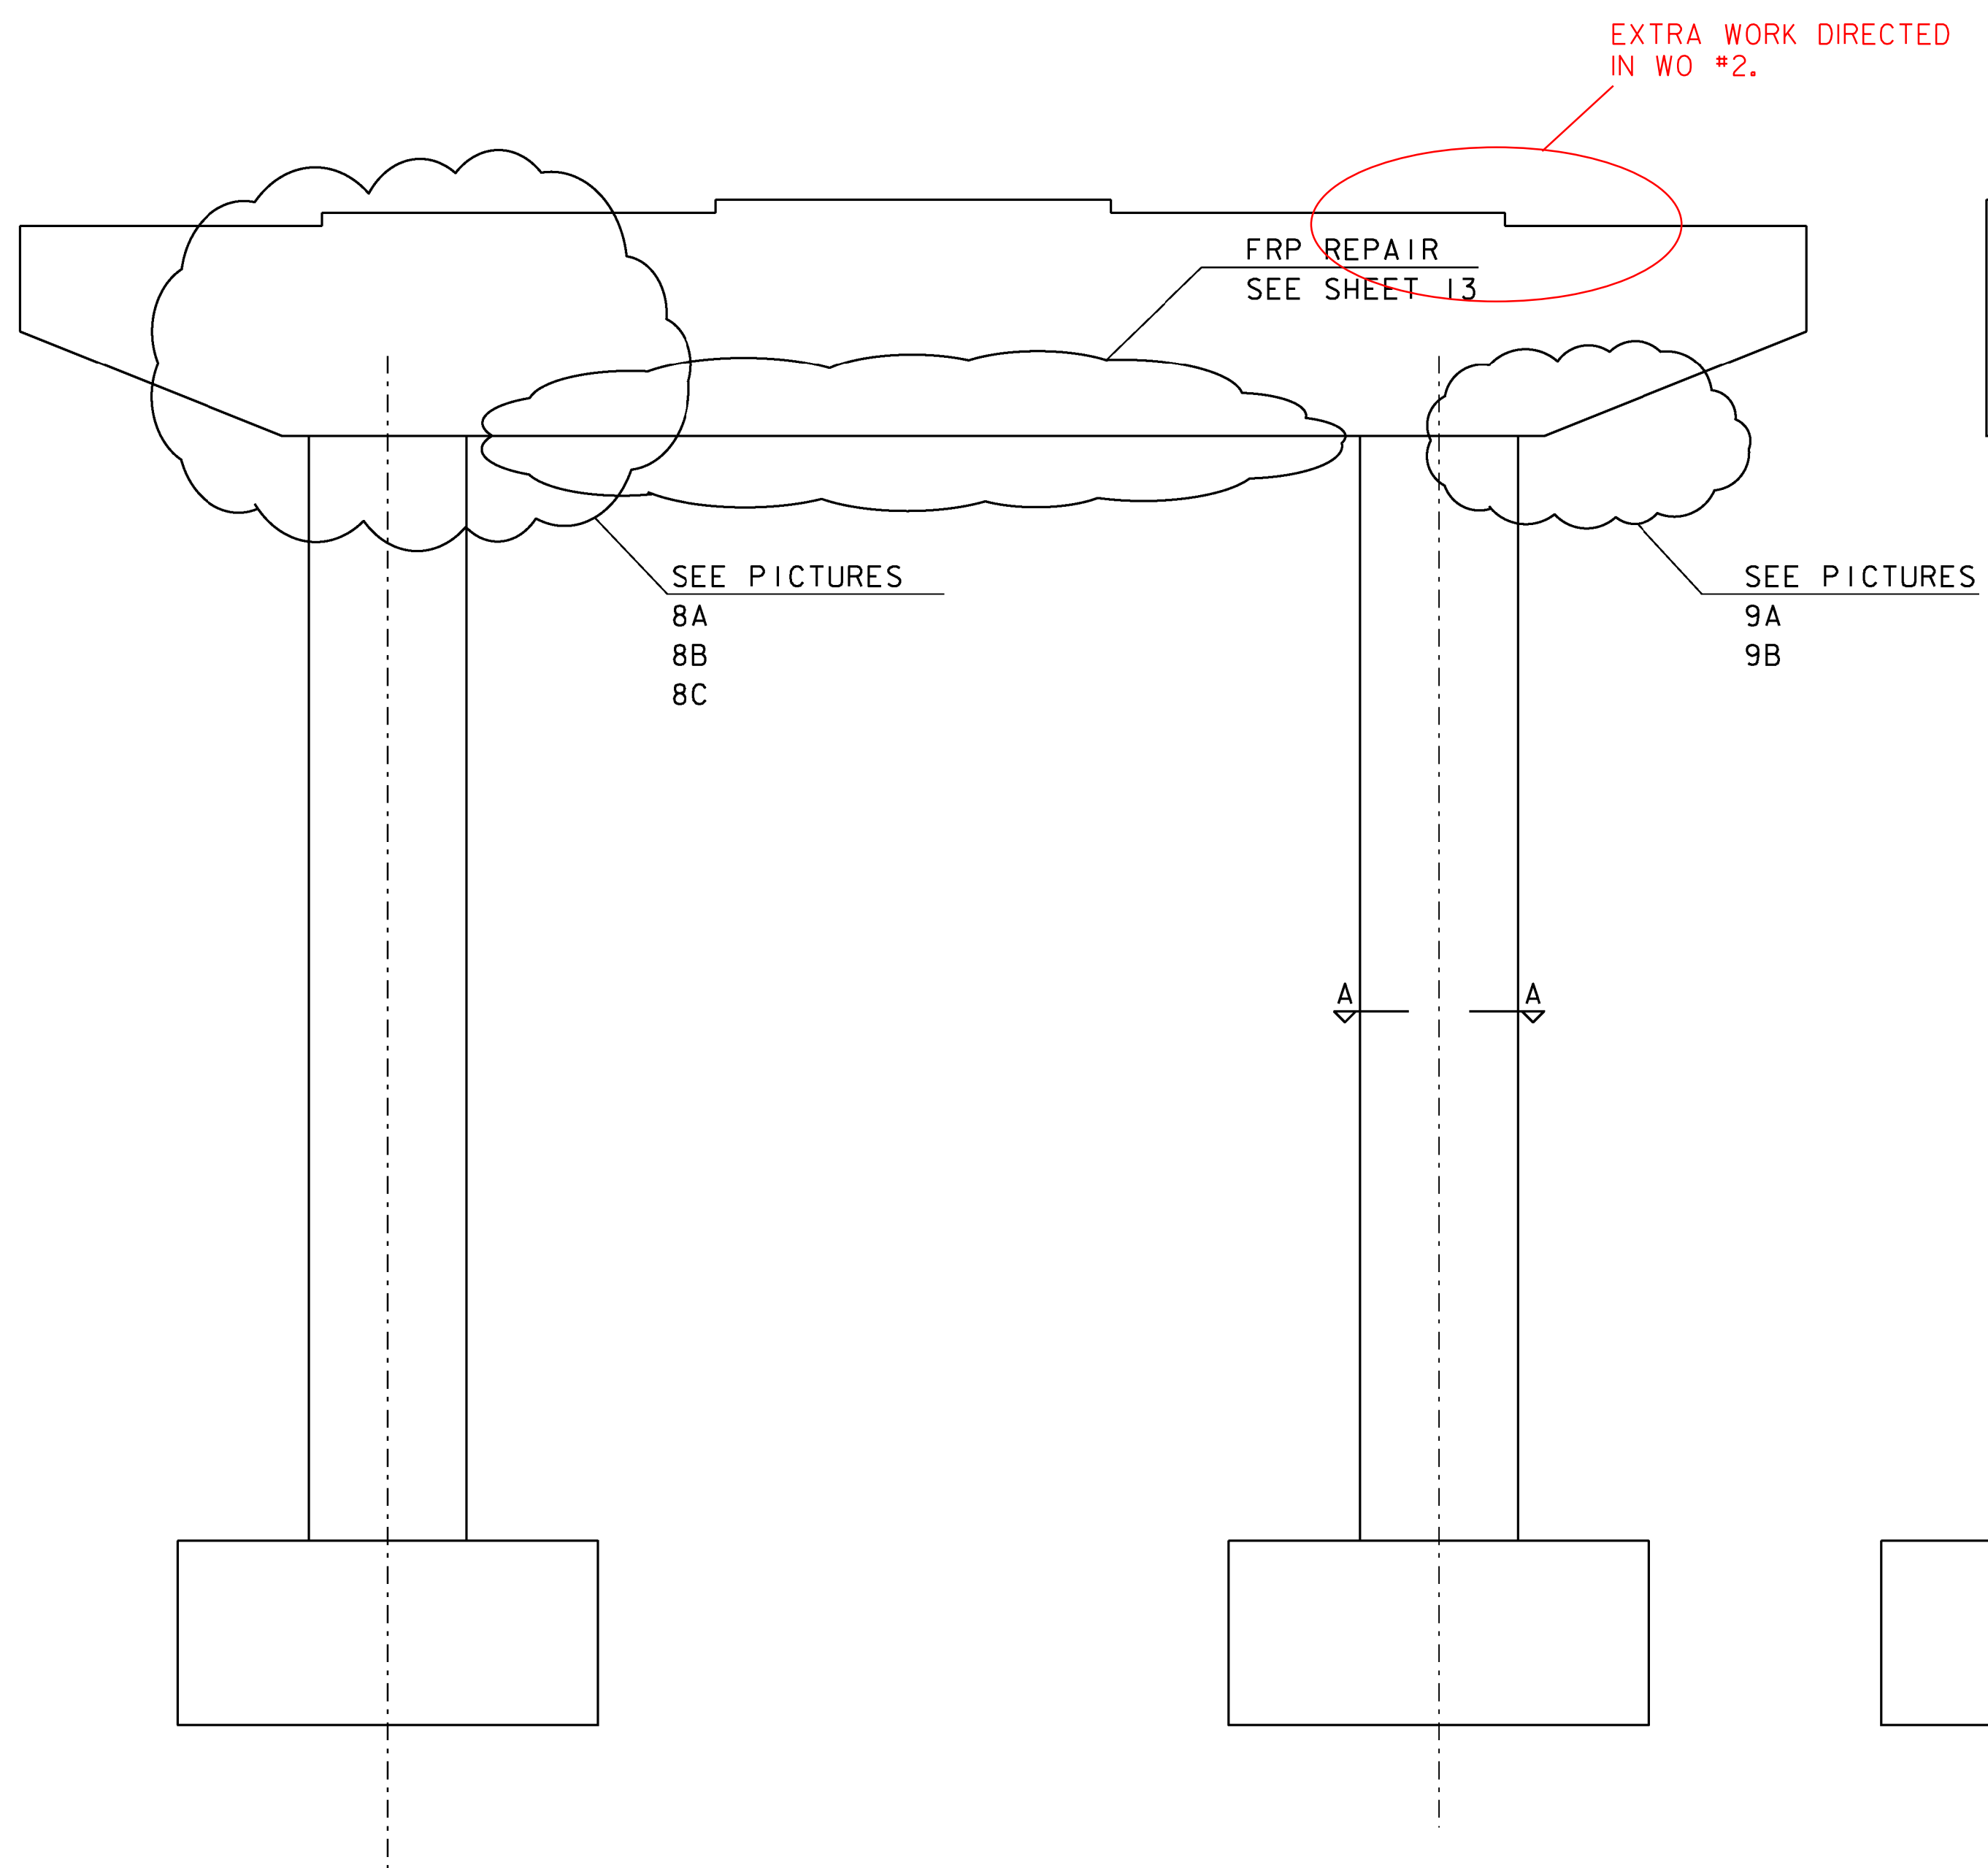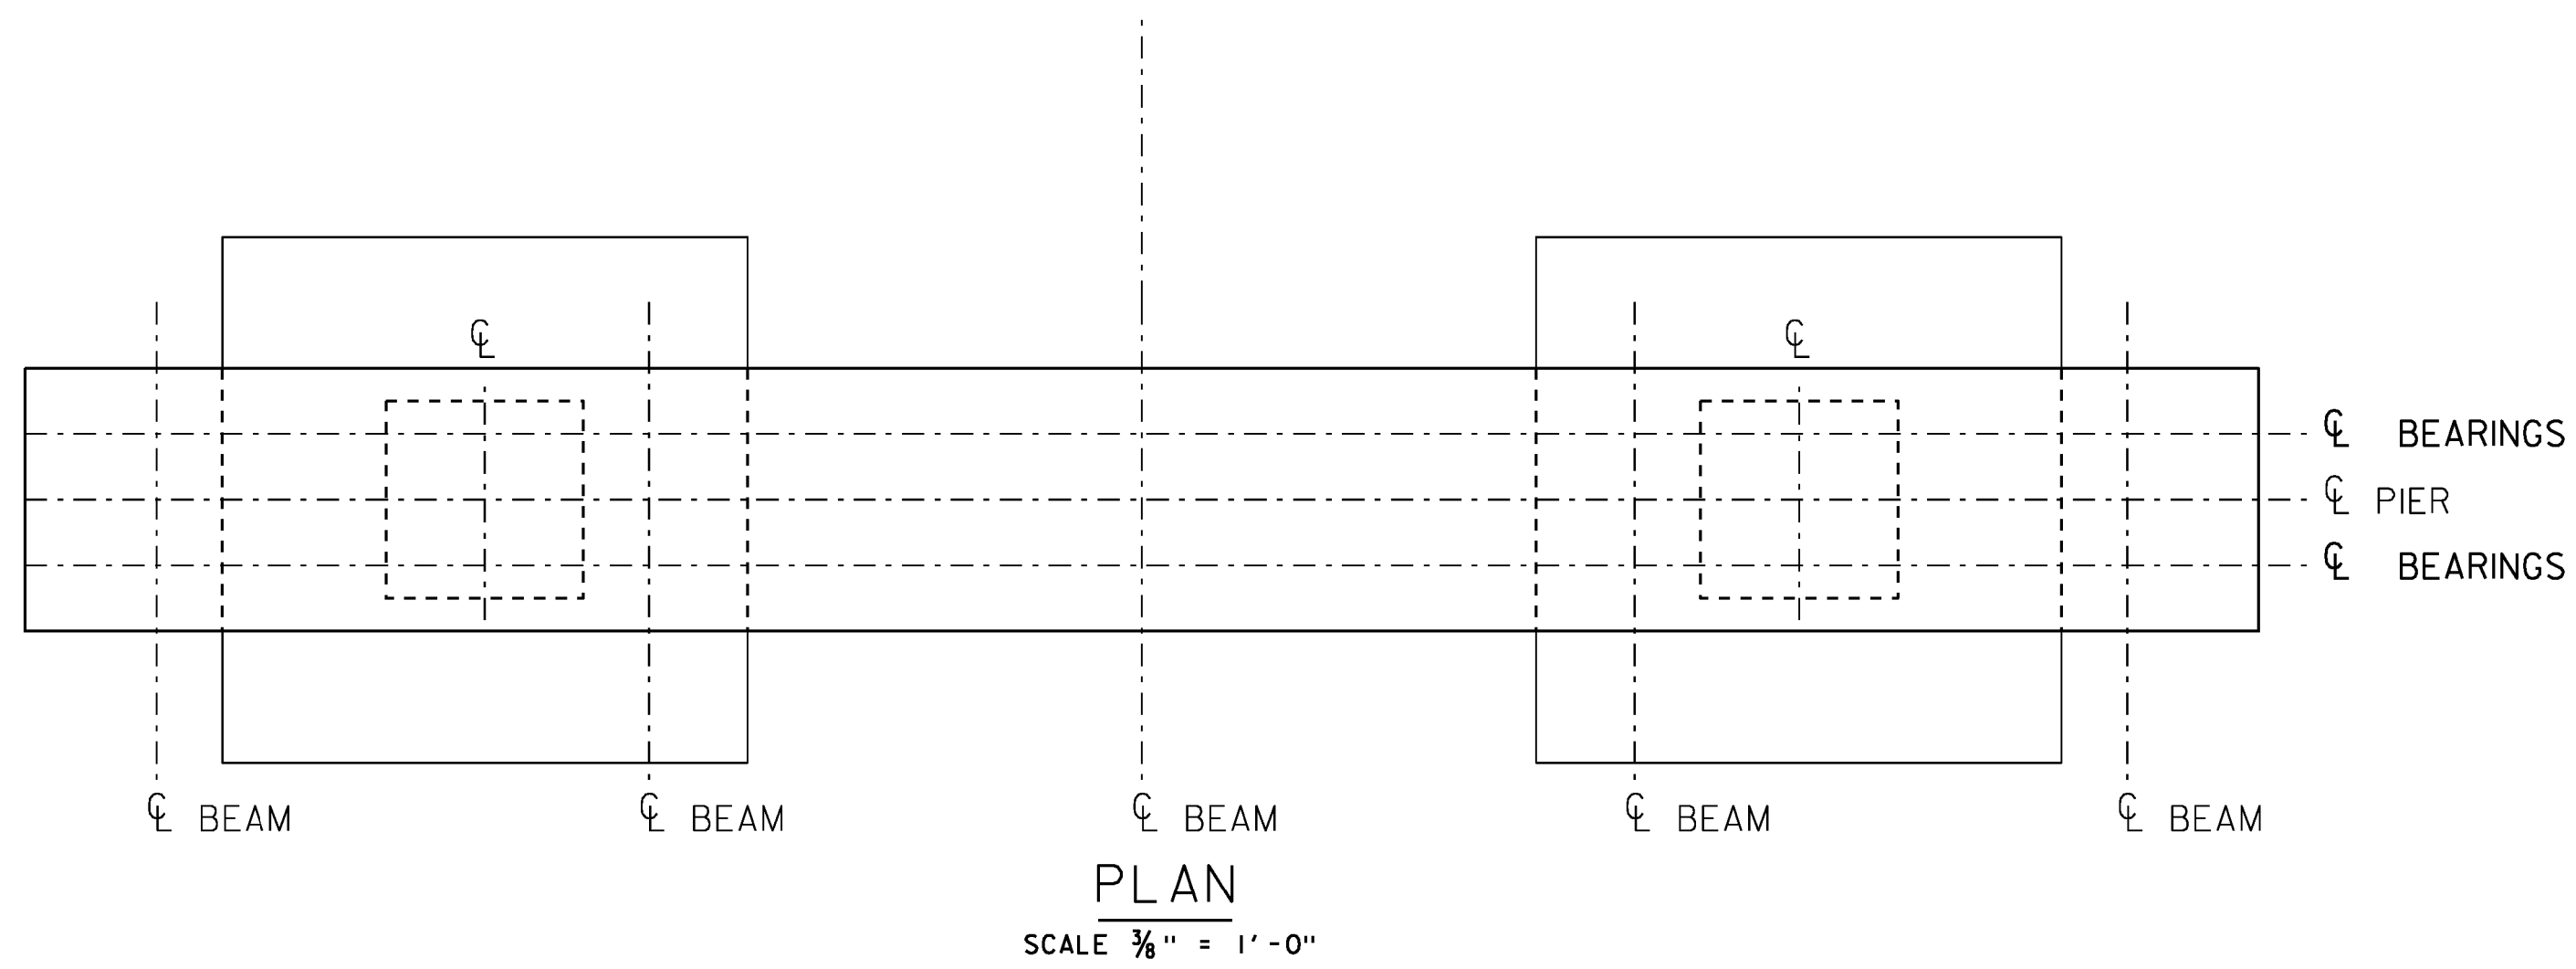

ELEVATION  
SCALE 3/8" = 1'-0"

TYPICAL SECTION  
SCALE 3/8" = 1'-0"

PICTURE 8A



PICTURE 8B



PICTURE 8C



PICTURE 9A



PICTURE 9B



SUBSTRUCTURE NOTES

IT IS ANTICIPATED THAT 30% OF THE SUBSTRUCTURE WILL REQUIRE A CLASS I SUBSTRUCTURE REPAIR; WHILE 10% WILL REQUIRE A CLASS II SUBSTRUCTURE REPAIR. THE ENGINEER WILL DETERMINE THE LEVEL OF REPAIR NEEDED.


THE PICTURES REPRESENT THE EXISTING CONDITION OF THE SUBSTRUCTURES BUT DO NOT SHOW ALL THE AFFECTED AREAS.

NOTE:  
FOR MORE DETAILED INFORMATION VIEW THE REFERENCE PLANS.


PROJECT NAME: SWANTON  
PROJECT NUMBER: IM 089-3(70)

FILE NAME: sl2a276sub.dgn  
PROJECT LEADER: C. CARLSON  
DESIGNED BY: H. SALLS  
BRIDGE 98 NORTH - PIERS NO. 1 & 2


PLOT DATE: 19-MAR-2013  
DRAWN BY: DZENAN K.  
CHECKED BY: H. SALLS  
SHEET 11 OF 31

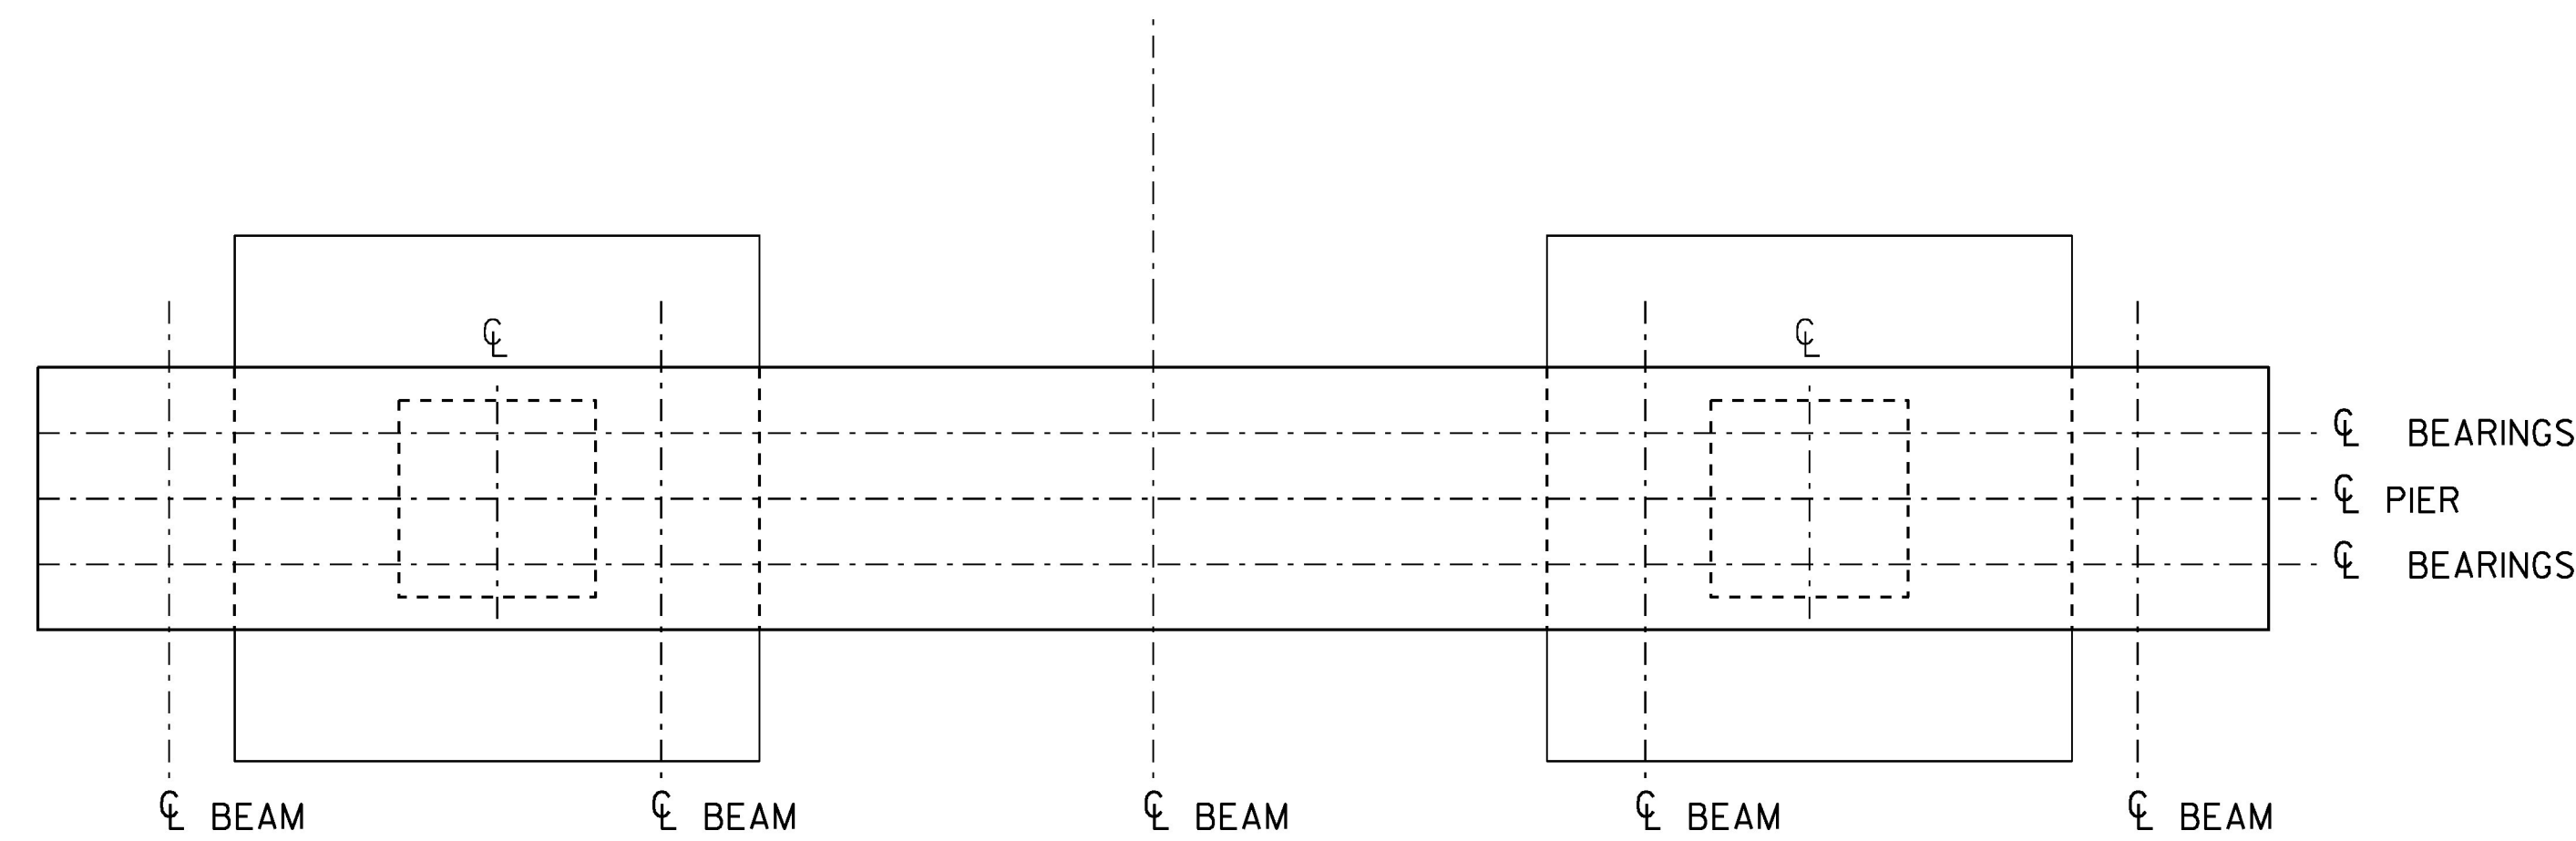

PLAN  
SCALE 3/8" = 1'-0"

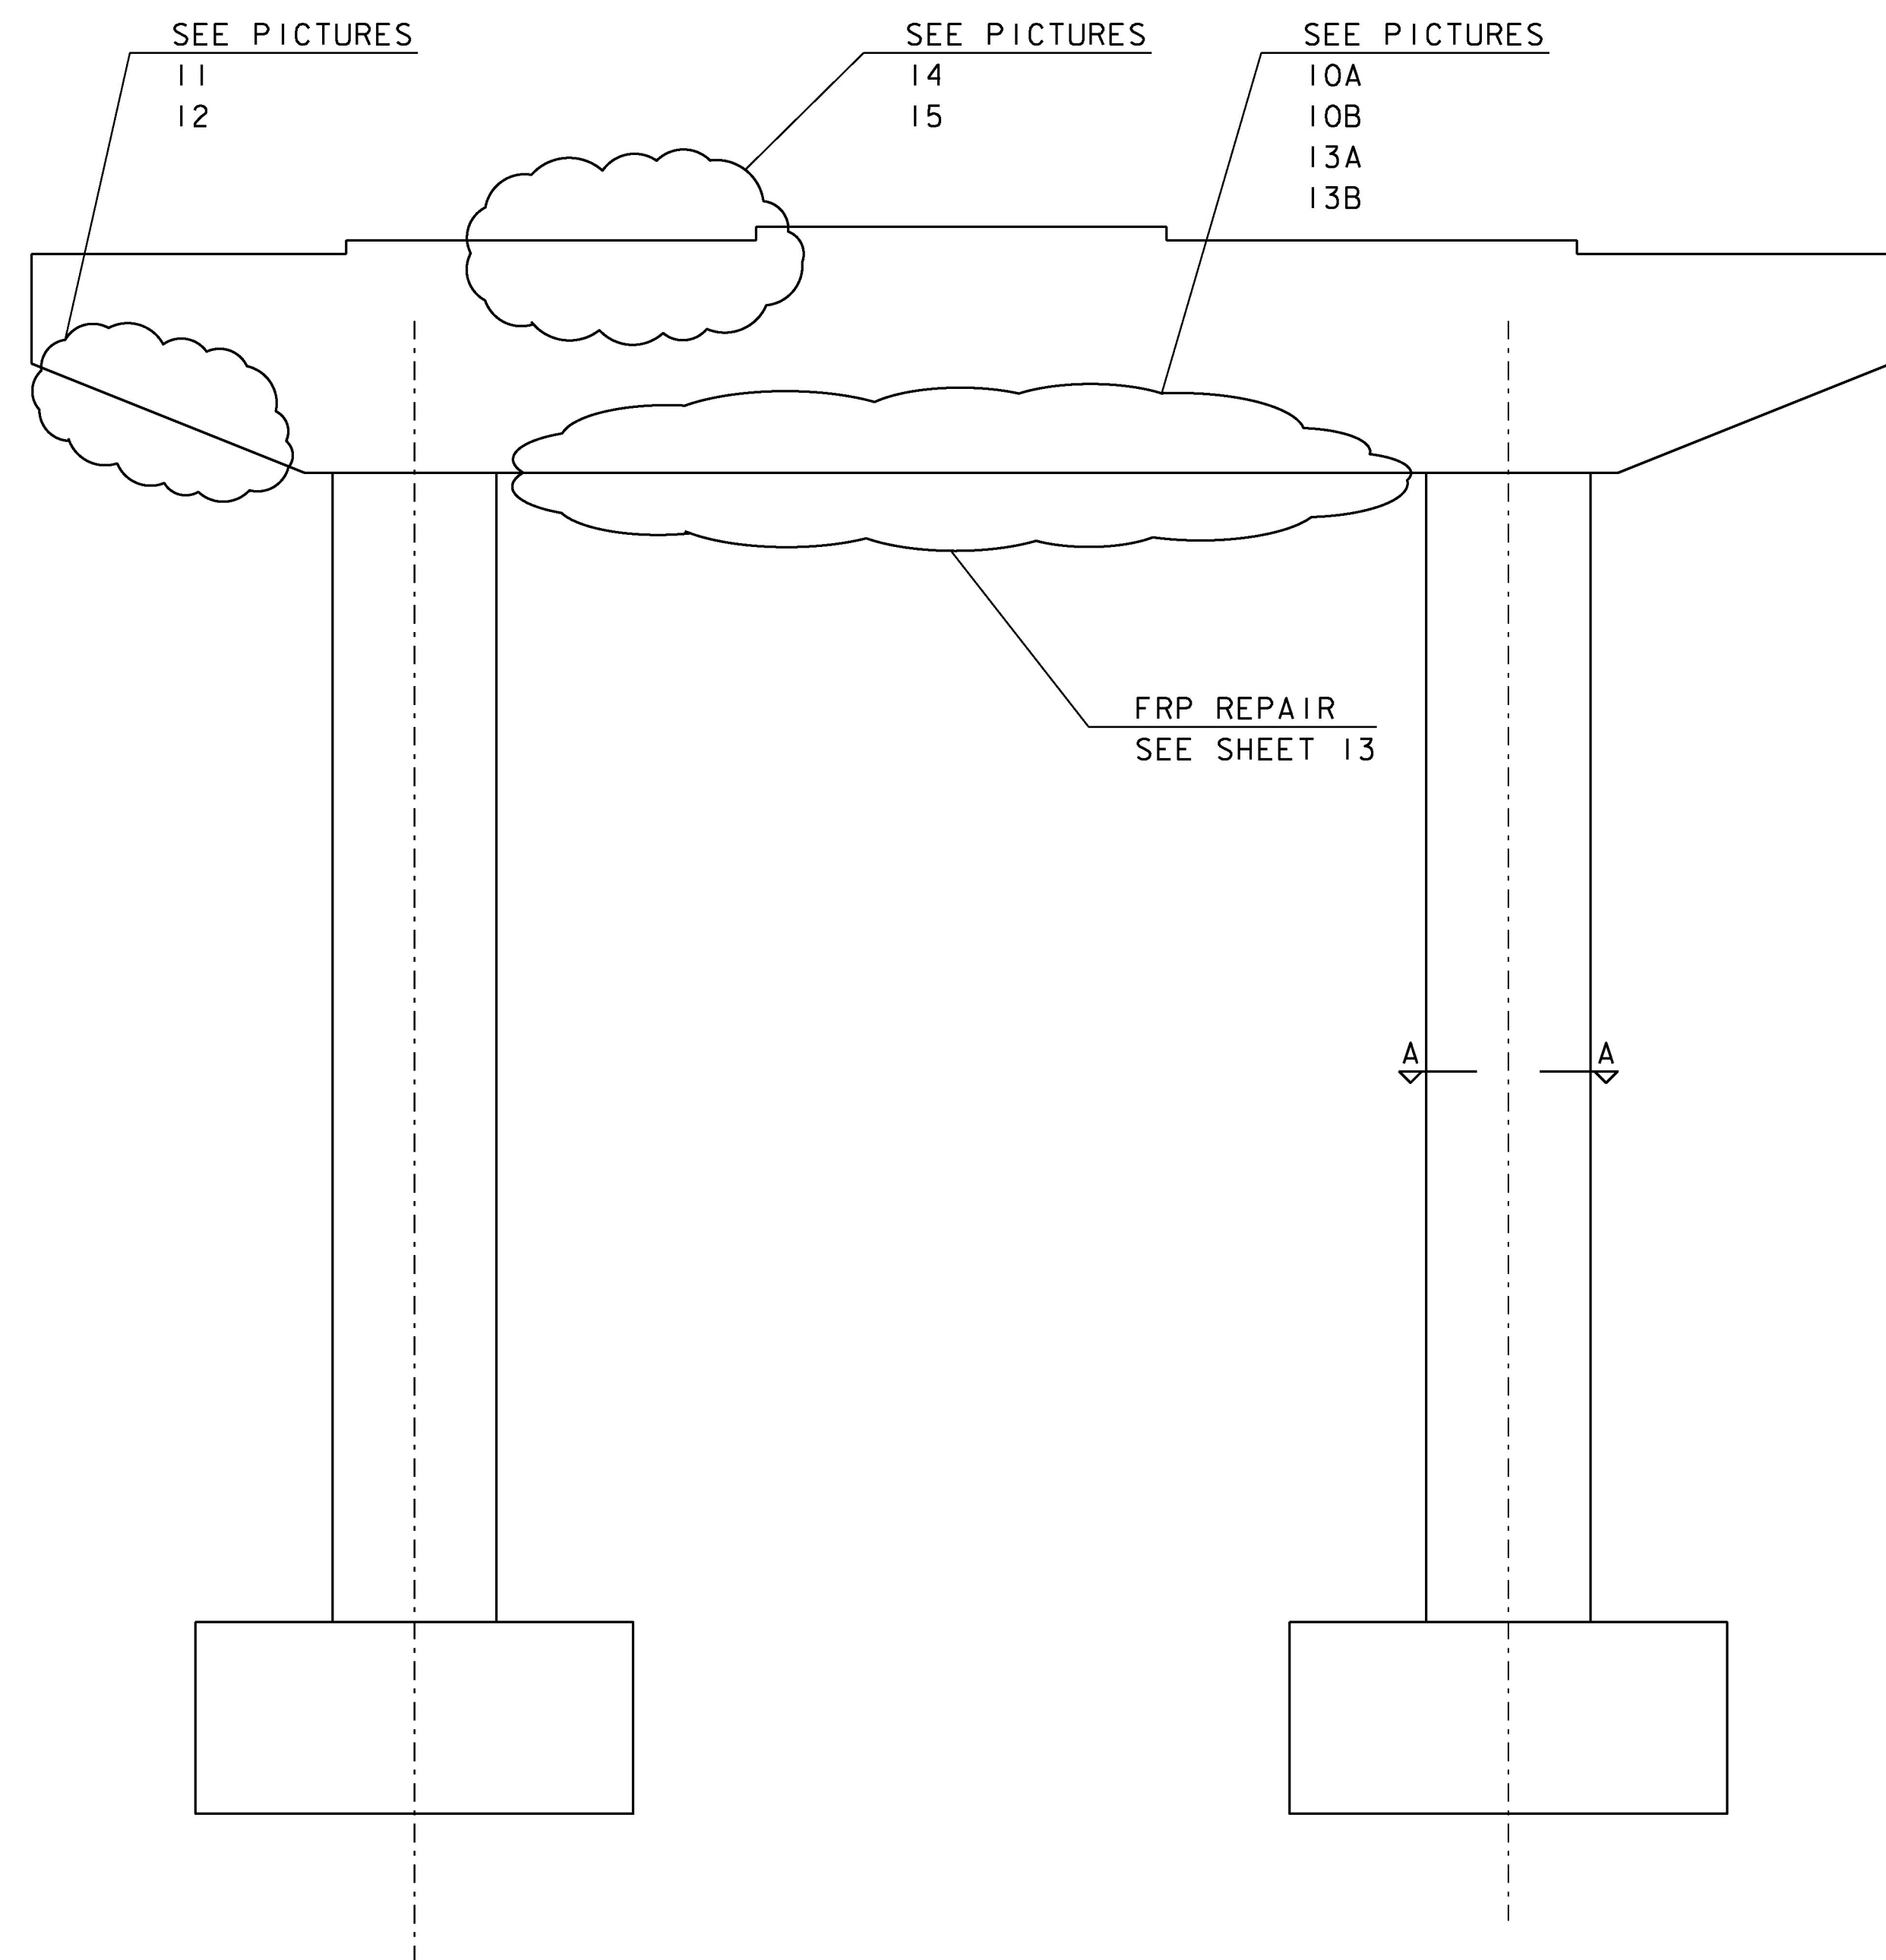

ELEVATION  
SCALE 3/8" = 1'-0"

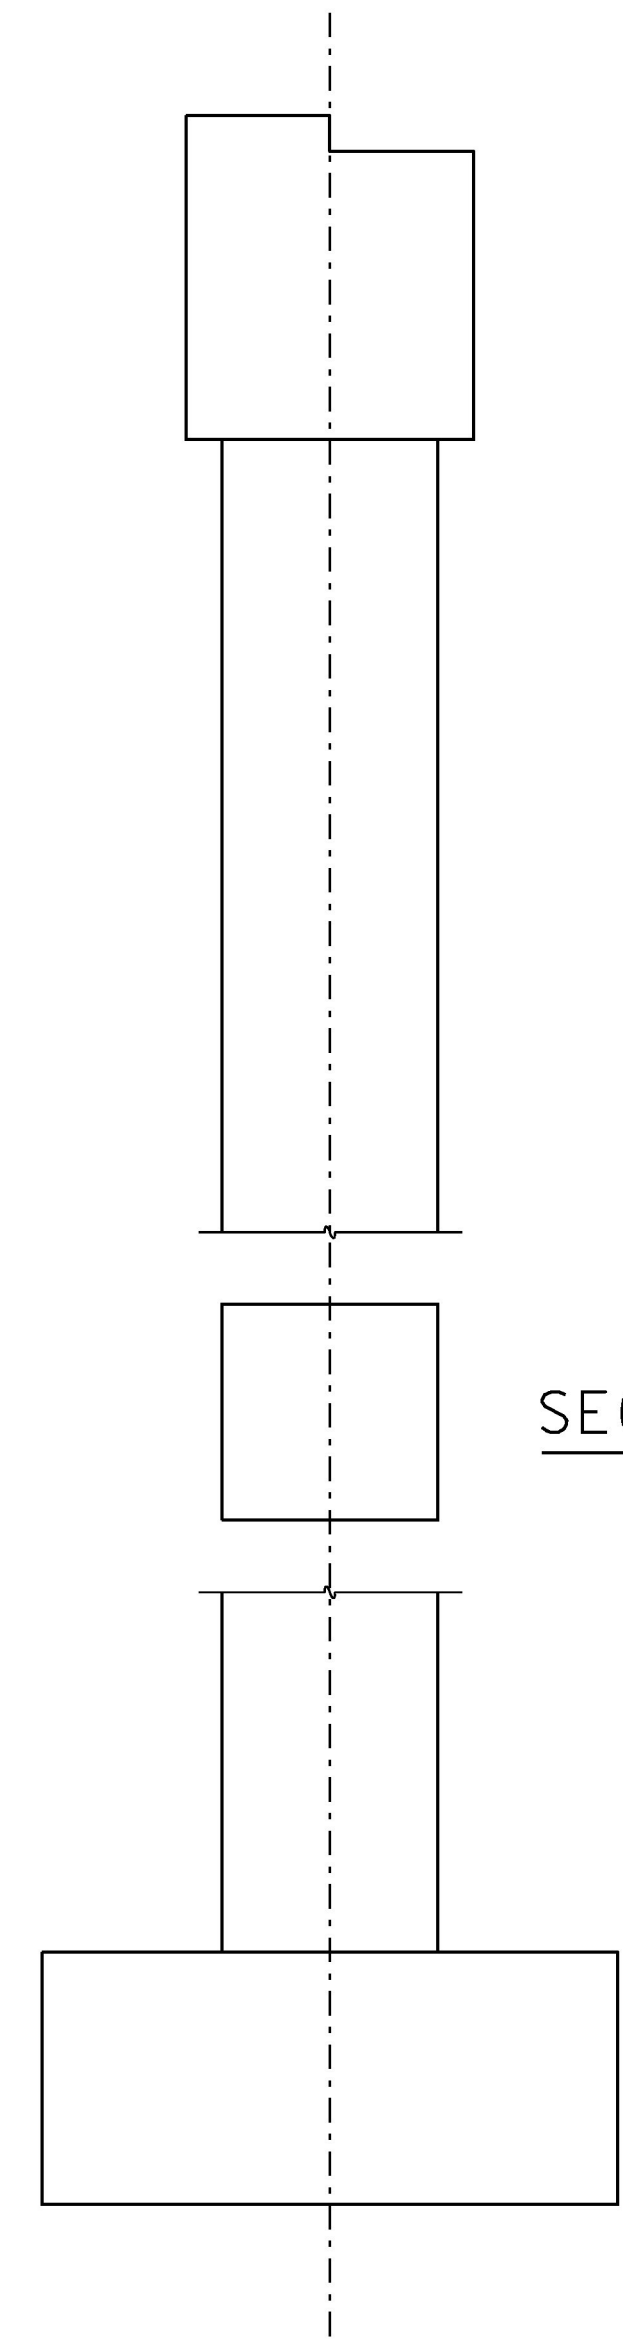

TYPICAL SECTION  
SCALE 3/8" = 1'-0"

SUBSTRUCTURE NOTES

IT IS ANTICIPATED THAT 30% OF THE SUBSTRUCTURE WILL REQUIRE A CLASS I SUBSTRUCTURE REPAIR; WHILE 10% WILL REQUIRE A CLASS II SUBSTRUCTURE REPAIR. THE ENGINEER WILL DETERMINE THE LEVEL OF REPAIR NEEDED.

THE PICTURES REPRESENT THE EXISTING CONDITION OF THE SUBSTRUCTURES BUT DO NOT SHOW ALL THE AFFECTED AREAS.



PICTURE 10A



PICTURE 10B



PICTURE 11



PICTURE 12



PICTURE 13A



PICTURE 13B




PICTURE 14



PICTURE 15

NOTE:  
FOR MORE DETAILED INFORMATION VIEW THE  
REFERENCE PLANS.

PROJECT NAME:	SWANTON	FILE NAME:	sl2a276sub.dgn	PLOT DATE:	01-APR-2013
PROJECT NUMBER:	IM 089-3(70)	PROJECT LEADER:	C. CARLSON	DRAWN BY:	DZENAN K.
		DESIGNED BY:	H. SALLS	CHECKED BY:	H. SALLS
		BRIDGE 98 SOUTH - PIERS NO. 3 & 4		SHEET	12 OF 31

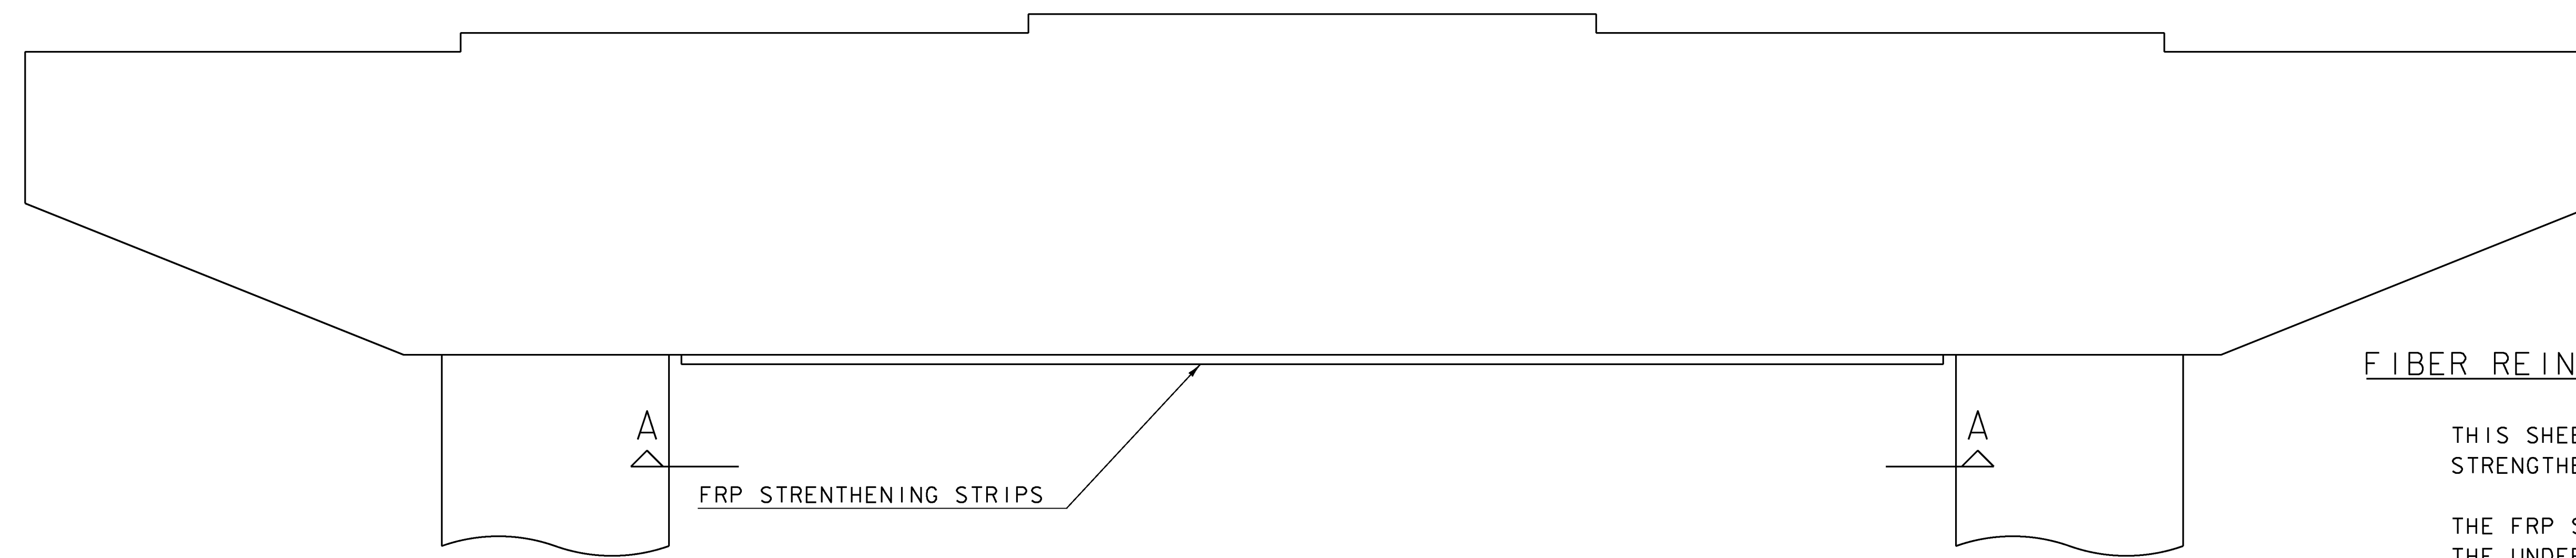

FRP STRENGTHENING STRIPS


ELEVATION

FIBER REINFORCED POLYMER (FRP) NOTES

THIS SHEET SHOWS THE LAYOUT OF THE FRP STRENGTHENING STRIPS AND BOLT PATTERN.

THE FRP STRIPS ARE TO BE ATTACHED TO THE UNDERSIDE OF THE PIER CAPS ON BRIDGES 98N AND 98S AS SHOWN.

THE FRP STRIPS ARE TO BE ANCHORED IN PLACE WITH STAINLESS STEEL WEDGE ANCHOR. DIAMETER, LENGTH AND STRENGTH ARE TO BE DETERMINED BY THE MANUFACTURER OF THE FRP STRIPS. FOR MORE INFORMATION ON THE FRP STRIPS SEE THE SPECIAL PROVISIONS.

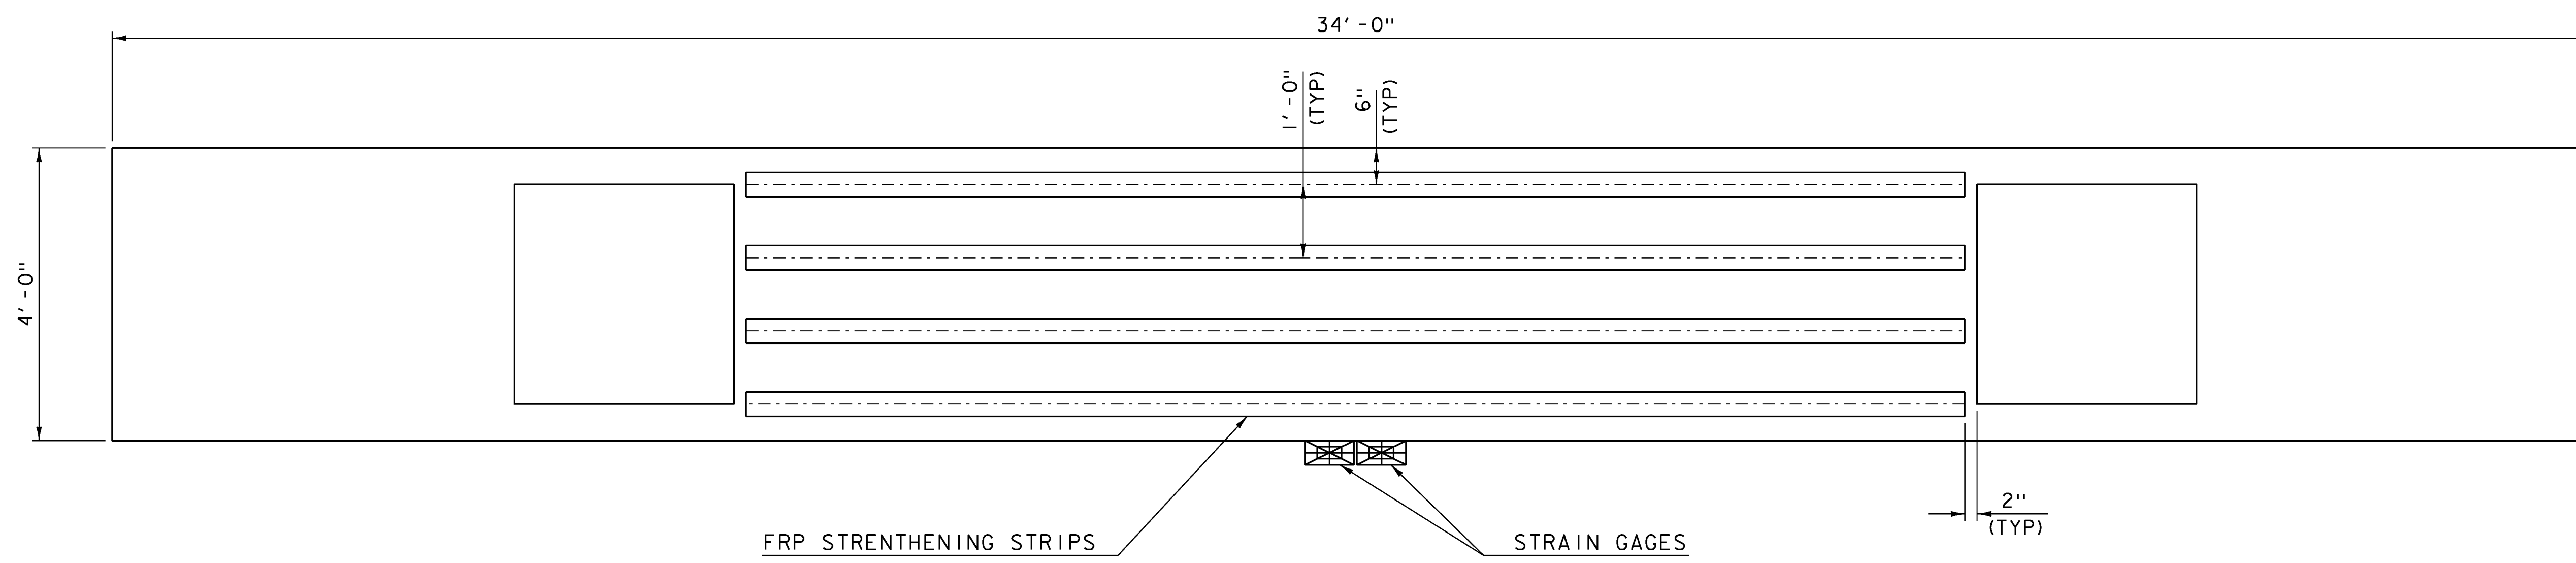


FRP STRENGTHENING STRIPS

STRAIN GAGES

PLAN

SCALE 3/4" = 1'-0"

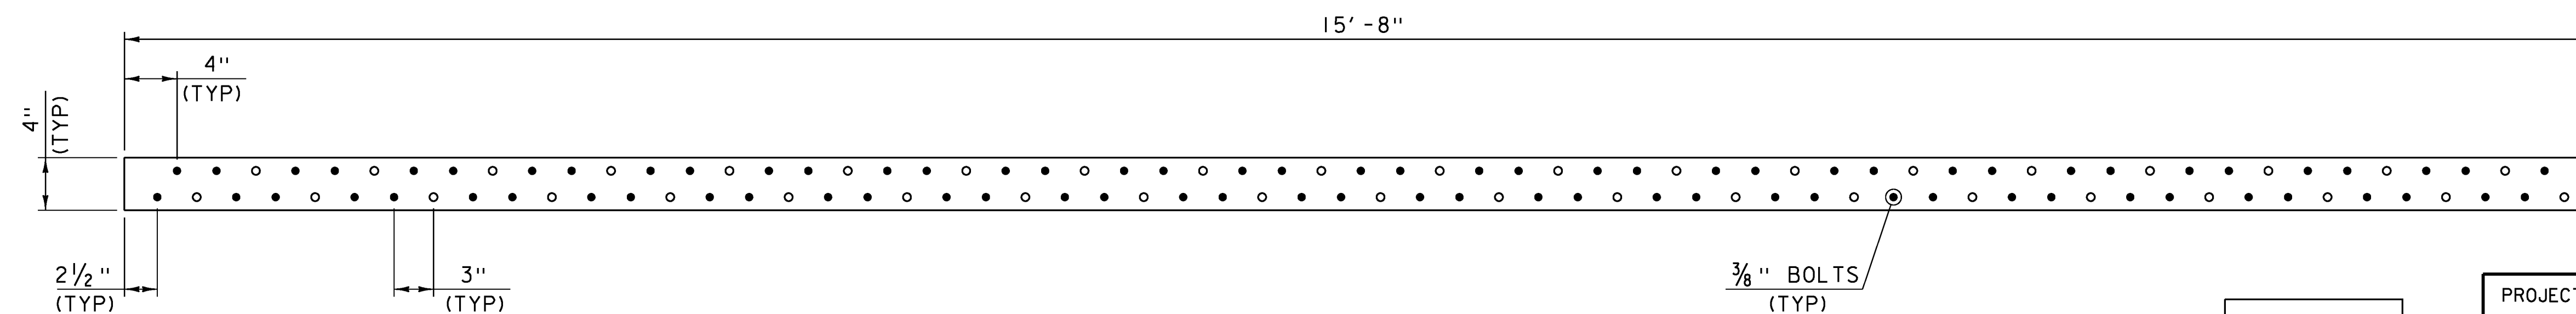

SECTION A-A

SCALE 3/4" = 1'-0"

3/8" BOLTS (TYP)

- KEY
- BOLT
  - NO BOLT

PROJECT NAME: SWANTON  
PROJECT NUMBER: IM 089-3(70)

FILE NAME: sl2a276sub.dgn  
PROJECT LEADER: C. CARLSON  
DESIGNED BY: H. SALLS  
SUBSTRUCTURE DETAILS

PLOT DATE: 19-MAR-2013  
DRAWN BY: DZENAN K.  
CHECKED BY: H. SALLS  
SHEET 13 OF 31

DRAWING NOT TO SCALE UNLESS NOTED OTHERWISE

SWANTON - Highgate I-89-3(32)

INDEX OF SHEETS

Table with 2 columns: SHEET NO. and TITLE PAGE. Lists sheets 1 through 133 with their respective titles, including typical cross sections, alignment data, and bridge details.

Table with 2 columns: SHEET NO. and TITLE PAGE. Lists sheets 134 through 246 with their respective titles, including channel sections, plan elevations, and preliminary information sheets.

STATE OF VERMONT DEPARTMENT OF HIGHWAYS

PROPOSED IMPROVEMENT

TOWNS OF SWANTON & HIGHGATE COUNTY OF FRANKLIN ST. ALBANS, VT - PHILIPSBURG, QUE ROAD PROJECT I 89-3 (32)

Table with 2 columns: Description and Value. Lists project statistics such as 'Beginning of a point 1.624 miles south of the Swanton-Highgate Town Line' and 'Length of Roadway 24,328.22 Feet'.

Table with 2 columns: PROJECT NAME & NUMBER and TYPE - STAGE I. Lists materials and construction details like 'SUB-BASE OF GRAVEL (MOD) - LAFRANCE QUARRY' and 'REINFORCED CONCRETE PIPE 5' P.C.C.C.I. & GUARD RAIL - ST. ALBANS, VT'.

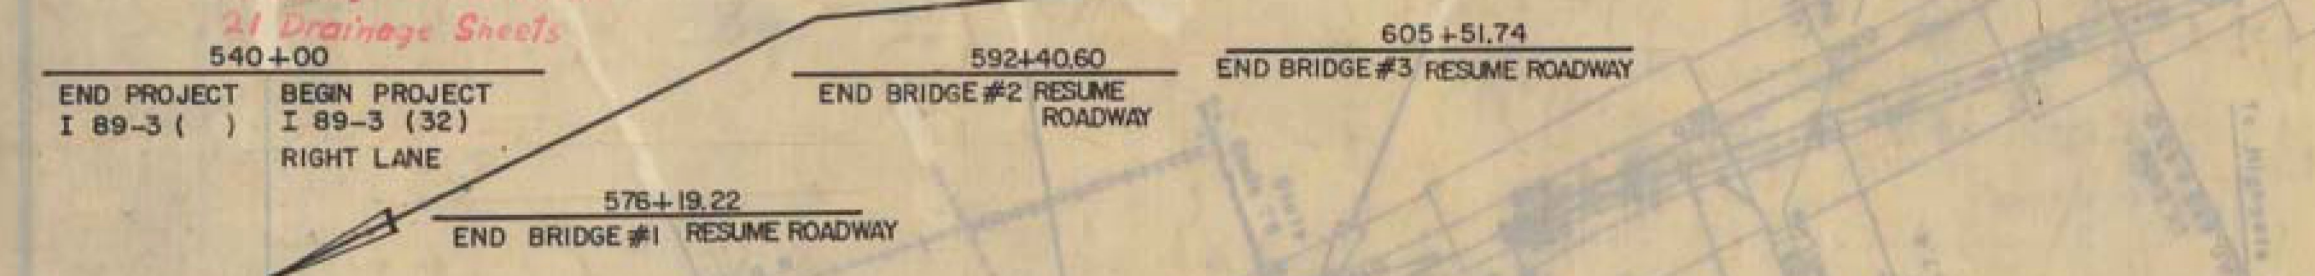


Table with 3 columns: ADT, N. OF INTERCH., and S. OF INTERCH. Lists traffic volume data for different years (1965, 1985, 1995) and truck percentages.

Table with 2 columns: CONTRACTOR and CONTRACT. Lists 'METAL CULVERT PIPE - NORTHEASTERN CULVERT CO.' and contract details including dates and names.

1688A



SWANTON-HIGHGATE I 89-3(32) CONTRACTOR - CALEDONIA SAND & GRAVEL CO. INC. - ST. JOHNSBURY, VT. MILLER CONSTRUCTION INC. - WINDSOR, VT.



LEGEND, APPROVED, and ASST. CHIEF ENGINEER signatures and dates (11/1/63, 11/4/63, 11/6/63, 11/4/63, 11/5/63).

NOTE: ANY FURTHER INFORMATION CONCERNING FINAL QUANTITIES, AMOUNTS OR OTHER DETAILS RELATIVE TO THIS PROJECT MAY BE FOUND IN EITHER THE FIELD BOOKS OR THE ESTIMATE FILE.

SWANTON IM 089-3(70) SHEET 14 OF 31 FOR REFERENCE ONLY

137

137

**INDEX OF SHEETS**

SHEET NO.	TITLE
1	TYPICAL IMPROVEMENT (INTERSTATE)
2	TYPICAL PAVEMENT
3	TYPICAL CROSS SECTIONS (RAMPS)
4	TYPICAL CROSS SECTIONS (LA. ROAD #1)
5-7	ALIGNMENT DATA SHEETS
8	TEMPORARY APPROACH TRANSITION SHEET
9-10	QUANTITY SHEETS (ITEMS)
11-12	QUANTITY SHEETS (ITEMS)
13-16	GRADE SHEETS
17-22	EARTHWORK SHEETS
23	BLANK
24-70	PLAN AND PROFILE SHEET
71	BLANK
72	BLANK
73	A-61 (DRILLING AND BLASTING OF SOLID ROCK, SUBGRADE)
74	B-1 (BANKING TABLES)
75	B-5 (TYPICAL SLOPE GRADING)
76	B-6 (MUCK EXCAVATION)
77	BLANK
78	B-15 (ENTRANCE AND EXIT TERMINALS)
79	BLANK
80	B-17 (DETAILS OF U-TURNS)
81	D-2 (UNDERDRAM AND HEADWALLS)
82	D-3 (LAITE MATINGS AND GUTTERS)
83	D-4 (ELBOWS AND FLUSHING BASINS)
84	BLANK
85	D-8 (DROP INLETS)
86	D-10 (DROP INLET TOPS)
87	D-11 (DROP INLET GRATES AND COVERS)
88	D-16 (PRECAST REINFORCED CONCRETE CURB DROP INLETS)
89	E-1 (BARRICADES, SIGNS AND LIGHTS) ROADWAY
90	E-2 (BARRICADES, SIGNS AND LIGHTS) BRIDGE
91	E-31 (CONSTRUCTION IDENTIFICATION SIGNS)
92	E-3 (THREE CABLE GUARD RAIL WITH STEEL POSTS)
93	E-4 (PLANK GUARD RAIL)
94	J-1 (BOUNDARY MARKERS)
95	J-4 (FIELD OFFICE)
96	BLANK
97	SB-20-60
98	SB-21-56
99-102	SB-PS-30-62
103-104	SB-55-62
105	SB-30-62
106-114	SCB-D1 THROUGH D6-62
115	BLANK
116	6" x 8" x 8" R.C. BOX (TEAM PASS STA 554+00)
117	PLAN SECTION-DETAILS
118	REINFORCING STEEL DETAILS
119	INTERSTATE BRIDGE OVER MISSISSQUOI RIVER
120	BR 200 SUPERSTRUCTURE PLAN AND ELEVATION
121	BR 201 BRIDGE QUANTITY SHEET
122	BR 202 PRELIMINARY INFORMATION SHEET
123	BR 203 BORINGS
124	BR 204 FRAMING AND RAILING PLAN
125	BR 205 DETAILS OF ABUTMENT NO. 1



SHEET NO.	TITLE
125	BR 206 DETAILS OF ABUTMENT NO. 2
126	BR 207 DETAILS OF PIER NO. 1
127	BR 208 DETAILS OF PIER NO. 2
128	BR 209 APPROACH SLAB NO. 1 (STD STR. SB-AS-62)
129	BR 210 APPROACH SLAB NO. 2 (STD STR. SB-AS-62)
130	BR 211 REINFORCING STEEL SCHEDULE
130-134	BR 212-216 CHANNEL SECTIONS
135	AB INTERSTATE BRIDGE OVER ST. J. AND L.C. RR.
136	BR 301 PLAN ELEVATION
137	BR 302 BRIDGE QUANTITY SHEET
138	BR 303 PRELIMINARY INFORMATION SHEET
139	BR 304 BORING LOGS
140	BR 305 APPROACH SLABS NO. 3 AND NO. 4
141	BR 306 ABUTMENTS NO. 3 AND NO. 4
142	BR 307 PIERS NO. 3 AND NO. 4
143	BR 308 REINFORCING STEEL SCHEDULE
144	AB INTERSTATE BRIDGE OVER VT. RTE 78
145	BR 400 PRELIMINARY INFORMATION SHEET
146	BR 401 PLAN AND ELEVATION
147	BR 402 BORINGS
148	BR 403 DETAILS OF ABUTMENTS (NORTH AND SOUTH)
149	BR 404 DETAILS OF PIERS NO. 1 AND NO. 2
150	BR 405 REINFORCING STEEL SCHEDULE
151	BR 406 APPROACH SLAB NO. 1 (STD STR. SB-AS-62)
152	BR 407 APPROACH SLAB NO. 2 (STD STR. SB-AS-62)
153	BR 408 OVER INTERSTATE BR
154	BR 500 PLAN AND ELEVATION
155	BR 501 PRELIMINARY INFORMATION SHEET
156	BR 502 BORINGS
157	BR 503 DETAILS OF ABUTMENT NO. 1
158	BR 504 DETAILS OF ABUTMENT NO. 2
159	BLANK
160	REINFORCING STEEL SCHEDULE
161	BLANK
162	CROSS SECTIONS

STATE OF VERMONT  
DEPARTMENT OF HIGHWAYS  
**Proposed Improvement**

INTERSTATE PROJECT  
RIGHT LANE CONSTRUCTION - STAGE I  
**TOWNS OF SWANTON & HIGHGATE**  
COUNTY OF FRANKLIN  
ST. ALBANS, VT - PHILIPSBURG, QUE ROAD  
PROJECT I 89-3 (32)




Dated February 27, 1964  
Adelino Sandy Gravel Co. Inc.  
Contractor  
Walter H. Conroy  
Contractor  
Missouri St. Stevedore  
By Order of Commissioner of Highways

Beginning at a point 1.824 miles southerly of the Swanton-Highgate Town Line and extending northerly 4.736 miles.  
Length of Roadway 24,328.22 Feet = 4.608 Miles  
Length of Bridge 679.18 Feet = 0.128 Miles  
Length of Project 25,007.40 Feet = 4.736 Miles

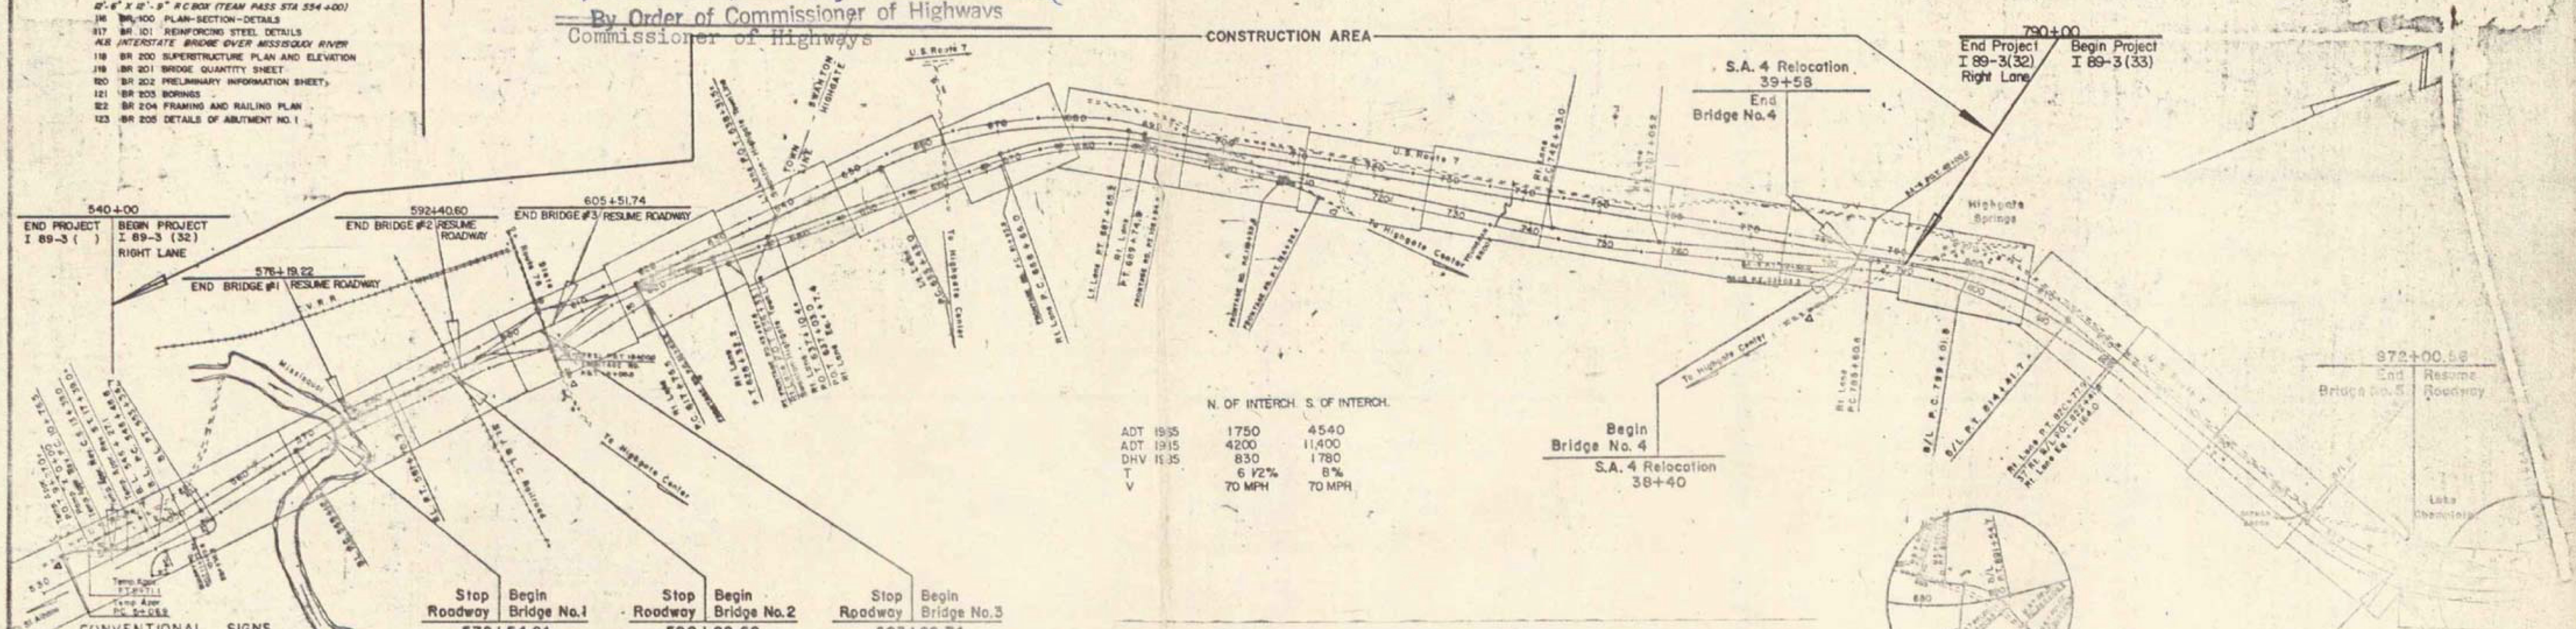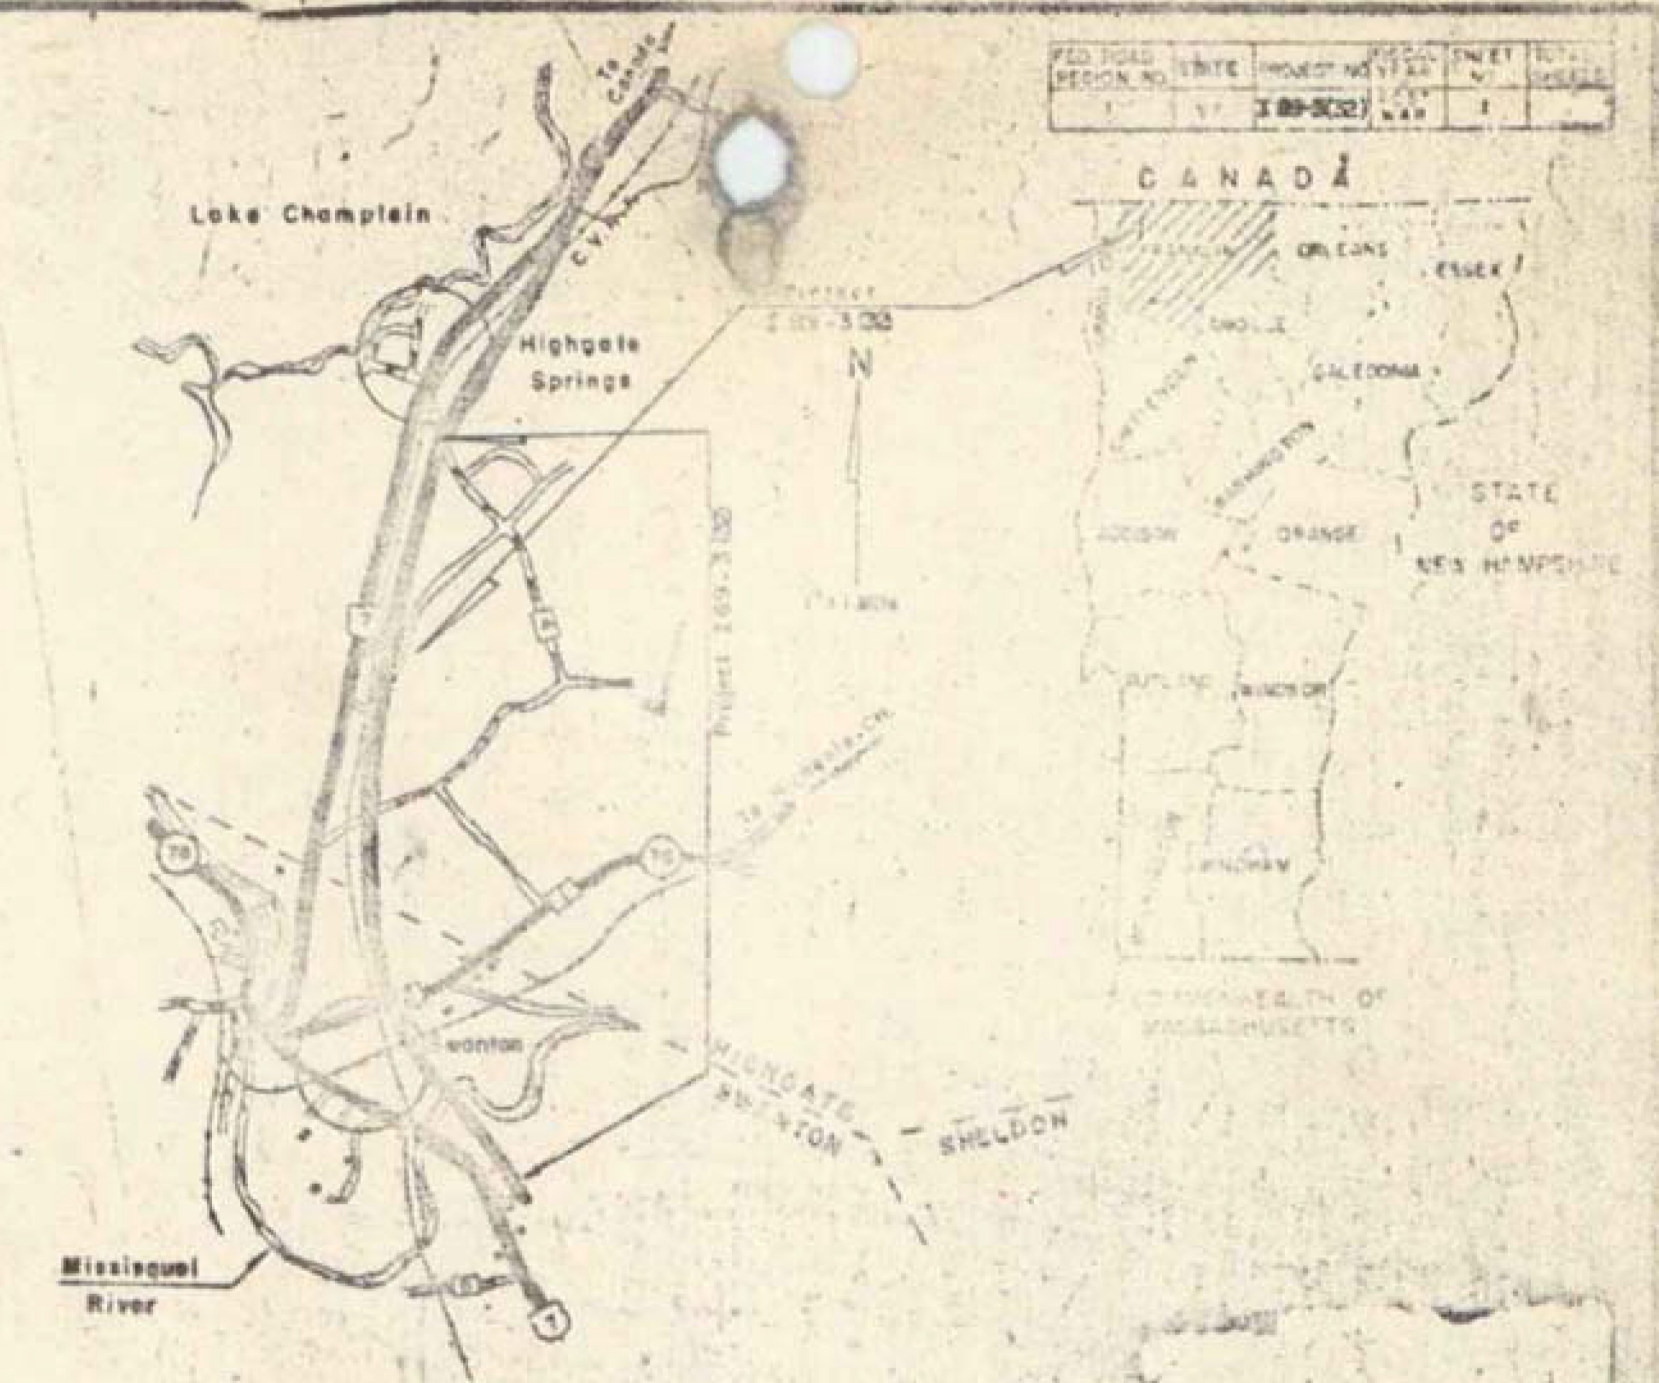

N. OF INTERCH. S. OF INTERCH.

ADT 1935	1750	4540
ADT 1945	4200	11400
DHV 1935	830	1780
T	6 1/2%	8%
V	70 MPH	70 MPH

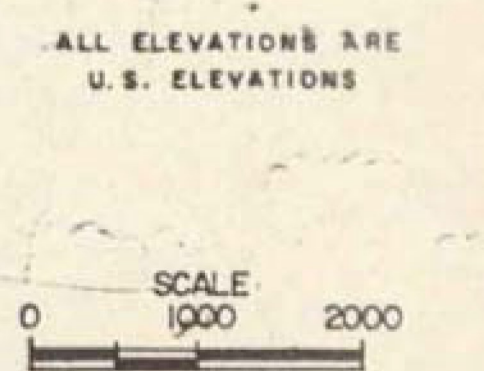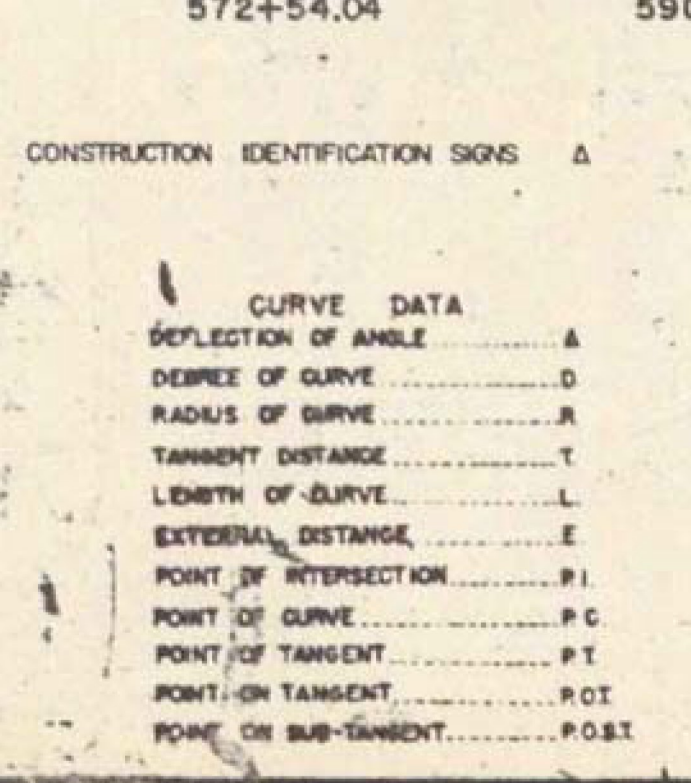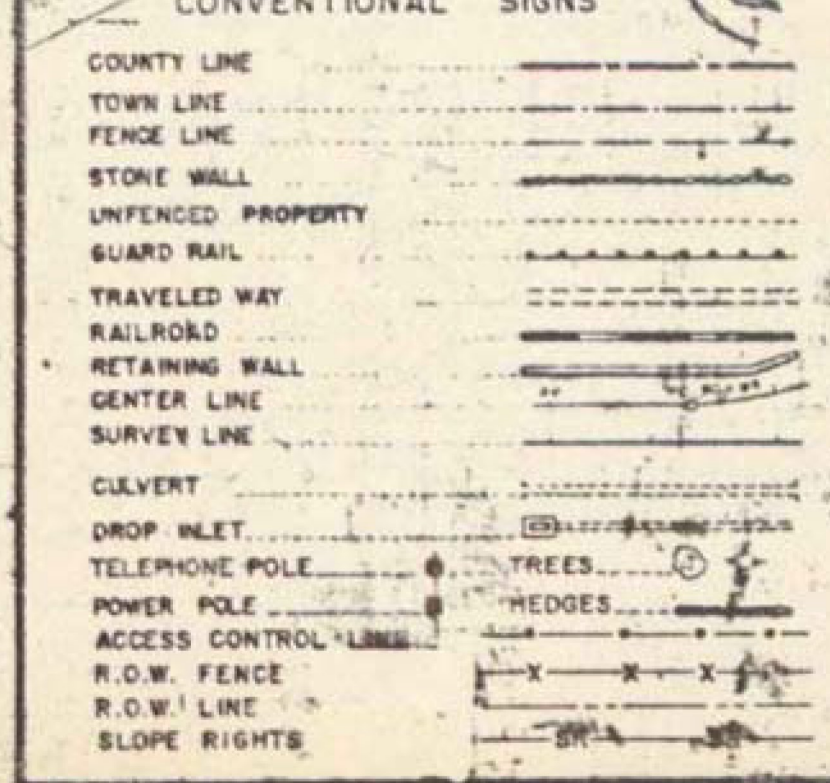

THESE PLANS HAVE BEEN REDUCED PHOTOGRAPHICALLY TO APPROXIMATELY 1/2 SCALE


WEBSTER - MARTIN, INC.  
E. U. Martin  
Submitted March 5, 1962  
Date

THESE PLANS ARE SUBJECT TO SUCH REVISIONS AS MAY BE REQUIRED BY THE BUREAU OF PUBLIC ROADS OR THE COMMISSIONER OF HIGHWAYS.  
CONSTRUCTION IS TO BE CARRIED ON IN ACCORDANCE WITH THE PLANS AND THE STANDARD SPECIFICATIONS FOR HIGHWAY BRIDGE CONSTRUCTION OF JANUARY 1956, SUBMITTED TO THE BUREAU OF PUBLIC ROADS FOR APPROVAL ON 10/15/56, INCLUDING ALL SUBSEQUENT APPROVED REVISIONS AND SUCH REVISED SPECIFICATIONS AND SPECIAL PROVISIONS AS ARE SUBMITTED WITH THE PLANS.

**SWANTON**  
IM 089-3(70)  
SHEET 15 OF 31  
FOR REFERENCE ONLY

APPROVED R.H. Arnold ASST. CHIEF ENGINEER DATE 11/7/63  
APPROVED E.W. Atkinson CHIEF ENGINEER DATE 11/4/63  
APPROVED L.M. Quinn CHIEF ENGINEER DATE 11/4/63  
APPROVED B.M. Blackwell CHIEF ENGINEER DATE 11/6/63  
APPROVED L.M. Lane CHIEF ENGINEER DATE 11/4/63  
APPROVED A.S. Bishop CHIEF ENGINEER DATE 11/5/63

PROJECT I NO. 89-3 (32)  
RIGHT LANE - STAGE I CONSTRUCTION  
SHEET 15 OF 31 SHEETS

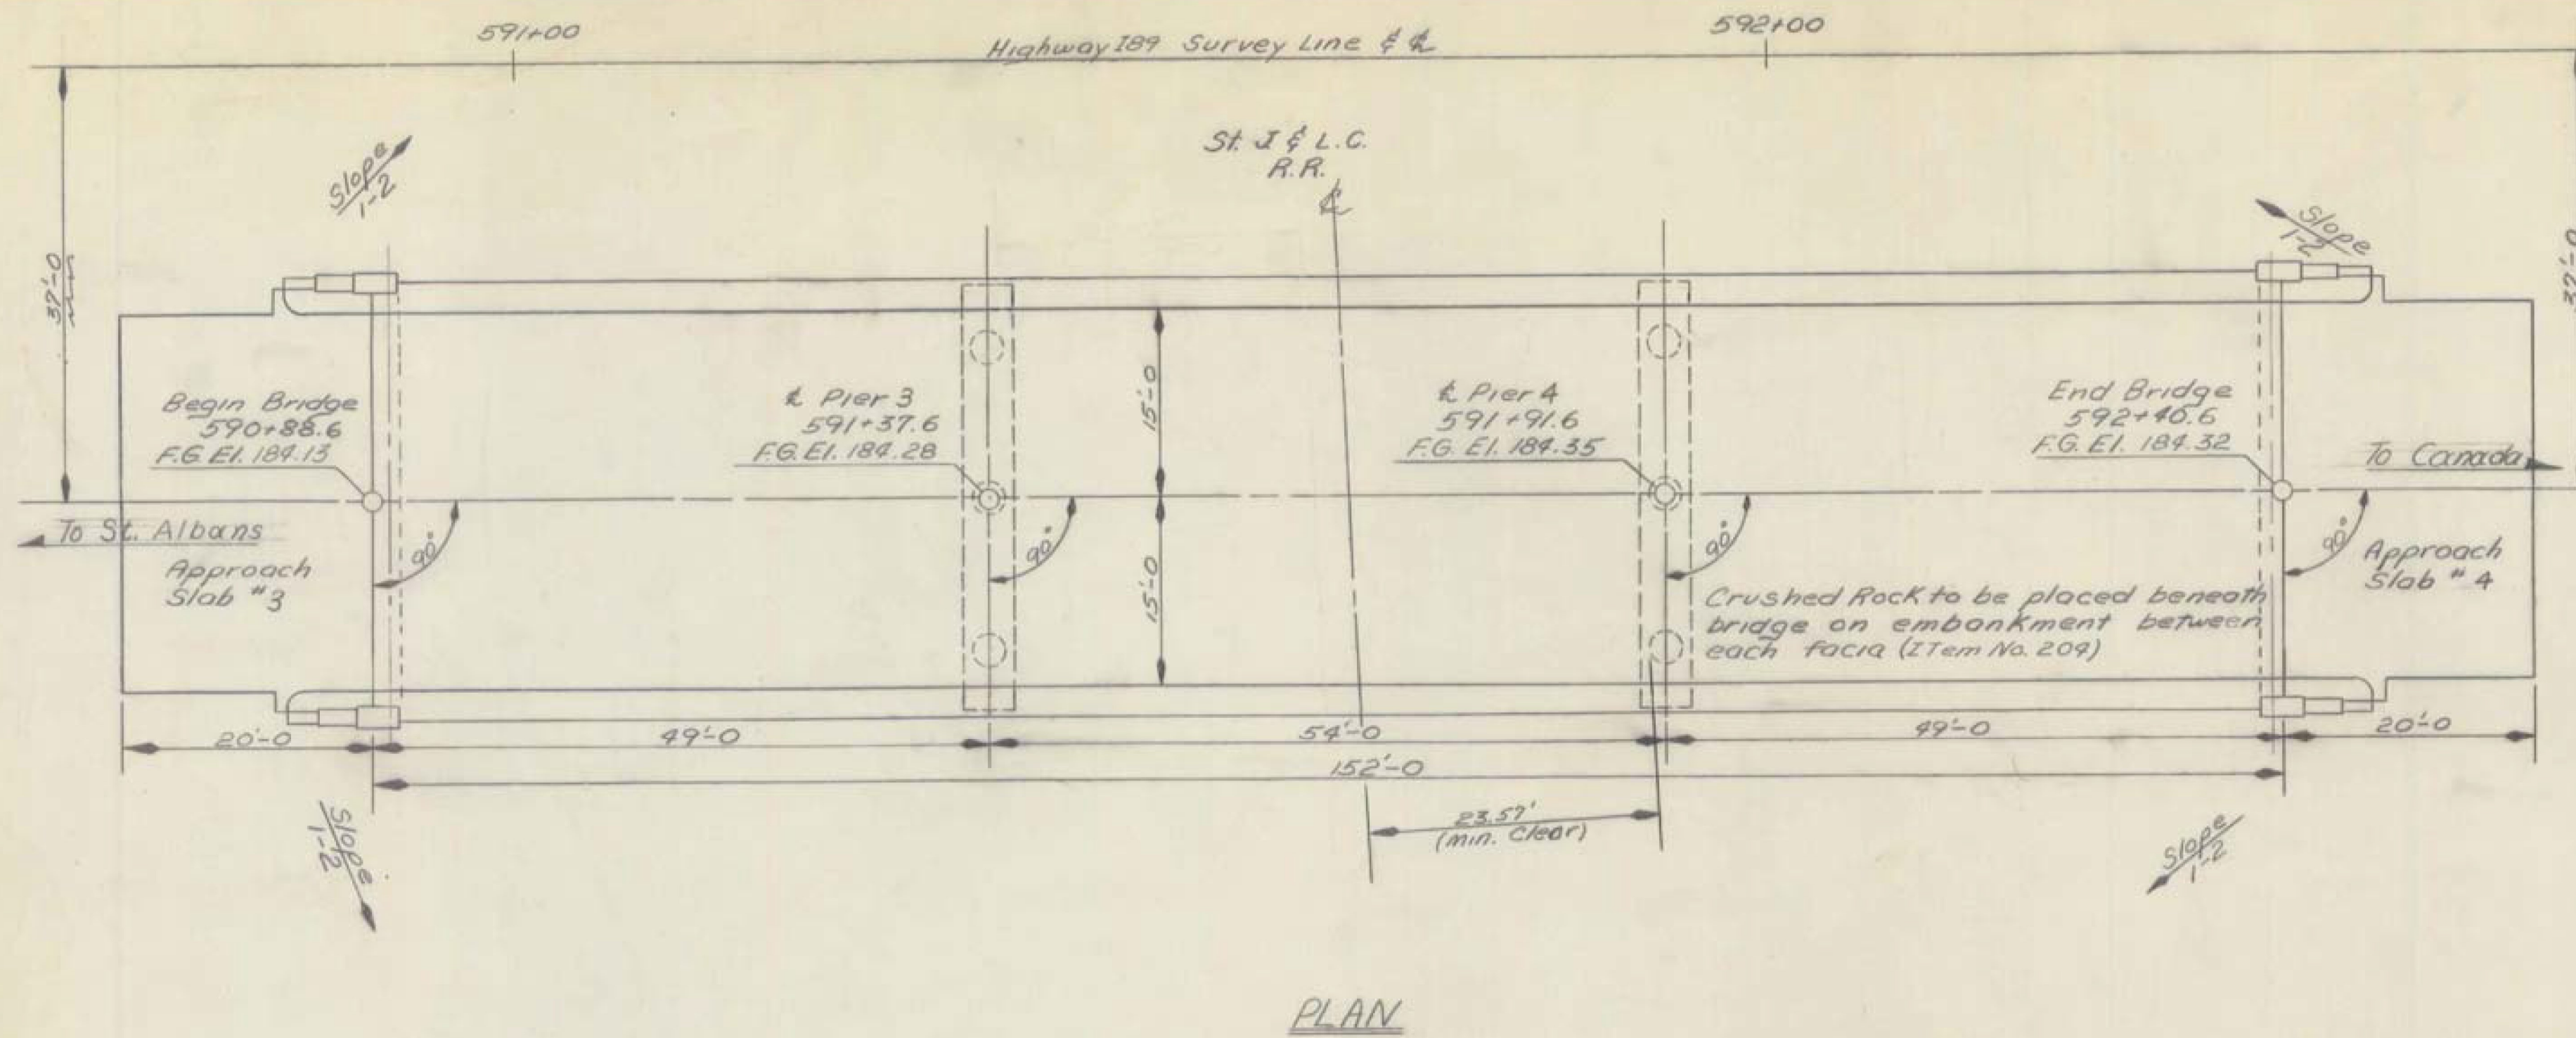


Abut. #3	Pier #3	Pier #4	Abut. #4			
179.69	179.80	179.79	179.86	179.87	179.89	1
179.92	180.07	180.07	180.19	180.15	180.11	2
180.02	180.17	180.17	180.23	180.29	180.21	3 Beam
179.92	180.07	180.07	180.14	180.15	180.11	4 NO.
179.69	179.80	179.79	179.86	179.87	179.89	5
Bearing Device Fix.		Exp. Fix.		Exp. Fix.		Exp.

Bridge Seat Elevations

- LIST OF SHEETS -
- Br. 301 Plan and Elevation
  - Br. 302 Bridge Quantity Sheet
  - Br. 303 Preliminary Information Sheet
  - Br. 304 Boring Logs
  - Br. 305 Approach Slabs #3 and #4
  - Br. 306 Abutments #3 and #4
  - Br. 307 Piers #3 and #4
  - Br. 308 Reinforcing Steel Schedule

- BRIDGE STANDARDS -
- SCB-30-62
  - SCB-D1 thru D9-62
  - SB-5G-62 Sheets #1 & #2

- GENERAL NOTES -
- Elevation datum sea level based on nearest U.S. Government Vertical Control.
  - For additional notes see SCB-D1-62.
  - For Bearing Devices see SCB-DB-62, Detail A.
  - Bridge Fencing Item 572 shall be the Galvanized Metal as indicated in detail @ on sheet 2 of 2 of standard SB-5G-62.

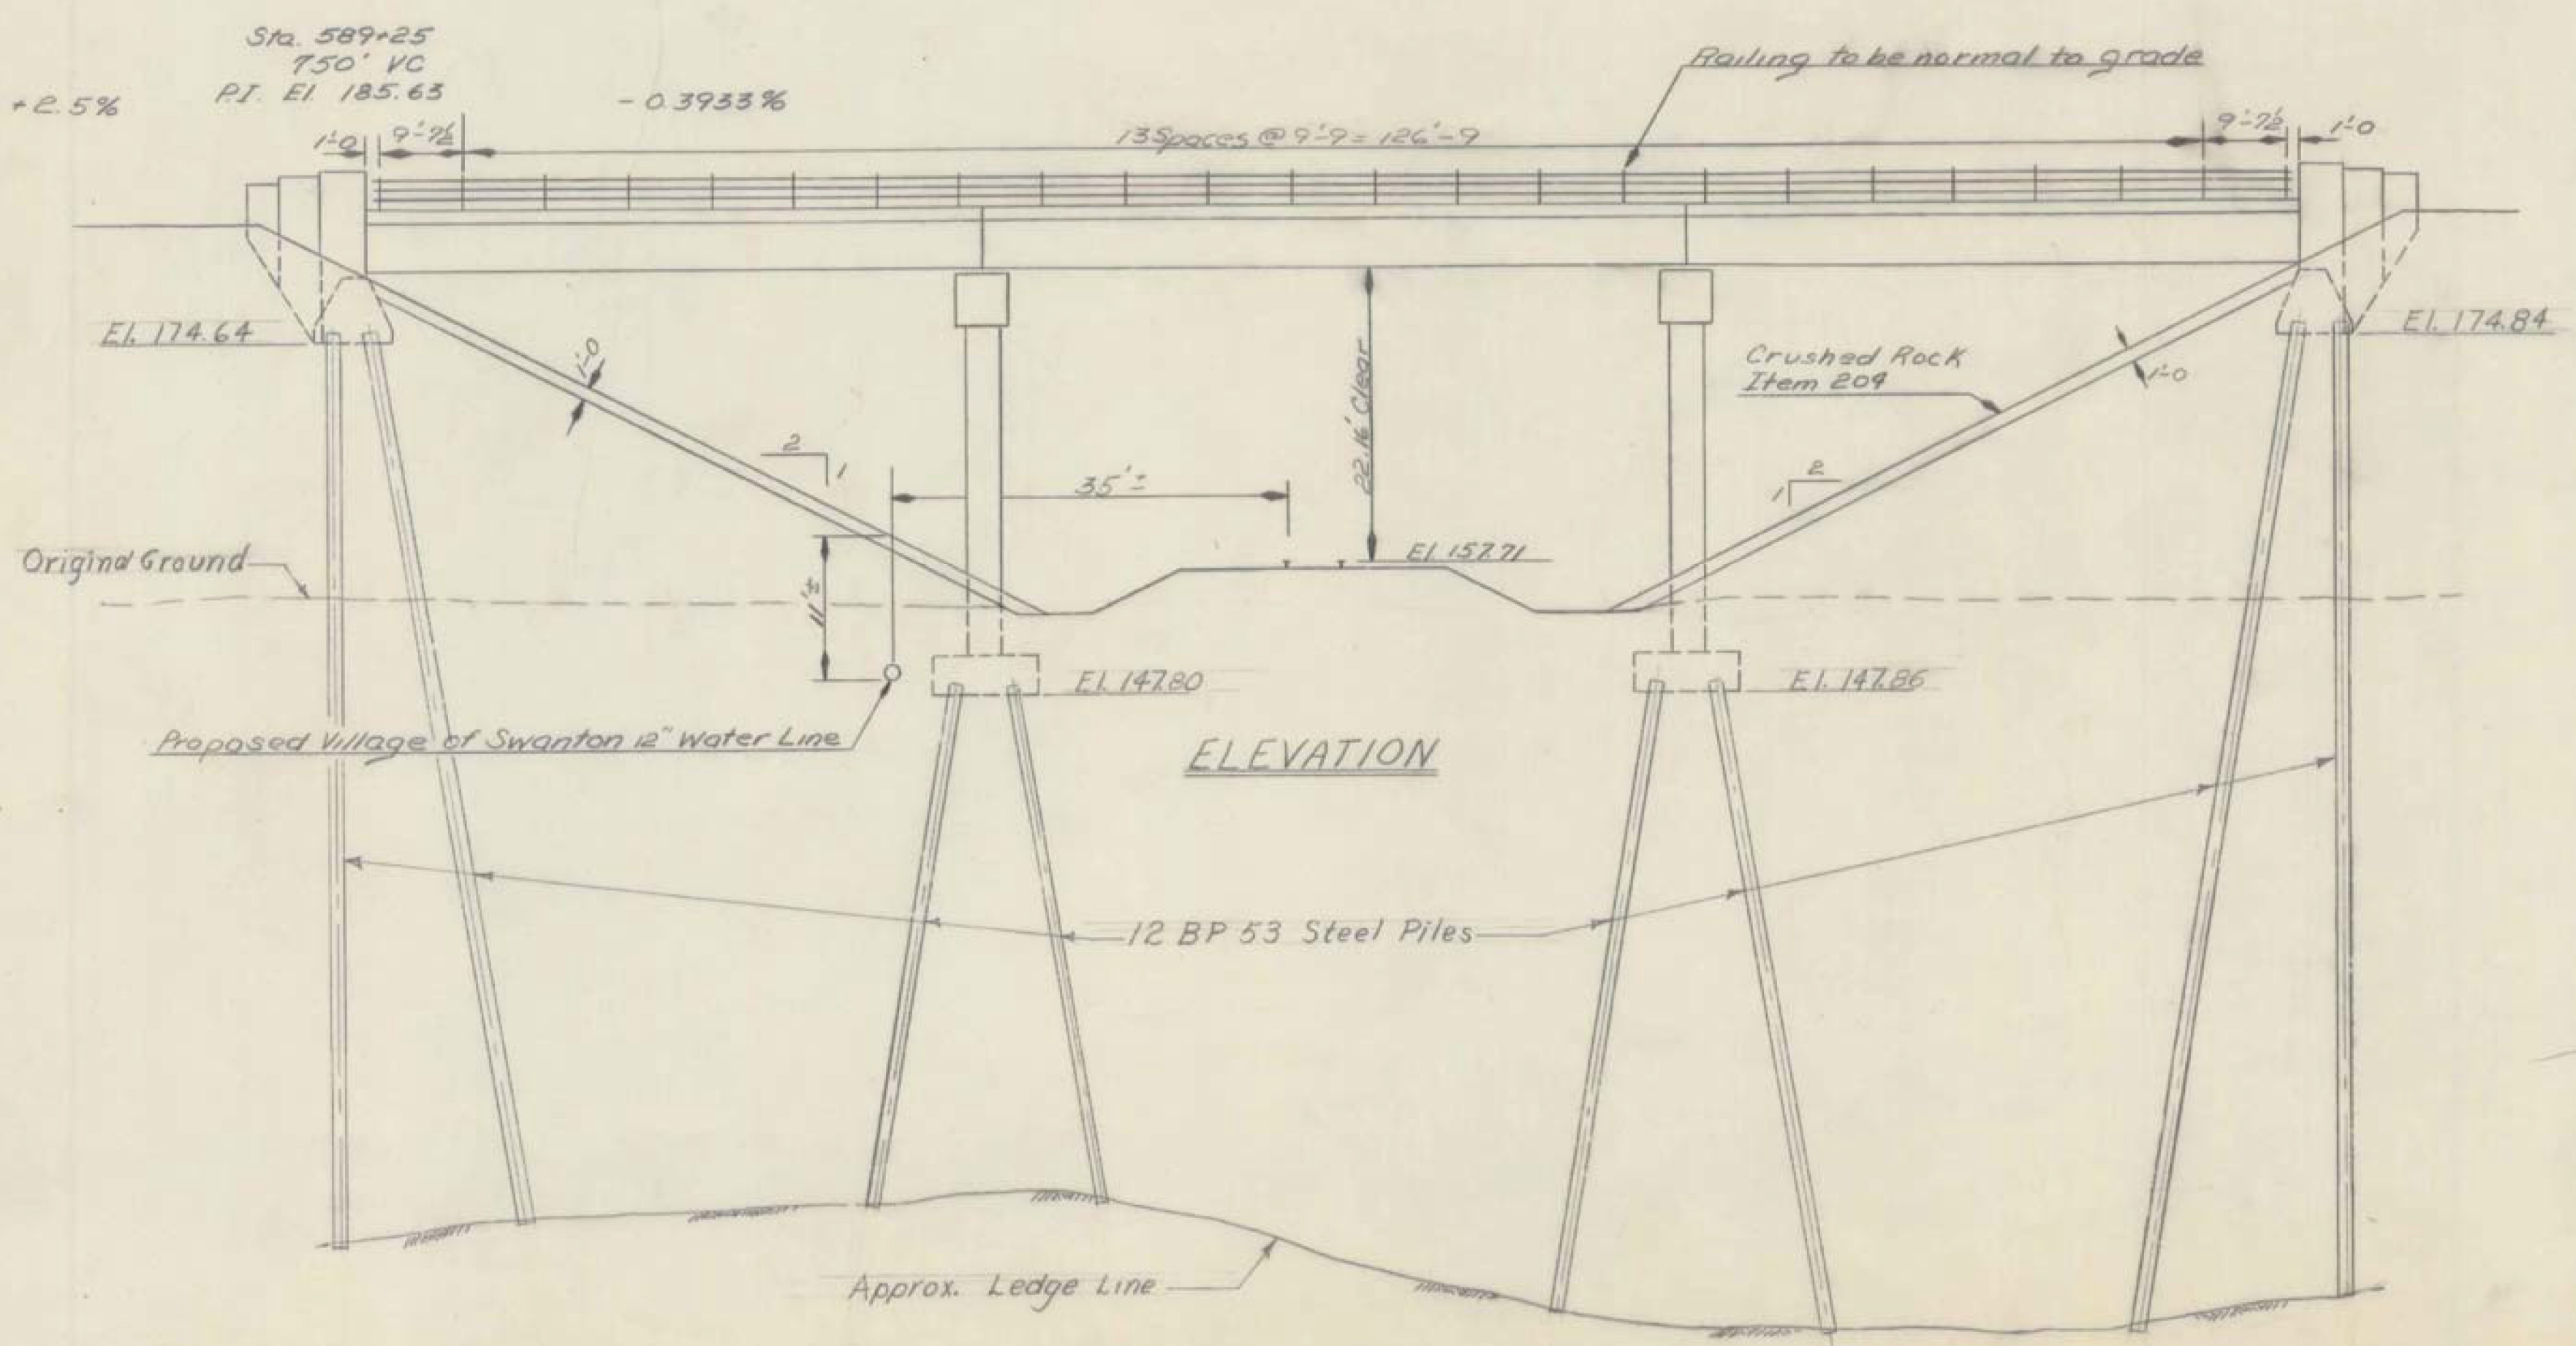

**SWANTON**  
**IM 089-3(70)**  
**SHEET 16 OF 31**  
**FOR REFERENCE**  
**ONLY**

BR. 301 OF 308

ITEM NO.	ITEM	UNIT	NET	TOTAL	FINAL
	CHAN. EXCAV. OF EARTH	C.Y.			
	CHAN. EXCAV. OF ROCK	C.Y.			
	UNCLASS. CHAN. EXCAV.	C.Y.			
	STRUCT. EXCAV.	C.Y.			
	CONC. CLASS AA (MOD.)	C.Y.			
	CONC. CLASS B (MOD.)	C.Y.			
	REINF. STEEL	LBS.			
	ASPHALTIC-ASB. COATING	S.Y.			
	TREATED TIMBER PILING	L.F.			
	SPLICES FOR STEEL PILING	EA.			
	STEEL PILING	L.F.			
	UNTREATED TIMBER PILING	L.F.			

STATE OF VERMONT  
 DEPARTMENT OF HIGHWAYS

TOWN OF SWANTON-HIGHGATE

ROAD NO. \_\_\_\_\_ BRIDGE NO. \_\_\_\_\_

NBI-89 OVER ST. J. & L.C. R.R.

PLAN AND ELEVATION

SCALE 1"=10'

SURVEYED BY \_\_\_\_\_

DRAWN BY SHS:K CHECKED BY RLO

PROJECT NO. I-89-3 (30)


SHEET 165 OF 246

Sheet 715 of 122





Elev. of B.M. = Top of Rail = 158.0 @ Sta 590+88.6

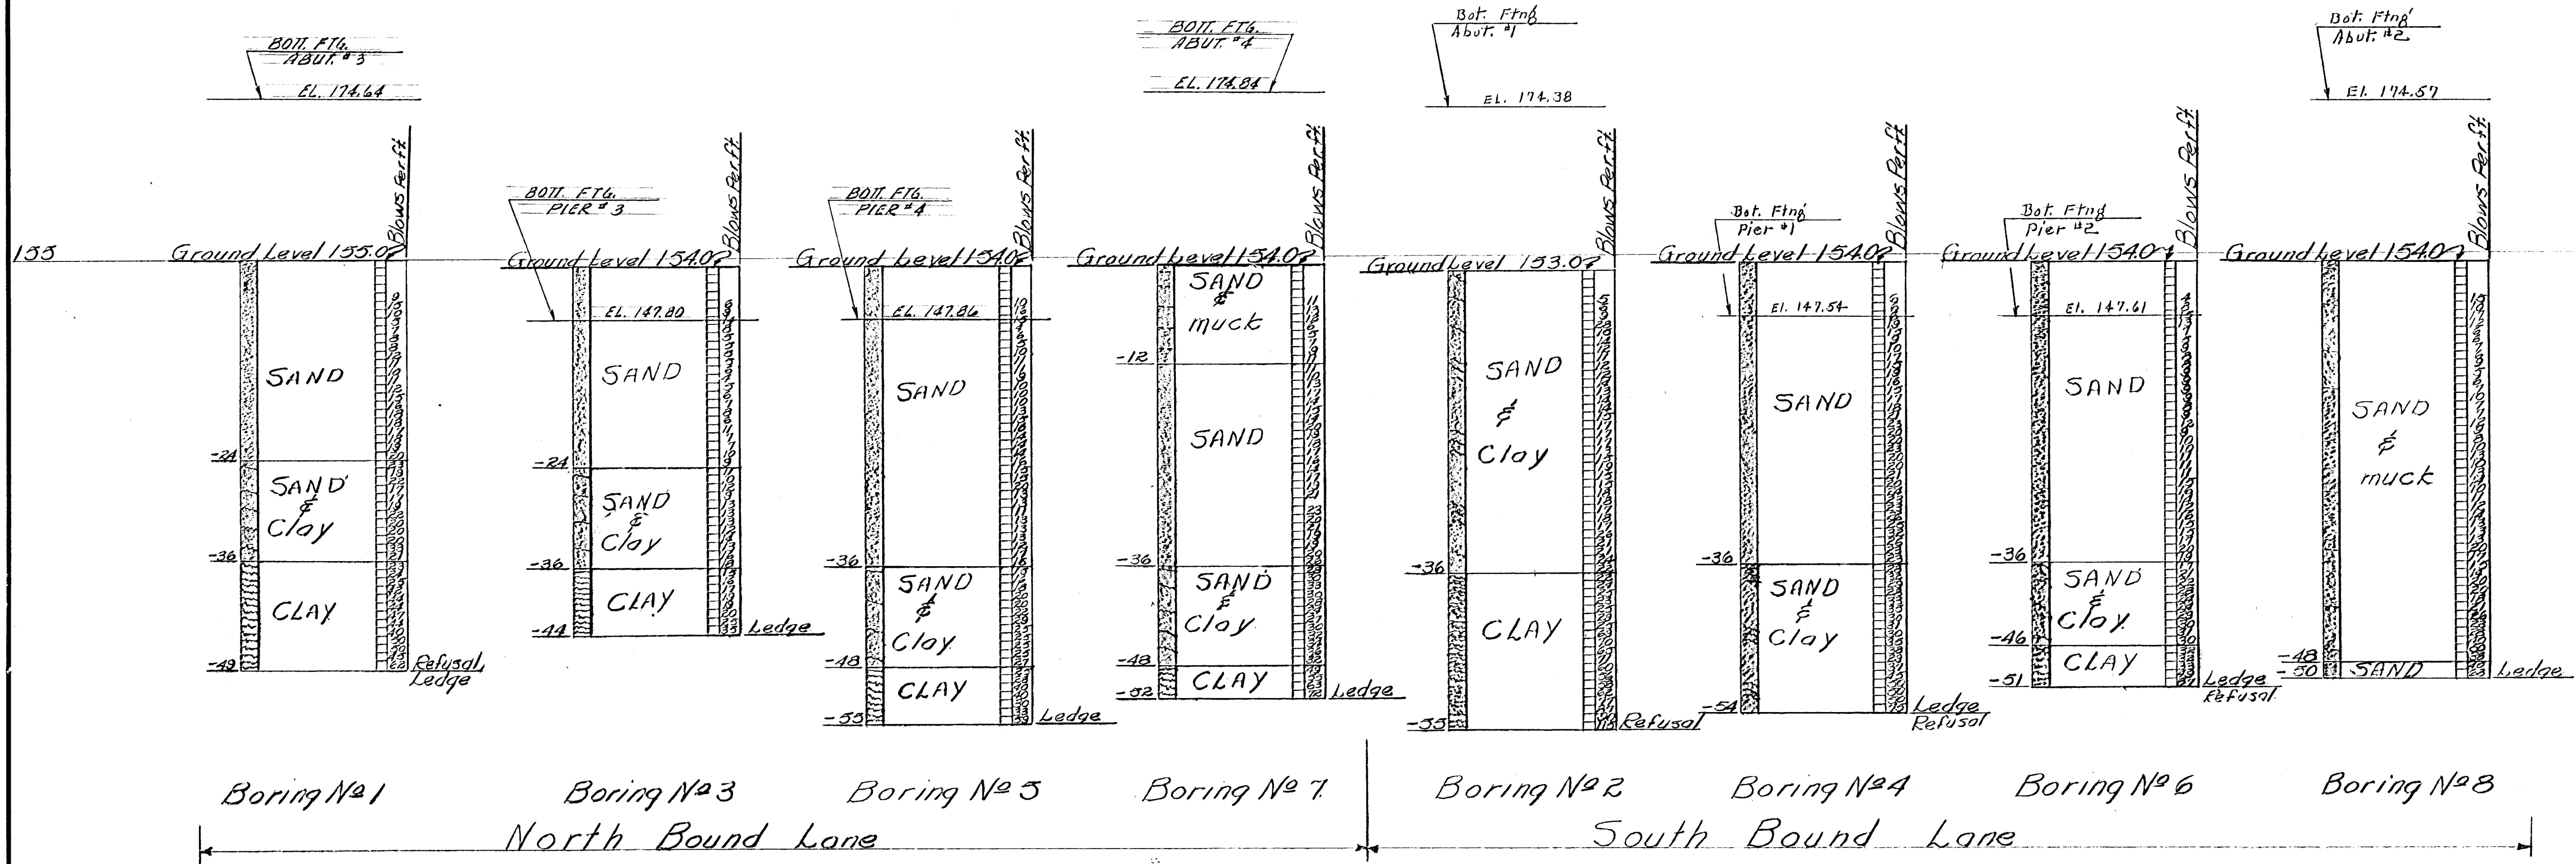

BR. 304 OF 308

STATE OF VERMONT  
DEPARTMENT OF HIGHWAYS

TOWN OF Swanton - Highgate  
ROUTE No. 89 LOG STA. 591+66

Over St. J. & L.C. Railroad  
Borings

SCALE 1" = 10'-0"




SURVEYED BY Stratton

DRAWN BY Hopkins CHECKED BY EAB

PROJECT No. 187-3(3)

SHEET 138 OF 242




**SWANTON**  
IM 089-3(70)  
SHEET 19 OF 31  
FOR REFERENCE  
ONLY

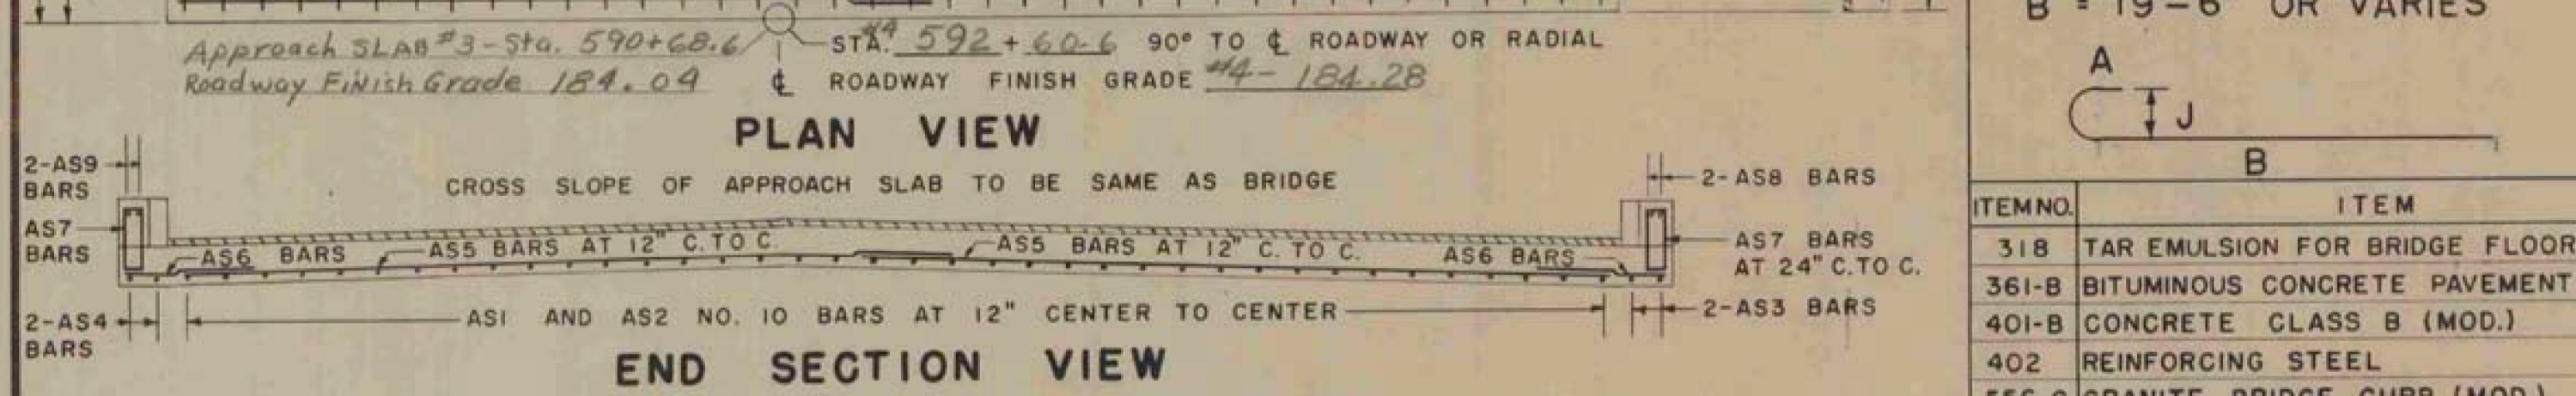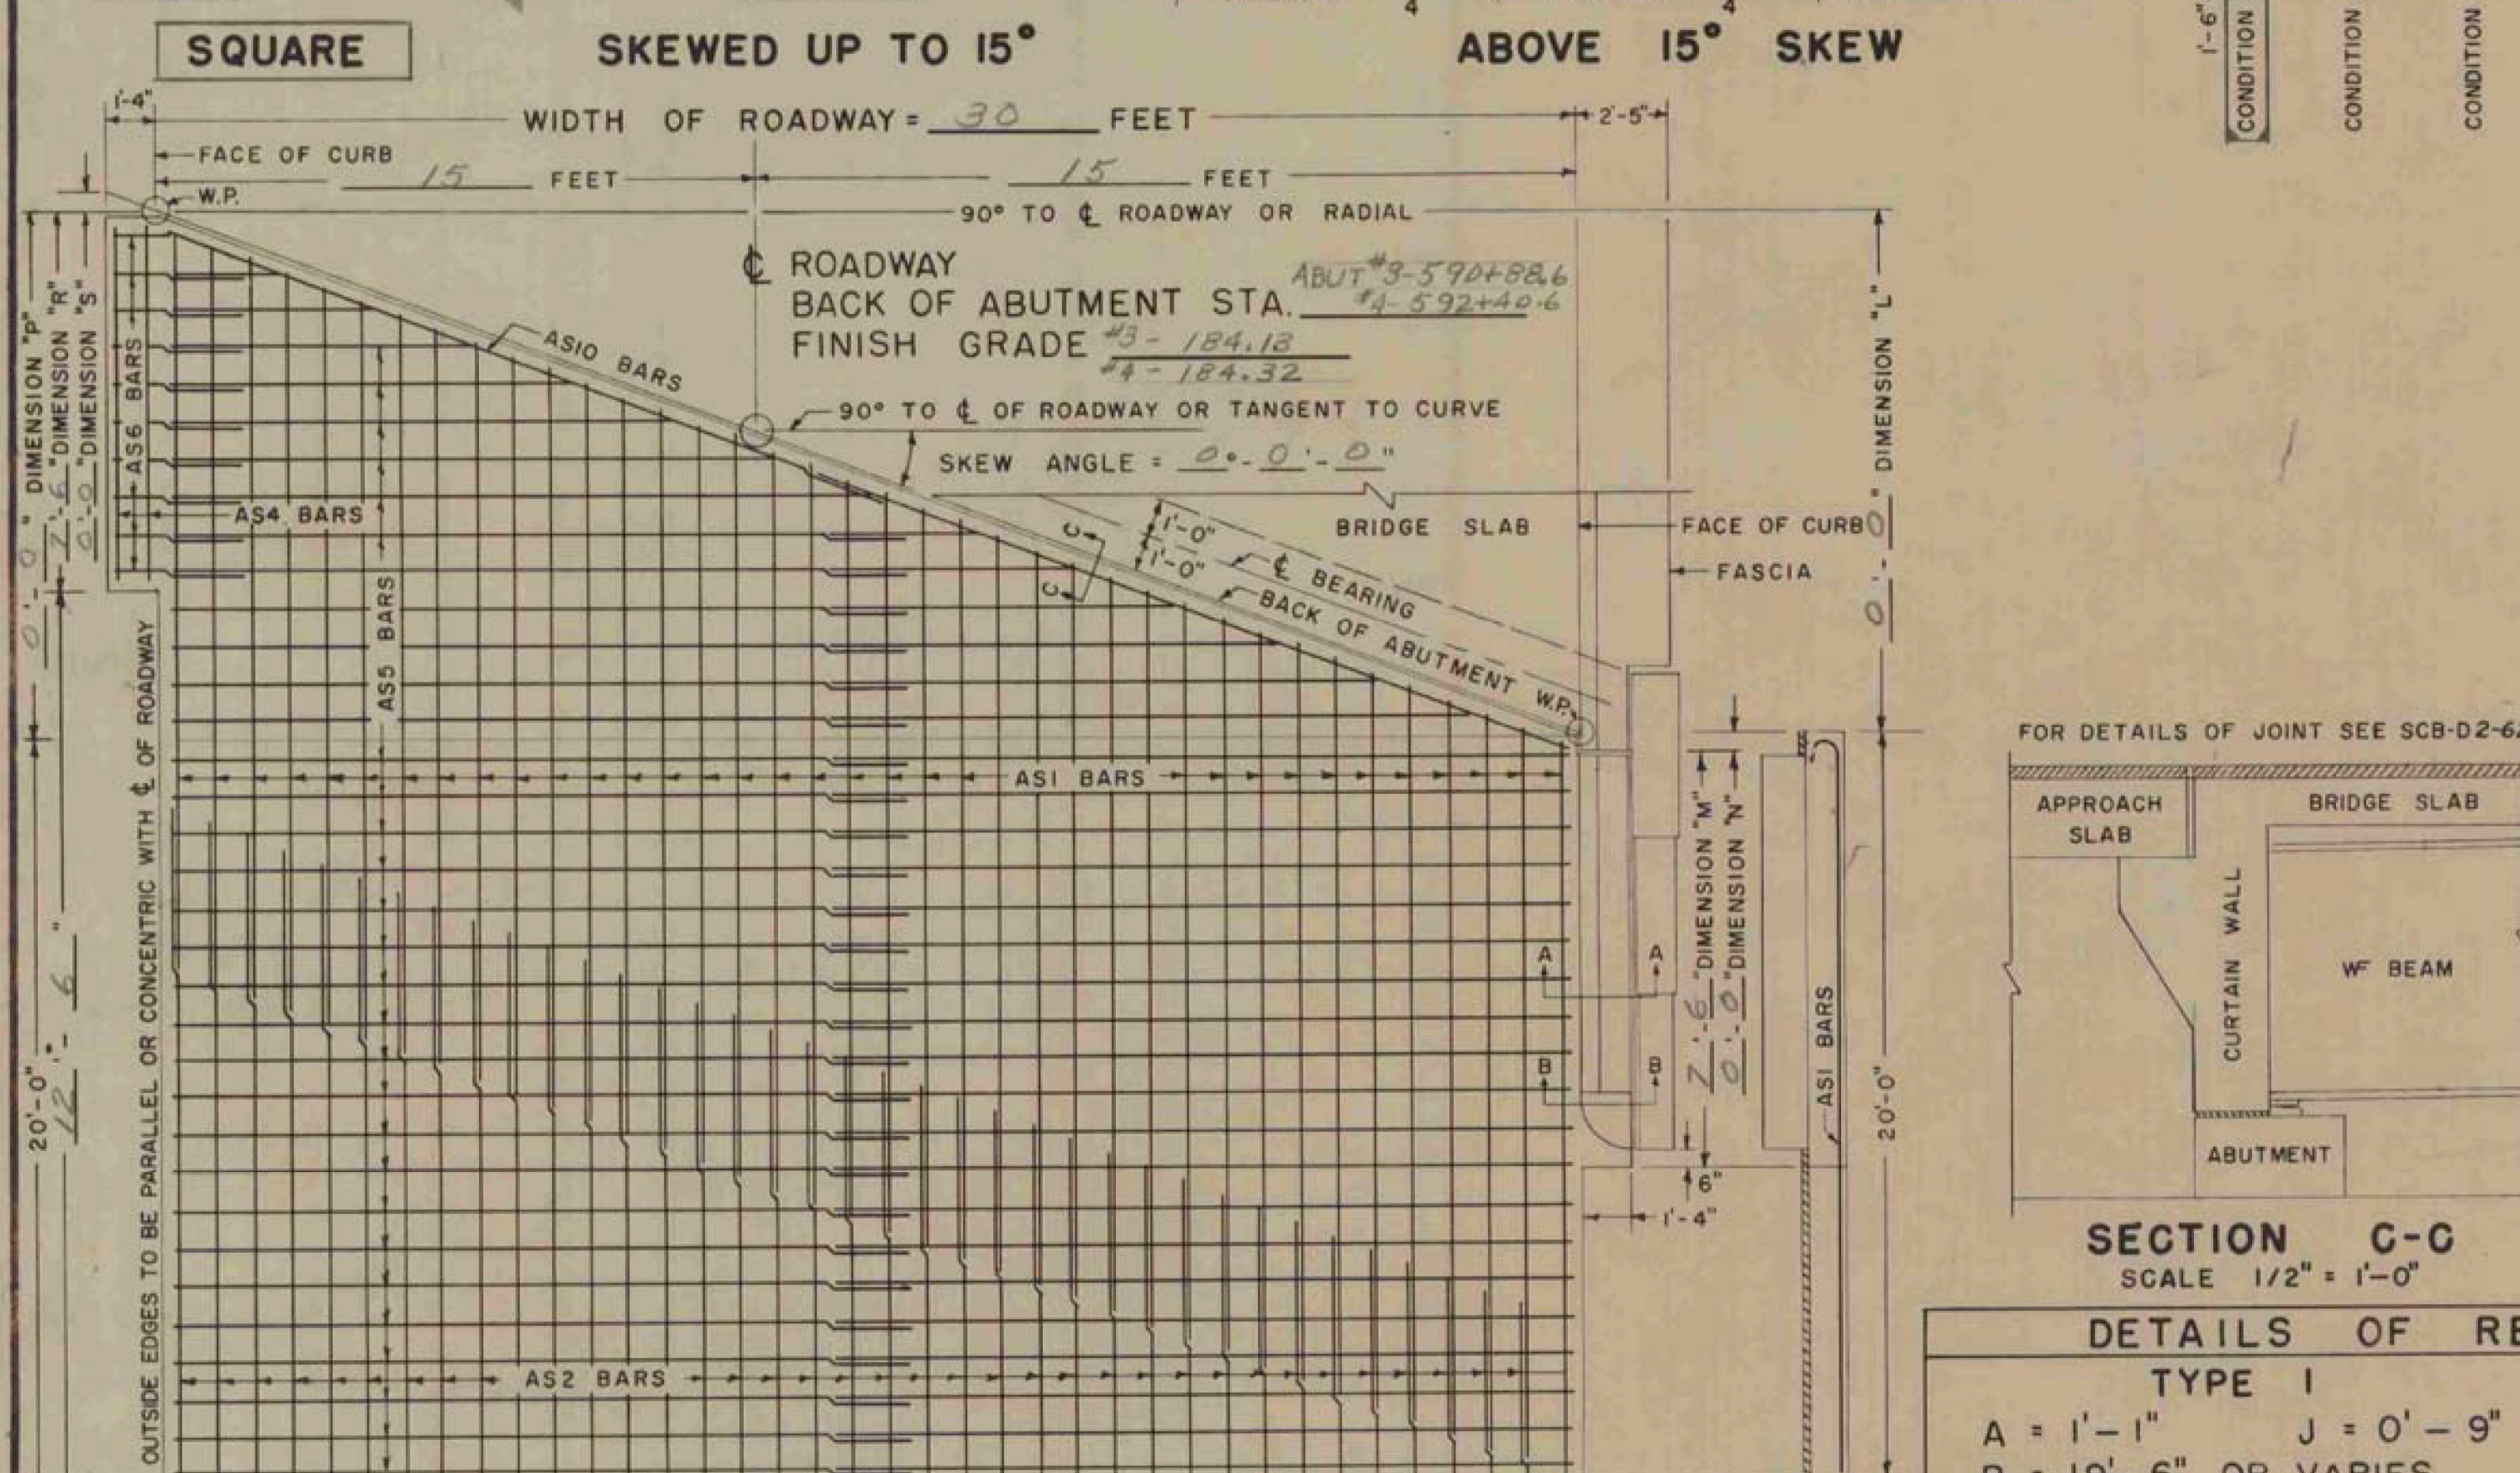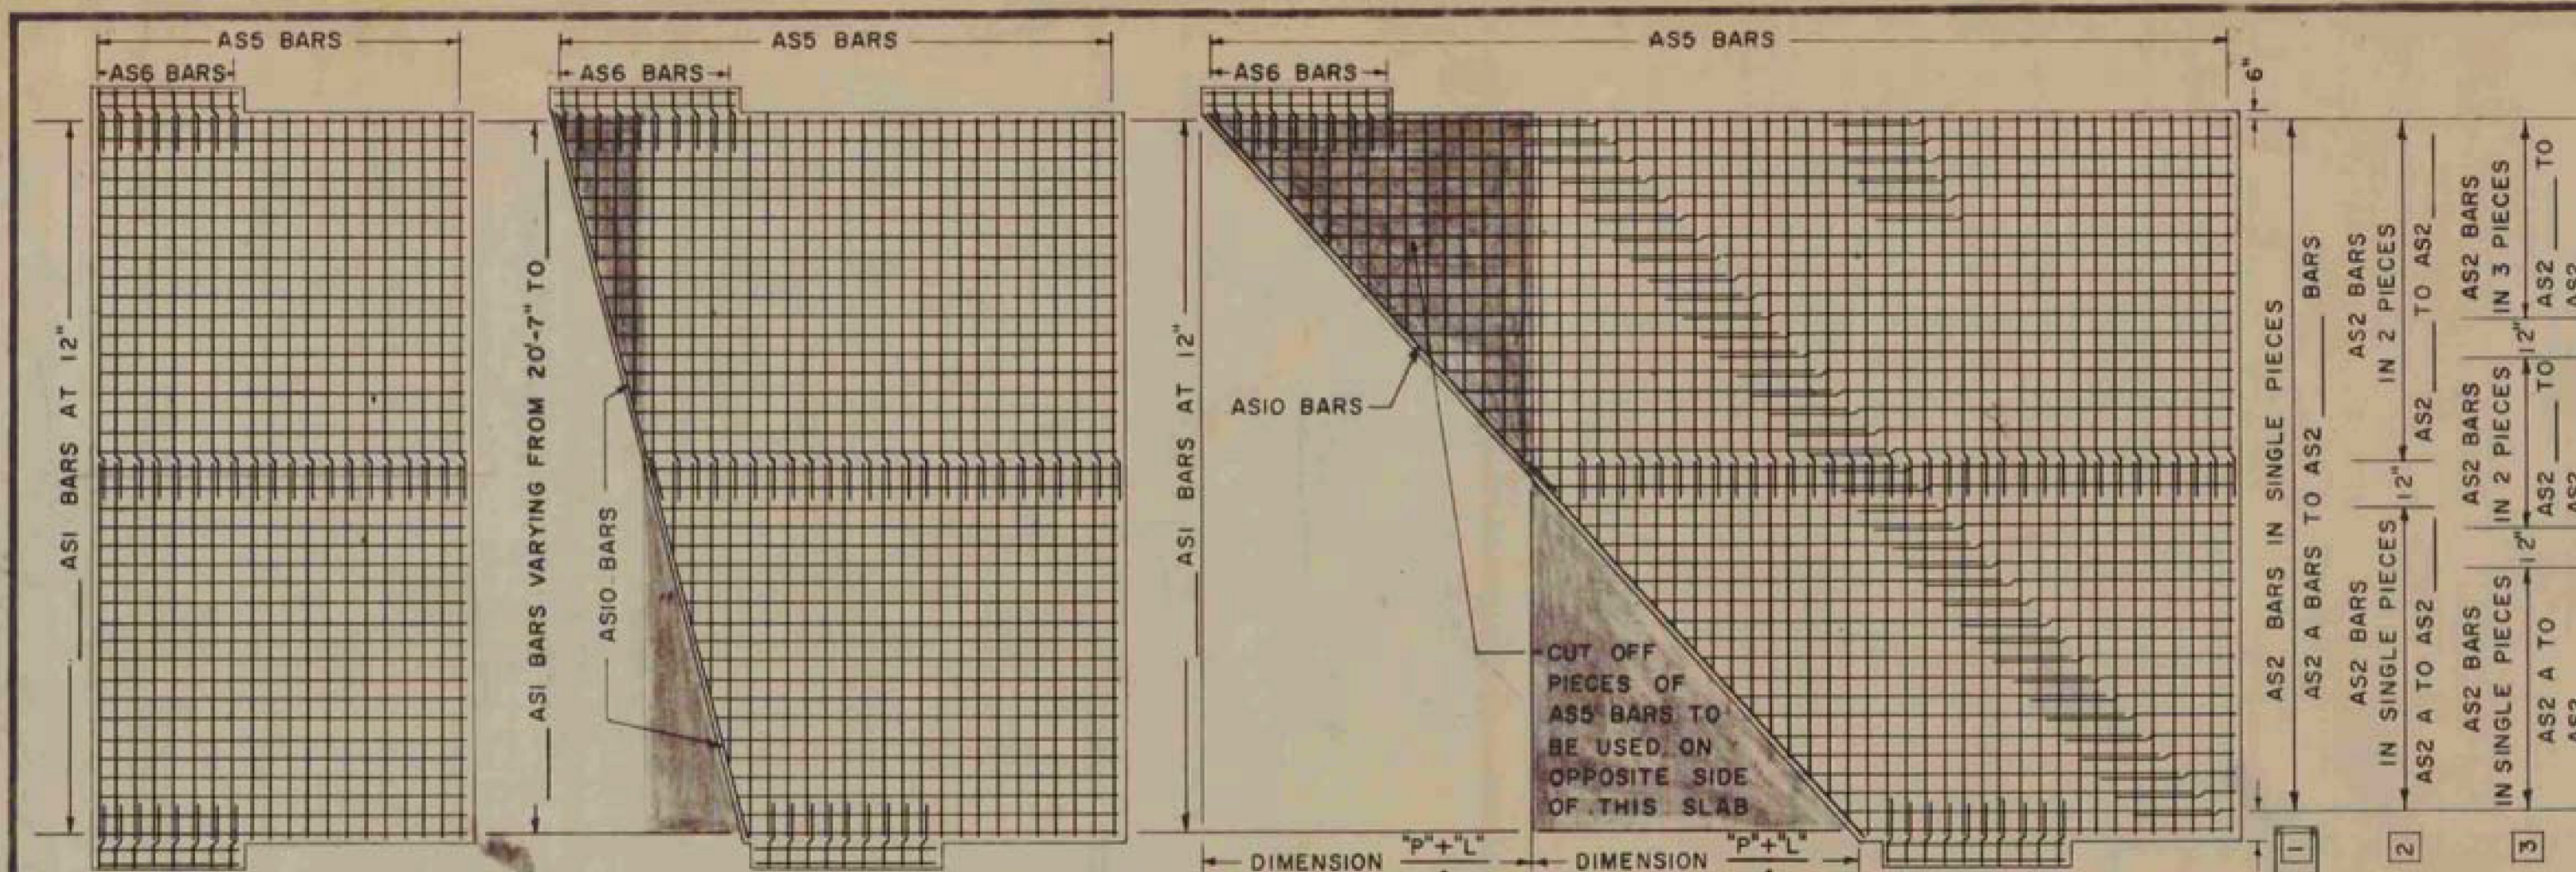

30' ROADWAY					38' ROADWAY					42' ROADWAY					44' ROADWAY					ROADWAY															
NO. PIECES	SIZE	LENGTH	MARK	TYPE	REMARKS	NO. PIECES	SIZE	LENGTH	MARK	TYPE	REMARKS	NO. PIECES	SIZE	LENGTH	MARK	TYPE	REMARKS	NO. PIECES	SIZE	LENGTH	MARK	TYPE	REMARKS	NO. PIECES	SIZE	LENGTH	MARK	TYPE	REMARKS						
2	10	7-0	AS3	STR.		2	10		AS3	STR.		2	10		AS3	STR.		2	10		AS3	STR.		2	10		AS3	STR.		2	10		AS3	STR.	
2	10	7-0	AS4	STR.		2	10		AS4	STR.		2	10		AS4	STR.		2	10		AS4	STR.		2	10		AS4	STR.		2	10		AS4	STR.	
16	5	3'-6"	AS6	STR.		5	3'-6"		AS6	STR.		5	3'-6"		AS6	STR.		5	3'-6"		AS6	STR.		5	3'-6"		AS6	STR.		5	3'-6"		AS6	STR.	
8	5	5'-0"	AS7	S6		5	5'-0"		AS7	S6		5	5'-0"		AS7	S6		5	5'-0"		AS7	S6		5	5'-0"		AS7	S6		5	5'-0"		AS7	S6	
2	5	5'-4"	AS8	STR.		2	5		AS8	STR.		2	5		AS8	STR.		2	5		AS8	STR.		2	5		AS8	STR.		2	5		AS8	STR.	
2	5	5'-4"	AS9	STR.		2	5		AS9	STR.		2	5		AS9	STR.		2	5		AS9	STR.		2	5		AS9	STR.		2	5		AS9	STR.	
SQUARE					SQUARE					SQUARE					SQUARE					SQUARE															
30	10	20'-7"	AS1	I		38	10	20'-7"	AS1	I		42	10	20'-7"	AS1	I		44	10	20'-7"	AS1	I		10	20'-7"		AS1	I		10	20'-7"		AS1	I	
20	5	29'-6"	AS5	STR.		40	5	19'-9"	AS5	STR.		40	5	21'-9"	AS5	STR.		40	5	22'-9"	AS5	STR.		5			AS5	STR.		5			AS5	STR.	
SKEWED UP TO 15°					SKEWED UP TO 15°					SKEWED UP TO 15°					SKEWED UP TO 15°					SKEWED UP TO 15°															
30	10		AVE. AS1	I	I	38	10		AVE. AS1	I	I	42	10		AVE. AS1	I	I	44	10		AVE. AS1	I	I	10			AVE. AS1	I	I	10			AVE. AS1	I	I
5	29'-6"		AS5	STR.	2	5	19'-9"		AS5	STR.	3	5	21'-9"		AS5	STR.	3	5	22'-9"		AS5	STR.	3	5			AS5	STR.	3	5			AS5	STR.	3
ALL SKEWED SPANS ABOVE 15° SKEW					ALL SKEWED SPANS ABOVE 15° SKEW					ALL SKEWED SPANS ABOVE 15° SKEW					ALL SKEWED SPANS ABOVE 15° SKEW					ALL SKEWED SPANS ABOVE 15° SKEW															
2	5		ASIO	STR.		5			ASIO	STR.		5			ASIO	STR.		5			ASIO	STR.		5			ASIO	STR.		5			ASIO	STR.	
30	10	20'-7"	AS1	I		38	10	20'-7"	AS1	I		42	10	20'-7"	AS1	I		44	10	20'-7"	AS1	I		10	20'-7"		AS1	I		10	20'-7"		AS1	I	
29	10		AVE. AS2	STR.	4	37	10		AVE. AS2	STR.	4	41	10		AVE. AS2	STR.	4	43	10		AVE. AS2	STR.	4	10			AVE. AS2	STR.	4	10			AVE. AS2	STR.	4
5	29'-6"		AS5	STR.	2	5	19'-9"		AS5	STR.	3	5	21'-9"		AS5	STR.	3	5	22'-9"		AS5	STR.	3	5			AS5	STR.	3	5			AS5	STR.	3

REMARKS: AS1 BAR "B" DIMENSION VARIES FROM 19'-6" TO 20'-0" DIMENSION (P+L)/4 (IN FEET) = NUMBER OF PIECES. CUT BARS IN THE FIELD USING CUT OFF PIECES ON OPPOSITE HALF OF SLAB. AS2 BAR DIMENSION VARIES FROM 19'-9" TO 20'-0" DIMENSION (P+L)/2 (IN FEET) = NUMBER OF PIECES. CUT BARS IN THE FIELD USING CUT OFF PIECES ON OPPOSITE HALF OF SLAB. THE LENGTH OF AS2 BARS VARIES FROM 19'-9" TO 20'-0" DIMENSION (P+L)/2 (IN FEET) = NUMBER OF PIECES. THE AS2 BARS MAY BE DIVIDED INTO TWO OR MORE PIECES, AS MAY BE NECESSARY, TO LIMIT THE MAXIMUM BAR LENGTH TO 30 FEET. THE LOCATION OF SPLICES IS LEFT TO THE OPTION OF THE DESIGNER. THE NO. PIECES SHOWN ARE FOR CONDITION 1. (FOR CONDITION 2 & 3. SEE REINF. SCHEDULE.)

GENERAL NOTES: ALL REINFORCING STEEL SHALL BE DETAILED ON THE REINFORCING STEEL SCHEDULE. WHEN A BAR LENGTH VARIES IN INCREMENTS EACH BAR MUST BE DETAILED. SPLICES SHALL BE 2'-0" FOR NUMBER 5 BARS, AND 4'-0" FOR NUMBER 10 BARS. ALL WORK AND MATERIALS SHALL CONFORM TO THE STATE OF VERMONT, DEPARTMENT OF HIGHWAYS, STANDARD SPECIFICATIONS FOR HIGHWAY AND BRIDGE CONSTRUCTION DATED JANUARY 1956, AND THE A.S.H.O. SPECIFICATIONS DATED 1962. DESIGNED FOR H20-S16-44.

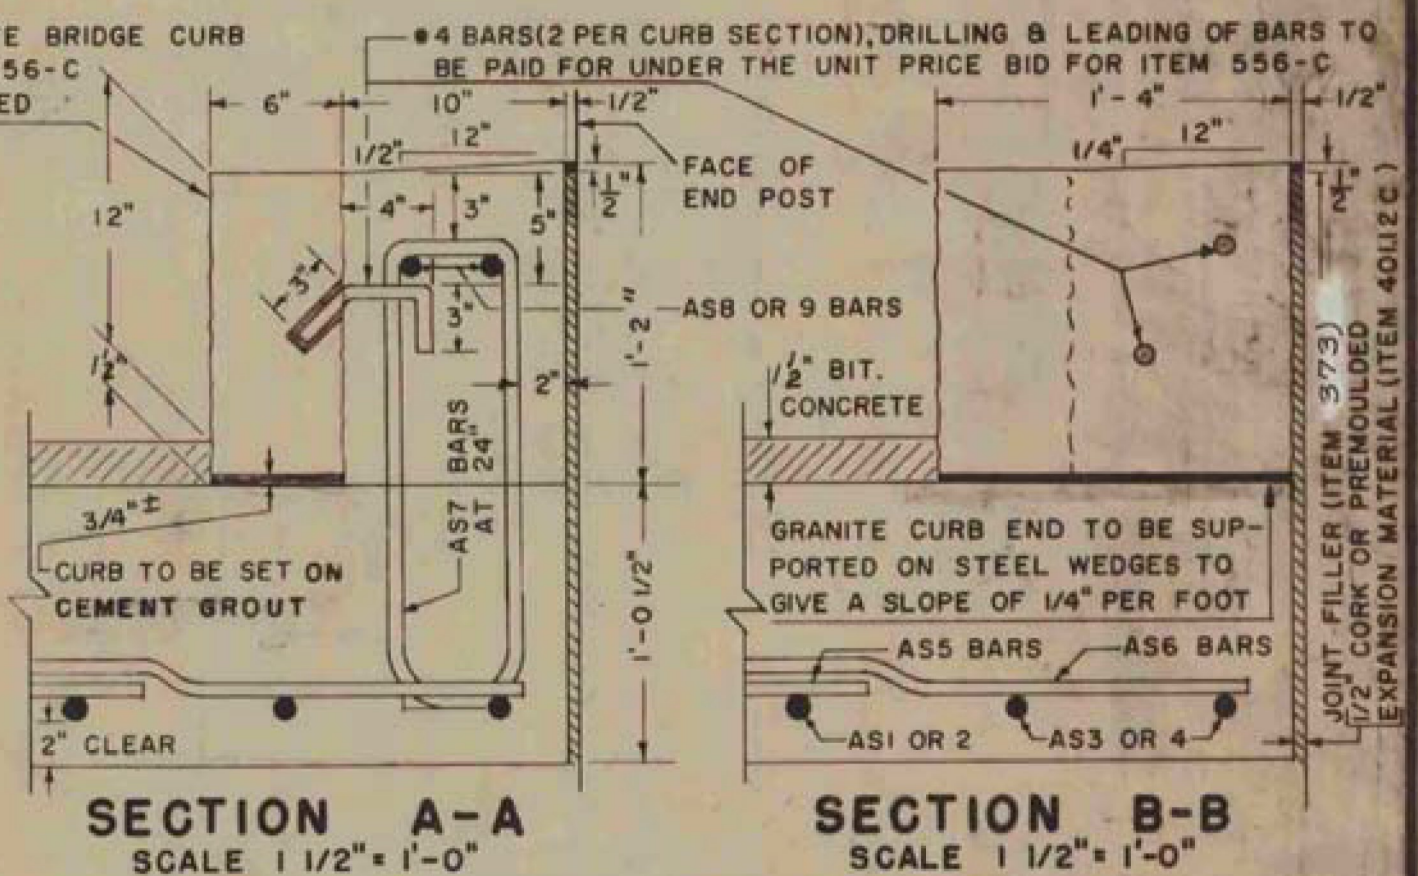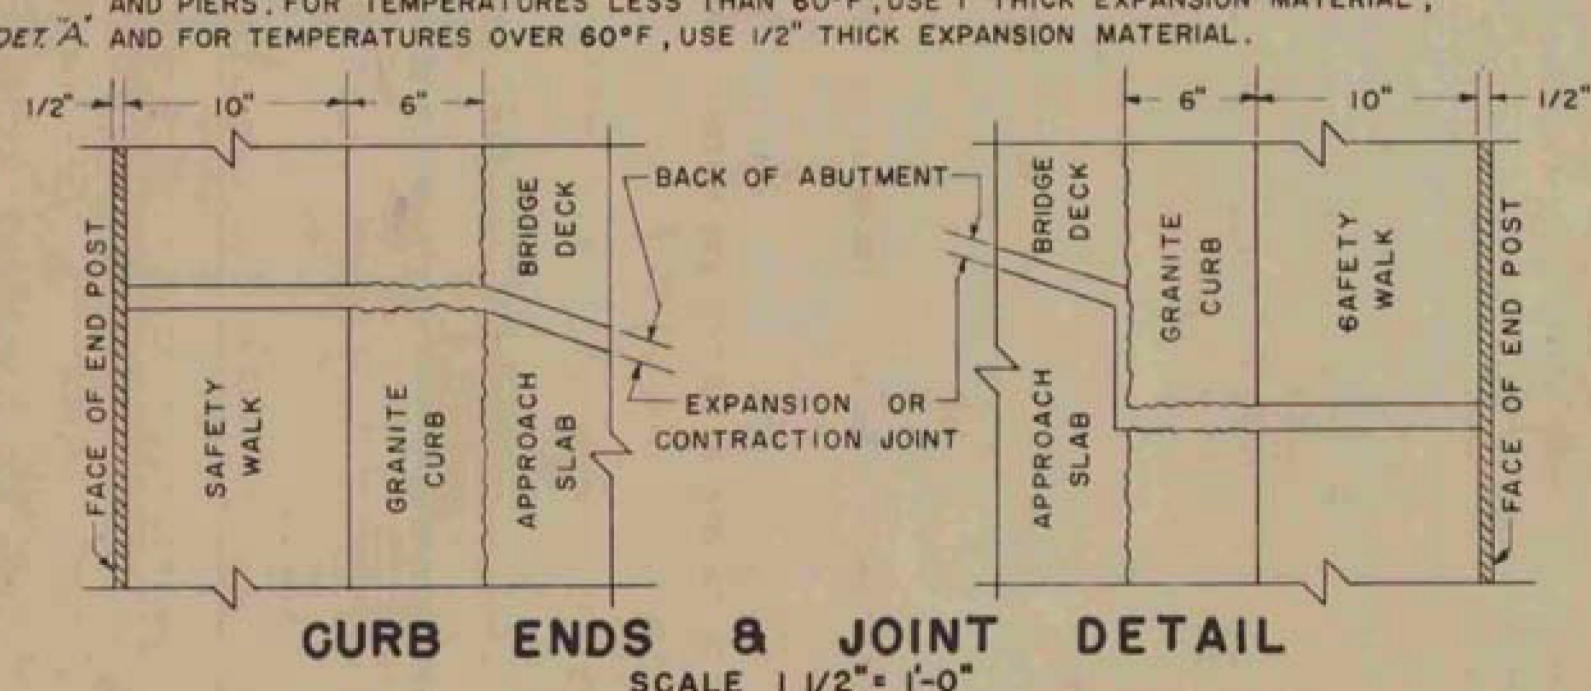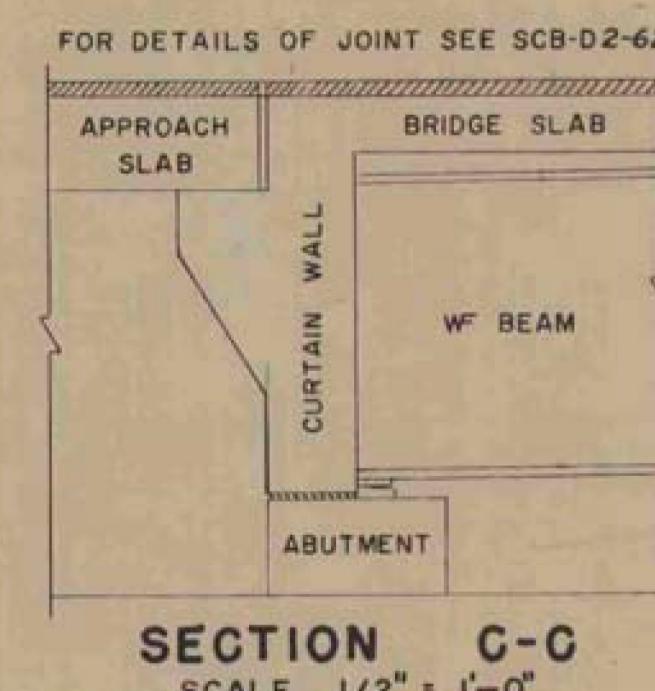

DETAILS OF REINFORCING BARS				REINFORCING STEEL				QUANTITY COMPUTATION					
TYPE I		TYPE S6		C		A X B X C		W		Z		T	
A	J	A	B	C	BAR NO.	NO. PIECES	LENGTH	WEIGHT PER FT.	WEIGHT IN LBS.	W = WIDTH OF ROADWAY	Z = 20 + DIMENSION (P+L)/4	T = DIMENSION (M+R)/2	
A = 1'-1"	J = 0'-9"	A = 0'-6"	B = 1'-9"	C = 0'-6"	AS1	30	20'-7"	4.303	2656.67	W = 30	Z = 20	T = 7'-6"	
B = 19'-6" OR VARIES		C = 0'-6"	D = 1'-9"	G = 0'-6"	AS2			4.303		BITUMINOUS CONCRETE = W x Z x 0.0092 = TONS 30 x 20 x 0.0092 = 5.52 TONS			
					AS3	2	7-0	4.303	60.24	TAR EMULSION = W x Z x 0.044 = GALLONS 30 x 20 x 0.044 = 26.64 GALLONS			
					AS4	2	7-0	4.303	60.24	CONCRETE CLASS B = W x Z x 0.0386 + T x 0.1029 + (T - 1.8333) x 0.0733 = CUBIC YARDS			
					AS5	20	29-6	1.043	615.37	[30 x 20 x 0.0386] + [7.5 x 0.1029] + [(7.5 - 1.8333) x 0.0733] = 24.35 CUBIC YARDS			
					AS6	16	3'-6"	1.043	58.40	GRANITE BRIDGE CURB = 2(T+0'-3') x LINEAR FEET 2(7.5+0.25) = 15.5 LINEAR FEET			
					AS7	8	5'-0"	1.043	41.72	BAR LENGTHS: AS3 BARS = DIMENSION "M" - 0'-6"			
					AS8	2	5'-4"	1.043	11.13	AS4 BARS = DIMENSION "R" - 0'-6"			
					AS9	2	5'-4"	1.043	11.13	AS6 BARS = 3'-6"			
					ASIO			1.043		AS7 BARS = 5'-0"			
										AS8 BARS = DIMENSION "M" - 2'-2"			
										AS9 BARS = DIMENSION "R" - 2'-2"			
										TOTAL WEIGHT = 3514.90			

DETAILS OF APPROACH SLAB FOR 30 FOOT BRIDGE (WIDTH)

TO BE USED FOR BRIDGE AT STATION 591+64.6

LOCATION SWANTON

STATE OF VERMONT DEPARTMENT OF HIGHWAYS STANDARD STRUCTURE SB-AS-62

TOWN OF SWANTON-HIGHGATE

ROUTE NO. I-89

NBI-89 over St. J. & L.C. Railroad

SCALE AS NOTED

DESIGNED BY [Signature] CHECKED BY RLO

PROJECT NO. I-89-3 (138)

BR. 305 OF 308 SHEET 133 OF 246

SWANTON IM 089-3(70) SHEET 20 OF 31 FOR REFERENCE ONLY

APPROVED

DRAWN BY: R.S. HAUPT NOV. 1960

TRACED BY: R.S. HAUPT NOV. 1960

CHECKED BY: A.H. SMALLEY NOV. 1960

Recommended For Approval [Signature] 12/1/62 Bridge Engineer Date

Recommended For Approval [Signature] 1/1/63 Asst. Chief Engineer Date








Approved By [Signature] 1/4/63 Chief Engineer Date



**NOTES**

- 1- For bridge seat elevations see sheet Br. 301
- 2- Maximum pile design load is 40 tons per pile.

**SWANTON**  
**IM 089-3(70)**  
**SHEET 22 OF 31**  
**FOR REFERENCE ONLY**

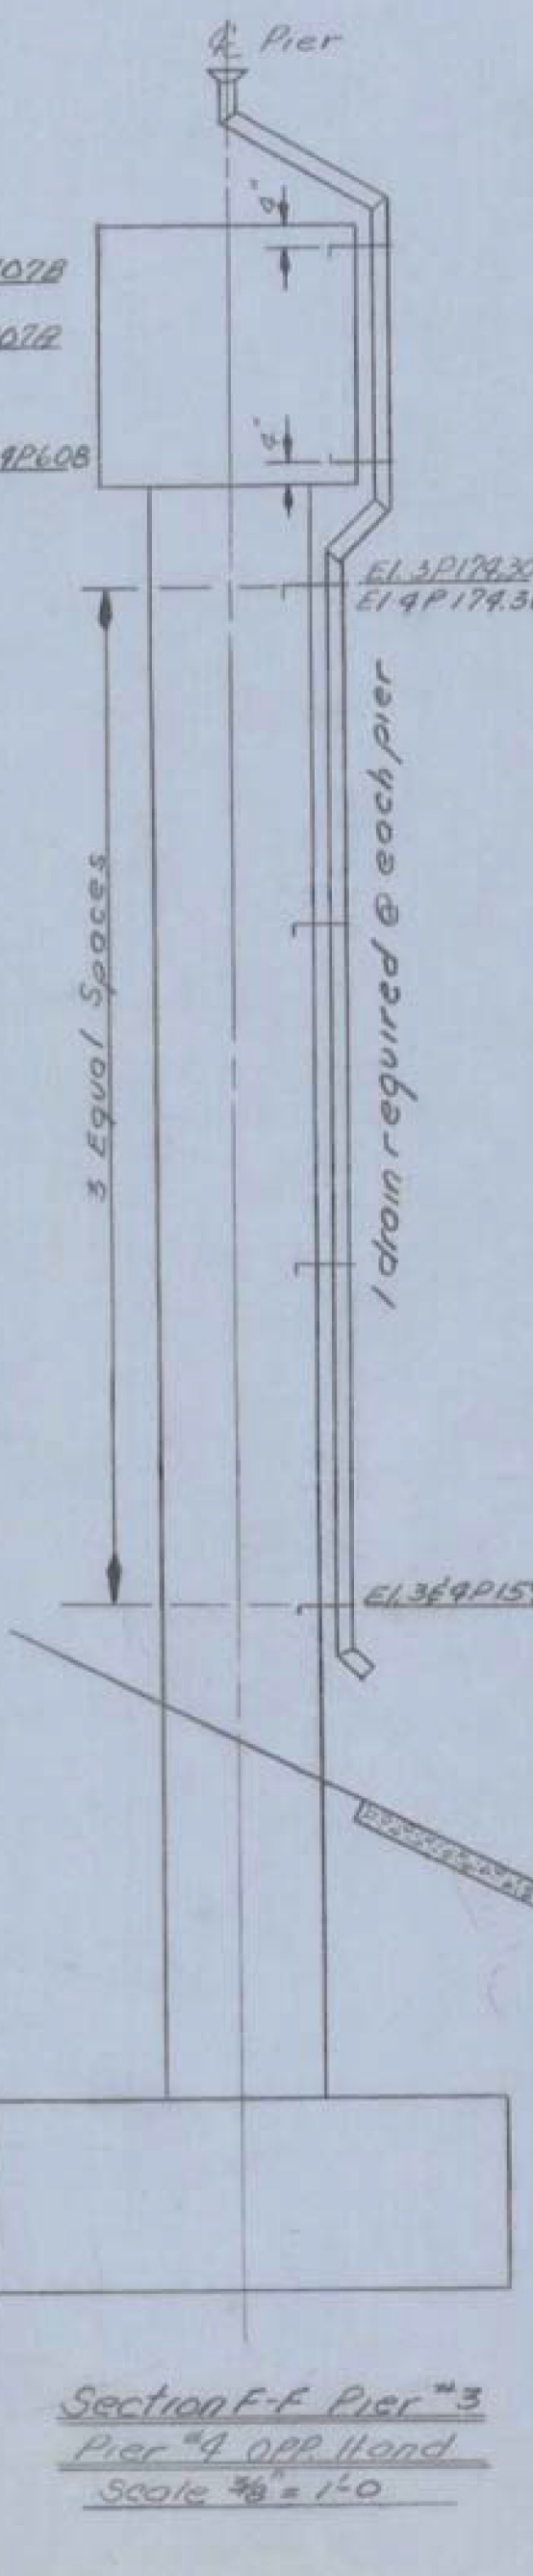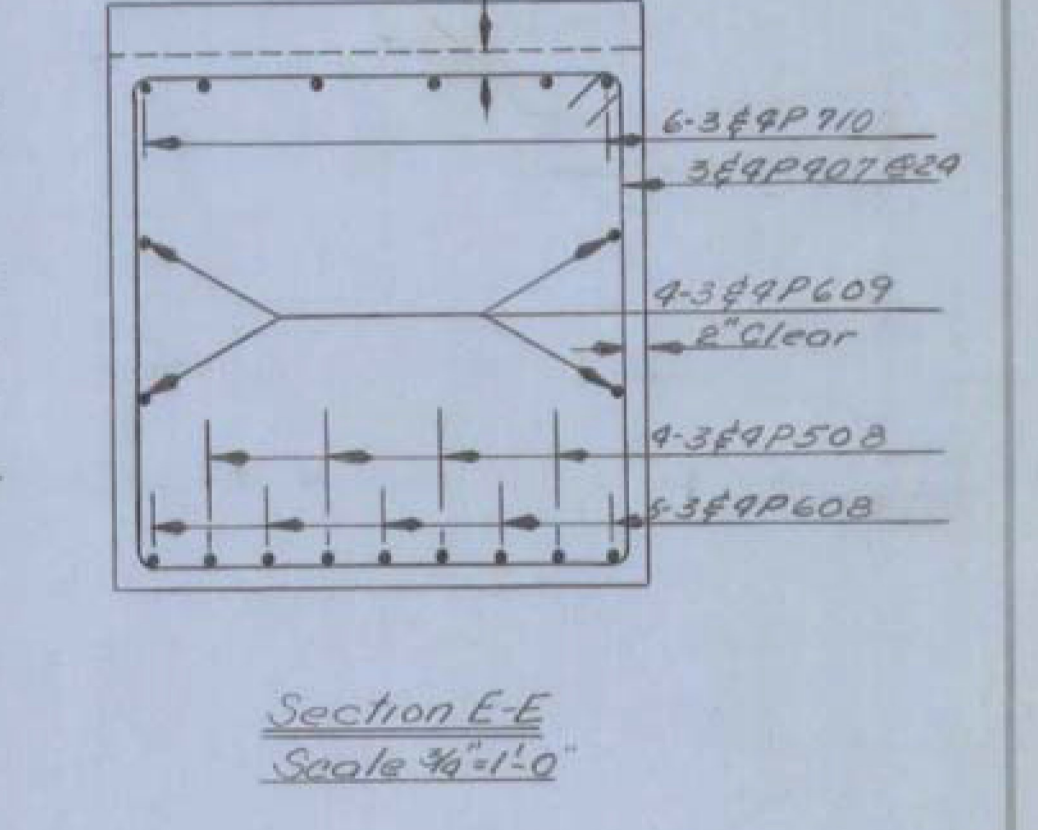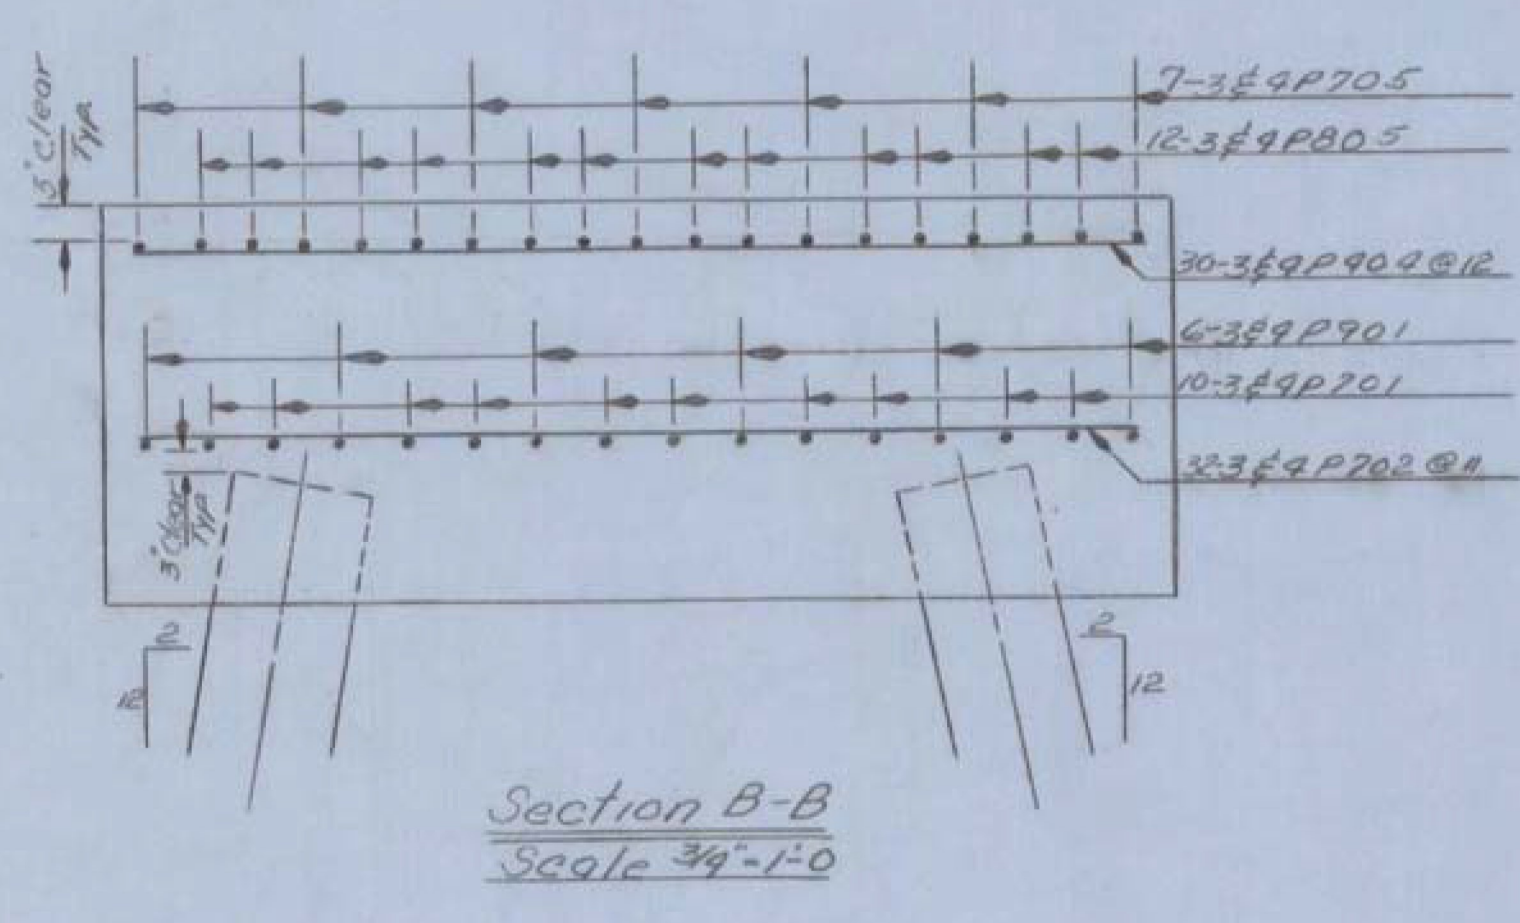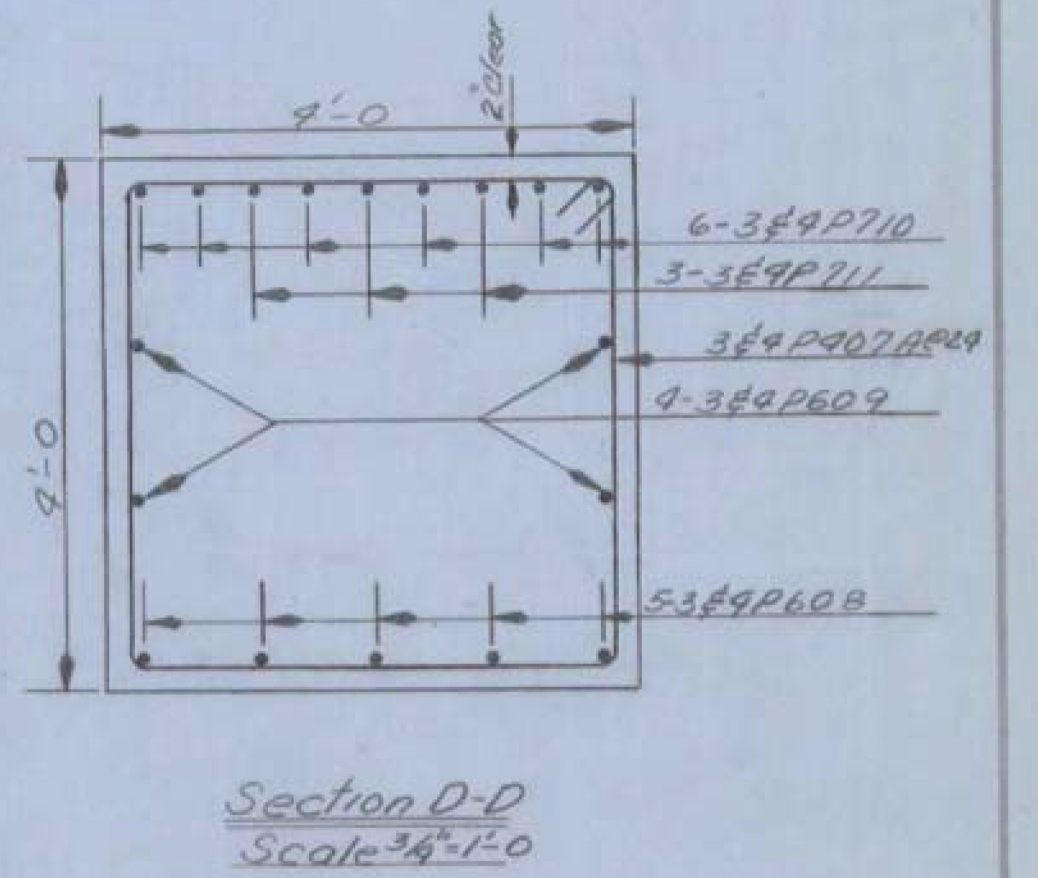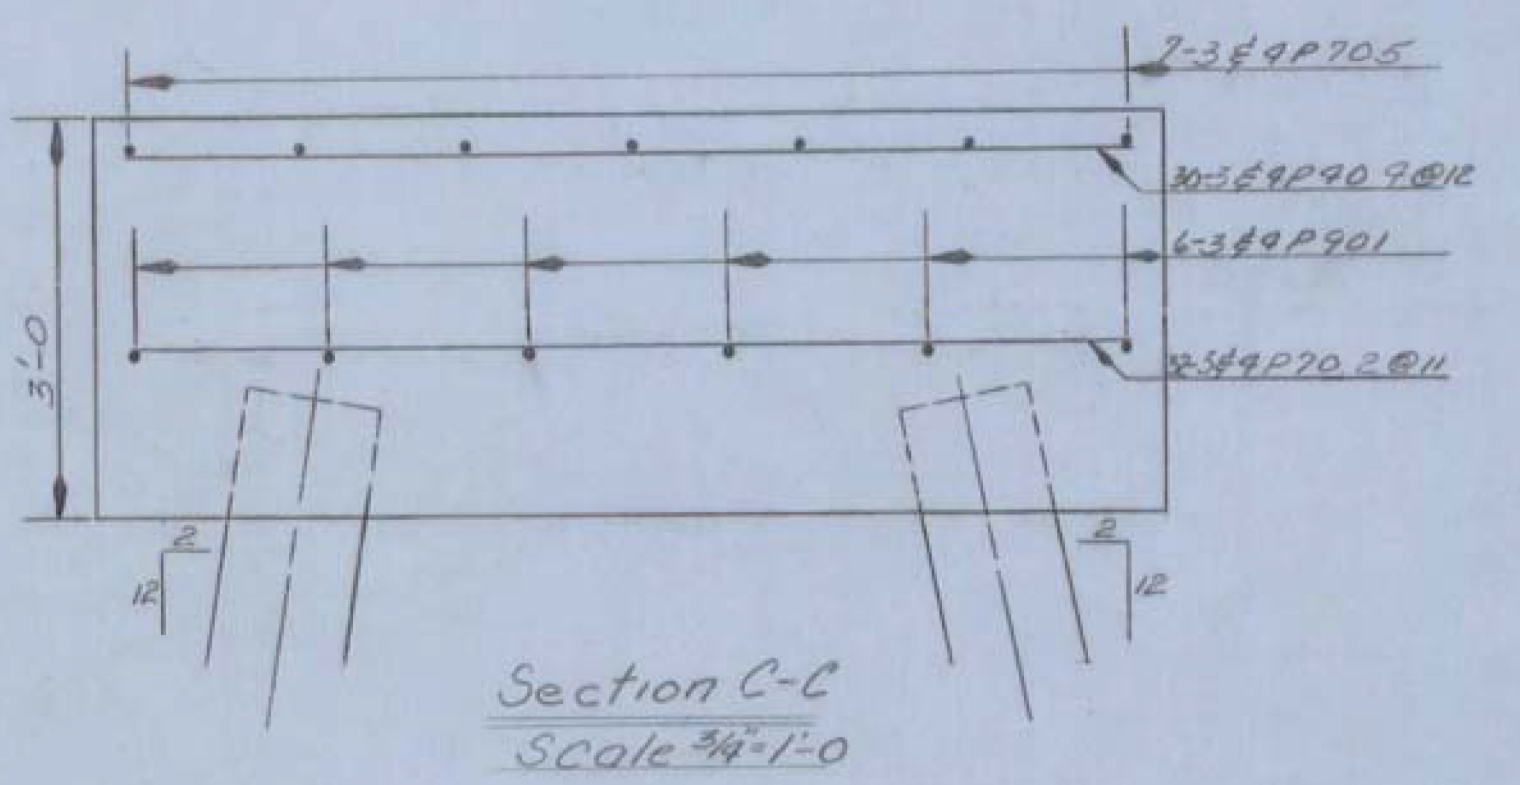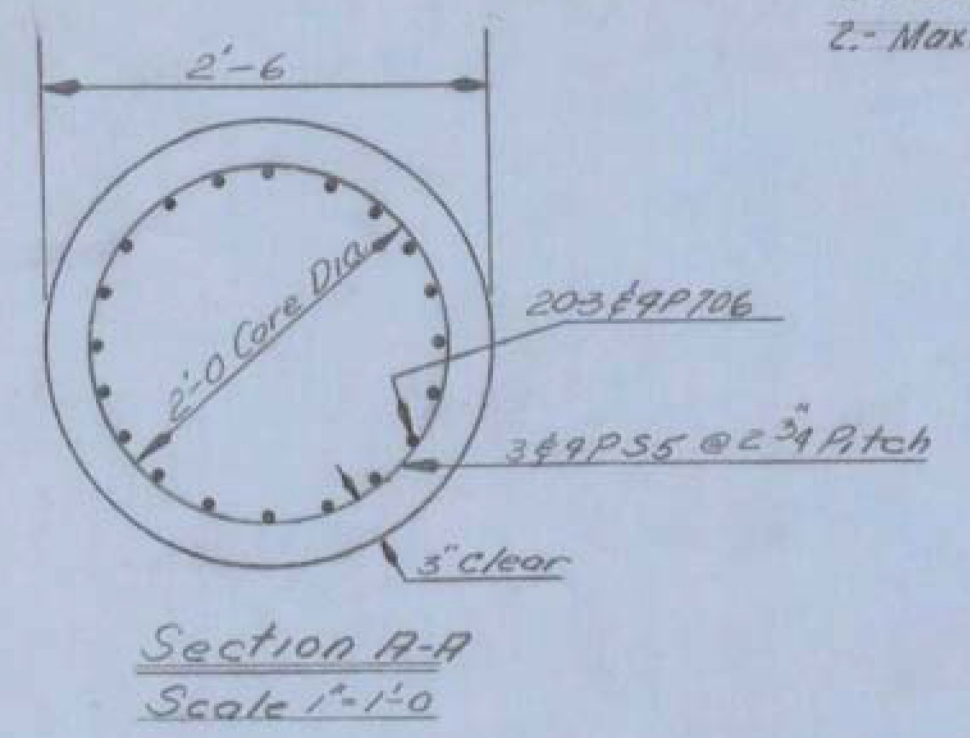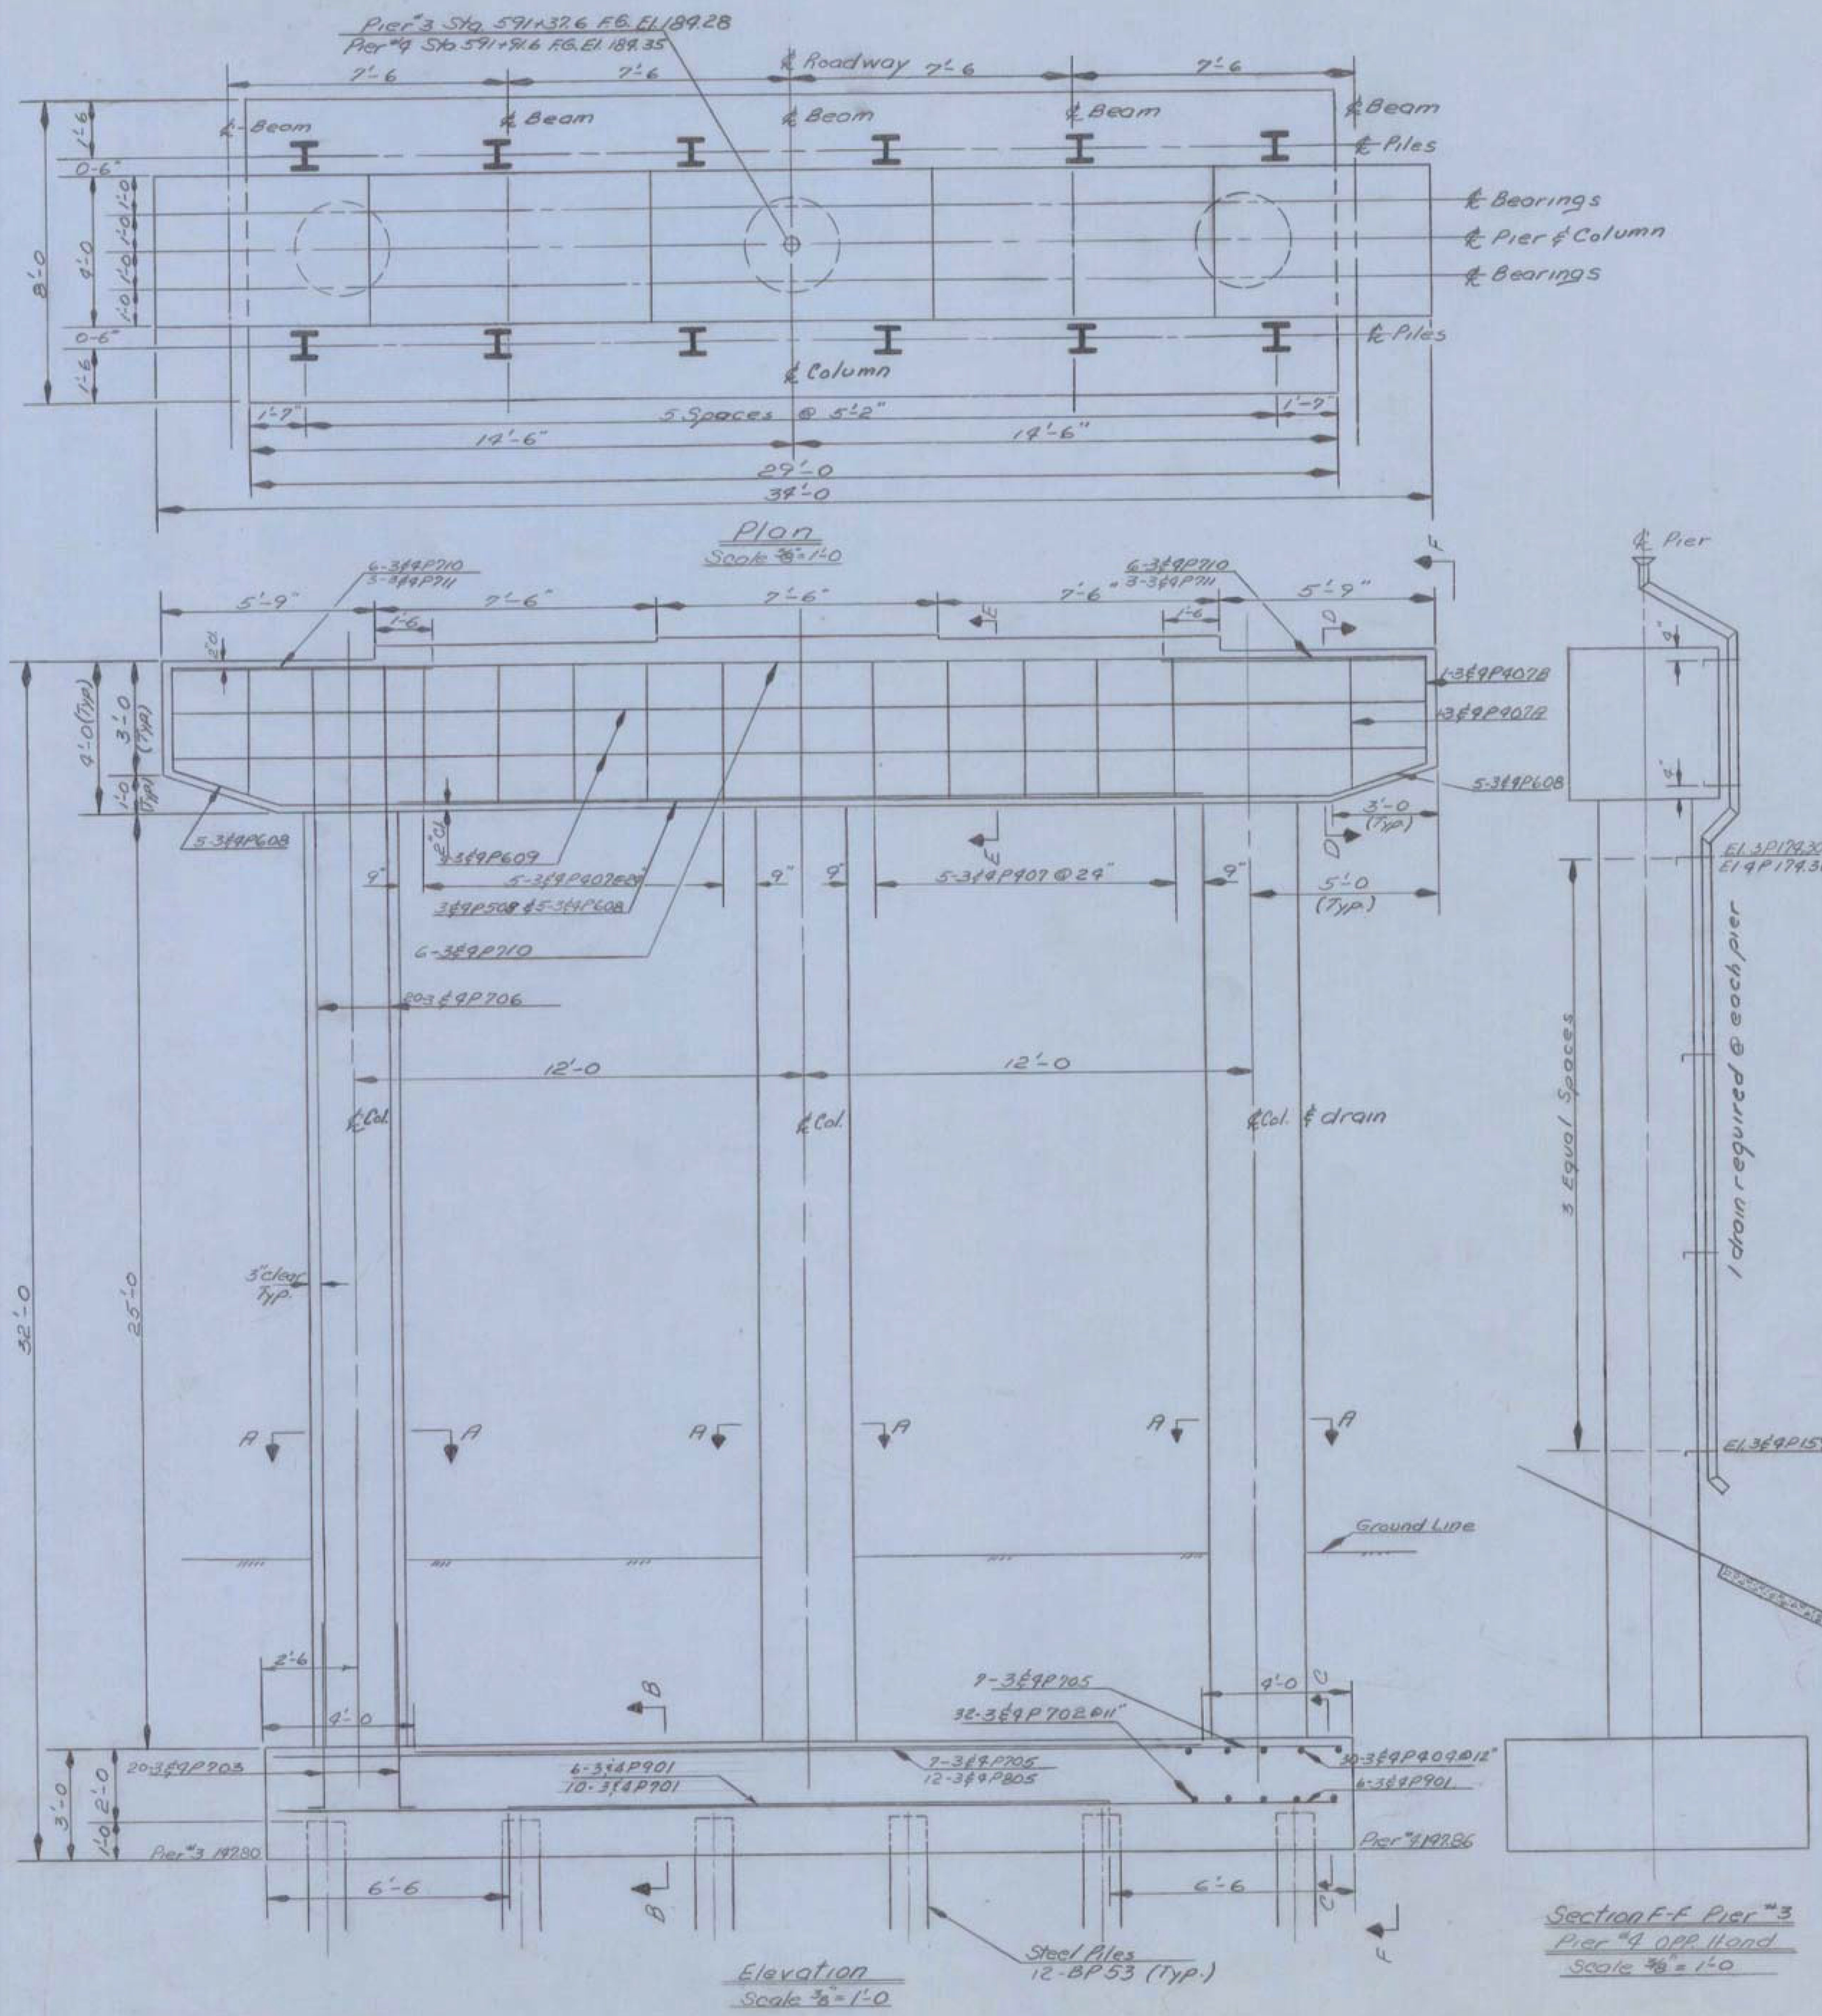

ITEM NO.	ITEM	UNIT	NET	OVERRUN	TOTAL	FINAL
106-A	CHAN EXCAV. OF EARTH	C.Y.				
106-B	CHAN EXCAV. OF ROCK	C.Y.				
106-C	UNCLASS. CHAN. EXCAV.	C.Y.				
107	STRUCT. EXCAV.	C.Y.				
401-B	CONC. CLASS B (MOD.)	C.Y.				
402	REINF. STEEL	LBS.				
407	ASPHALTIC-ASB. COATING	S.Y.				
502-B	TREATED TIMBER PILING	L.F.				
503	SPLICES FOR STEEL PILING	EA.				
504	STEEL PILING	L.F.				
502-A	UNTREATED TIMBER PILING	L.F.				

BR. 307 OF 308

**STATE OF VERMONT**  
 DEPARTMENT OF HIGHWAYS

TOWN OF SWANTON - HIGHGATE

ROAD No. I-89 BRIDGE No. ...

NBI-89 OVER ST. J. & L.C. R.R.

PIERS NO. 3 AND 4

SCALE AS SHOWN

SURVEYED BY ...


DRAWN BY SHS CHECKED BY RLO

PROJECT No. I-89-3(70)

SHEET 141 OF 246


Item	No. Pieces	Size	Length	Mark	Type	A	B	C	D	E	F	G	H	J	K	R	O
<b>STAGE I CONSTRUCTION</b>																	
<b>APPROACH SLAB NO. 3</b>																	
1																	
2																	
3																	
4	16	5	3-6	3A5506	STR												
5	*3	4	5-4	3A5508													
6	2		5-4	3A5509													
7	20		29-6	3A5505	STR												
8	5	5-0	3A5507	56	0-6	1-9	0-6	1-9			0-6						
9	*3	10	7-0	3A5504	STR												
10	2		7-0	3A5504	STR												
11	30	10	20-7	3A5500	1	1-1	19-6							0-9			
<b>APPROACH SLAB NO. 4</b>																	
Same as Approach Slab #3 except that Mark shall be 4AS in lieu of 3AS and test bars shall be omitted.																	
<b>SUPERSTRUCTURE</b>																	
<b>SPAN NO. 4</b>																	
23	66	4	5-3	3S404	53	0-5	1-6	1-5	1-6							0-5	
24	26	4	7-6	3S406A	55	0-5	3-0	0-8	3-0							0-5	
25	150	5	25-3	3S502	STR												
26	8	1	32-2	3S505	STR												
27	196	1	34-4	3S501	STR												
28	31	5	4-2	3S506P	17	2-6	0-8	1-0									
29	20	6	25-6	3S603	STR												
30	22	6	3-0	3S607	1	0-8	1-8									0-8	
<b>SPAN NO. 5</b>																	
33	72	4	5-3	3S404	53	0-5	1-6	1-5	1-6							0-5	
34	150	5	27-9	3S502	STR												
35	216	5	34-4	3S501	STR												
36	62	5	4-2	3S506P	17	2-6	0-8	1-0									
37	*21	6	28-0	3S603	STR												
38	*1	4	4-0	3S400	STR												
<b>SPAN NO. 6</b>																	
Same as Span No. 4 except that Mark shall be 6S in lieu of 4S.																	
<b>SUBSTRUCTURE</b>																	
<b>ABUTMENT NO. 3</b>																	
47	4	4	3-0	3A405G	STR												
48	12		6-1	A													
49	4		6-6	B													
50	4		7-1	C													
51	4		7-9	D													
52	4		8-4	E													
53	16	4	8-6	3A405F													
54	*37	5	5-2	3A502													
55	*17	6	8-6	3A603B													
56	16		11-0	3A603A													
57	10		34-9	3A601	STR												
58	12	6	11-1	3A604	16	3-9	7-4							6-3		3-9	
<b>ABUTMENT NO. 4</b>																	
Same as Abut. No. 3 except that Mark shall be 4A in lieu of 3A and test bars shall be omitted.																	
<b>PIER NO. 3</b>																	
63	30	4	7-6	3P404	STR												
64	2		13-5	3P407B	T1	0-4 1/2	3-8	2-8	3-8	2-8						0-4 1/2	
65	2		15-1	3P407A	T1	0-4 1/2	3-8	3-6	3-8	3-6						0-4 1/2	
66	10	4	15-5	3P407	T1	0-4 1/2	3-8	3-8	3-8	3-8						0-4 1/2	
67	4	5	21-6	3P508	STR												
68	4	6	33-6	3P609	STR												
69	5	6	33-6	3P608	14	2-9	28-0	2-9						1-0			
70	*7	7	7-0	3P711	STR												
71	32		7-6	3P702													
72	10		16-0	3P701													
73	7		28-6	3P705													
74	60		28-10	3P706													
75	6		33-6	3P710	STR												
76	60	7	5-4	3P703	2	0-5	4-11										
77	*13	8	21-0	3P805	STR												
78	*7	9	28-6	3P901	STR												

Minimum bends to be as follows:  
 "Stirrups and tie bars shall be bent around a pin having a diameter not less than two times the minimum thickness of the bar. Bends for other bars shall be made around a pin having a diameter not less than six times the minimum thickness except for bars larger than 1 inch, in which case the bends shall be made around a pin of eight bar diameters."

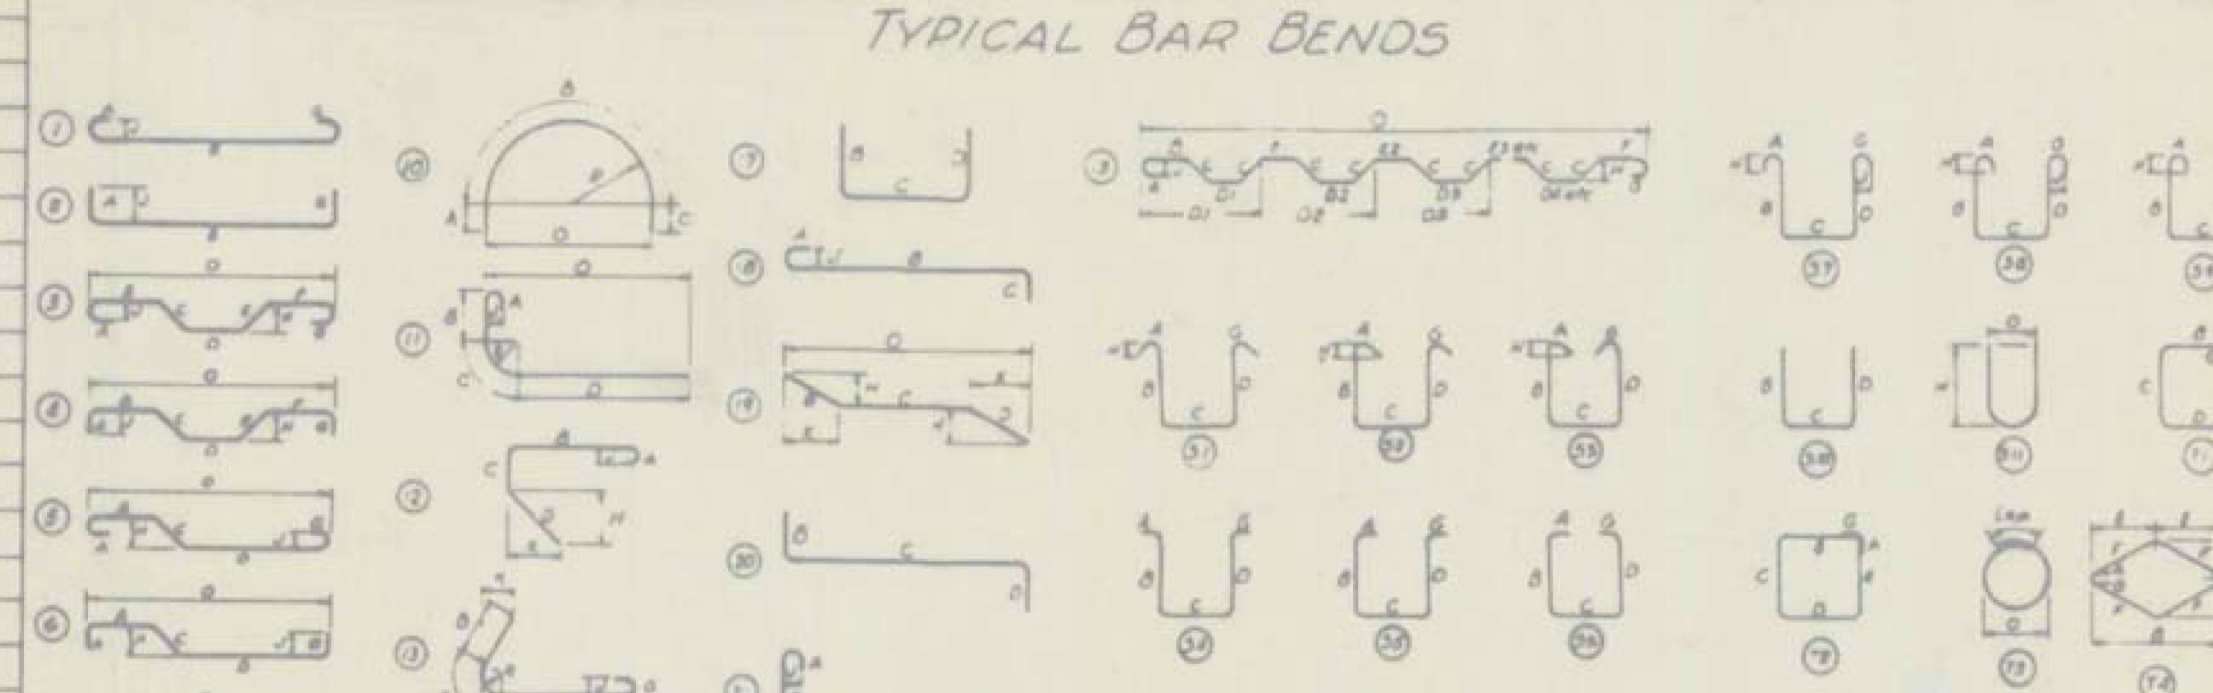

- NOTES**
- All dimensions are out to out of bar.
  - J' dimensions on 180° hooks to be shown only, where necessary to restrict hook size otherwise standard hooks are to be used.
  - Where J' is not shown, J' will be kept equal to or less than "4" where J can exceed "4", it should be shown.
  - H dimension on stirrups to be shown where necessary to restrict hooks.
  - Where bars are to be bent more accurately than standard bending tolerances bending dimensions which require closer marking should have limits indicated.
  - Figures in circles show types.
  - No allowance for bend curvature is to be made except for standard hook & radii in excess of same.

Item	No. Pieces	Size	Length	Mark	Type	A	B	C	D	E	F	G	H	J	K	R	O
143																	
144																	
145																	
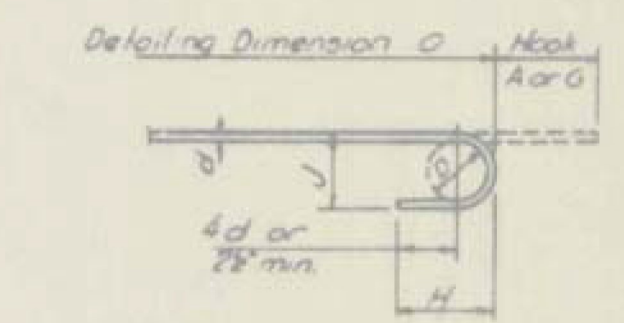

STANDARD HOOK DETAIL

**BAR SIZES**

Equivalent Size	Present (Numbers)
1/2"	#2
3/8"	#3
1/2"	#4
5/8"	#5
3/4"	#6
7/8"	#7
1"	#8
1 1/8"	#9
1 1/4"	#10
1 3/8"	#11



\* Denotes 1 Bar added for testing purposes.

8. Bar reinforcement metal shall conform to the requirements of the Standard Specifications for new Billet-Steel Concrete Reinforcement Bars (Intermediate Grade) Serial Designation AAS, N.O. M31-48 or its latest revision. All bars shall be deformed to conform with ASTM Specifications A305-49.

ESTIMATED QUANTITIES		BR. 308 OF 308	
Location	Pounds	FINAL	SWANTON-HIGHGATE
<b>STAGE I CONSTRUCTION</b>			
Approach Slab No. 3	3,550		North Bound
Approach Slab No. 4	3,520		I 89 OVER ST. J.F.L.C. R.R.
Sub-Total	7,070		REINFE STEEL SCHEDULE
Abutment No. 3	1,630		PROJECT No. I-89-3(32)
Abutment No. 4	1,610		
Span No. 4	12,600		
Span No. 5	13,480		
Span No. 6	12,600		
Pier No. 3	8,250		
Pier No. 4	8,250		
Sub-Total	58,250		
GRAND TOTAL	65,320		



**SWANTON  
IM 089-3(70)  
SHEET 23 OF 31  
FOR REFERENCE  
ONLY**

DRAWN BY: W. CHECKED BY: RLO  
SHEET 142 OF 240

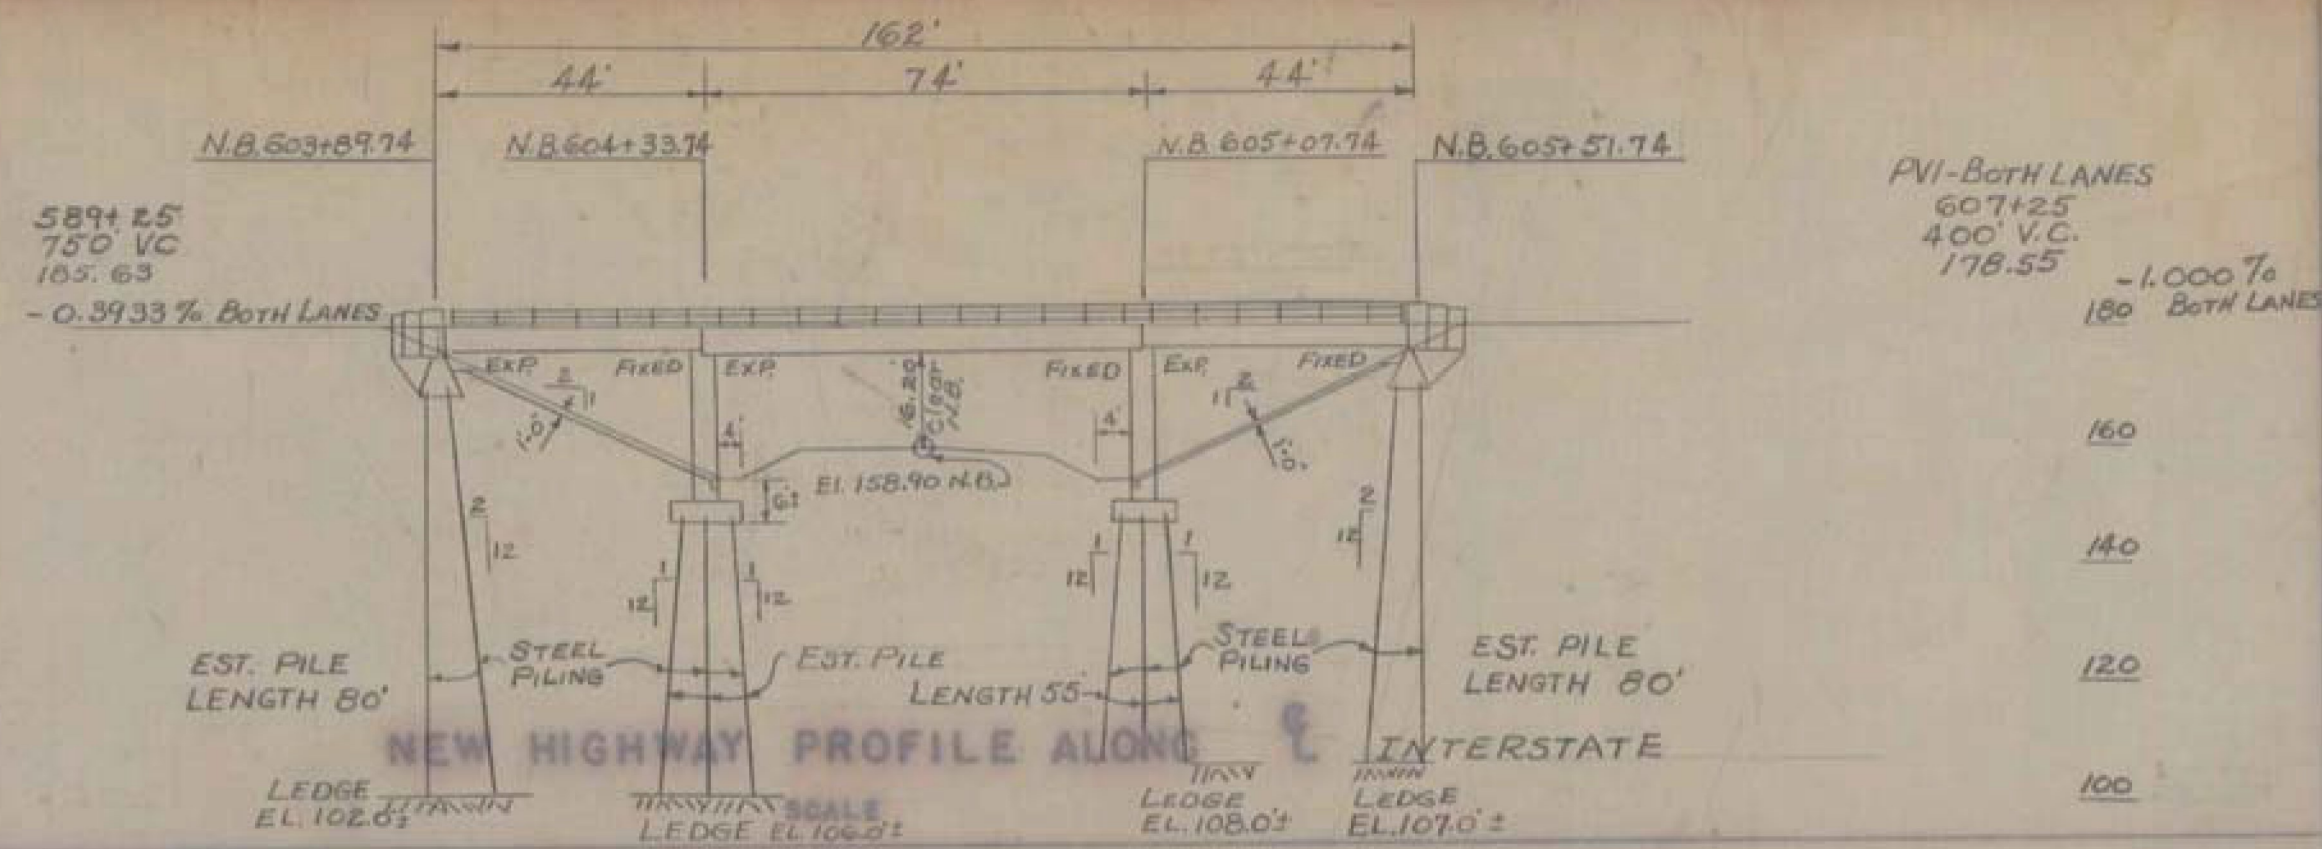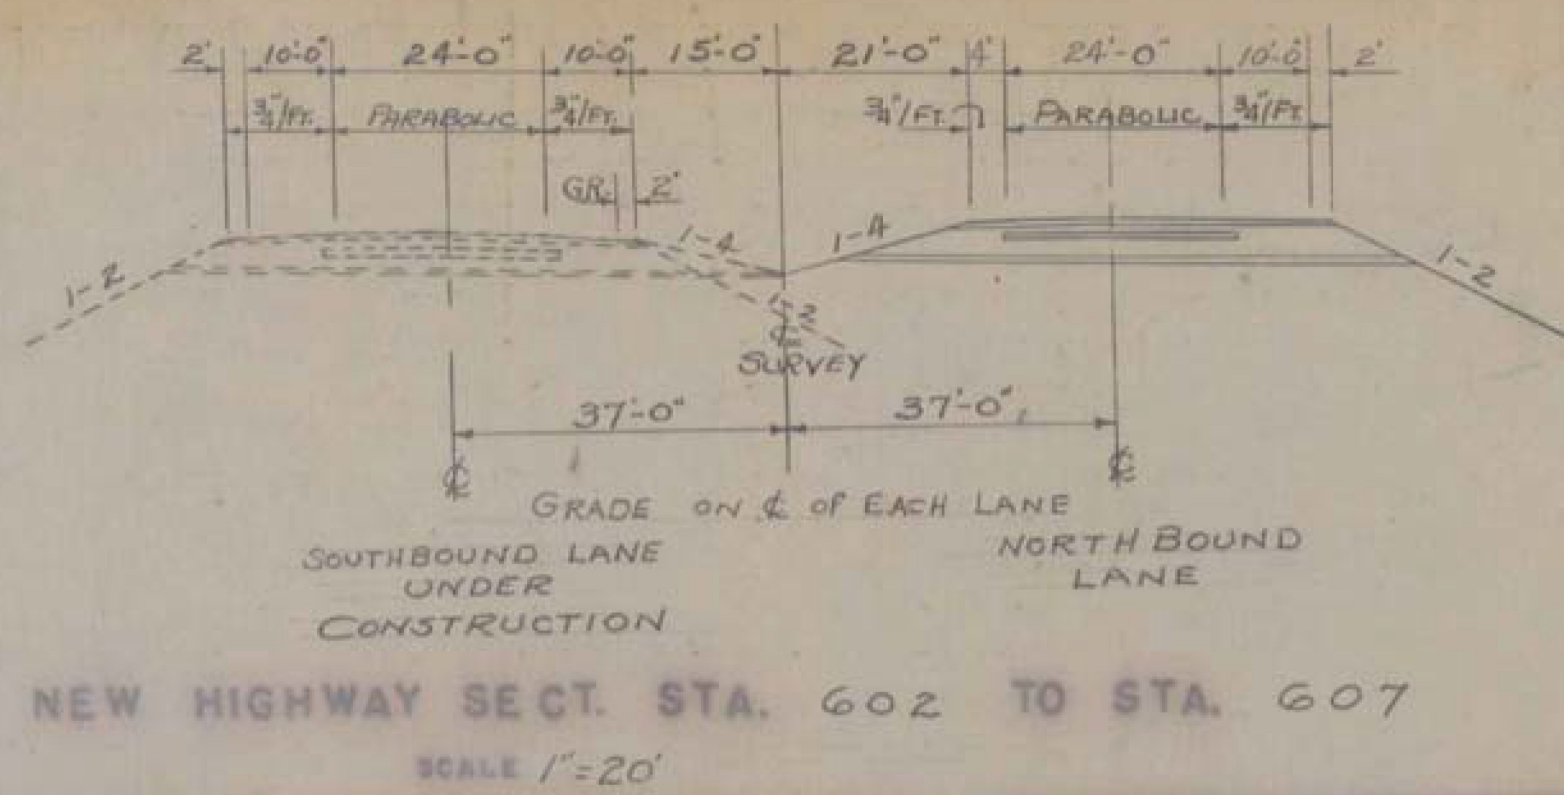


HIGHWAY NO. INTERSTATE NAME OF HIGHWAY SWANTON-HIGHGATE  
 COUNTY FRANKLIN TOWN SWANTON  
 PROJECT NO. 7-89-3(32) LOCATION 3/4 Mile east from intersection of Route 7

EXISTING STRUCTURE	
1 RATED LOADING OF EXISTING STRUCTURE	NA
2 TYPE OF EXISTING STRUCTURE	NA
3 UNDERCLEARANCE ELEVATION OF EXISTING STRUCTURE	NA
4 WHAT DISPOSITION SHOULD BE MADE OF EXISTING STRUCTURE	NA COST OF REMOVAL
5 SHOULD EXISTING STRUCTURE BE USED TO MAINTAIN TRAFFIC DURING CONSTRUCTION OF NEW STRUCTURE	NA
6 SHOULD NEW TEMPORARY STRUCTURE BE BUILT	NA
7 ORDINARY HIGH WATER SURFACE ELEV. AT EXISTING STRUCTURE	NA WATERWAY TO ORDINARY H.W. NA
8 EXTREME HIGH WATER AT EXISTING STRUCTURE	NA WATERWAY TO EXTREME H.W. NA
9 SPAN OF EXISTING BRIDGE UPSTREAM	NA WATERWAY TO EXTREME H.W. NA
10 TYPE OF FOUNDATION UNDER EXISTING ABUTMENTS	NA
11 DOES ALL WATER AT FLOOD ELEVATION PASS THROUGH EXISTING STRUCTURE	NA
12 IF NOT AT WHAT ELEVATION IS RELIEF AFFORDED	NA
13 ADDITIONAL WATERWAY AREA PROVIDED	NA
NEW STRUCTURE	
1 RECOMMENDED TYPE OF STRUCTURE	W/ COMPOSITE
2 RECOMMENDED CLEAR SPAN OR SPANS	40' 70' - 40'
3 MEASURED PARALLEL TO NEW HIGHWAY	40' 70' 40'
4 MEASURED AT RIGHT ANGLES TO STREAM	40' 70' 40'
5 ARE THERE OBJECTIONS TO A PIER IN THE STREAM, ANSWER YES OR NO	NA
6 ORDINARY HIGH WATER ELEVATION AT NEW STRUCTURE	NA SOURCE OF INFORMATION
7 EXTREME HIGH WATER ELEVATION AT NEW STRUCTURE	NA SOURCE OF INFORMATION
8 DOES STREAM REACH ITS MAXIMUM HIGH WATER ELEVATION RAPIDLY?	NA IS ORDINARY RISE RAPID?
9 LOW WATER ELEVATION AT NEW STRUCTURE	NA
10 DRAINAGE AREA IN ACRES ABOVE STRUCTURE	NA CHARACTER OF TERRAINE
11 IS STREAM EVER DRY?	NA
12 VELOCITY OF STREAM AT HIGH WATER STAGE	NA ESTIMATED DISCHARGE
13 AREA FULL OPENING	NA AREA BELOW ORDINARY H.W. NA
14 CHARACTER OF SOIL	NA DRIFT ICE
15 ESTIMATED DRAINAGE AREA ABOVE NATURAL OR ARTIFICIAL STORAGE	NA
16 VERTICAL CLEARANCE ABOVE FLOOD ELEVATION	NA
17 ARE SIDEWALKS REQUIRED, IF SO ON WHAT SIDE	NO BOTH SIDES
18 RECOMMENDED TYPE OF PAVEMENT	BIT. CONCRETE
19 TRAFFIC TO BE MAINTAINED UNDER (TUN NO. NA ONE OR TWO WAYS PROBABLE DIRT	
20 PROBABLE COST OF CLEANING AND GRUBBING STREAM CHANNEL AT STRUCTURE SITE	NA
21 SHOULD PROVISIONS BE MADE FOR PUBLIC UTILITIES?	
22 ESTIMATED ALLOWABLE LOAD ON FOUNDATIONS	35 TONS SHOULD PILES BE USED STEEL 55'-80'

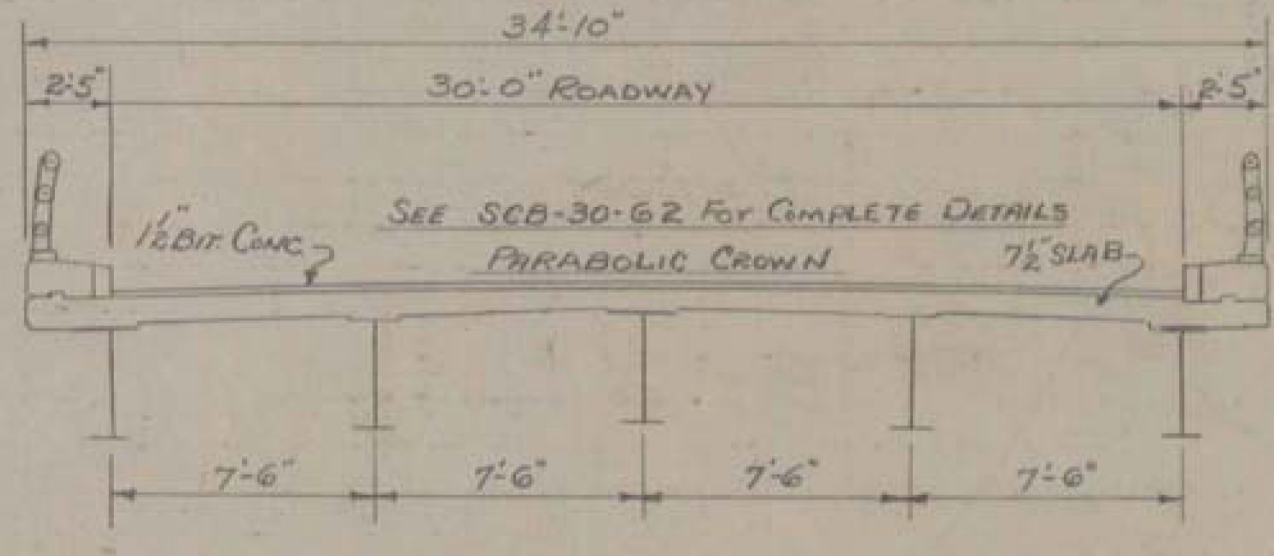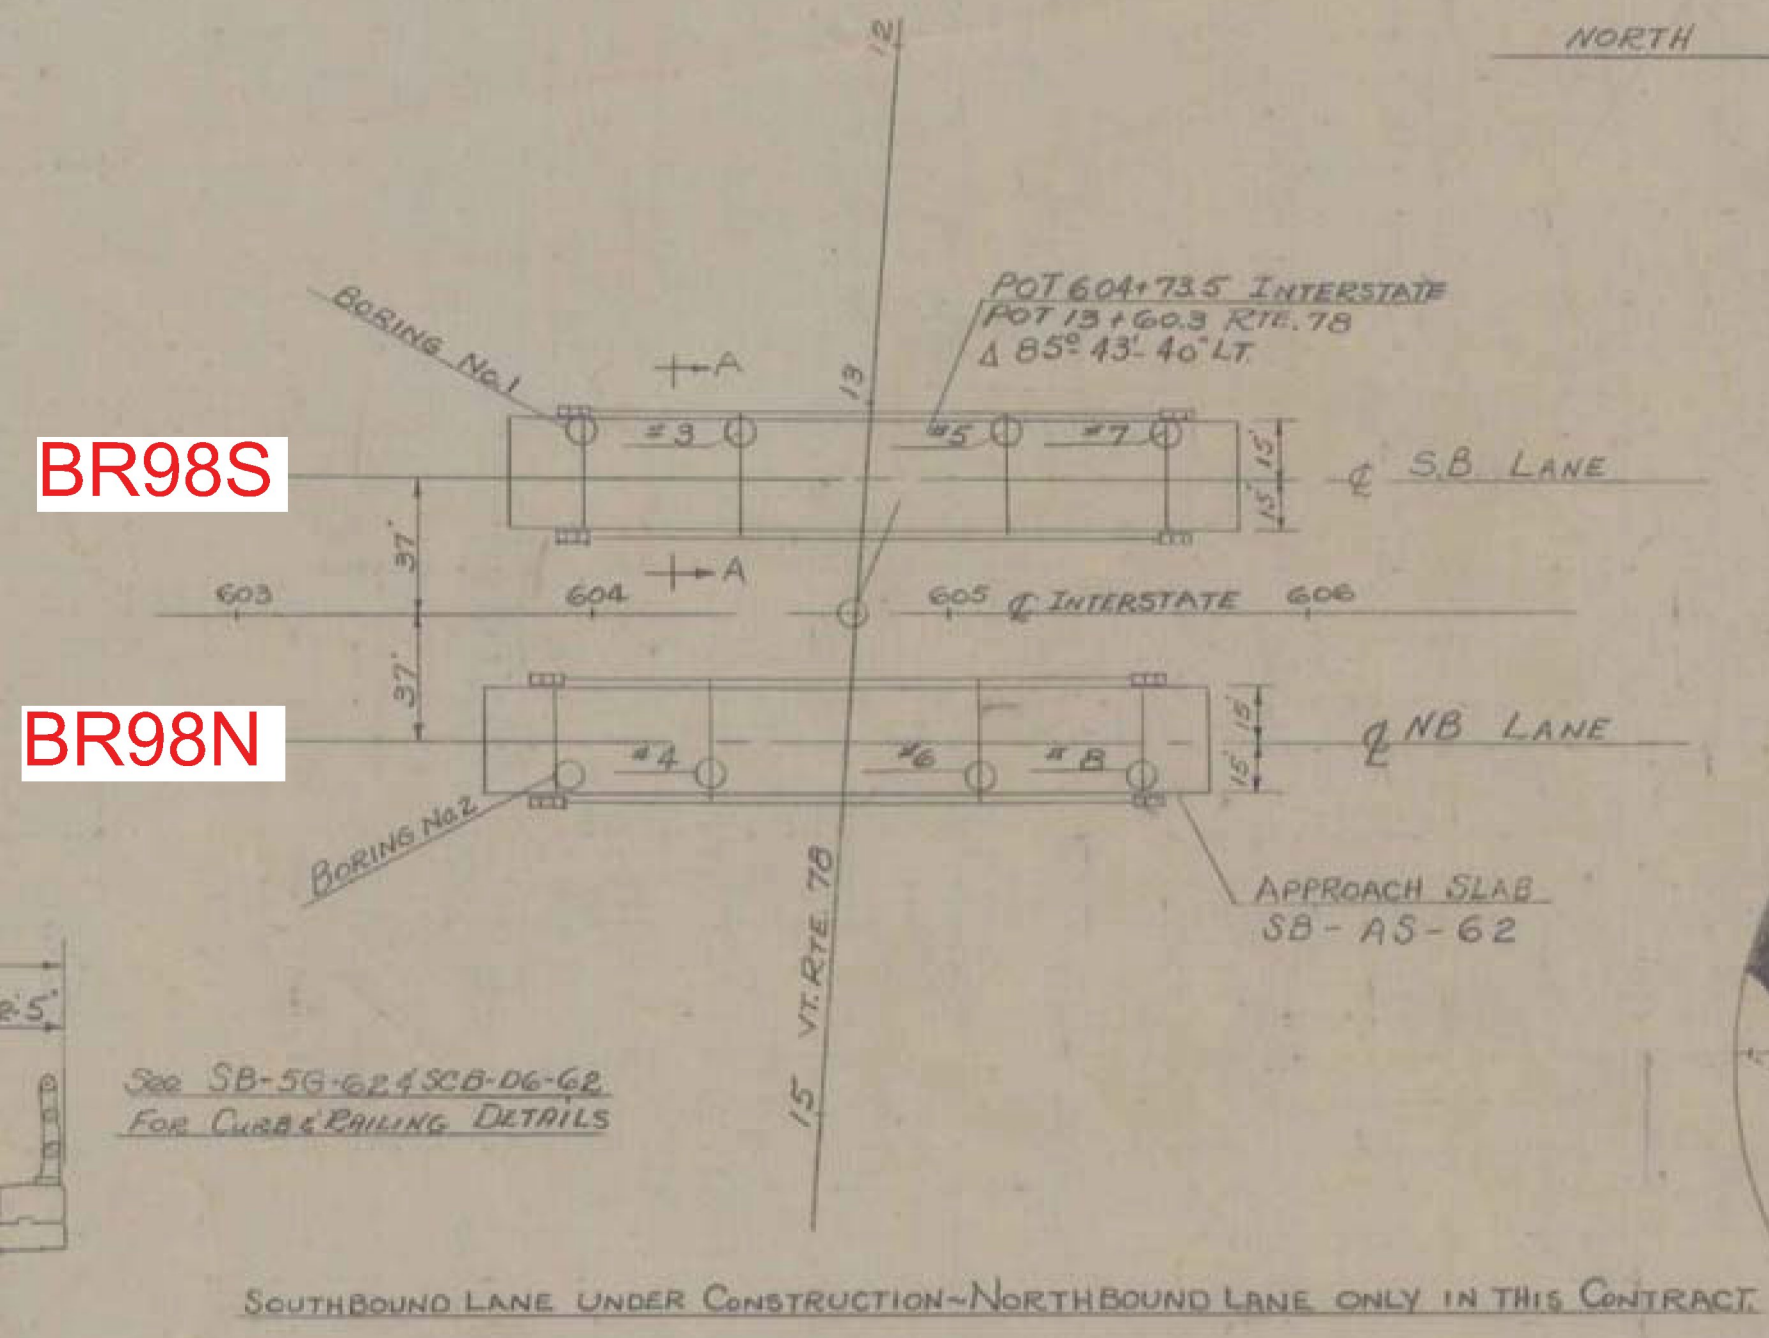


**BR98N&S**

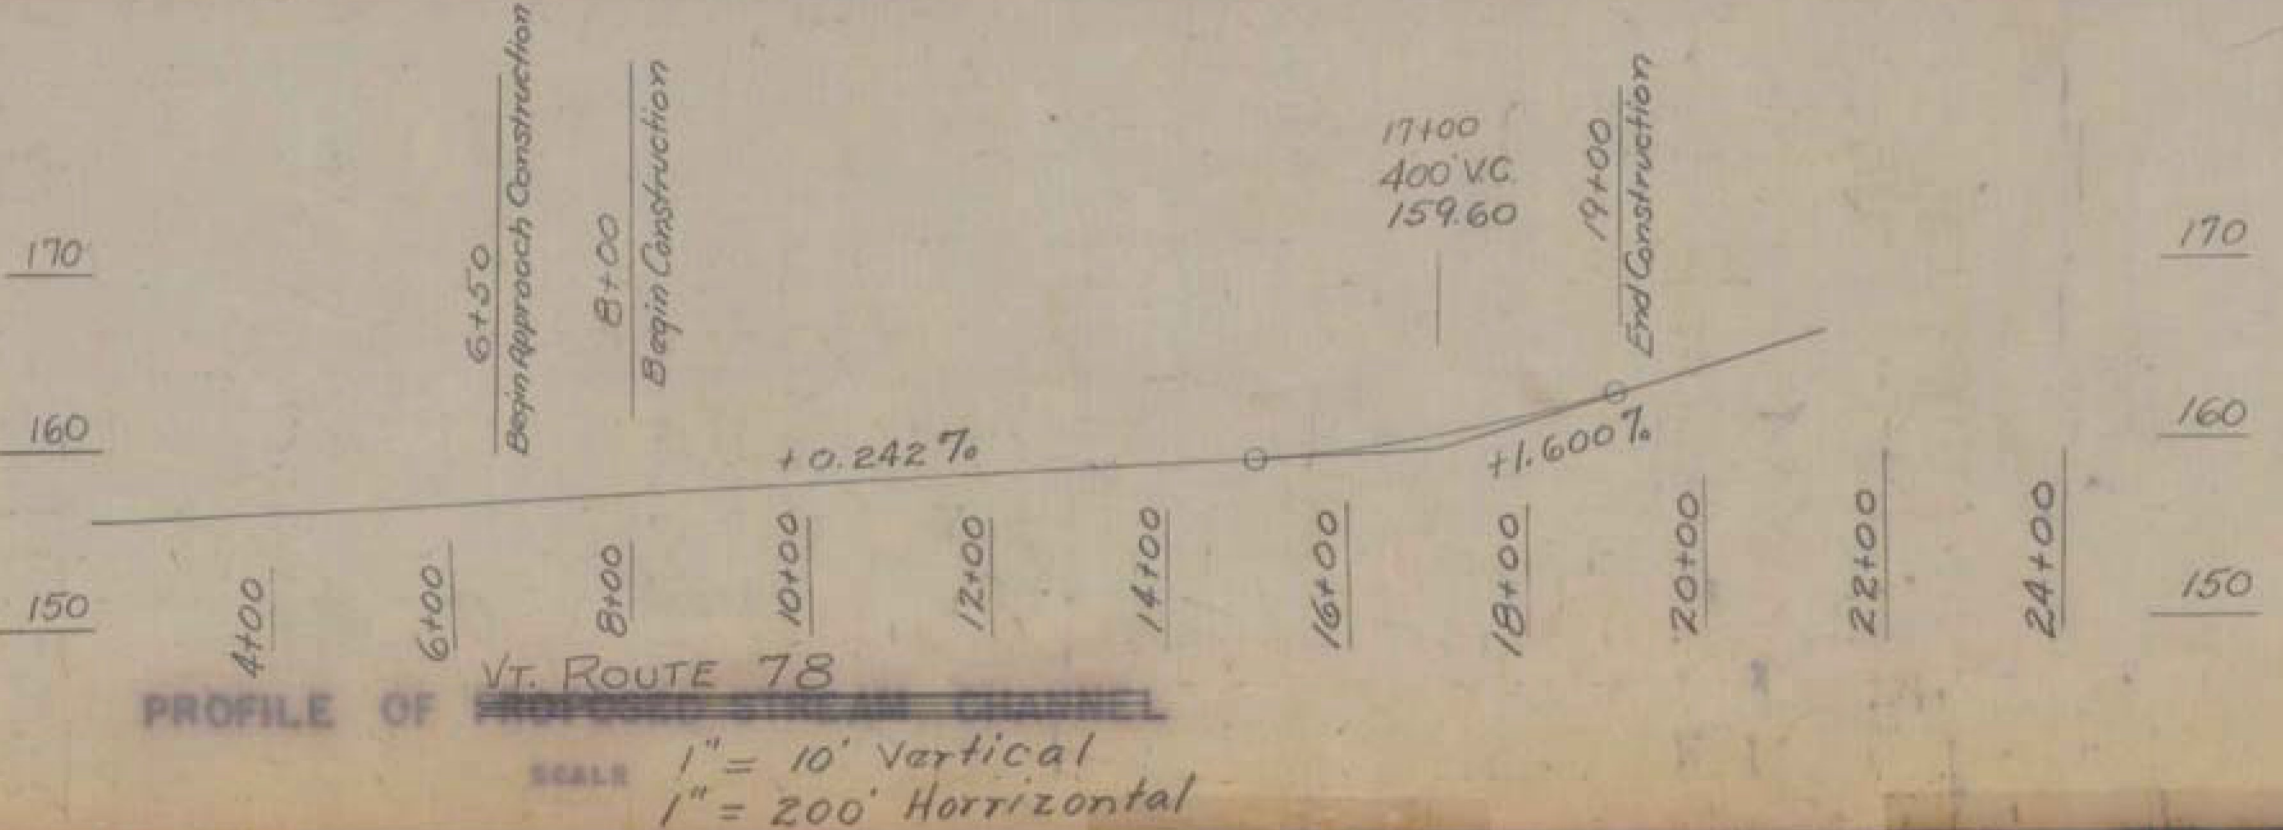

**FOUNDATION INFORMATION**  
 OBTAINED FOR DESIGN PURPOSES ONLY, AND THE STATE ASSUMES NO RESPONSIBILITY WHATSOEVER FOR THE SUFFICIENCY OR ACCURACY OF THE INFORMATION SHOWN. SOULERS MAY BE ENCOUNTERED AT ANY PIER OR ABUTMENT LOCATION.  
 FOR BORINGS SEE BR SHEET #402

**SWANTON**  
**IM 089-3(70)**  
**SHEET 24 OF 31**  
**FOR REFERENCE ONLY**


**STAGE I & II CONSTRUCTION**  
 STATE OF VERMONT  
 DEPARTMENT OF HIGHWAYS  
 INTERSTATE BRIDGE IN THE TOWNS OF  
 SWANTON - HIGHGATE  
 ROUTE NO 189-3(32) STA 604+73.5  
 INTERSTATE OVER VT 78  
 PRELIMINARY INFORMATION SHEET  
 PROJECT NO 189-3 SHEET 24 OF 246  
 (38) BR 400 of 407  
 Sheet 119 of 122

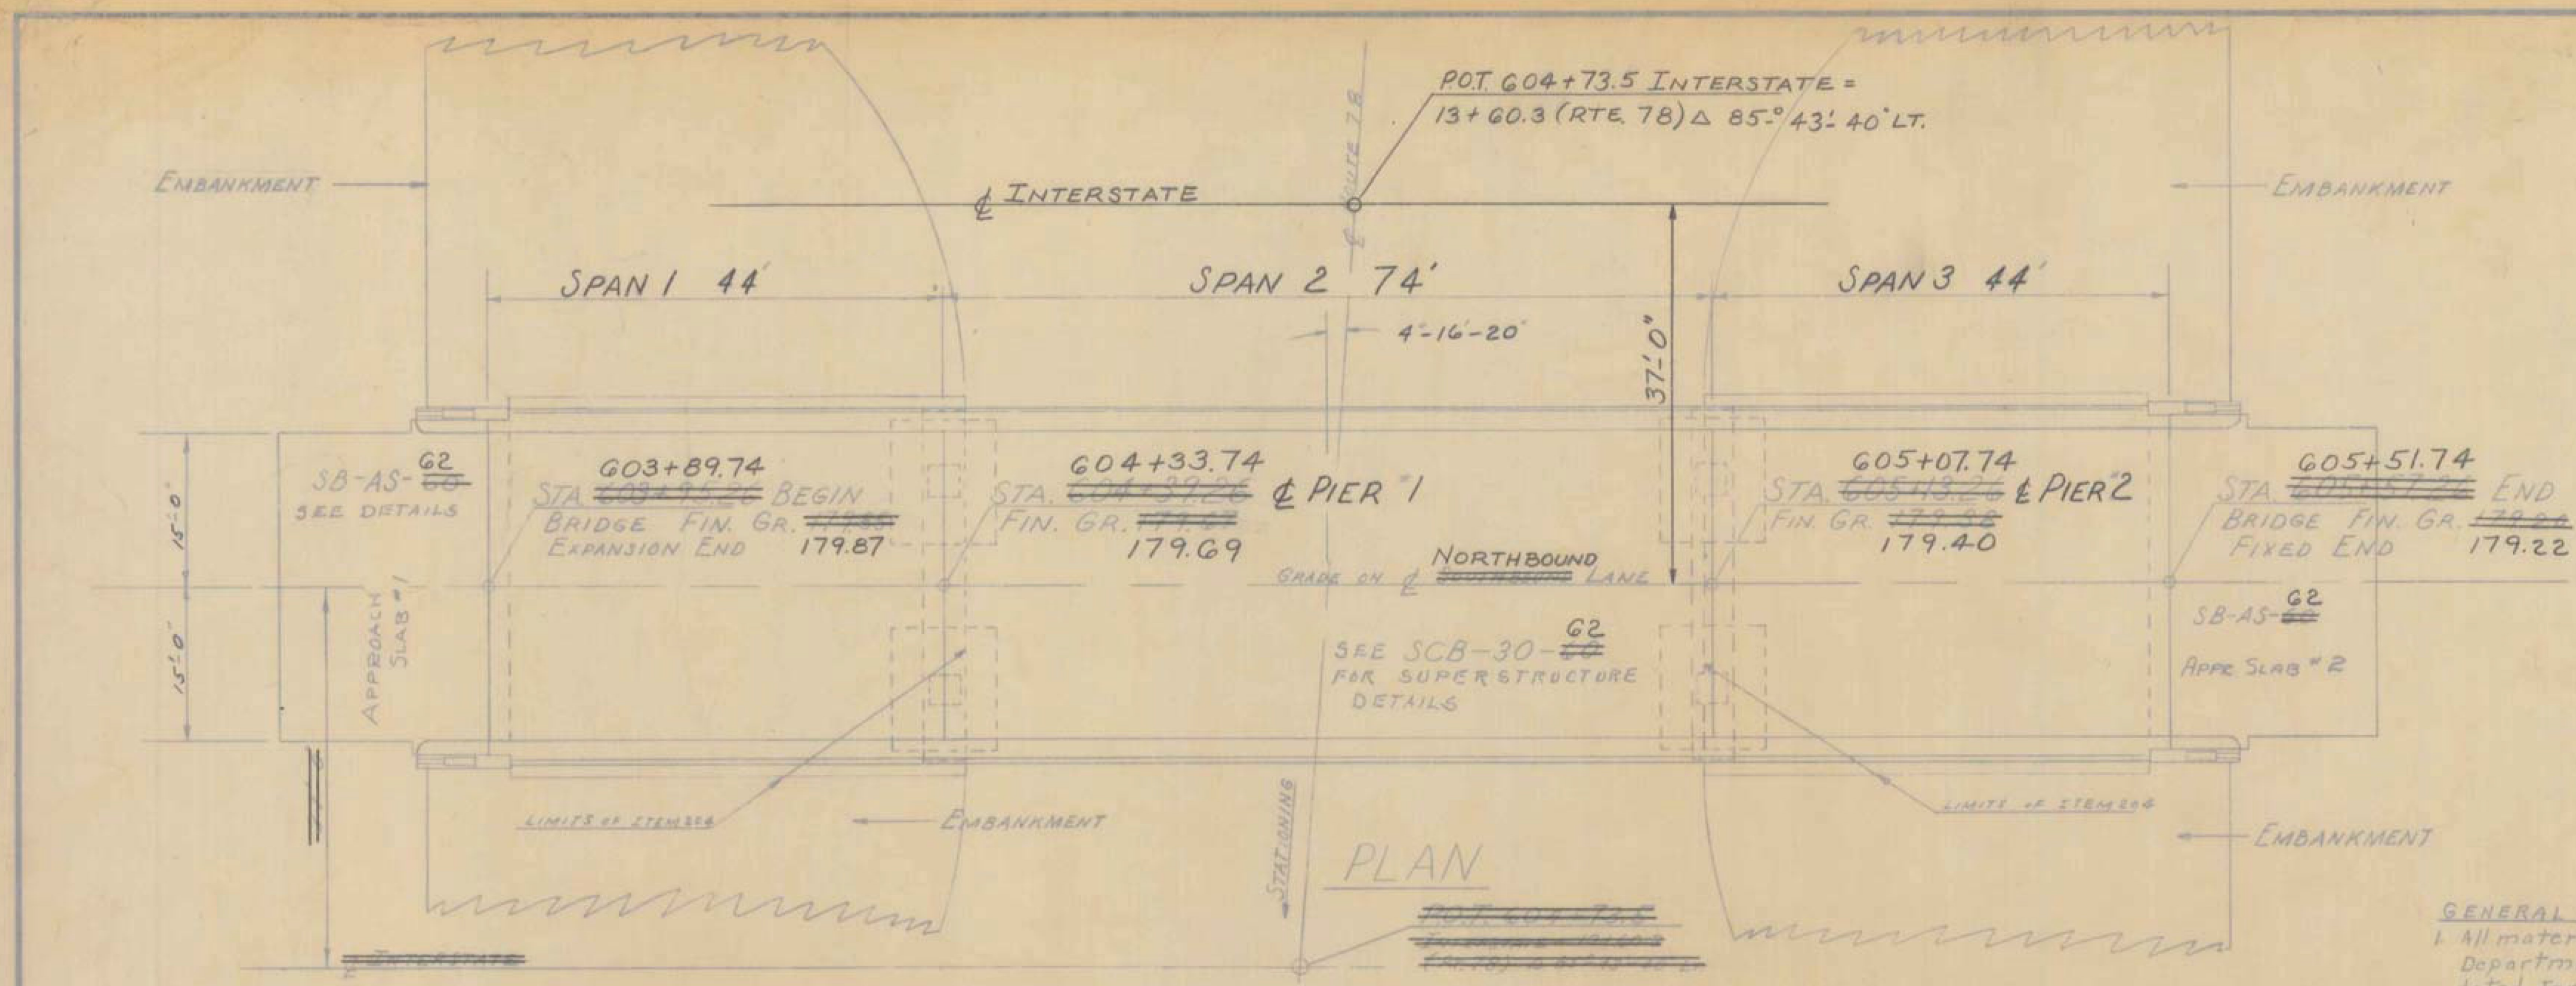

**ESTIMATED QUANTITIES (BRIDGE ONLY)**

ITEM*	ITEM	UNIT	NET	TOTAL STAGE I	TOTAL STAGE II	FINAL #
107	STRUCTURE EXCAVATION	C.Y.	<del>160</del>			130
204	SUB-BASE OF CRUSHED ROCK MOD. UNDER STRUCTURE	C.Y.	<del>97</del>			109
222	Gravel Backfill	C.Y.	<del>36</del>			0
* 318	TAR EMULSION FOR BRIDGE FLOORS	GAL		270		0
* 373	RUBBER JOINT MATERIAL	L.F.	<del>128</del>			122
* 361-B	BIT. CONC. PAV'T.	TON		66		0
401-B	CONCRETE CLASS B, MOD.	C.Y.	<del>242</del>			245
402	REINFORCING STEEL	LB.	<del>66,560</del>			66,499
403	SPIRAL REINFORCEMENT @2040	LB.	<del>1,000</del>			1,000
404-A	STRUCTURAL STEEL	LB.	<del>156,220</del>			156,172
407	ASPHALTIC-ASBESTOS COATING	S.Y.	<del>35</del>			36
501	FURNISHING EQUIPMENT FOR DRIVING PILES	L.S.		14		14
401-AA	CONCRETE CLASS AA, MOD.	C.Y.	<del>784</del>			183
503	SPLICES FOR STEEL PILING	EA.	<del>32</del>			20
504	STEEL PILING (123P53)	L.F.	<del>3,620</del>			3,287
556-C	GRANITE BRIDGE CURB MOD.	L.F.	<del>356</del>			355
572	BRIDGE RAILING (GALVANIZED METAL)	L.F.	<del>315</del>			315
* 372-A	JOINT SEALER HOT BURIED	L.F.		60		0
594	UNIFORMED TRAFFIC OFFICERS	MAN HR.				0
* 102-A	GRANULAR BORROW	C.Y.		2160		0
* Note:	These items to be included in roadway quantities					
	Cut-offs @ 50% Unit Price	L.F.		0		333

- GENERAL NOTES**
- All material and construction shall conform to the State of Vermont Department of Highway, Standard Specifications for Road and Bridge Construction dated Jan. 1956 and the AASHTO Standard Specs. dated 1957. Designed for AASHTO leading modified for National System of Interstate Highways applied in accordance with the provision of the AASHTO Standard Specifications, Article 1.2.B.
  - Where rock is encountered no footing shall be poured until all blasting in an area 300 feet from the structure has been completed.
  - Final coat of field paint shall be green unless otherwise directed by the Engineer.
  - All dimensions given are measured horizontally or vertically unless otherwise noted.
  - All dimensions given at 68°F.
  - All reinforcing steel to have a clearance of 3" unless otherwise noted.
  - All exposed edges of concrete shall be chamfered 1" x 1" unless otherwise noted.
  - Borings indicated on the drawings have been made for design purposes only and are not warranted to show actual subsurface conditions.
  - Elevation sea level based on nearest U.S. Government Vertical Control.
  - Steel bearing piles shall be driven to ledge rock unless otherwise approved by the Engineer. When piles are driven in till, the material should be such as to have no stones large enough to interfere with the driving of piles.
  - Cross slope of approach slab to conform with the cross slope of bridge.
  - The top surfaces of all piers and abutments shall be sloped 4" per foot from the front edge of abutment curtain wall or center line of piers, except for bearing pads projecting 1" or more above the general area, which surfaces shall be level. The entire exposed top surface of abutment and piers shall be coated with asphaltic Asbestos coating 6" thick as per item 407 of the specs. The application of this item shall be after all painting and incidental items are completed.
  - Unless otherwise called for all beams shall be cambered as specified on Standard Structures ~~SCB-DI-G2~~ SCB-DI-G2
  - All expansion material shall be premoised cork containing no Tar or asphalt.

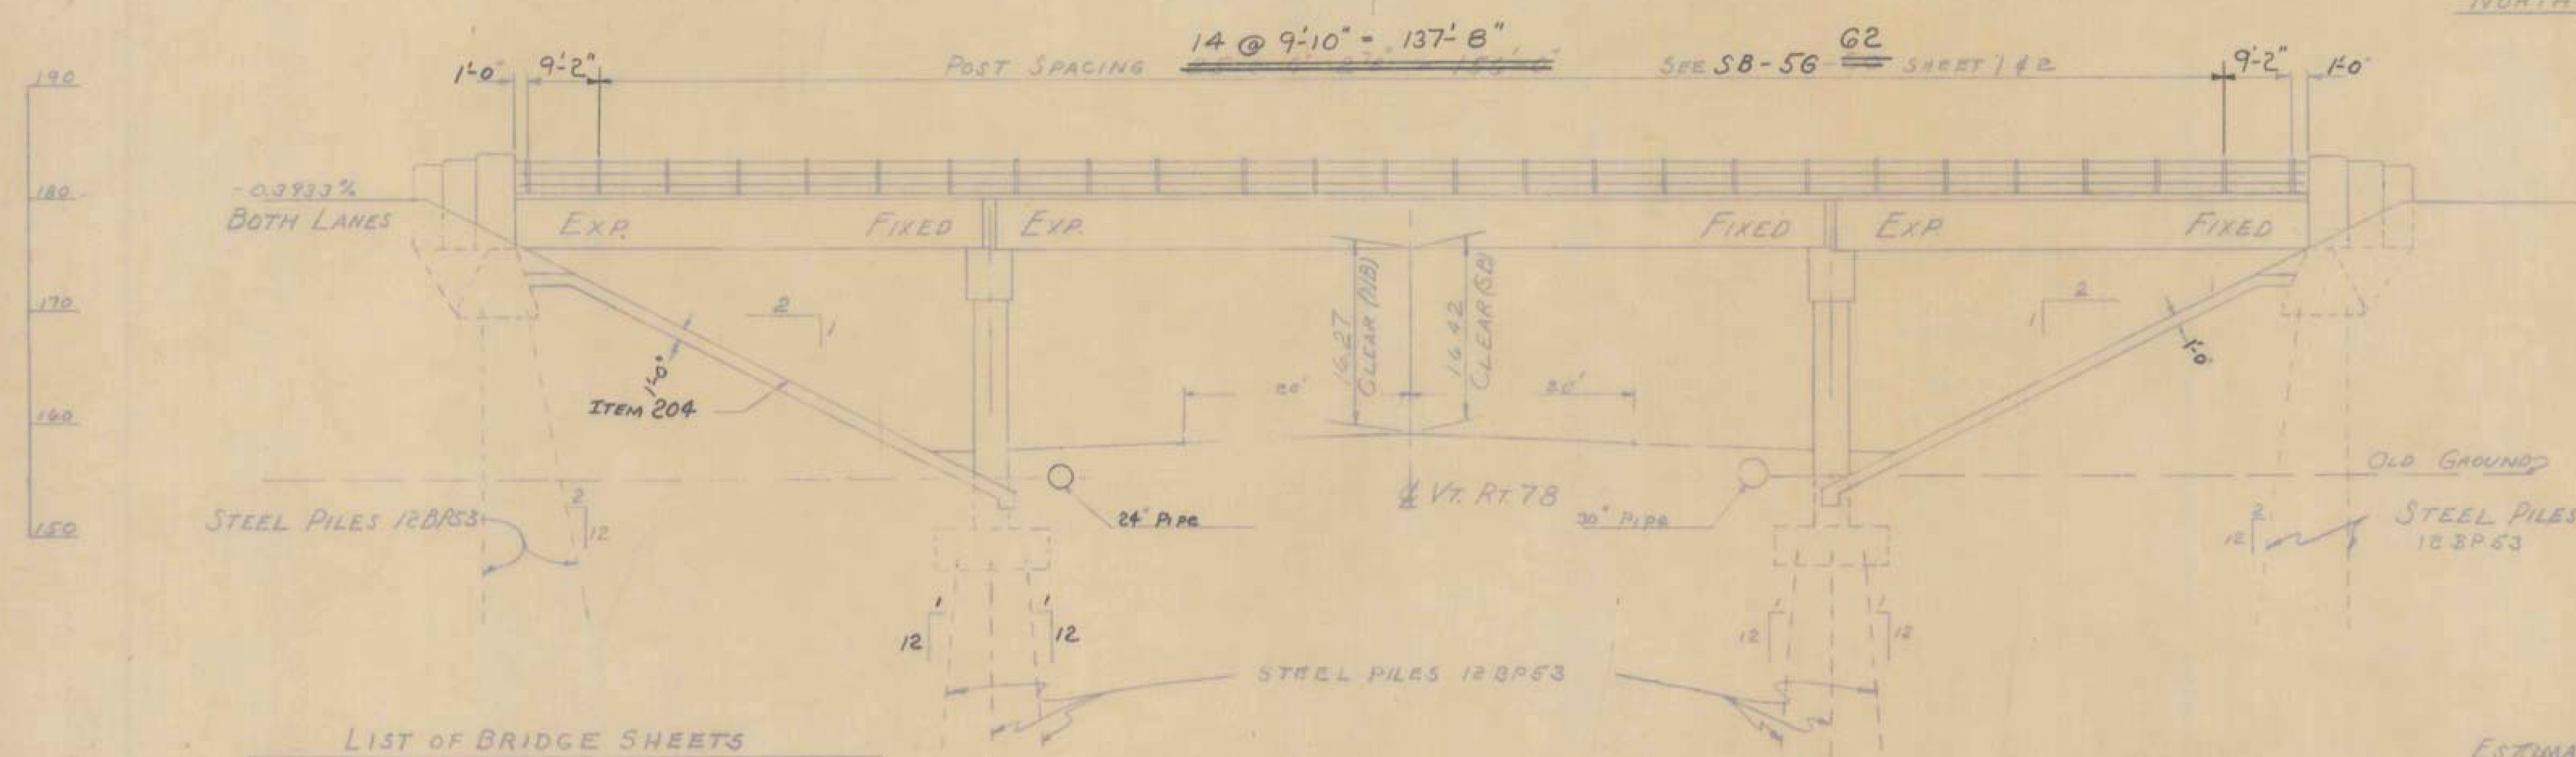

**LIST OF BRIDGE SHEETS**

SHEET NO.	TITLE
BR # 400	PRELIMINARY INFORMATION
BR # 401	PLAN & ELEVATION
BR # 402	BORINGS
BR # 403	DETAILS OF ABUTTS. (NORTH)
BR # 404	DETAILS OF PIER 1 & 2
BR # 405	REINFORCING STEEL SCHEDULE
BR # 406-407	SB-AS G2
	SCB-30-G2
	SCB-DI-G2 THRU SCB-D9-G2
	SB-56-G2 SHEET 1 & 2
	SB-56-G2
	SB-56-G2
	Std. E-2, Barricades, Signs & Lights (for Bridges)

**ESTIMATED SUPERSTRUCTURE QUANTITIES**

ITEM*	ITEM	UNIT	NET	FINAL #
* 361-B	BIT. CONC. PAVEMENT	TON	54	
401-AA	CONCRETE CLASS AA MOD.	C.Y.	<del>784</del>	183
402	REINFORCING STEEL	LB.	SEE REINF. SCHEDULE	
403	SPIRAL REINFORCEMENT @2040	LB.	1	1
* 318	TAR EMULSION FOR BRIDGE FLOORS	GAL.	216	
404-A	STRUCTURAL STEEL	LB.	<del>156,220</del>	156,172
556-C	GRANITE BRIDGE CURB MOD.	L.F.	324	323
572	BRIDGE RAILING (GALVANIZED METAL)	L.F.	315	315
* 372-A	JOINT SEALER HOT BURIED	L.F.	60	
373	RUBBER JOINT MATERIAL	L.F.	122	122
<b>APPROACH SLAB QUANTITIES</b>				
* 361-B	BIT. CONC. PAVE.	TON	12	
401-B	CONCRETE CLASS B, MOD.	C.Y.	<del>57</del>	49
402	REINFORCING STEEL	LB.	SEE REINF. SCHEDULE	
556-C	GRANITE BRIDGE CURB MOD.	L.F.	32	32
* 318	TAR EMULSION FOR BRIDGE FLOORS	GAL.	54	
* Note:	These items to be included in roadway quantities			

**STATE OF VERMONT**  
DEPARTMENT OF HIGHWAYS

TOWN OF SWANTON - HIGHGATE

ROAD NO. I-89 BRIDGE NO. \_\_\_\_\_

INTERSTATE OVER ROUTE 78

PLAN & ELEVATION (N.B.)

SCALE 1" = 10'-0"


SURVEYED BY WHEELER & WHEELER A.J.C. (N.B.) J.J.C. (N.B.)

DRAWN BY A.J.C. CHECKED BY WHEELER


PROJECT NO. I-89-3 (3a)

SHEET 25 OF 31

SWANTON  
 IM 089-3(70)  
 SHEET 25 OF 31  
 FOR REFERENCE  
 ONLY

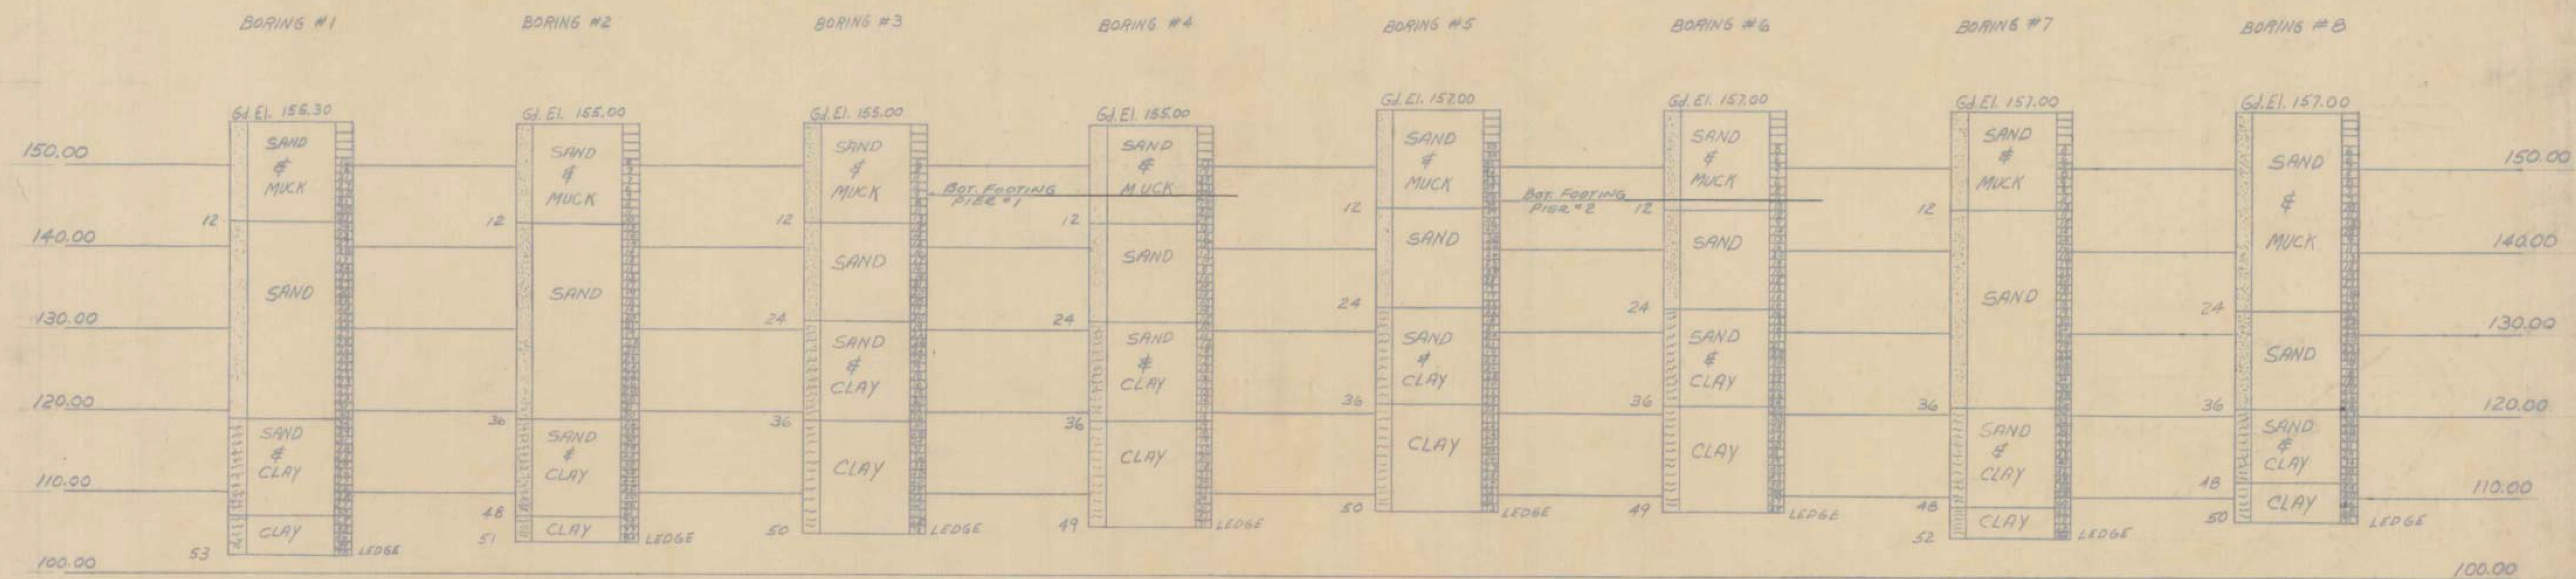

BORING SCALE 1" = 10' VERTICAL

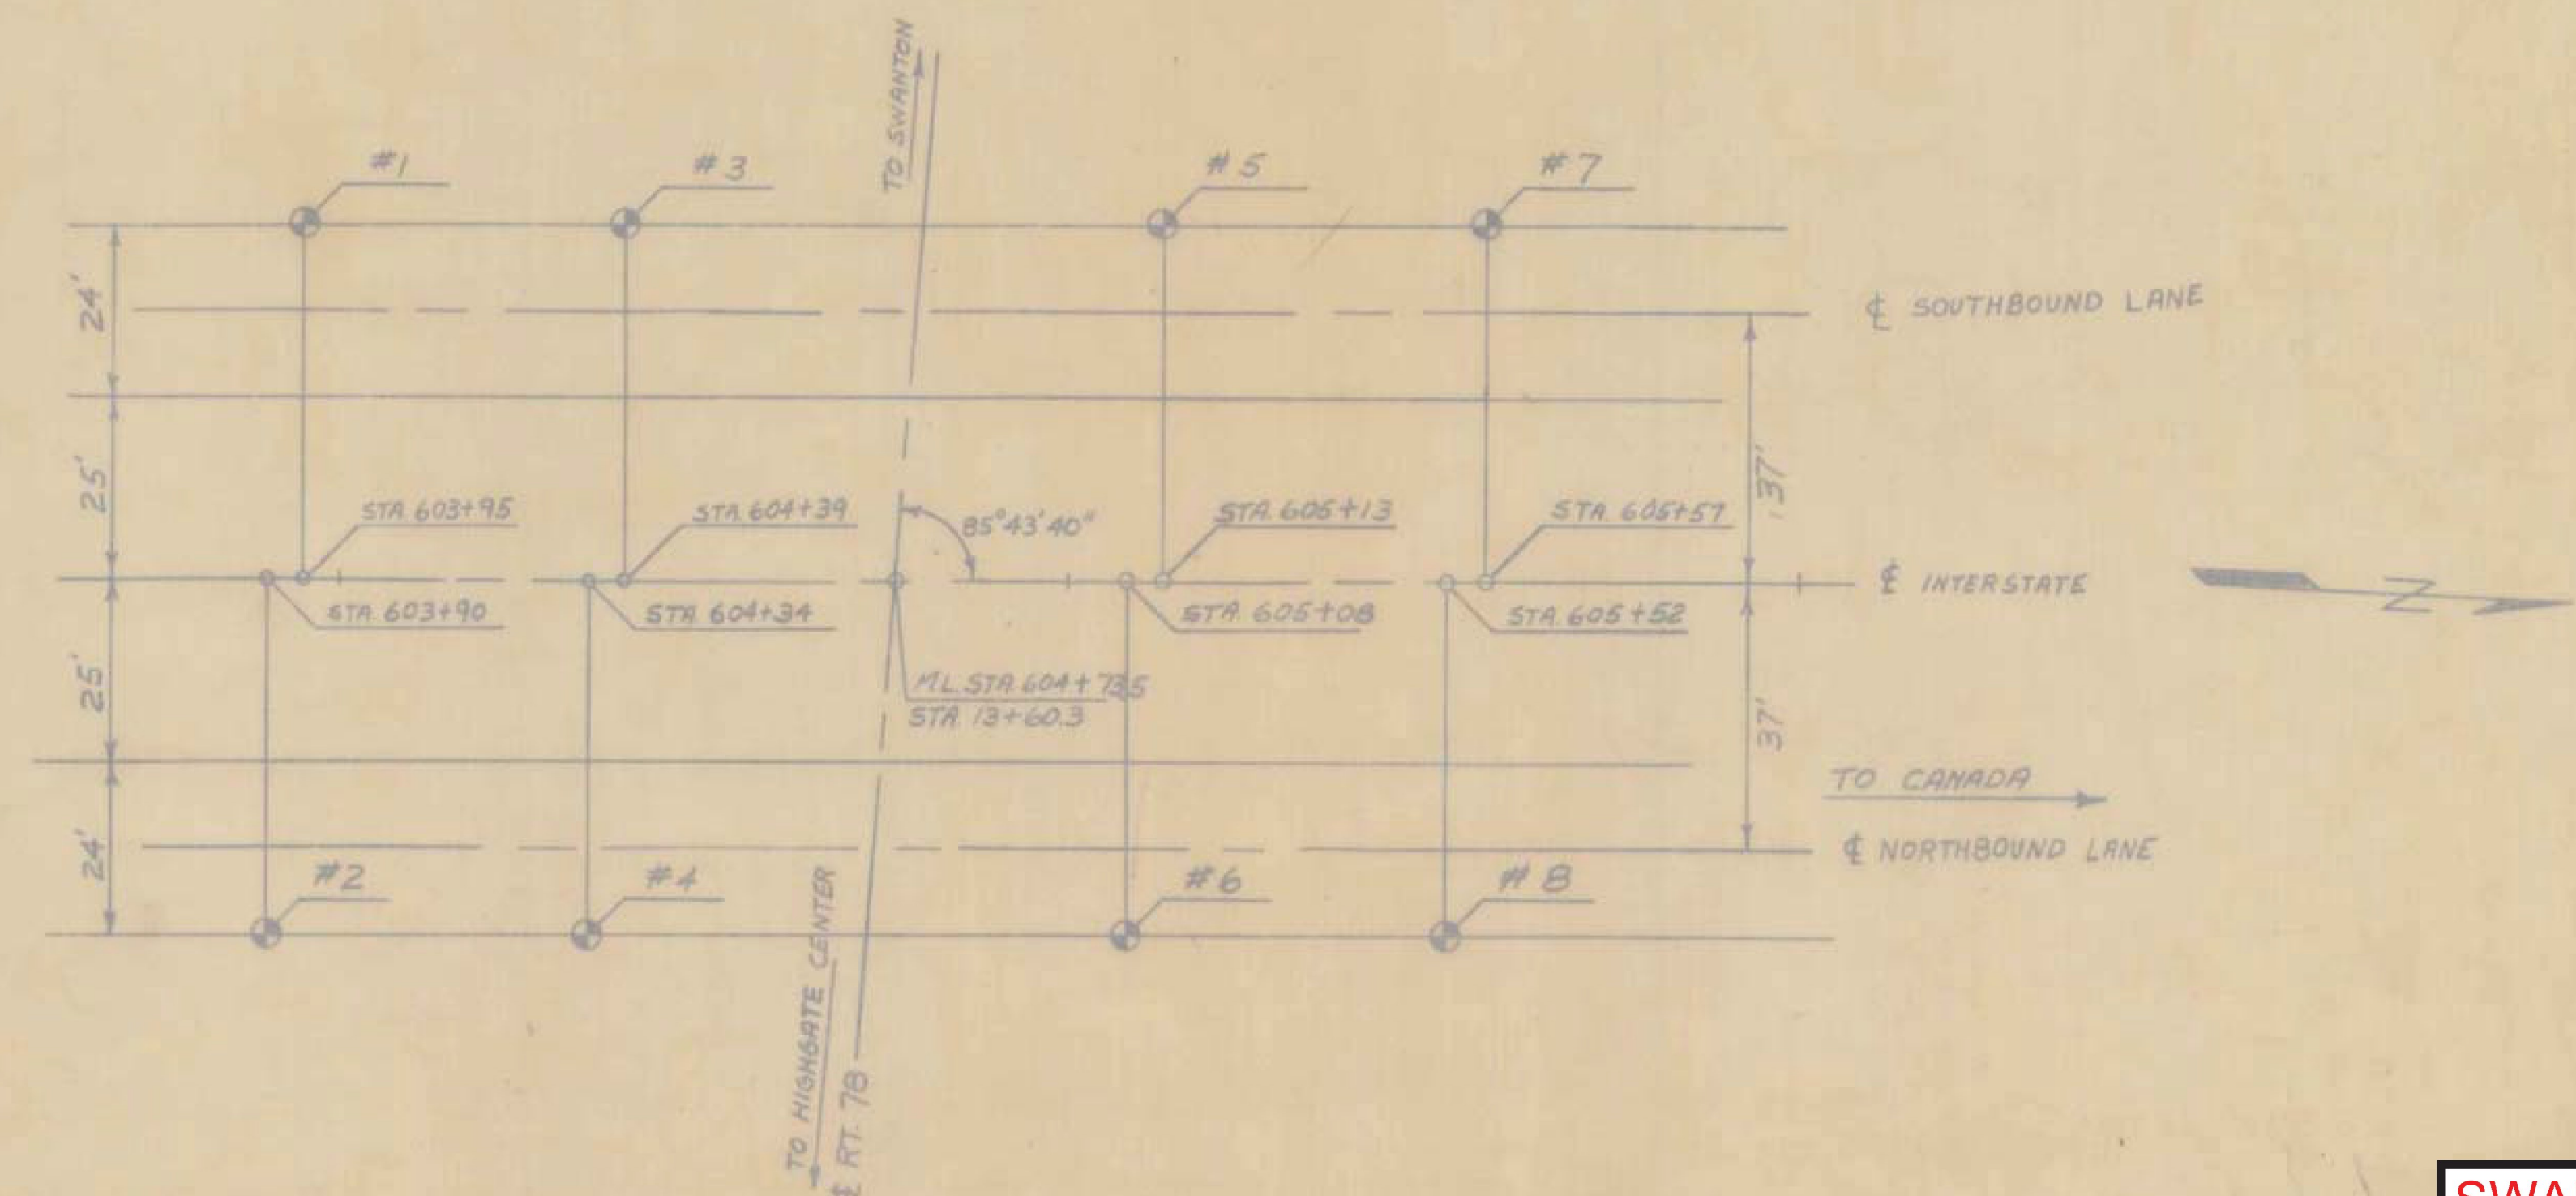


PLAN BORING LOCATIONS SCALE 1" = 20'

SWANTON  
 IM 089-3(70)  
 SHEET 26 OF 31  
 FOR REFERENCE  
 ONLY

STATE OF VERMONT  
 DEPARTMENT OF HIGHWAYS

TOWN OF SWANTON-HESKETT  
 ROUTE No. I-89 LOG STA  
 BORINGS  
 ML STA 604+735 - RT. 78  
 SCALE AS NOTED  
 SURVEYED BY STANTON  
 DRAWN BY P.A.  
 PROJECT No. I-89-3(32)  
 SHEET 125 OF 246




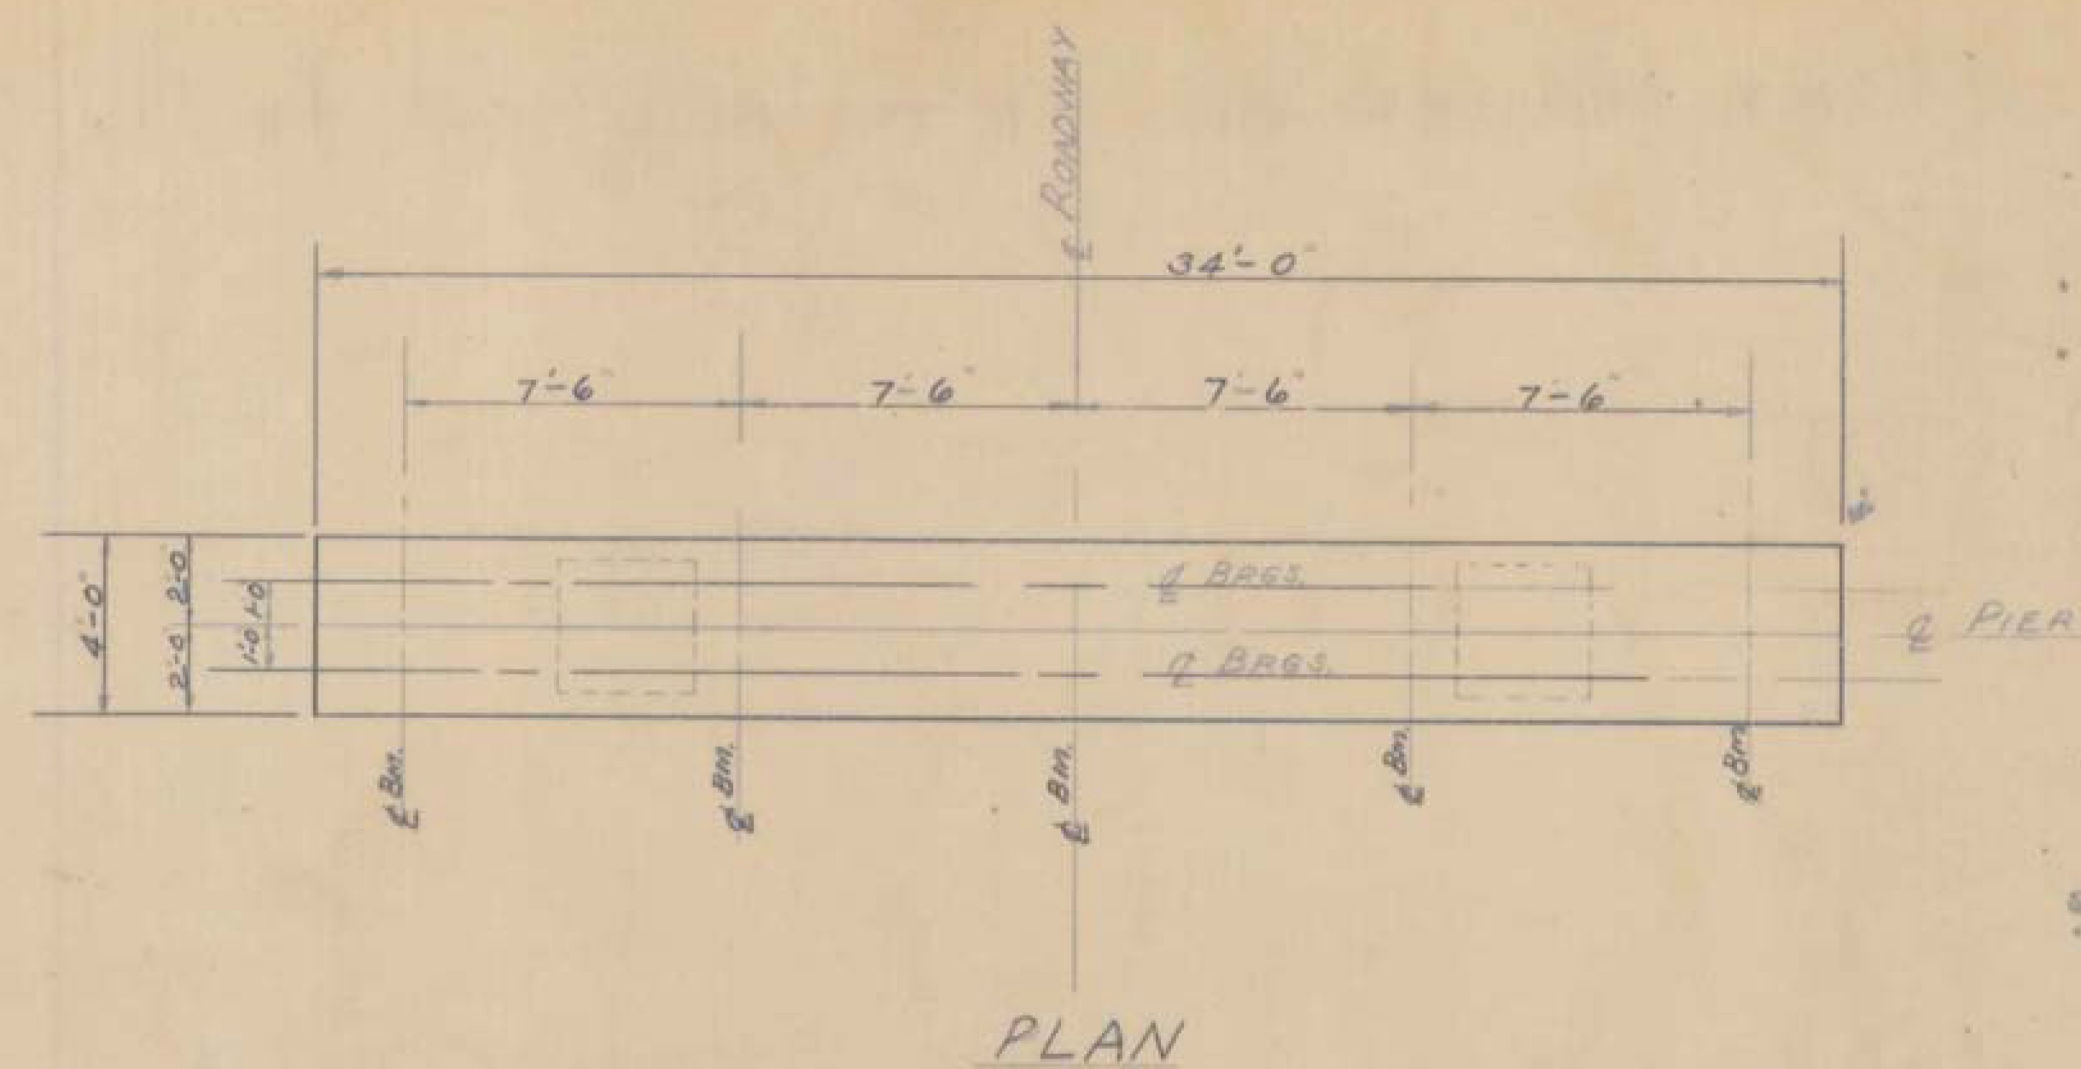


PLAN

175.23	174.94	q. 2m	174.78	174.94
175.51	175.21	q. 2m	175.06	175.21
175.61	175.31	q. 2m	175.16	175.31
175.51	175.21	q. 2m	175.06	175.21
175.23	174.94	q. 2m	174.78	174.94

PIERS - BRIDGE SEAT ELEVATIONS

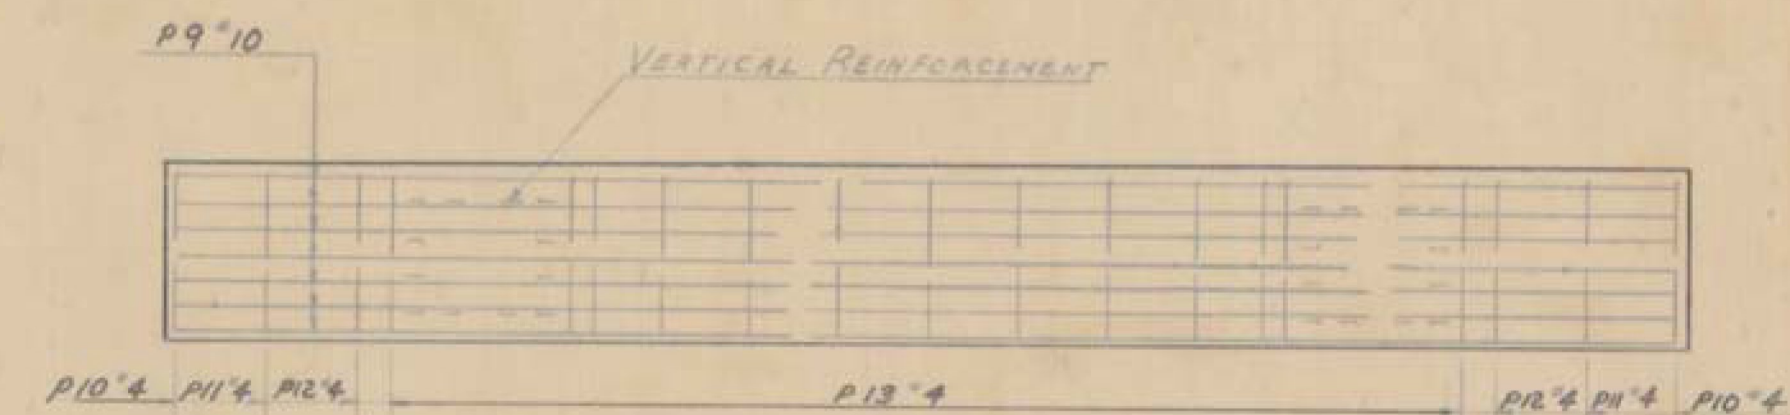


CAP REINFORCEMENT - TOP

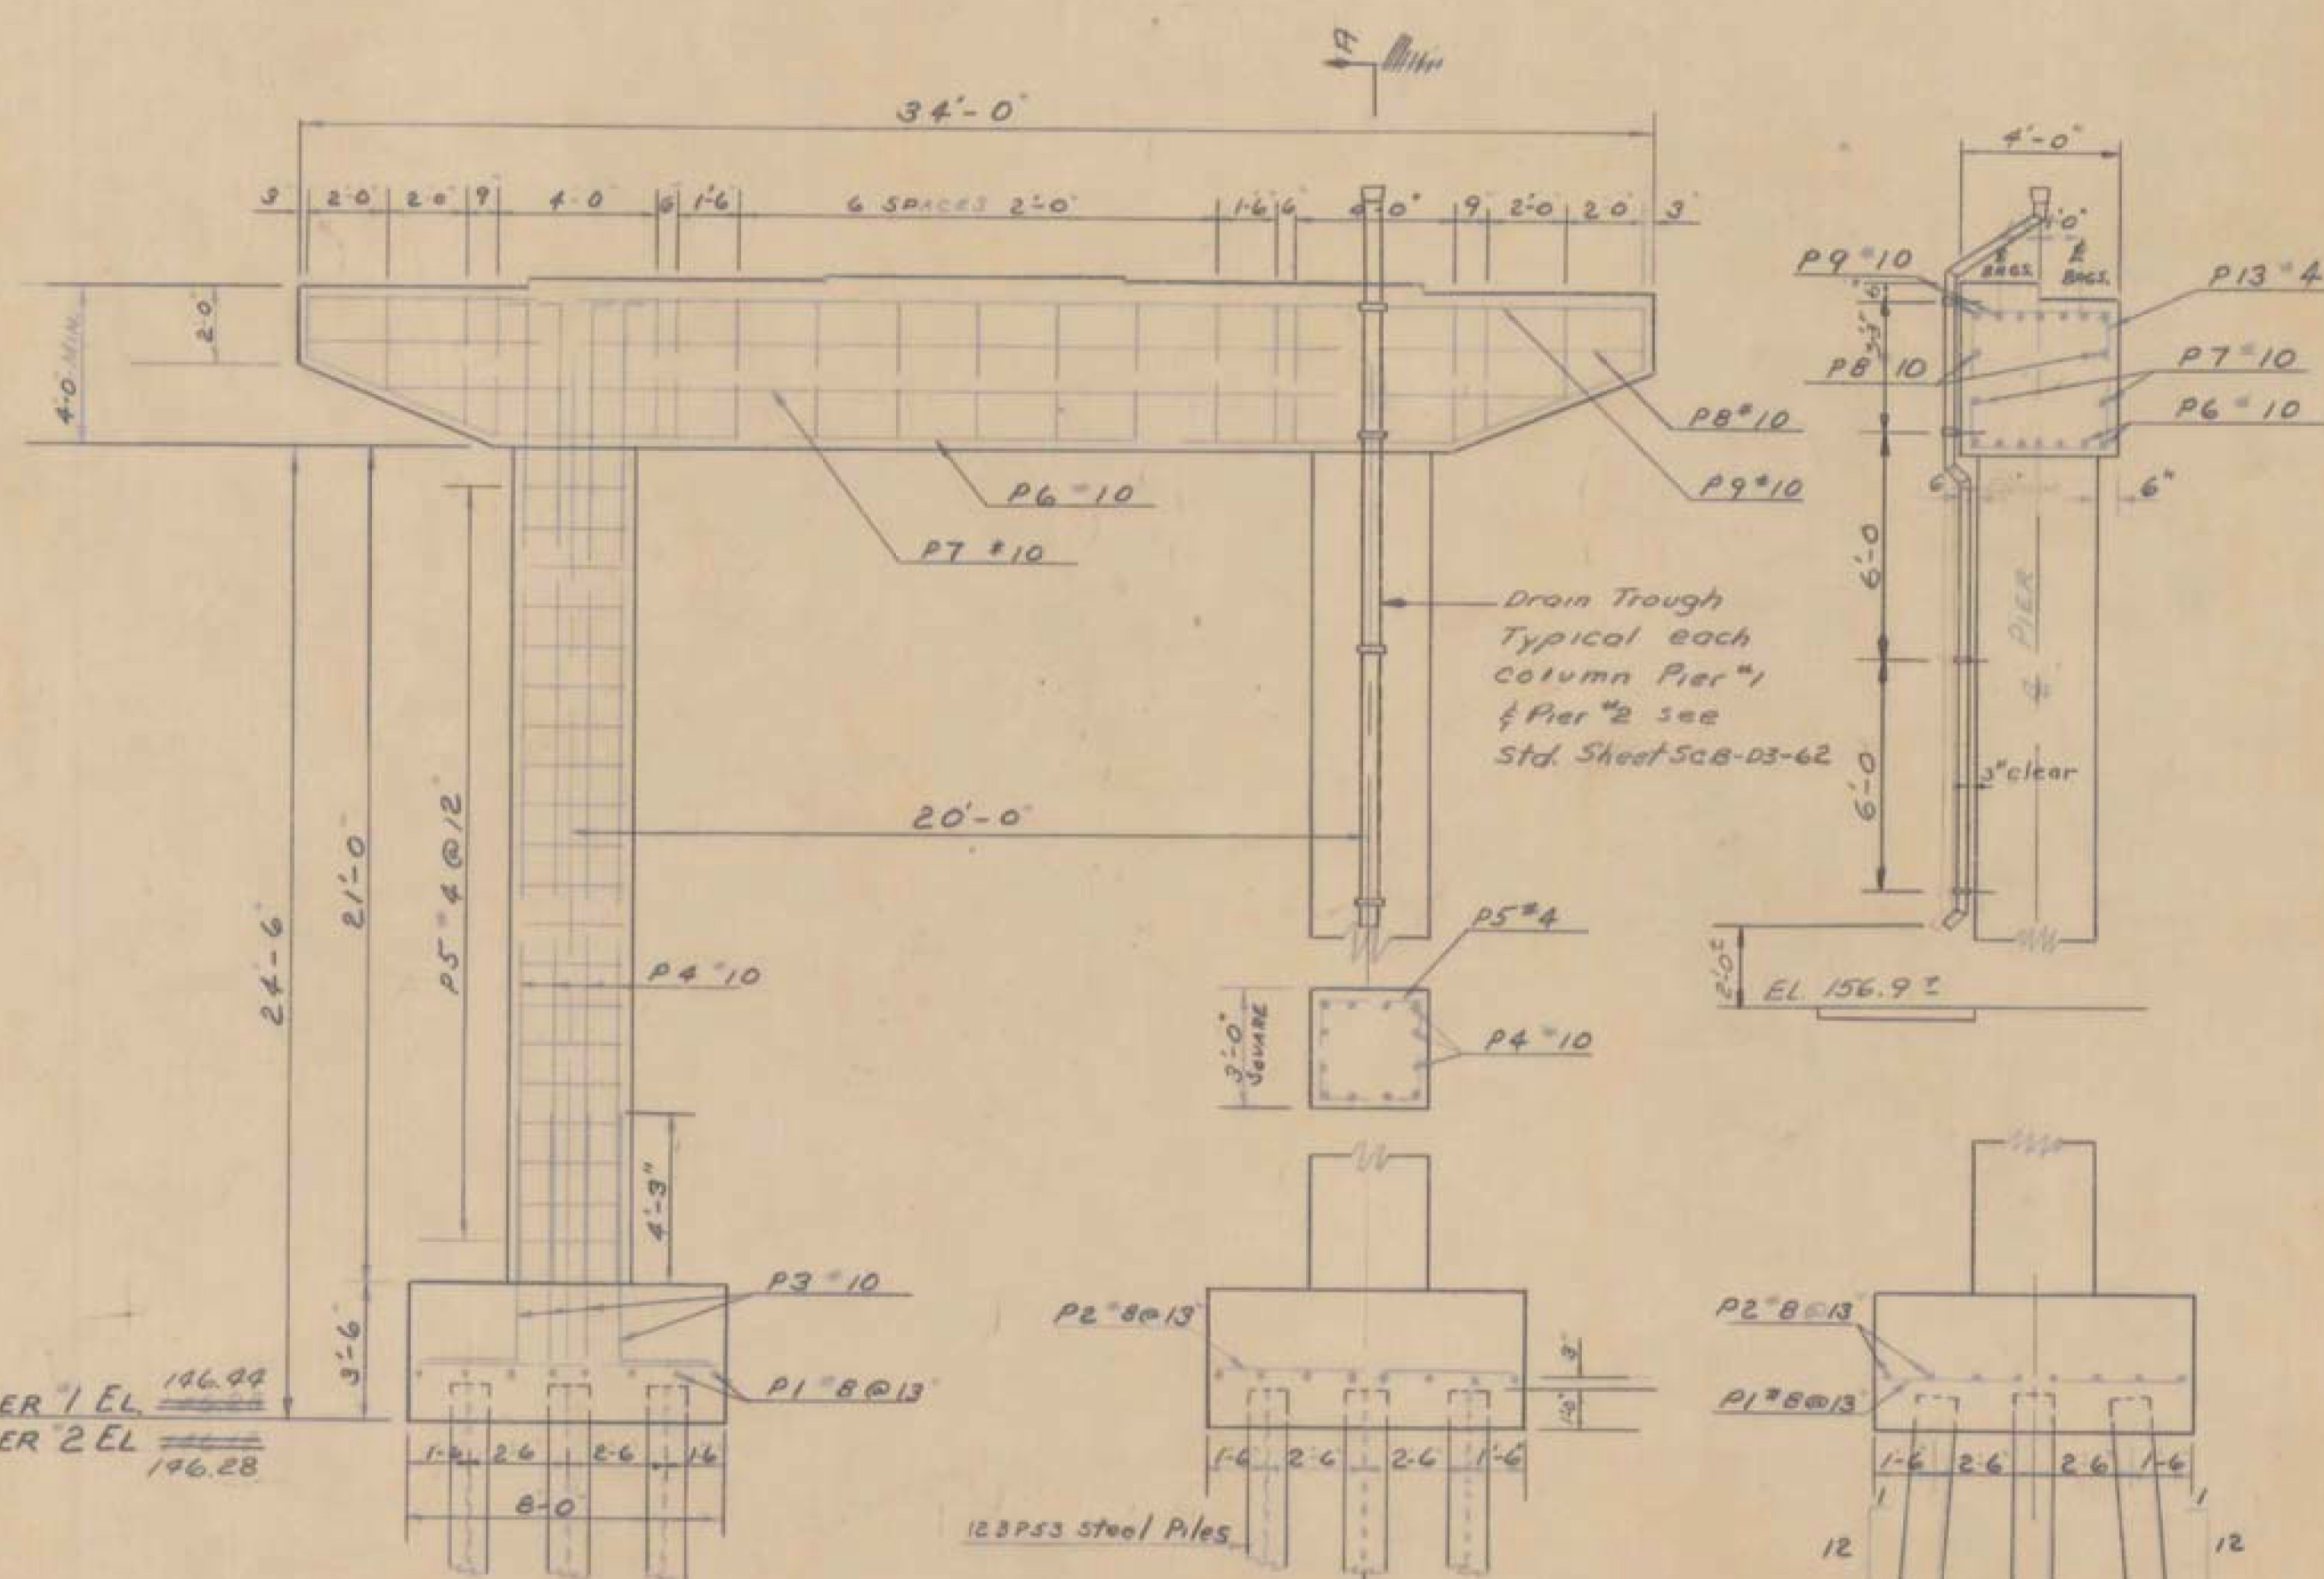


ELEVATION

SECTION A-A

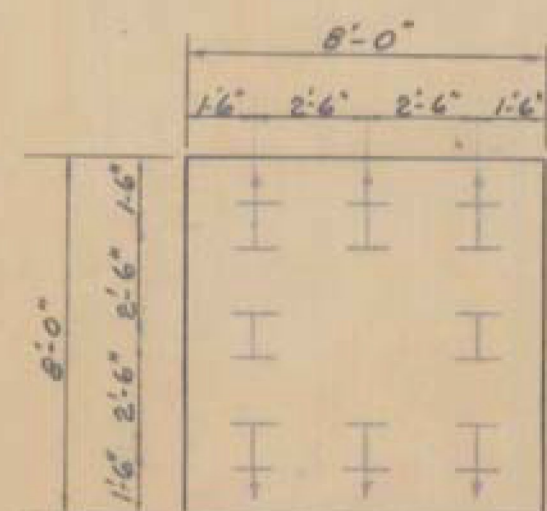

PLAN OF PILES

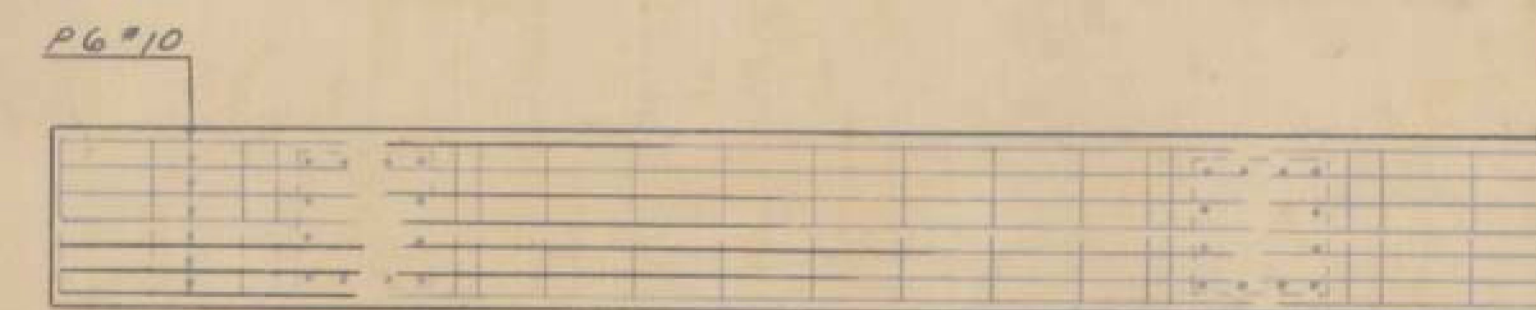

CAP REINFORCEMENT - BOTTOM

	No. Piles	Size	Est Length of Piles	Splices Allowed for Piles Not Exceeding Plan Length (to be paid for only if used)	Splices Estimated for Piles Exceeding Plan Length (to be paid for only if used)
Pier #1	16	12 #10	60	—	4
Pier #2	16	12 #10	60	—	4

NOTES

- BRIDGE SEAT ELEVATIONS ARE FOR 6 BRSS.
- SLOPE BRIDGE SEATS 1/4" PER FOOT FOR DRAINAGE.
- COAT BRIDGE SEATS WITH ASPHALTIC-ASBESTOS COATING, ITEM 407, AFTER SUPERSTRUCTURE IS IN PLACE.
- 12 #10 STEEL PILES TO BE DRIVEN TO 35 TON BEARING CAPACITY. ESTIMATED LENGTH = 53 FEET.
- BOTTOM OF ALL PILES TO BE AT LEDGE.
- FOR GENERAL NOTES SEE SHEET BR-401.

ITEM NO.	ITEM	UNIT	NET	OVERRUN	TOTAL	FINAL
106-A	CHAN. EXCAV. OF EARTH	C.Y.				
106-B	CHAN. EXCAV. OF ROCK	C.Y.				
106-C	UNCLASS. CHAN. EXCAV.	C.Y.				
107	STRUCT. EXCAV.	C.Y.	135		130	
401-B	CONC. CLASS 8 (MOD. 1)	C.Y.	44		102	
402	REINF. STEEL	LBS.	SEE REINF. SCHEDULE			
407	ASPHALTIC-ASE COATING	S.Y.	27		28	
502-B	TREATED TIMBER PILING	L.F.				
503	SPLICERS FOR STEEL PILING	EA.	8		0	
504	STEEL PILING (12 #10) (In place)	L.F.	1720		1,754	
502-A	UNTREATED TIMBER PILING	L.F.				
	Cut-offs @ 50% Unit Price				166	

Stage I Construction

STATE OF VERMONT  
DEPARTMENT OF HIGHWAYS

TOWN OF SWANTON-HIGHGATE  
ROUTE No. I-89 LOG STA.  
INTERSTATE OVER ROUTE 78  
DETAILS - PIERS #1 & 2 (N.B.)


SCALE 3/4" = 1'-0"  
SURVEYED BY NEETER-MARTIN  
A.S.C. (N.B.) J.J.C. (N.B.)  
DRAWN BY A.S.C. CHECKED BY J.J.C.  
PROJECT NO. I-89-3(32)  
SHEET 147 OF 246

BR 409 OF 407


SWANTON  
IM 089-3(70)  
SHEET 28 OF 31  
FOR REFERENCE  
ONLY

Item	No Pieces	Size	Length	Mark	Type	A	B	C	D	E	F	G	H	J	K	R	O
SUPERSTRUCTURE																	
SPAN No. 1 (44')																	
1	4	4-0	1-5B	Str													
176	5	34-4	1-51	Str													
151	5	22-9	1-52	Str													
8	5	32-2	1-55	Str													
21	6	23-0	1-53	Str													
54	4	5-3	1-54	S3	0-5	1-6	1-5	1-6								0-5	
26	4	7-6	1-56A	S2	0-5	3-0	0-8	3-0								0-5	
28	5	4-2	1-56P	17			2-6	0-8	1-0								
22	6	3-0	1-57	1	0-8	1-8	0-8										
SPAN No. 2 (74')																	
296	5	34-4	2-51	Str													
225	5	26-0	2-52	Str													
30	6	26-3	2-53	Str													
94	4	5-3	2-54	S3	0-5	1-6	1-5	1-6								0-5	
56	5	4-2	2-56P	17			2-6	0-8	1-0								
SPAN No. 3 (44')																	
176	5	34-4	3-51	Str													
150	5	22-9	3-52	Str													
8	5	32-2	3-55	Str													
20	6	23-0	3-53	Str													
26	4	7-6	3-56A	S2	0-5	3-0	0-8	3-0								0-5	
54	4	5-3	3-54	S3	0-5	1-6	1-5	1-6								0-5	
28	5	4-2	3-56P	17			2-6	0-8	1-0								
22	6	3-0	3-57	1	0-8	1-8	0-8										
APPROACH Slab No. 1																	
20	5	29-6	1AS5	Str													
16	5	3-6	1AS6	Str													
3	5	5-4	1AS8	Str													
2	5	5-4	1AS9	Str													
3	10	7-0	1AS3	Str													
2	10	7-0	1AS4	Str													
8	5	5-0	1AS7	S6	0-6	1-9	0-6	1-9								0-6	0-9
30	10	20-7	1AS1	1	1-1	19-6											
APPROACH Slab No. 2 Same as APPROACH Slab No. 1 Except Prefix 2AS1, 2AS2 etc and No Test Bars.																	

Item	No Pieces	Size	Length	Mark	Type	A	B	C	D	E	F	G	H	J	K	R	O
SUBSTRUCTURE																	
South Abutment.																	
32	4	8-6	1A7	Str													
17	4	7-6	1A8	Str													
7	6	34-9	1A1	Str													
37	6	6-0	1A2	Str													
4	6	34-9	1A3	Str													
12	6	12-6	1A4	Str													
17	6	1-9	1A9	Str													
12	6	13-0	1A5	19			5-9	7-3	None				3-6		4-8		11-11
12	6	12-6	1A6	19			5-9	6-9	None				3-6		4-8		11-5
North Abutment same as South Abutment except No Test Bars and Prefix 2A1, 2A2 etc.																	
PIER No. 1																	
17	8	7-6	1P1	Str													
10	8	7-6	1P2	Str													
2	10	29-9	1P7	Str													
2	10	33-6	1P8	Str													
7	10	33-6	1P9	Str													
40	4	10-10	1P5	TI	0-5	2-6	2-6	2-6	2-6							0-5	
2	4	10-10	1P10	TI	0-5	3-6	1-6	3-6	1-6							0-5	
2	4	12-4	1P11	TI	0-5	3-6	2-3	3-6	2-3							0-5	
2	4	13-10	1P12	TI	0-5	3-6	3-0	3-6	3-0							0-5	
13	4	14-10	1P13	TI	0-5	3-6	3-6	3-6	3-6							0-5	
25	10	8-6	1P3	17			2-3	6-3	None								
24	10	25-3	1P4	20			0-6	2A9	None								1-11
7	10	34-0	1P6	14	None	5-0	2A-0	5-0	None								
PIER No. 2 Same as Pier No. 1 except No Test Bars and Prefix 2P1, 2P2 etc.																	

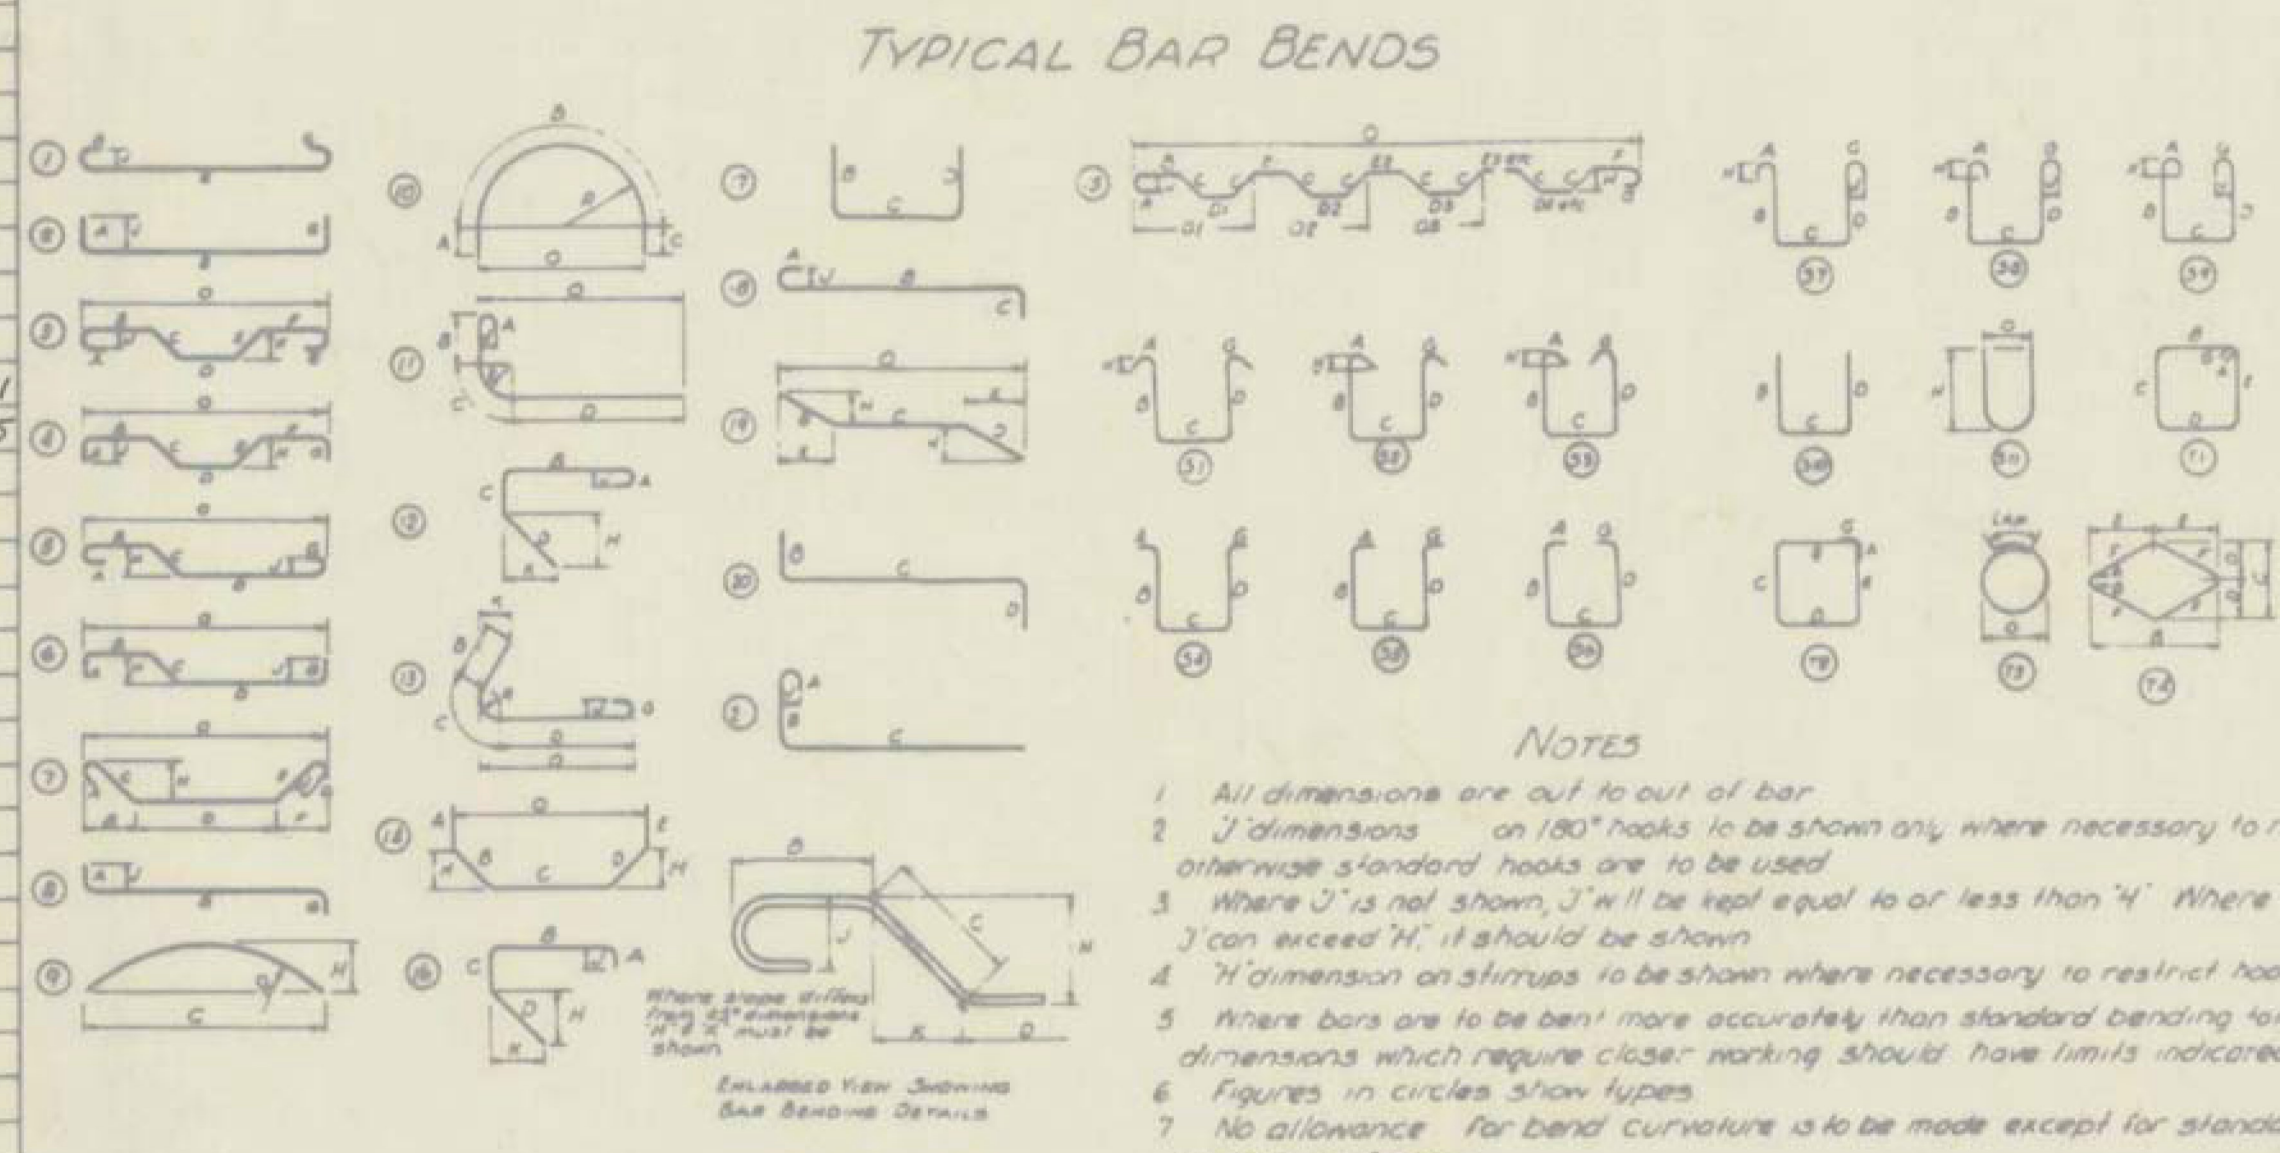

- #### NOTES
- All dimensions are out to out of bar.
  - J' dimensions on 180° hooks to be shown only, where necessary to restrict hook size otherwise standard hooks are to be used.
  - Where 'J' is not shown, 'J' will be kept equal to or less than 'H'. Where 'J' can exceed 'H', it should be shown.
  - 'H' dimension on stirrups to be shown where necessary to restrict hooks.
  - Where bars are to be bent more accurately than standard bending tolerances bending dimensions which require close marking should have limits indicated.
  - Figures in circles show types.
  - No allowance for bend curvature is to be made except for standard hook & radii in excess of same.

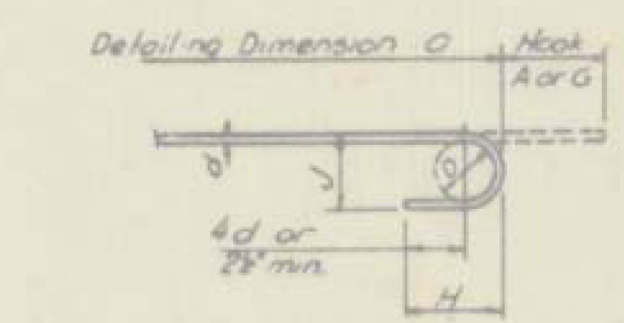

#### BAR SIZES

Equivalent Size	Present (Numbers)
1/2"	#2
3/8"	#3
1/2"	#4
5/8"	#5
3/4"	#6
7/8"	#7
1"	#8
1 1/8"	#9
1 1/4"	#10
1 3/8"	#11

\* One bar included for testing

Minimum bends to be as follows:  
Stirrups and tie bars shall be bent around a pin having a diameter not less than two times the minimum thickness of the bar. Bends for other bars shall be made around a pin having a diameter not less than six times the minimum thickness except for bars larger than 1 inch, in which case the bends shall be made around a pin of eight bar diameters.




Bar reinforcement metal shall conform to the requirements of the Standard Specifications for new Billet-Steel Concrete Reinforcement Bars (Intermediate Grade) Serial Designation AAS.HO.M31-48 or its latest revision. All bars shall be deformed to conform with ASTM Specifications A305-49.

#### ESTIMATED QUANTITIES

Location	Pounds
SPAN No. 1	11,436
SPAN No. 2	10,470
SPAN No. 3	11,360
South Abutment	7,910
North Abutment	7,900
Pier No. 1	7,250
Pier No. 2	7,200
Approach Slab No. 1	3,520
Approach Slab No. 2	3,520
<b>Total</b>	<b>66,560</b>

Stage I Construction  
**SWANTON - HIGHGATE**  
 Interstate over Rte 78 (N.B.)  
 Reinforcing Schedule  
 IB9-3(C) Contr. #1  
 Prepared by: JJC  
 Checked by: A.J.C.  
 BR 405 of 407  
 Sheet 143 of 246




**SWANTON**  
 IM 089-3(70)  
 SHEET 29 OF 31  
 FOR REFERENCE  
 ONLY

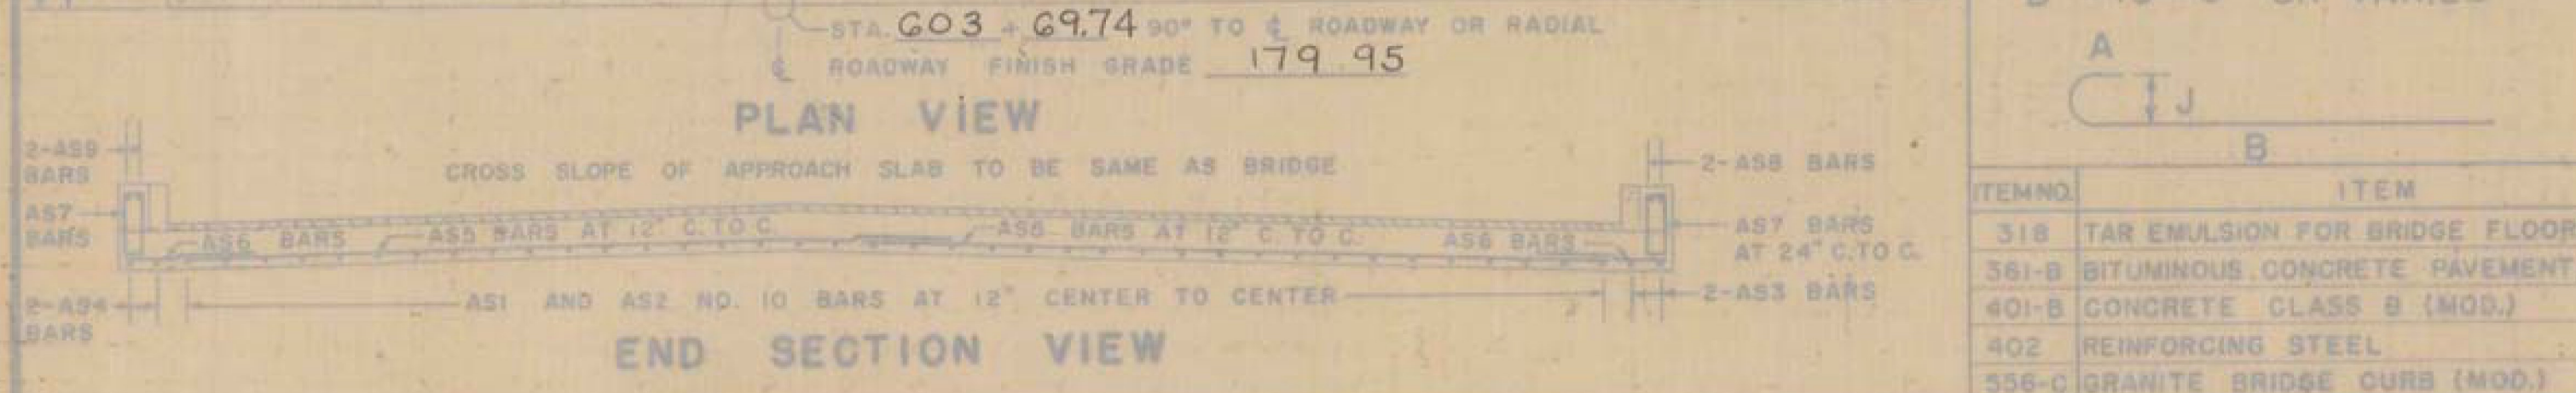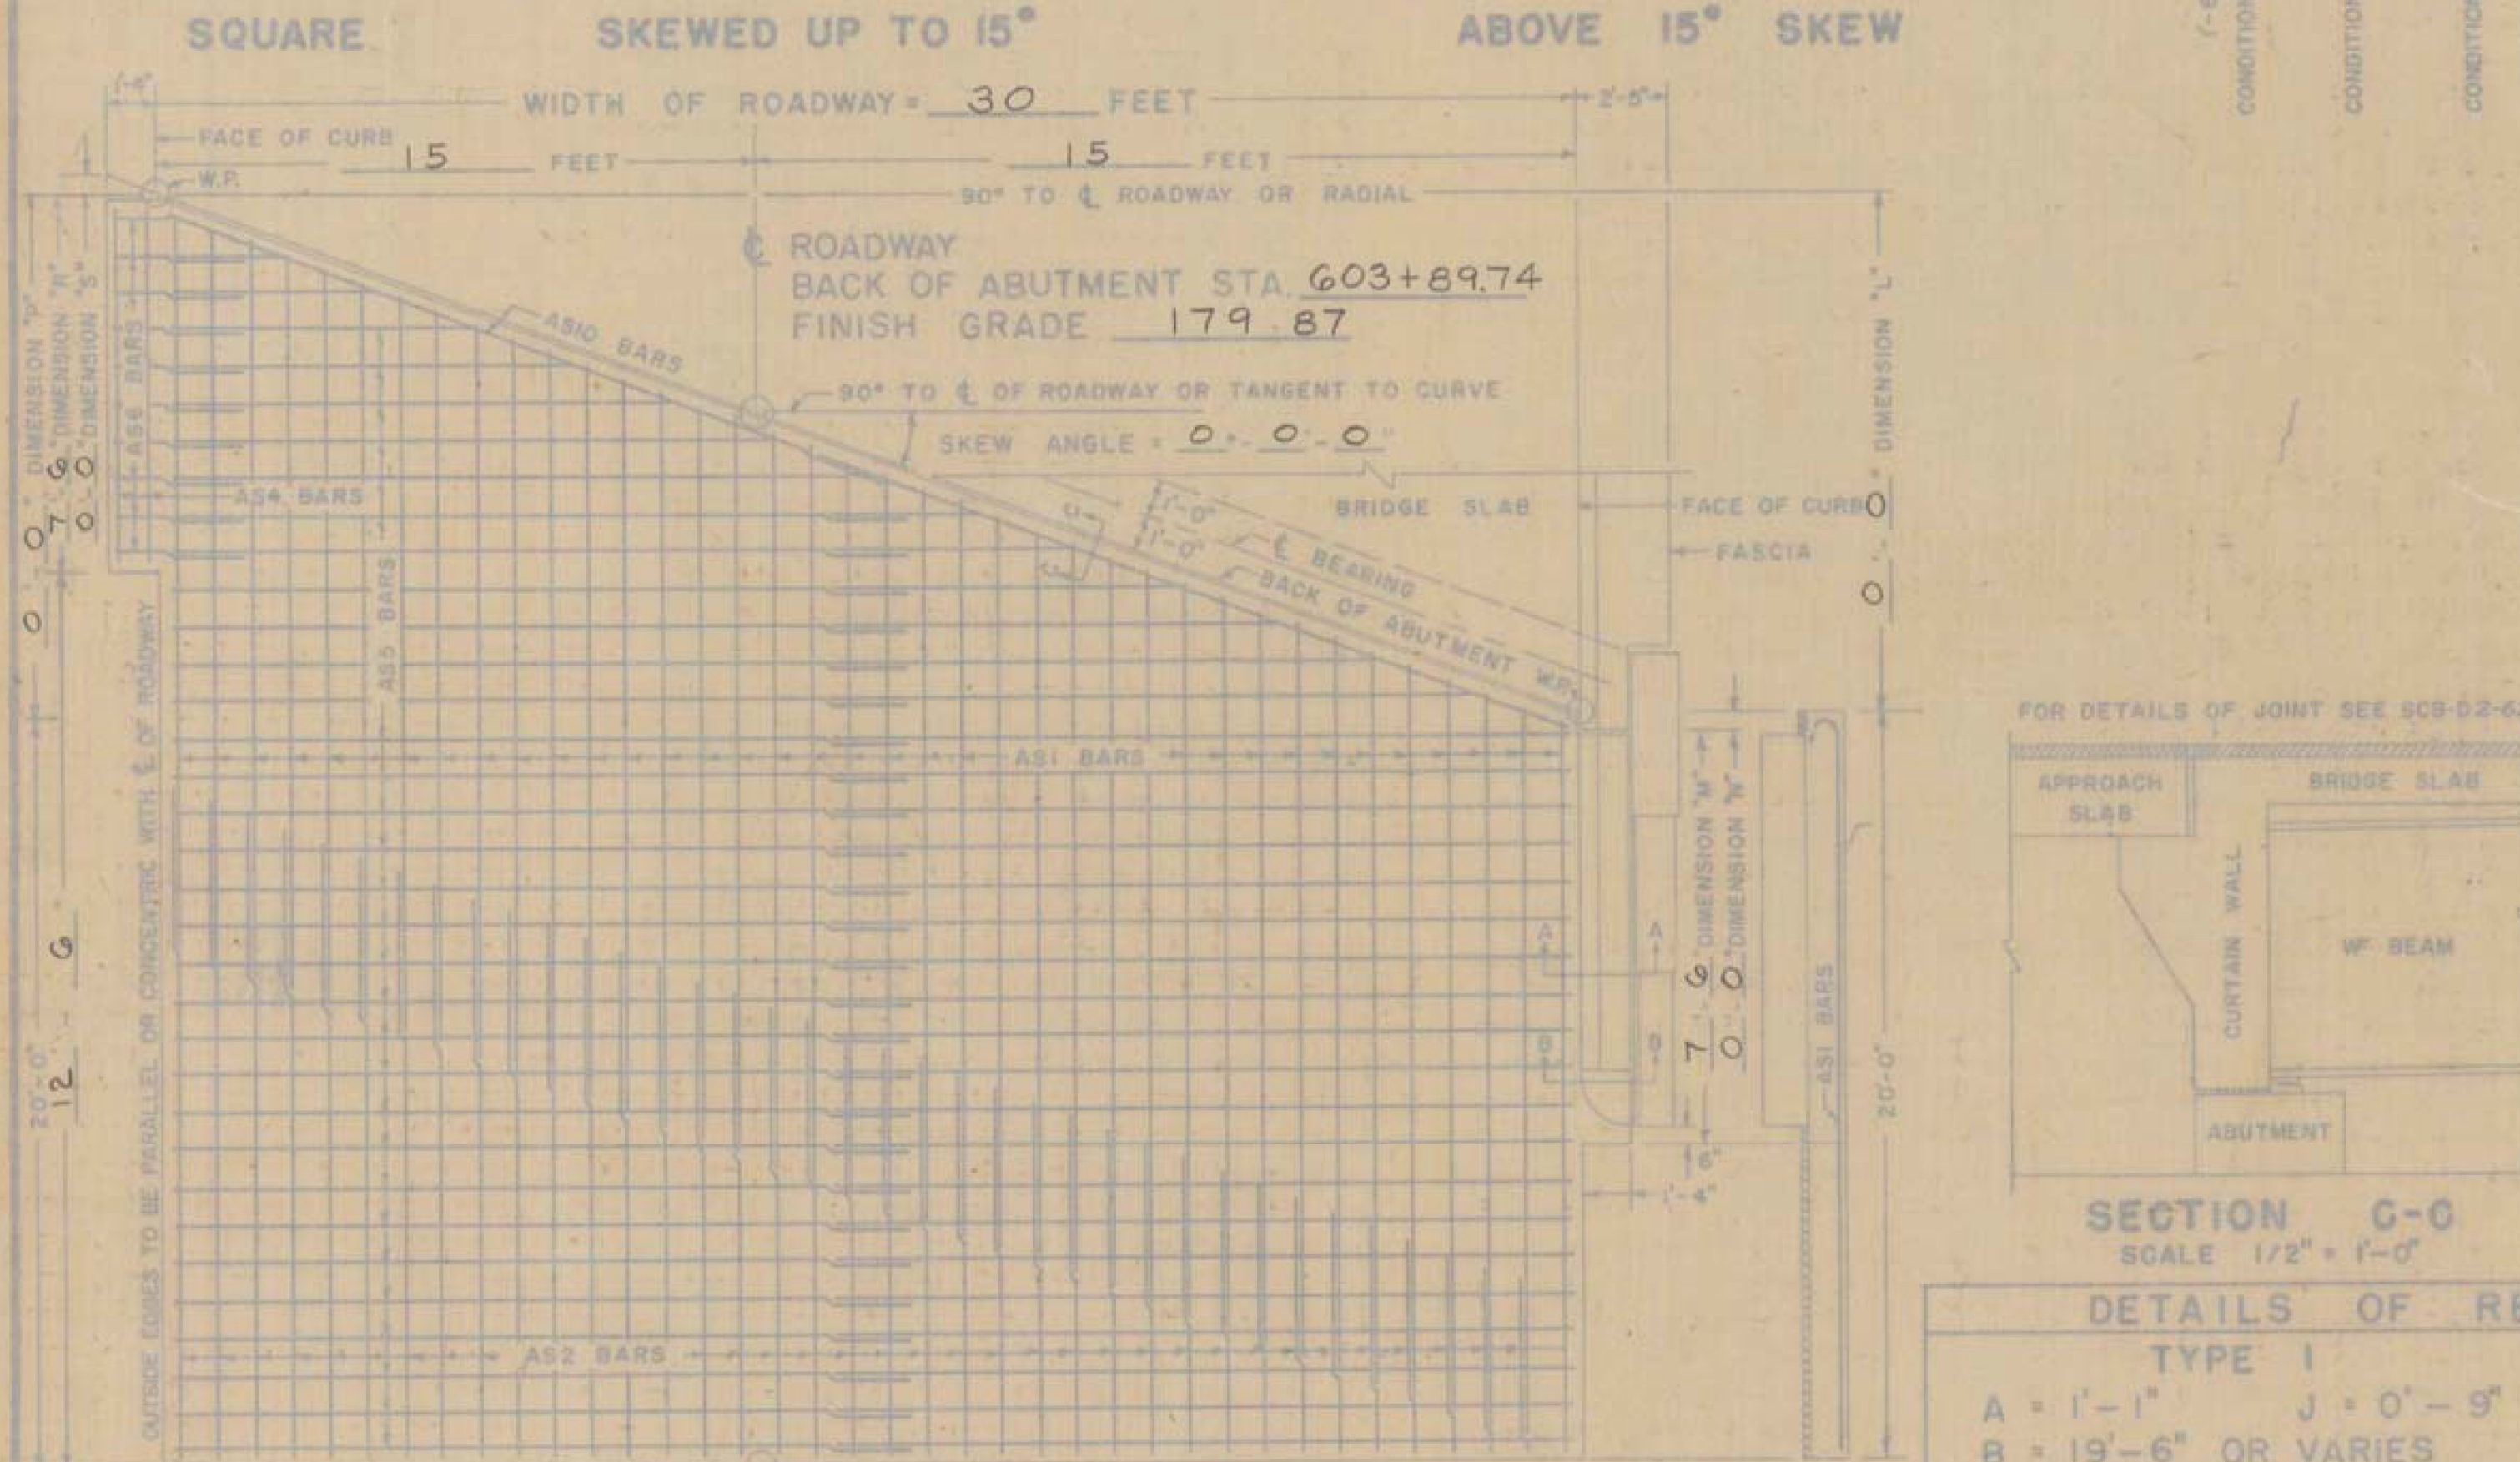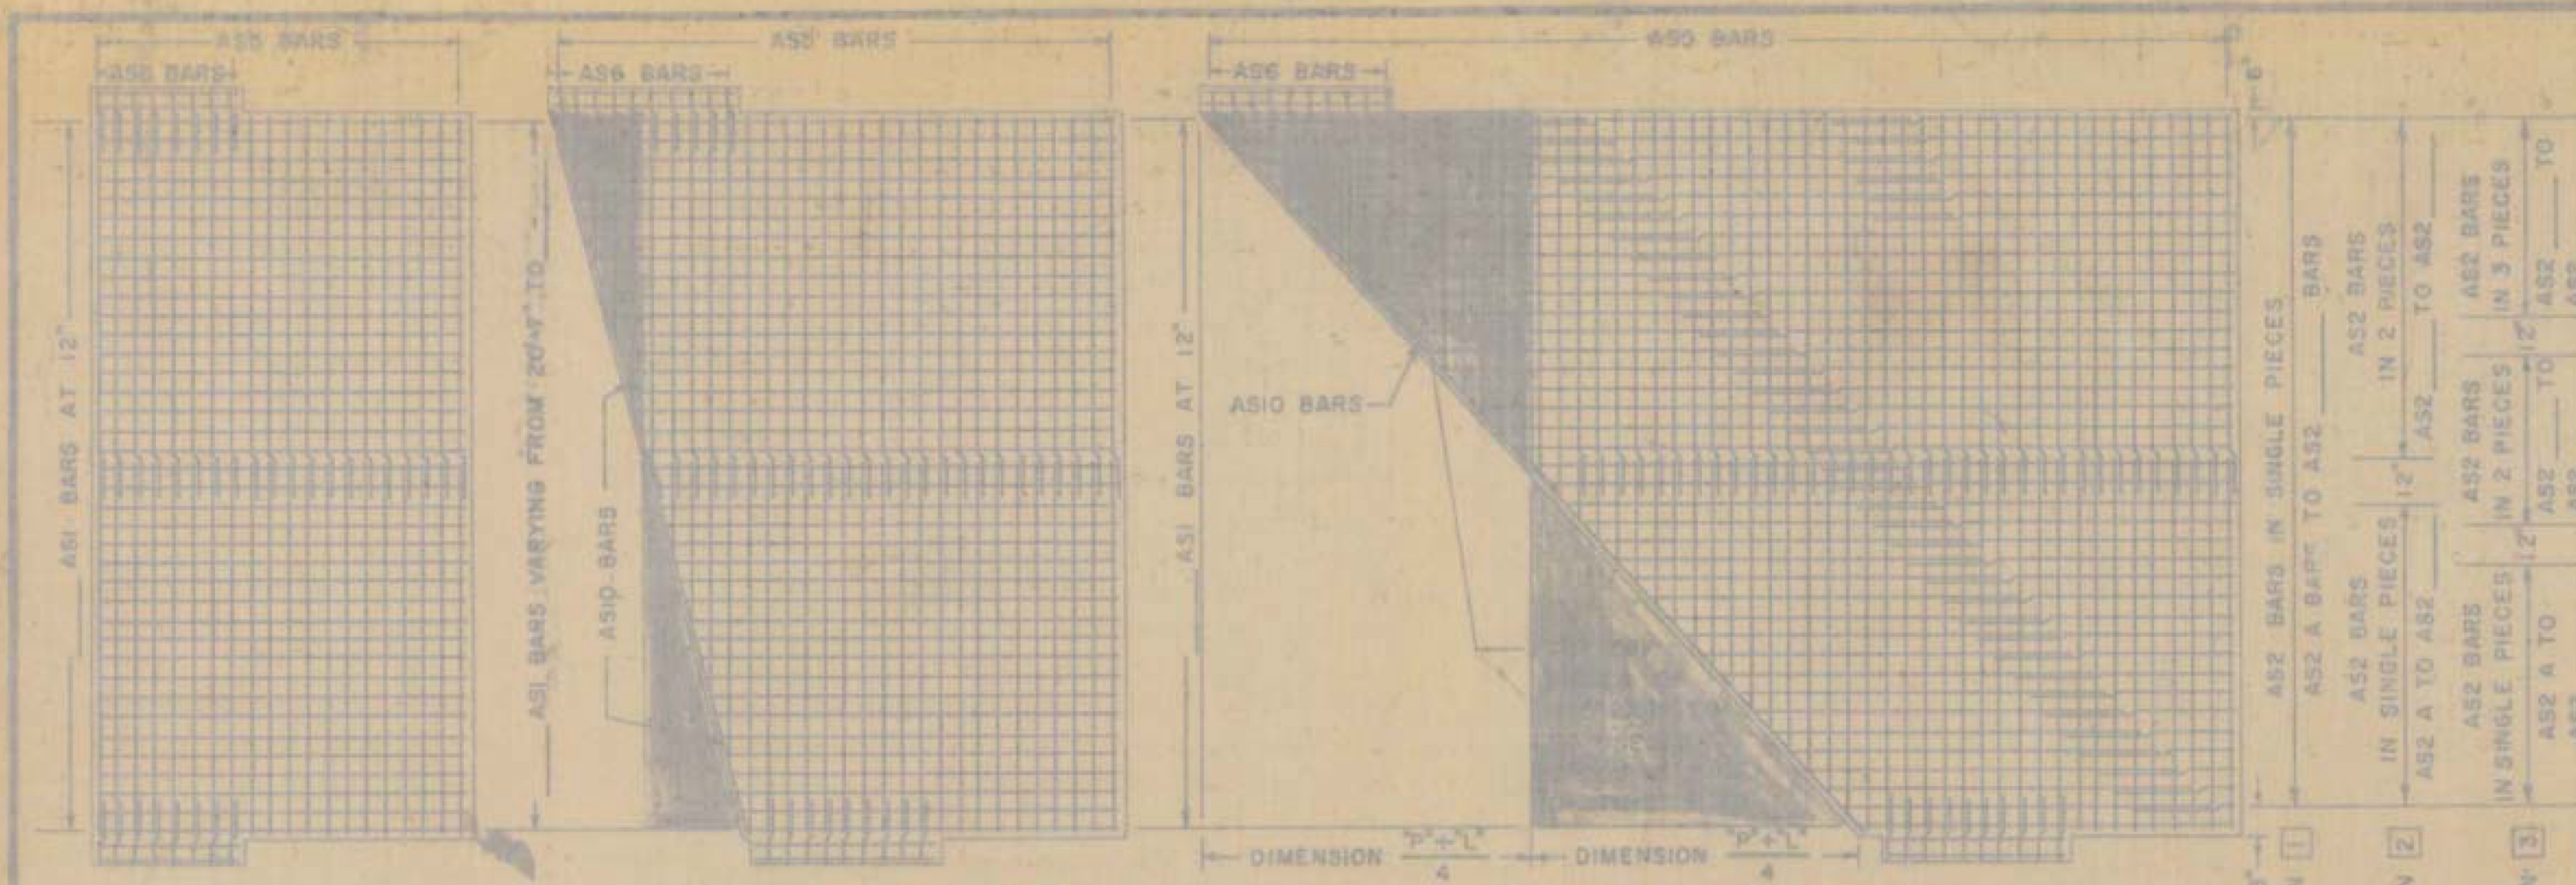

30' ROADWAY				35' ROADWAY				42' ROADWAY				44' ROADWAY				ROADWAY			
NO. PIECES	SIZE	LENGTH	REMARKS	NO. PIECES	SIZE	LENGTH	REMARKS	NO. PIECES	SIZE	LENGTH	REMARKS	NO. PIECES	SIZE	LENGTH	REMARKS	NO. PIECES	SIZE	LENGTH	REMARKS
2	10	7'-0"	AS3 STR.	2	10	7'-0"	AS3 STR.	2	10	7'-0"	AS3 STR.	2	10	7'-0"	AS3 STR.	2	10	7'-0"	AS3 STR.
2	10	7'-0"	AS4 STR.	2	10	7'-0"	AS4 STR.	2	10	7'-0"	AS4 STR.	2	10	7'-0"	AS4 STR.	2	10	7'-0"	AS4 STR.
16	5	3'-6"	AS6 STR.	16	5	3'-6"	AS6 STR.	16	5	3'-6"	AS6 STR.	16	5	3'-6"	AS6 STR.	16	5	3'-6"	AS6 STR.
2	5	5'-0"	AS7 S6	2	5	5'-0"	AS7 S6	2	5	5'-0"	AS7 S6	2	5	5'-0"	AS7 S6	2	5	5'-0"	AS7 S6
2	5	5'-4"	AS8 STR.	2	5	5'-4"	AS8 STR.	2	5	5'-4"	AS8 STR.	2	5	5'-4"	AS8 STR.	2	5	5'-4"	AS8 STR.
2	5	5'-4"	AS9 STR.	2	5	5'-4"	AS9 STR.	2	5	5'-4"	AS9 STR.	2	5	5'-4"	AS9 STR.	2	5	5'-4"	AS9 STR.
SQUARE				SQUARE				SQUARE				SQUARE				SQUARE			
30	10	20'-7"	AS1 1	38	10	20'-7"	AS1 1	42	10	20'-7"	AS1 1	44	10	20'-7"	AS1 1	10	20'-7"	AS1 1	
20	5	29'-6"	AS5 STR.	40	5	29'-6"	AS5 STR.	40	5	29'-6"	AS5 STR.	40	5	29'-6"	AS5 STR.	5			AS5 STR.
SKEWED UP TO 15°				SKEWED UP TO 15°				SKEWED UP TO 15°				SKEWED UP TO 15°				SKEWED UP TO 15°			
30	10	AVE	AS1 1	38	10	AVE	AS1 1	42	10	AVE	AS1 1	44	10	AVE	AS1 1	10	AVE	AS1 1	
5	29'-6"	AS5 STR.	2	5	29'-6"	AS5 STR.	3	5	29'-6"	AS5 STR.	3	5	29'-6"	AS5 STR.	3	5			AS5 STR.
ALL SKEWED SPANS ABOVE 15° SKEW				ALL SKEWED SPANS ABOVE 15° SKEW				ALL SKEWED SPANS ABOVE 15° SKEW				ALL SKEWED SPANS ABOVE 15° SKEW				ALL SKEWED SPANS ABOVE 15° SKEW			
2	5	AS10 STR.	5	2	AS10 STR.	5	2	AS10 STR.	5	2	AS10 STR.	5	2	AS10 STR.	5	2			AS10 STR.

REMARKS: AS1 BAR "T" DIMENSION VARIES FROM 19'-6" TO 20'-0" (IN FEET) + NUMBER OF PIECES. CUT BARS IN THE FIELD USING CUT OFF PIECES ON OPPOSITE HALF OF SLAB. AS2 BAR "T" DIMENSION VARIES FROM 19'-6" TO 20'-0" (IN FEET) + NUMBER OF PIECES. CUT BARS IN THE FIELD USING CUT OFF PIECES ON OPPOSITE HALF OF SLAB. THE LENGTH OF AS2 BARS VARIES FROM 19'-6" TO 20'-0" (IN FEET) + NUMBER OF PIECES. THE AS2 BARS MAY BE DIVIDED INTO TWO OR MORE PIECES, AS MAY BE NECESSARY, TO LIMIT THE MAXIMUM BAR LENGTH TO 30 FEET. THE LOCATION OF SPLICES IS LEFT TO THE OPTION OF THE DESIGNER. THE NO. PIECES SHOWN ARE FOR CONDITION 1 (FOR CONDITION 2 & 3 SEE REINF. SCHEDULE).

GENERAL NOTES: ALL REINFORCING STEEL SHALL BE DETAILED ON THE REINFORCING STEEL SCHEDULE. WHEN A BAR LENGTH VARIES IN INCREMENTS EACH BAR MUST BE DETAILED. SPLICES SHALL BE 2'-0" FOR NUMBER 5 BARS, AND 4'-0" FOR NUMBER 10 BARS. ALL WORK AND MATERIALS SHALL CONFORM TO THE STATE OF VERMONT, DEPARTMENT OF HIGHWAYS, STANDARD SPECIFICATIONS FOR HIGHWAY AND BRIDGE CONSTRUCTION DATED JANUARY 1956, AND THE A.S.H.O. SPECIFICATIONS DATED 1962. DESIGNED FOR H20-316-43.

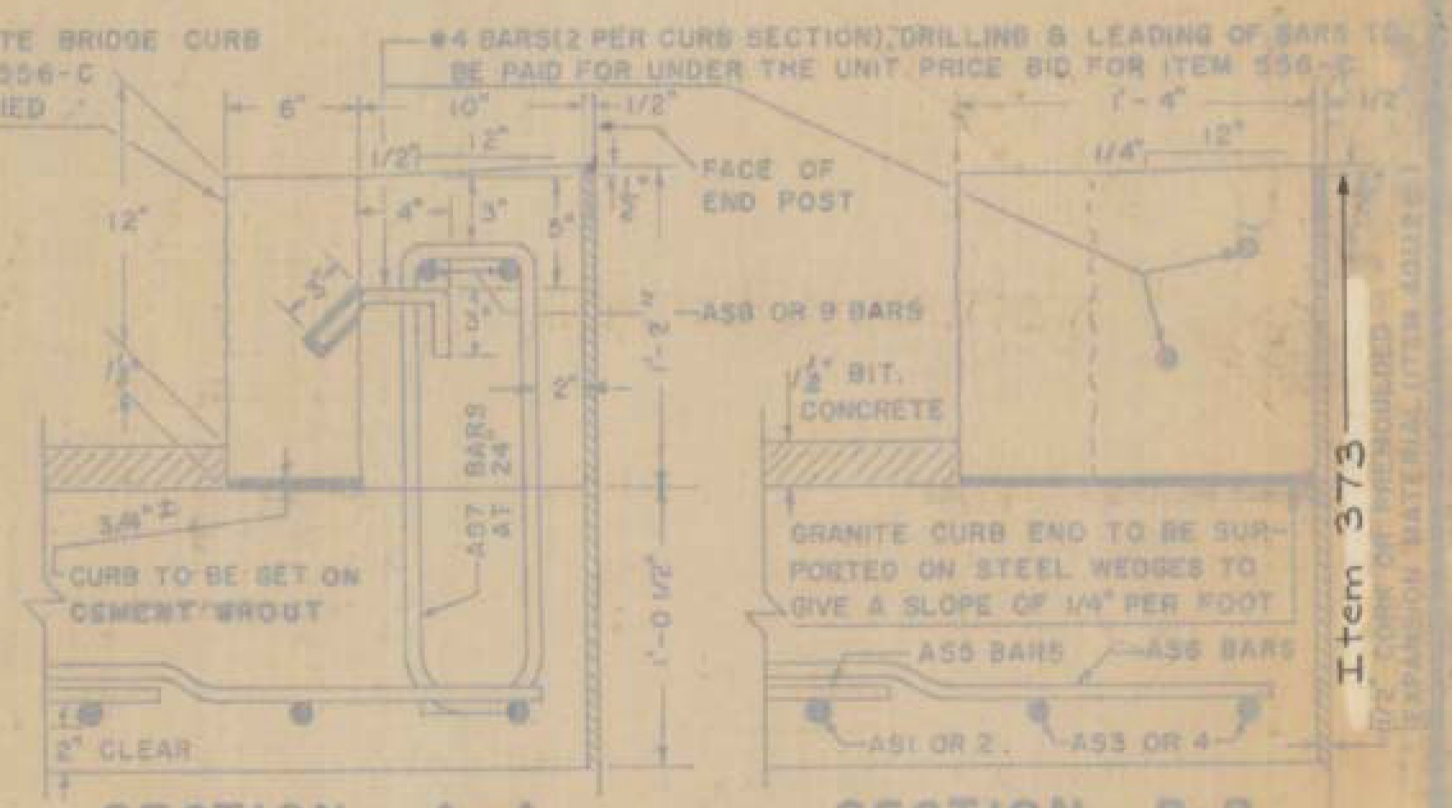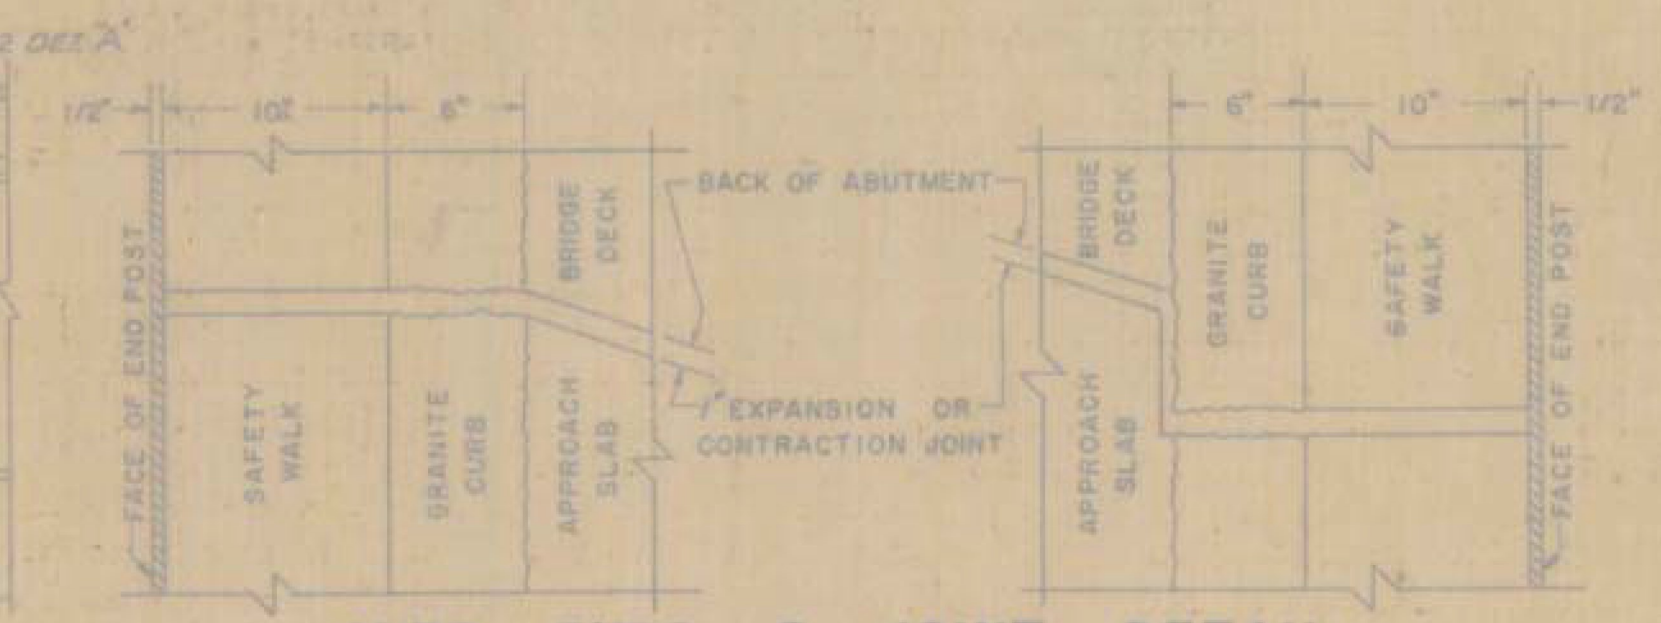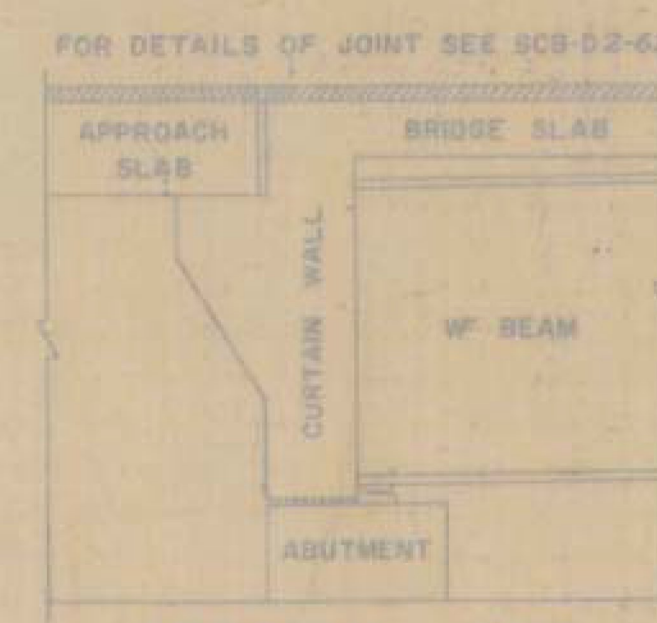

SECTION G-G SCALE 1/2" = 1'-0"

CURB ENDS & JOINT DETAIL SCALE 1/2" = 1'-0"

SECTION A-A SCALE 1/2" = 1'-0"

SECTION B-B SCALE 1/2" = 1'-0"

DETAILS OF REINFORCING BARS				REINFORCING STEEL				QUANTITY COMPUTATION					
TYPE I		TYPE S6 C		A	B	C	A X B X C	W	Z	T	T <sup>3</sup> DIMENSION		
A = 1'-1"	J = 0'-9"	A = 0'-6"	B = 1'-9"	BAR NO.	LENGTH	WEIGHT PER FT.	WEIGHT IN LBS.	W = WIDTH OF ROADWAY	Z = 20 + DIMENSION	T = DIMENSION	M <sup>3</sup> + T <sup>3</sup>		
B = 19'-6" OR VARIES		B = 1'-9"	C = 0'-6"	AS1	30	20'-7"	4,303	30	20	7-6	BITUMINOUS CONCRETE = W x Z x 0.0099 = TONS		
		C = 0'-6"	D = 1'-9"	AS2			2657	30	20	7-6	TAR EMULSION = W x Z x 0.0444 = GALLONS		
		D = 1'-9"	G = 0'-6"	AS3	2	7'-0"	4,303	30	20	7-6	CONCRETE CLASS B = W x Z x 0.0386 + T x 0.1029 + (T - 1.8333) x 0.0733 = CUBIC YARDS		
		G = 0'-6"		AS4	2	7'-0"	4,303	30	20	7-6	[30 x 20 x 0.0386] + [7.5 x 0.1029] + [7.5 - 1.8333] x 0.0733 = 24.35 CUBIC YARDS		
				AS5	20	29'-6"	1,043	615			GRANITE BRIDGE CURB = 2(T + C - 3) x LINEAR FEET		
				AS6	16	3'-6"	1,043	58			2(7.5 + 0.25) = 15.50 LINEAR FEET		
				AS7	8	5'-0"	1,043	42			BAR LENGTHS: AS5 BARS = DIMENSION "M" - 0'-6"		
				AS8	2	5'-4"	1,043	11			AS6 BARS = DIMENSION "N" - 0'-6"		
				AS9	2	5'-4"	1,043	11			AS7 BARS = 5'-0"		
				AS10			1,043				AS8 BARS = DIMENSION "M" - 2'-2"		
											AS9 BARS = DIMENSION "N" - 2'-2"		
ITEM NO.	ITEM	UNIT	TOTAL	FINAL	TOTAL WEIGHT = 3514				Stage I & II Construction				
31B	TAR EMULSION FOR BRIDGE FLOORS	GAL.	27	27									
361-B	BITUMINOUS CONCRETE PAVEMENT (MOD.)	TONS	2.5	24.5									
401-B	CONCRETE CLASS B (MOD.)	CY.	25	24.5									
402	REINFORCING STEEL	L.B.	3520	3532									
556-C	GRANITE BRIDGE CURB (MOD.)	LF.	16	16									

DETAILS OF APPROACH SLAB #1 N.B. FOR 30 FOOT BRIDGE TO BE USED FOR BRIDGE AT STATION 604+73.5 LOCATION I 89 over Route Vt. 78

STATE OF VERMONT DEPARTMENT OF HIGHWAYS STANDARD STRUCTURE SB-AS-60 TOWN OF Swanton-Highgate ROUTE NO. I 89 LOG STA. 604+73.5 SCALE AS NOTED DESIGNED BY A.J.C. CHECKED BY J.J.C. PROJECT NO. I 89-3 (65) BR. 406 OF 407 SHEET 120 OF 210

SWANTON IM 089-3(70) SHEET 30 OF 31 FOR REFERENCE ONLY

APPROVED: [Signature] Bridge Engineer  
 DRAWN BY: R.S. NAUPT NOV. 1960  
 TRACED BY: R.S. NAUPT NOV. 1960  
 CHECKED BY: A.H. SMALLEY NOV. 1960  
 Recommended For Approval: [Signature] Asst. Chief Engineer  
 Approved By: [Signature] Chief Engineer

