




~~MM 137.194 - 137.193~~
BEGIN PROJECT IM SURF(34)
I-91 SOUTHBOUND LANE

DISTRICT #7 | DISTRICT #9
 MM 150.071

~~MM 155.987 - 155.934~~ = SOUTH END OF BR #102-S
END PROJECT IM SURF(34)
I-91 SOUTHBOUND LANE

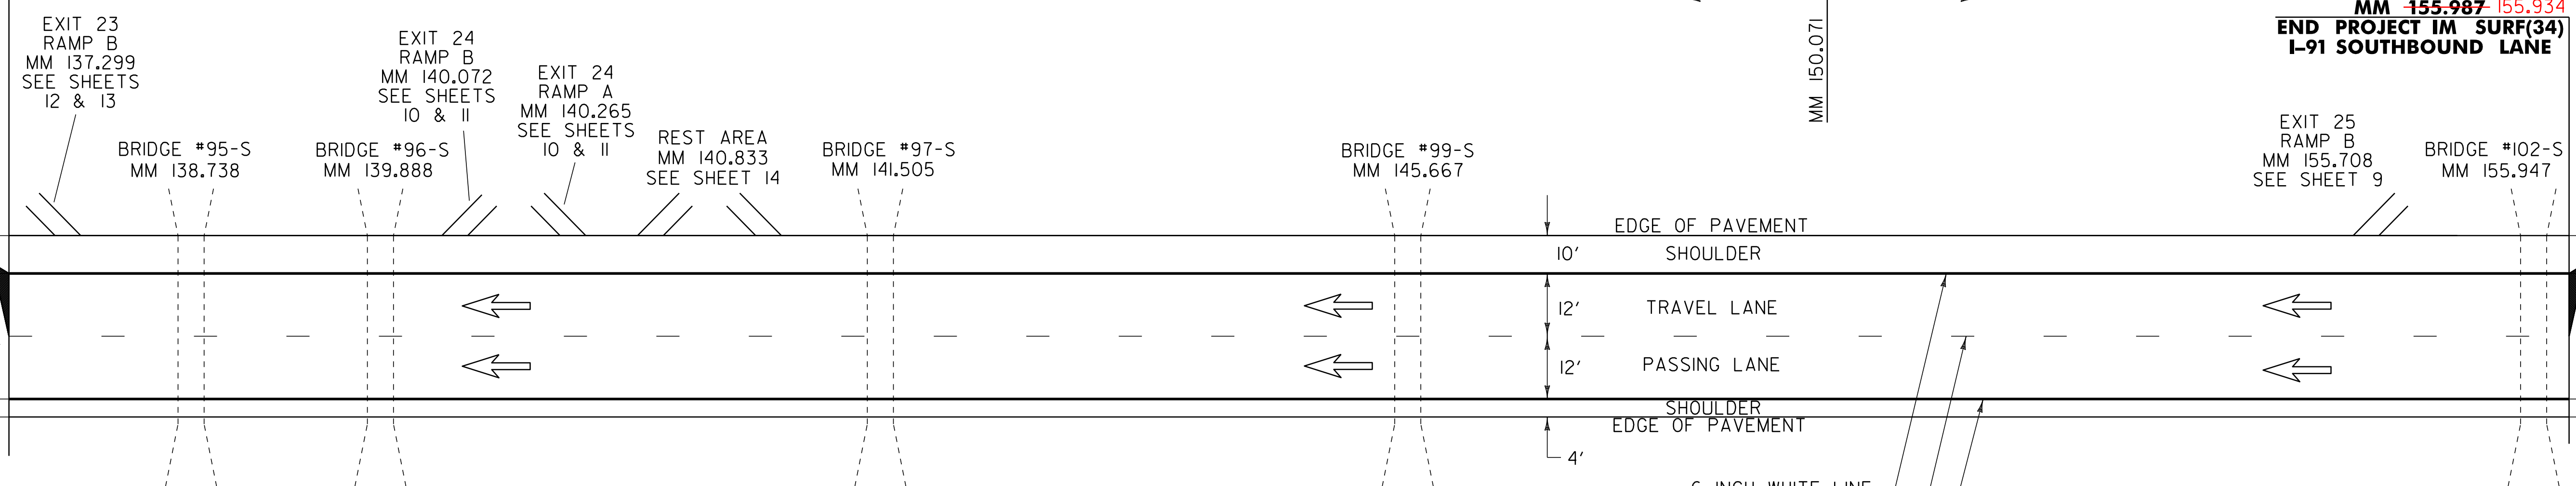

TO ST. JOHNSBURY

SOUTHBOUND I-91

6 INCH WHITE LINE
 6 INCH DASHED WHITE LINE
 6 INCH YELLOW LINE

DURABLE 6 INCH WHITE LINE (OPTION BID ITEM)
 646.622 TEMPORARY 6 INCH WHITE LINE, PAINT

MM 137.194 - MM 155.987 SB (SOLID LT)
 MM 137.194 - MM 155.987 SB (DASHED)

DURABLE 6 INCH YELLOW LINE (OPTION BID ITEM)
 646.632 TEMPORARY 6 INCH YELLOW LINE, PAINT

MM 137.194 - MM 155.987 SB (SOLID RT)

NOTES:

- FOR STRIPING DETAILS AT THE GORES, SEE VAOT STANDARDS E-191 & E-192.
- DIRECTION OF TRAVEL →

NOT TO SCALE

PAVEMENT MARKING DETAIL SHEET MAINLINE	PROJECT NAME: LYNDON - BARTON
	PROJECT NUMBER: IM SURF (34)
	FILE NAME: pl2a286.dgn
	PLOT DATE: 15-APR-2014 14:07
PROJECT LEADER: M. FOWLER	DRAWN BY: L. BULLOCK
DESIGNED BY: L. BULLOCK	CHECKED BY: PAVT MGMT
IPARM FILE NAME: l2a286pmdl.i	SHEET 9 OF 21