


↑  
NORTHBOUND  
DIRECTION OF TRAVEL

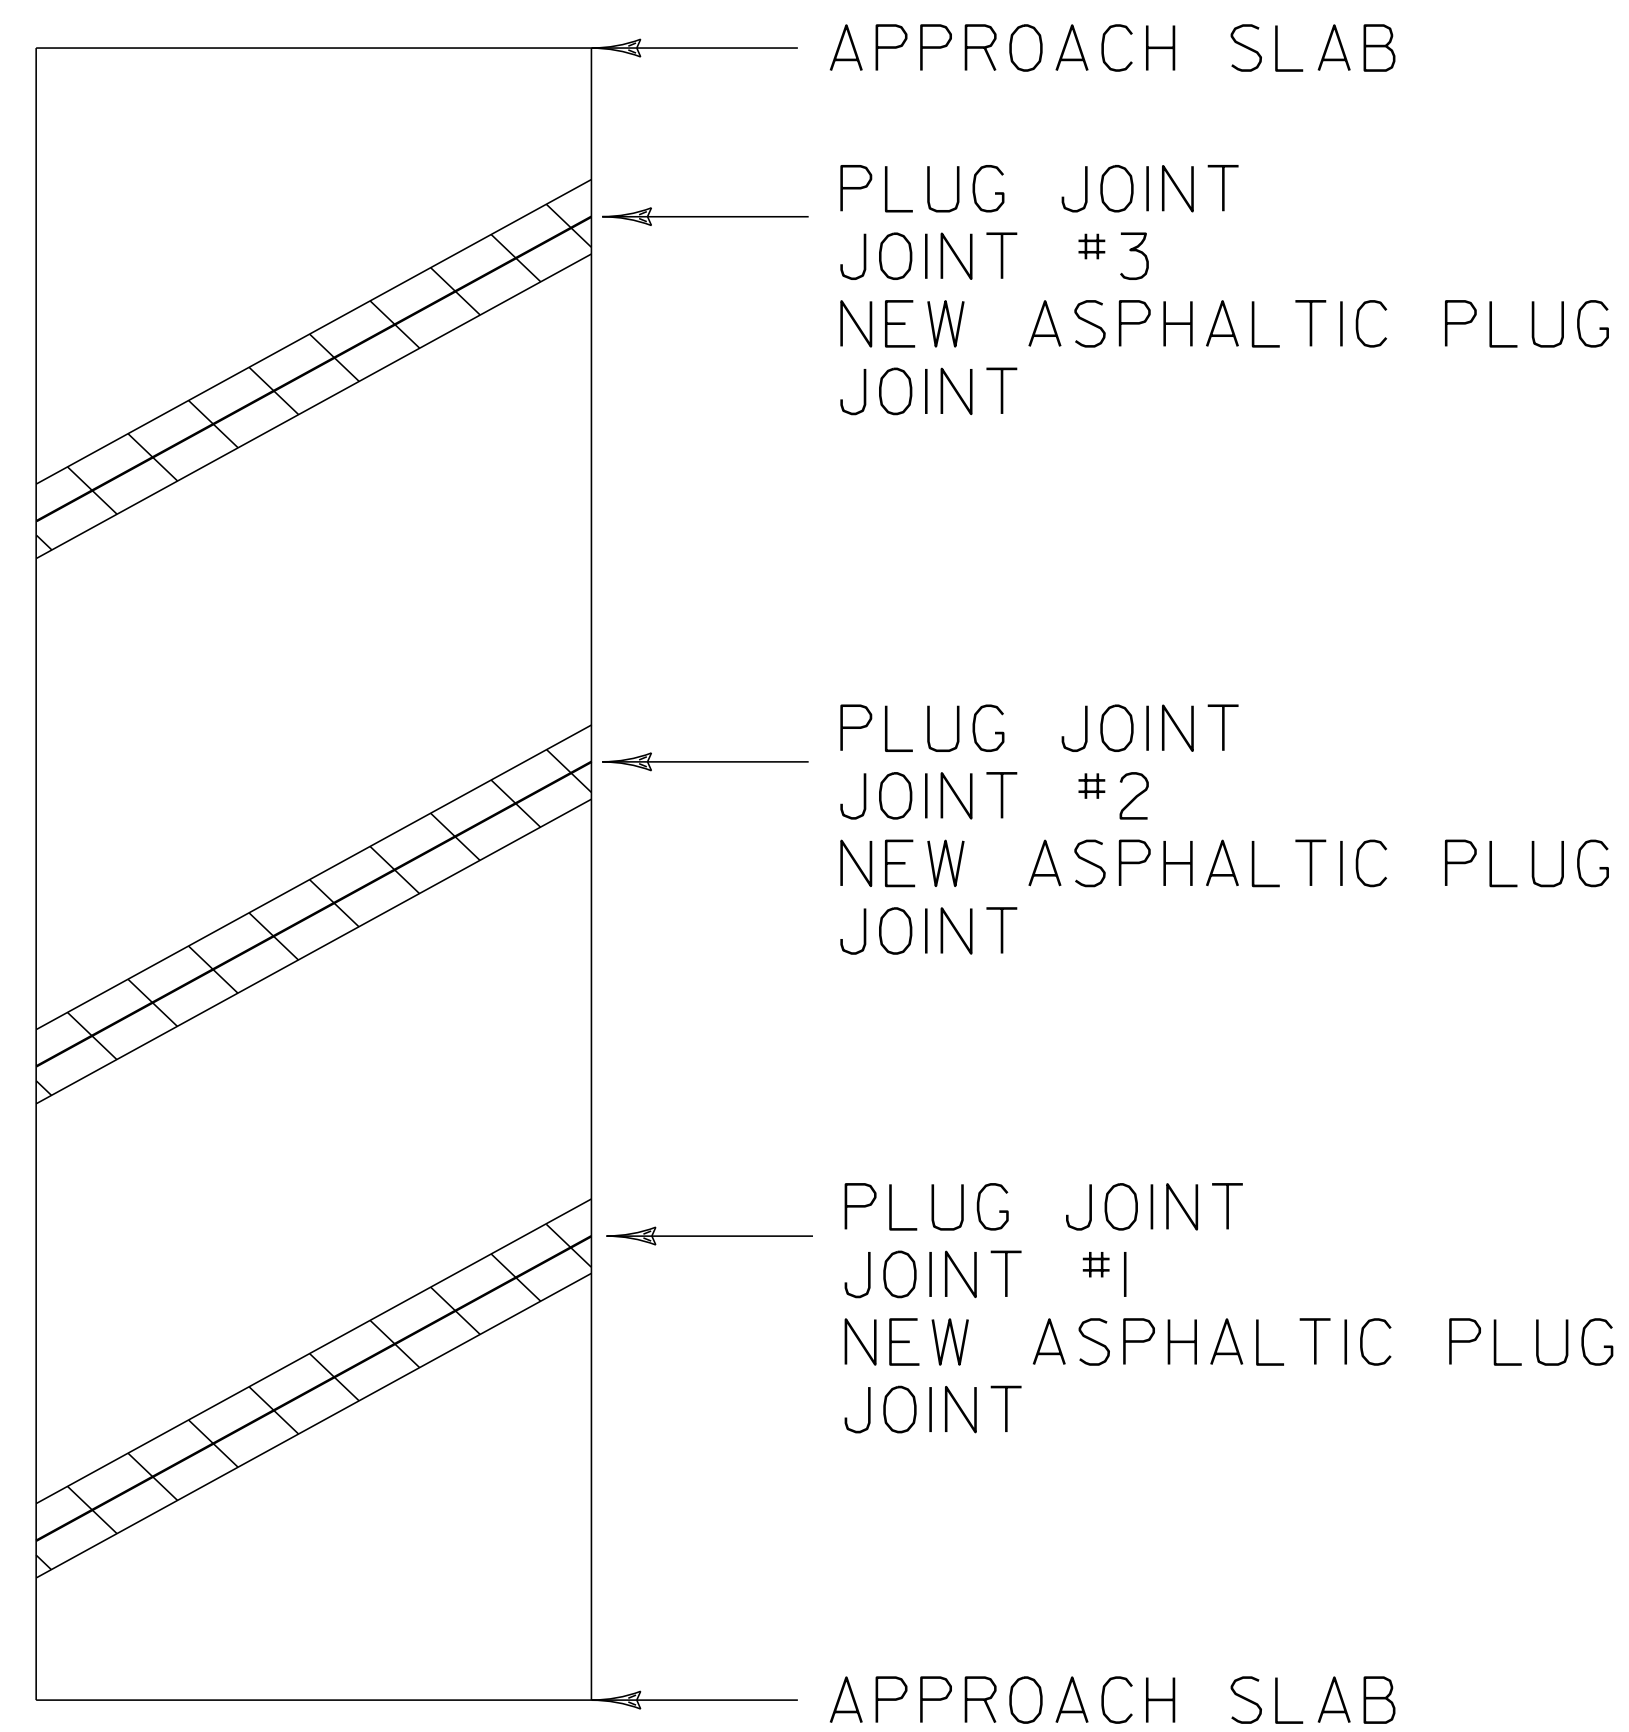

**BRIDGE 20N**


MM 28.608

LENGTH OF ASPHALTIC PLUG JOINTS:

- JOINT #1 - 45'
- JOINT #2 - 45'
- JOINT #3 - 45'

TOTAL = 135'

↑  
SOUTHBOUND  
DIRECTION OF TRAVEL

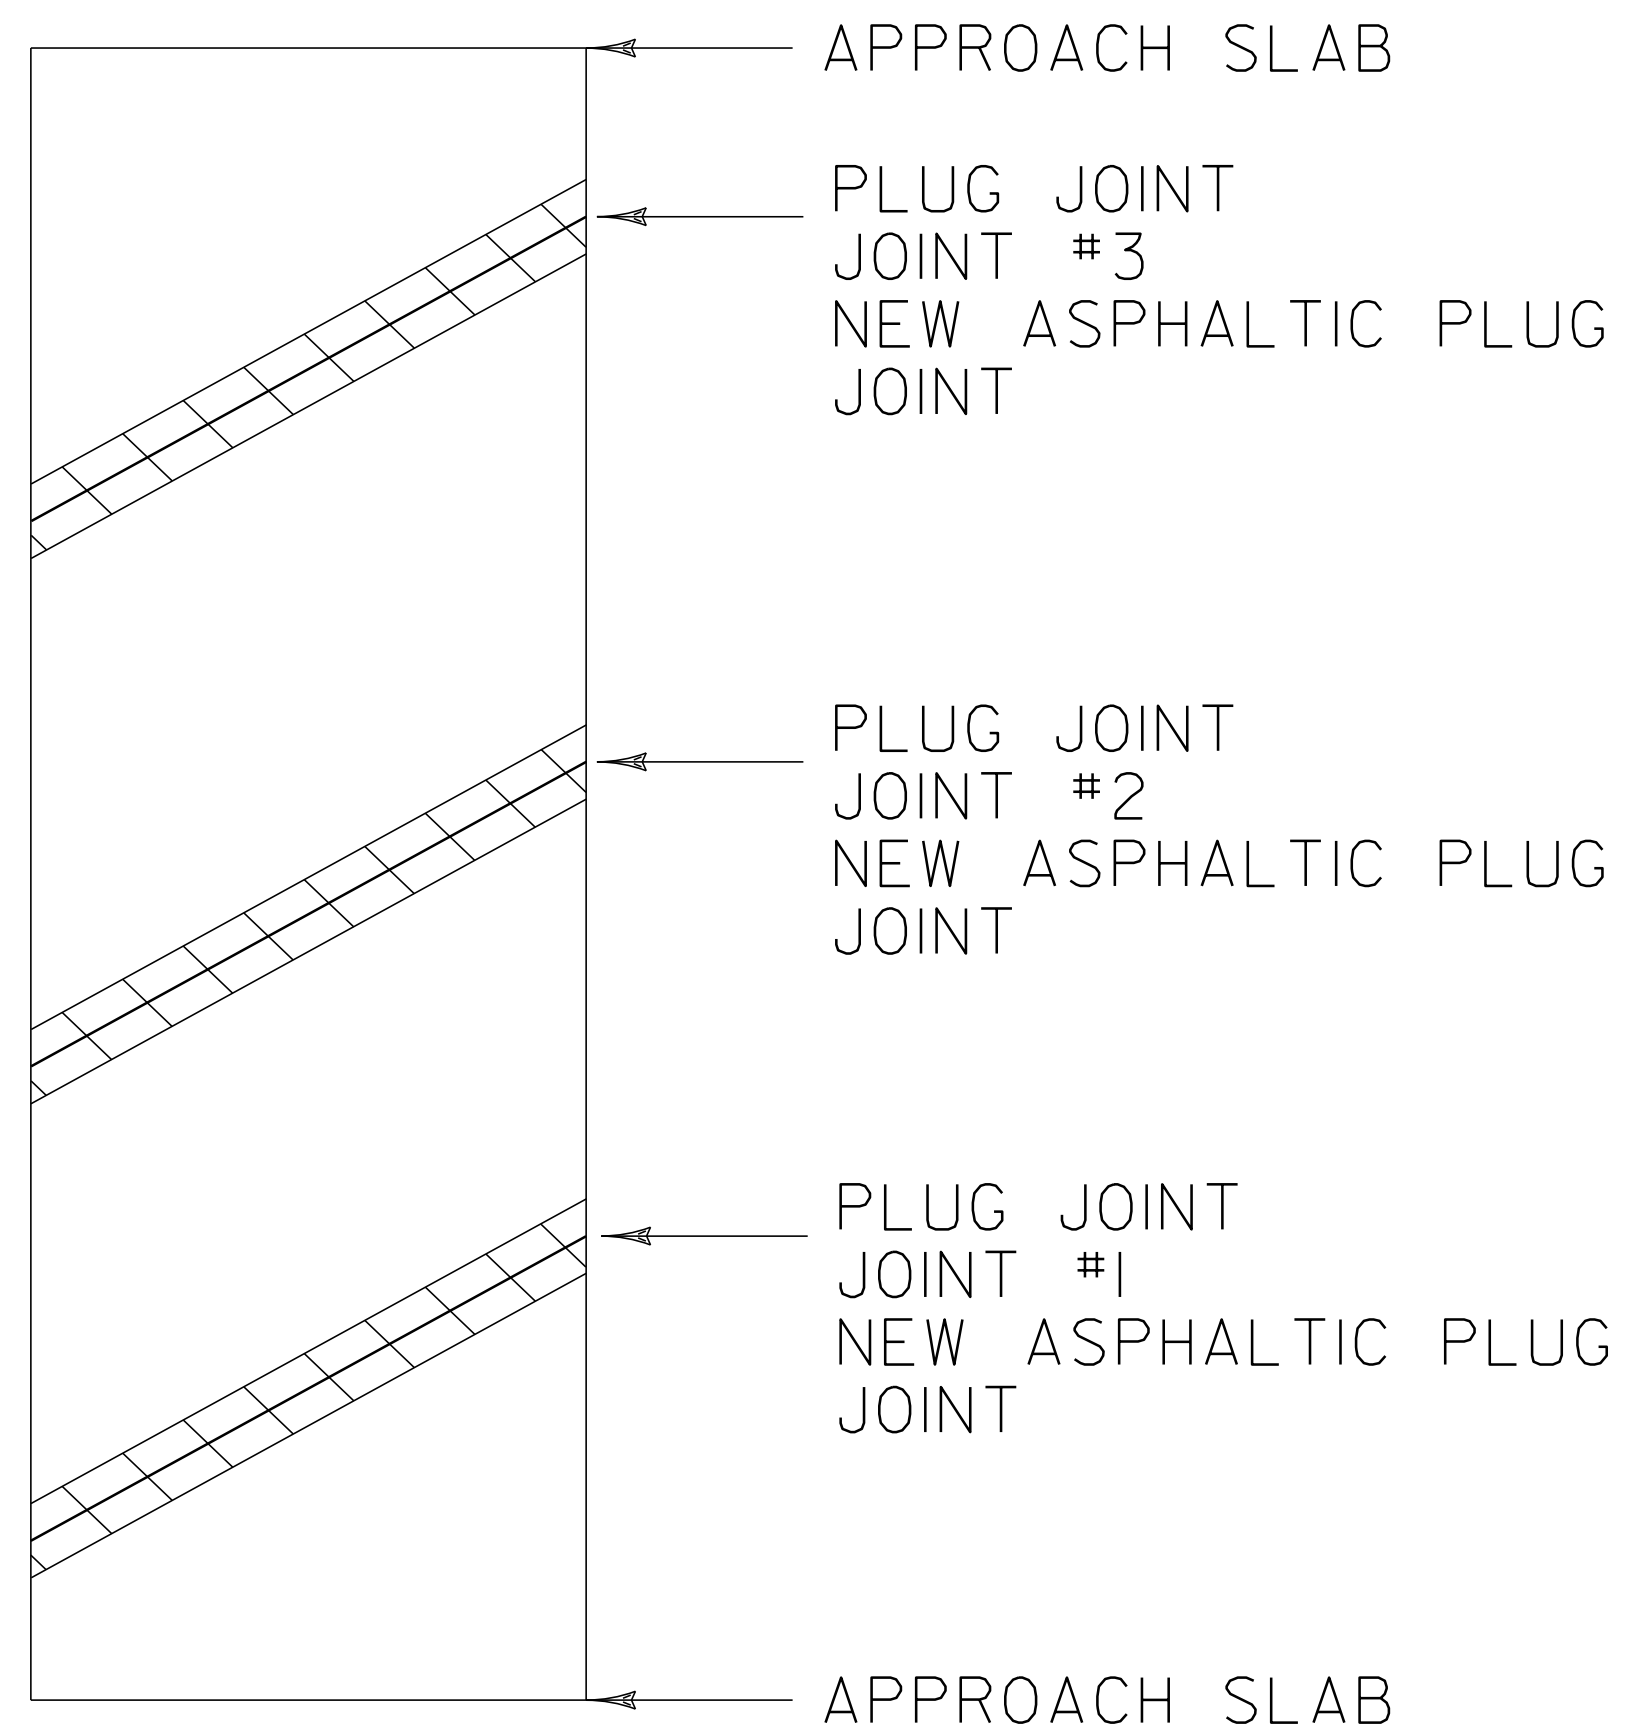

**BRIDGE 20S**


MM 28.608

LENGTH OF ASPHALTIC PLUG JOINTS:

- JOINT #1 - 45'
- JOINT #2 - 45'
- JOINT #3 - 45'

TOTAL = 135'

↑  
SOUTHBOUND  
DIRECTION OF TRAVEL

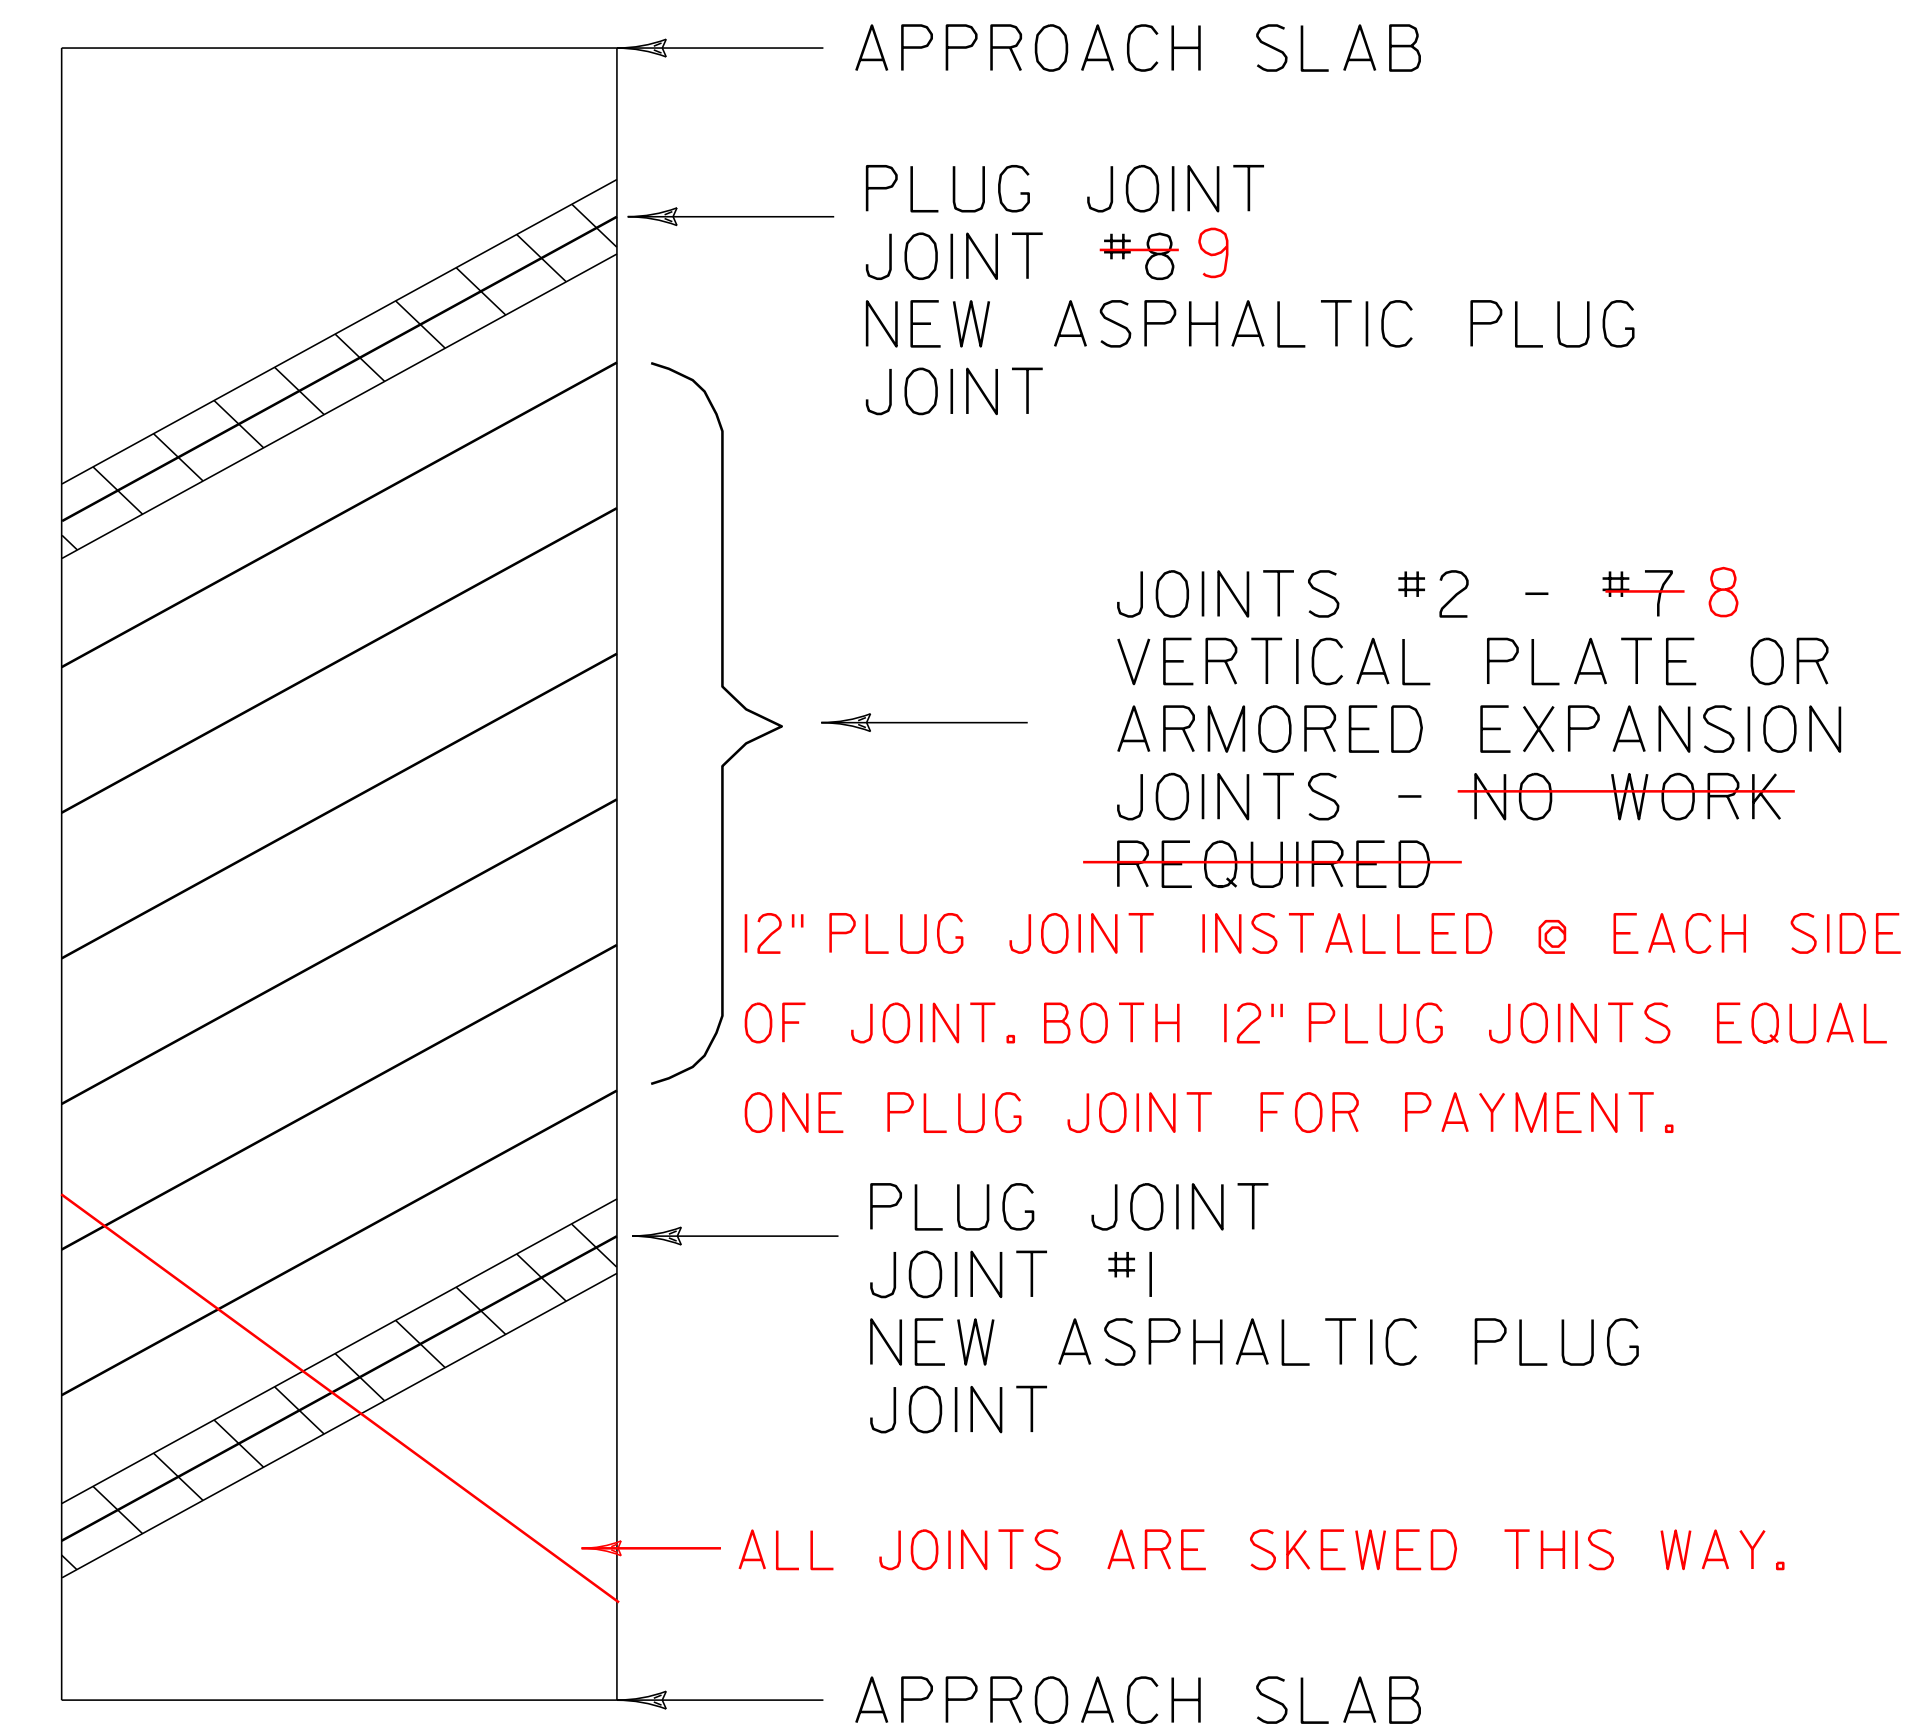

**BRIDGE 21S**

MM 31.039

LENGTH OF ASPHALTIC PLUG JOINTS:

- JOINT #1 - 45'
- JOINT #2 - 45'

TOTAL = 90'

**LEGEND**



EXISTING BRIDGE JOINTS TO BE REPAIRED WITH ASPHALTIC PLUG JOINT

**BRIDGE  
DETAIL SHEET  
# 2**

PROJECT NAME: BRATTLEBORO - ROCKINGHAM  
PROJECT NUMBER: IM SURF (37)

FILE NAME: I2a398\pi2a398.dgn  
PROJECT LEADER: M. FOWLER  
DESIGNED BY: LOCKE  
IPARM FILE NAME: pi2a398bd2.i

PLOT DATE: 27-MAR-2014 13:15  
DRAWN BY: LOCKE  
CHECKED BY: HARRINGTON  
SHEET 6 OF 36