


BRIDGE 22S

MM 33.660

LENGTH OF ASPHALTIC PLUG JOINTS:

JOINT #1 - 45'
JOINT #2 - 45'

TOTAL = 90'

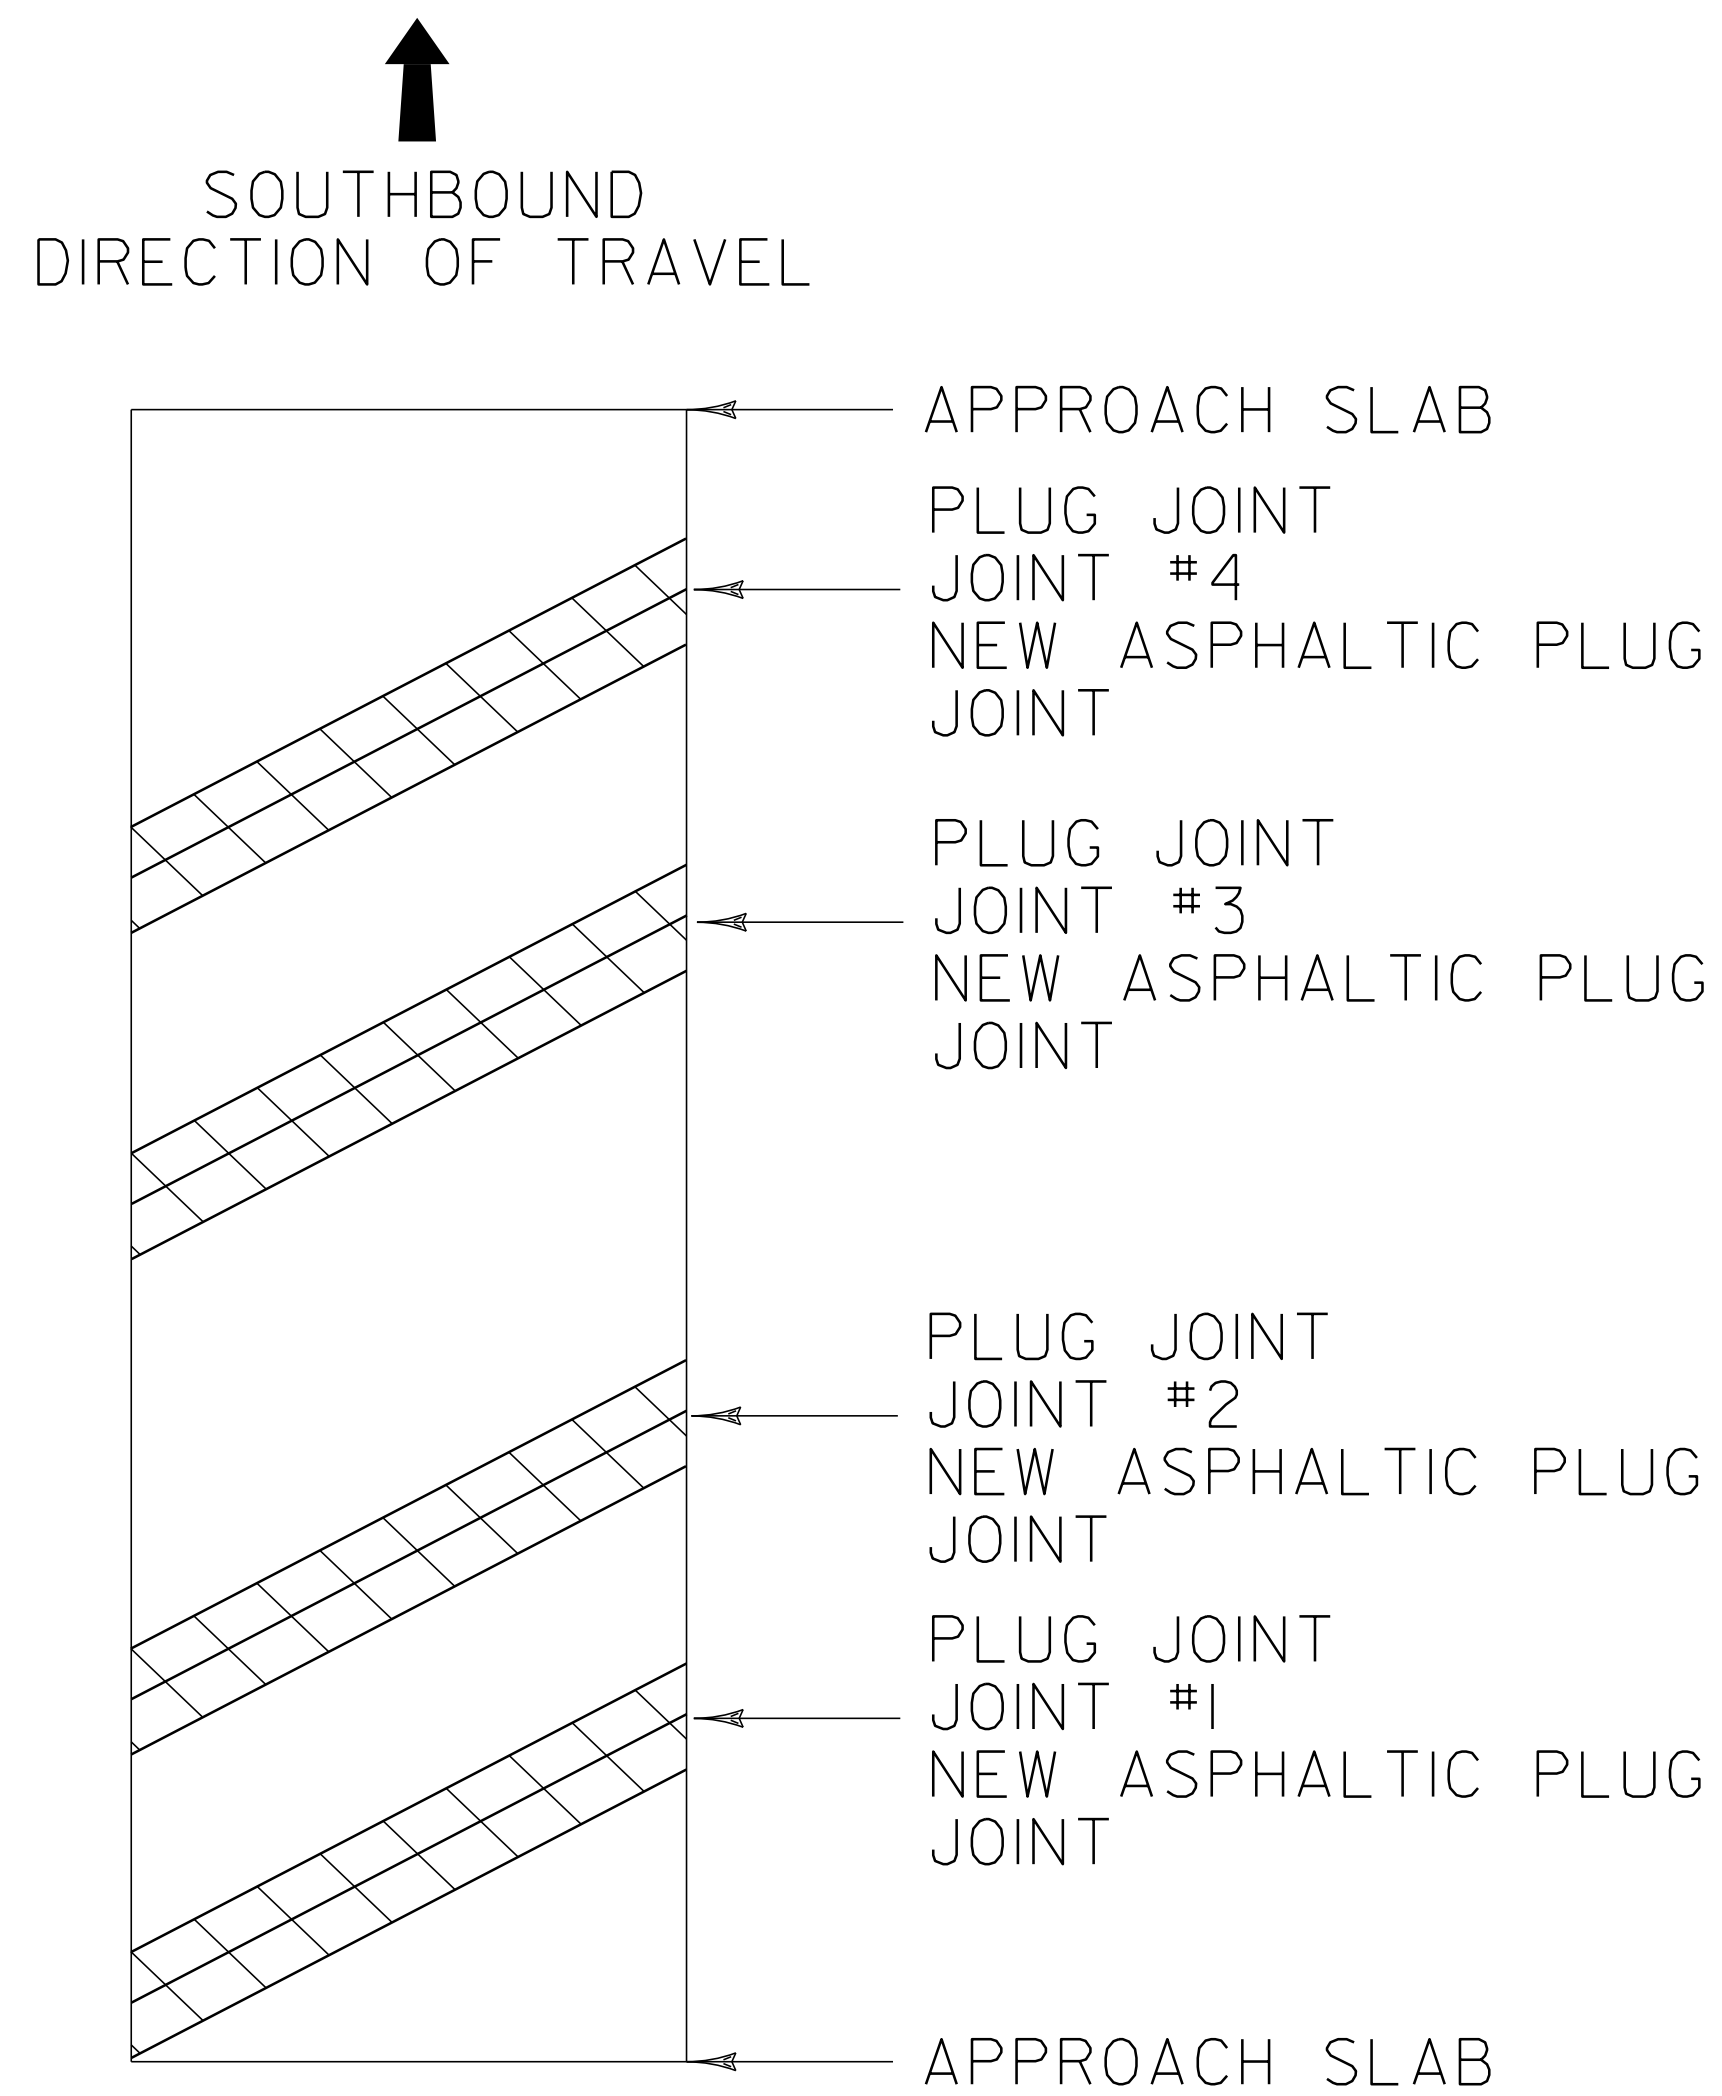


BRIDGE 23S

MM 35.204

LENGTH OF ASPHALTIC PLUG JOINTS:

JOINT #1 = 64'
JOINT #2 = 64'
JOINT #3 = 64'
JOINT #4 = 64'

TOTAL = 256'

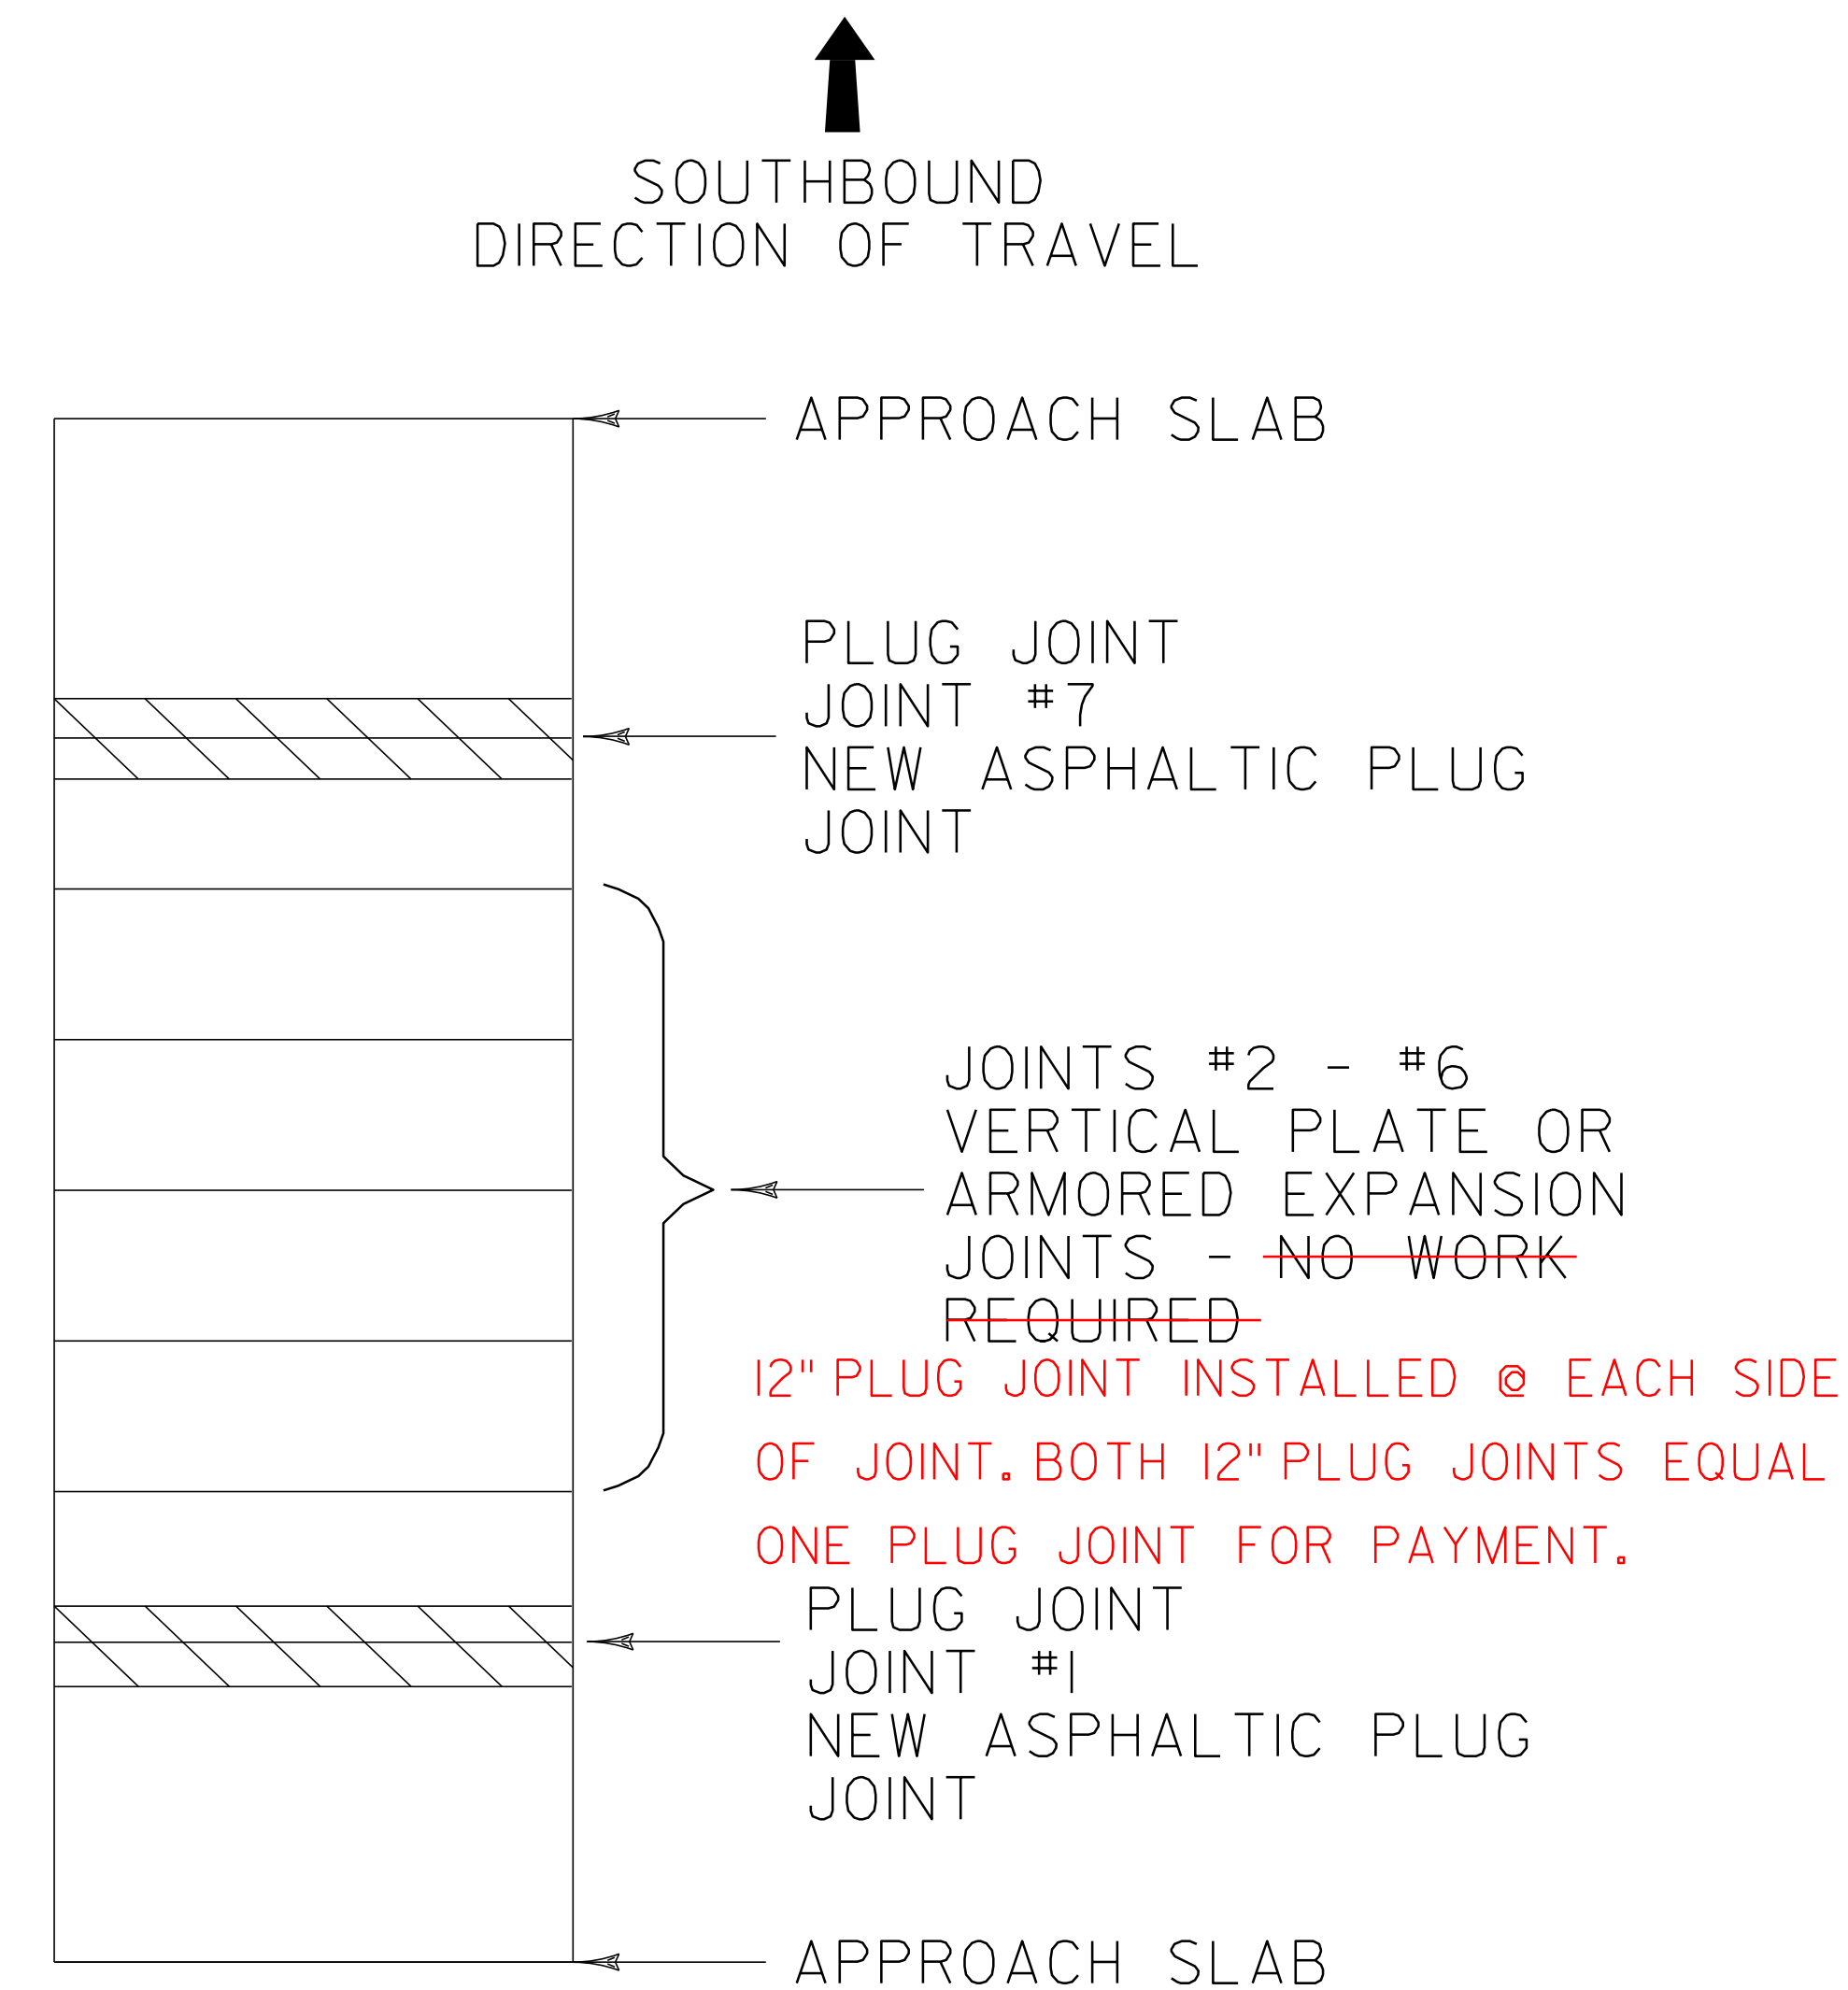

BRIDGE 24S


MM 35.495

LENGTH OF ASPHALTIC PLUG JOINTS:

JOINT #1 - 38'
JOINT #7 - 38'

TOTAL = 76'

LEGEND

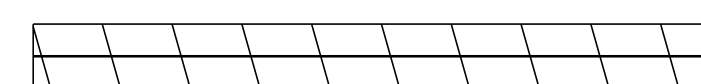

EXISTING BRIDGE JOINTS TO BE
REPAIRED WITH ASPHALTIC PLUG JOINT

**BRIDGE
DETAIL SHEET
3**

PROJECT NAME: BRATTLEBORO - ROCKINGHAM
PROJECT NUMBER: IM SURF (37)

FILE NAME: I2a398\pl2a398.dgn
PROJECT LEADER: M. FOWLER
DESIGNED BY: LOCKE
IPARM FILE NAME: pl2a398bd3.i

PLOT DATE: 27-MAR-2014 13:15
DRAWN BY: LOCKE
CHECKED BY: HARRINGTON
SHEET 7 OF 36