


EXIT 5 - RAMP C & E NORTHBOUND OFF RAMP

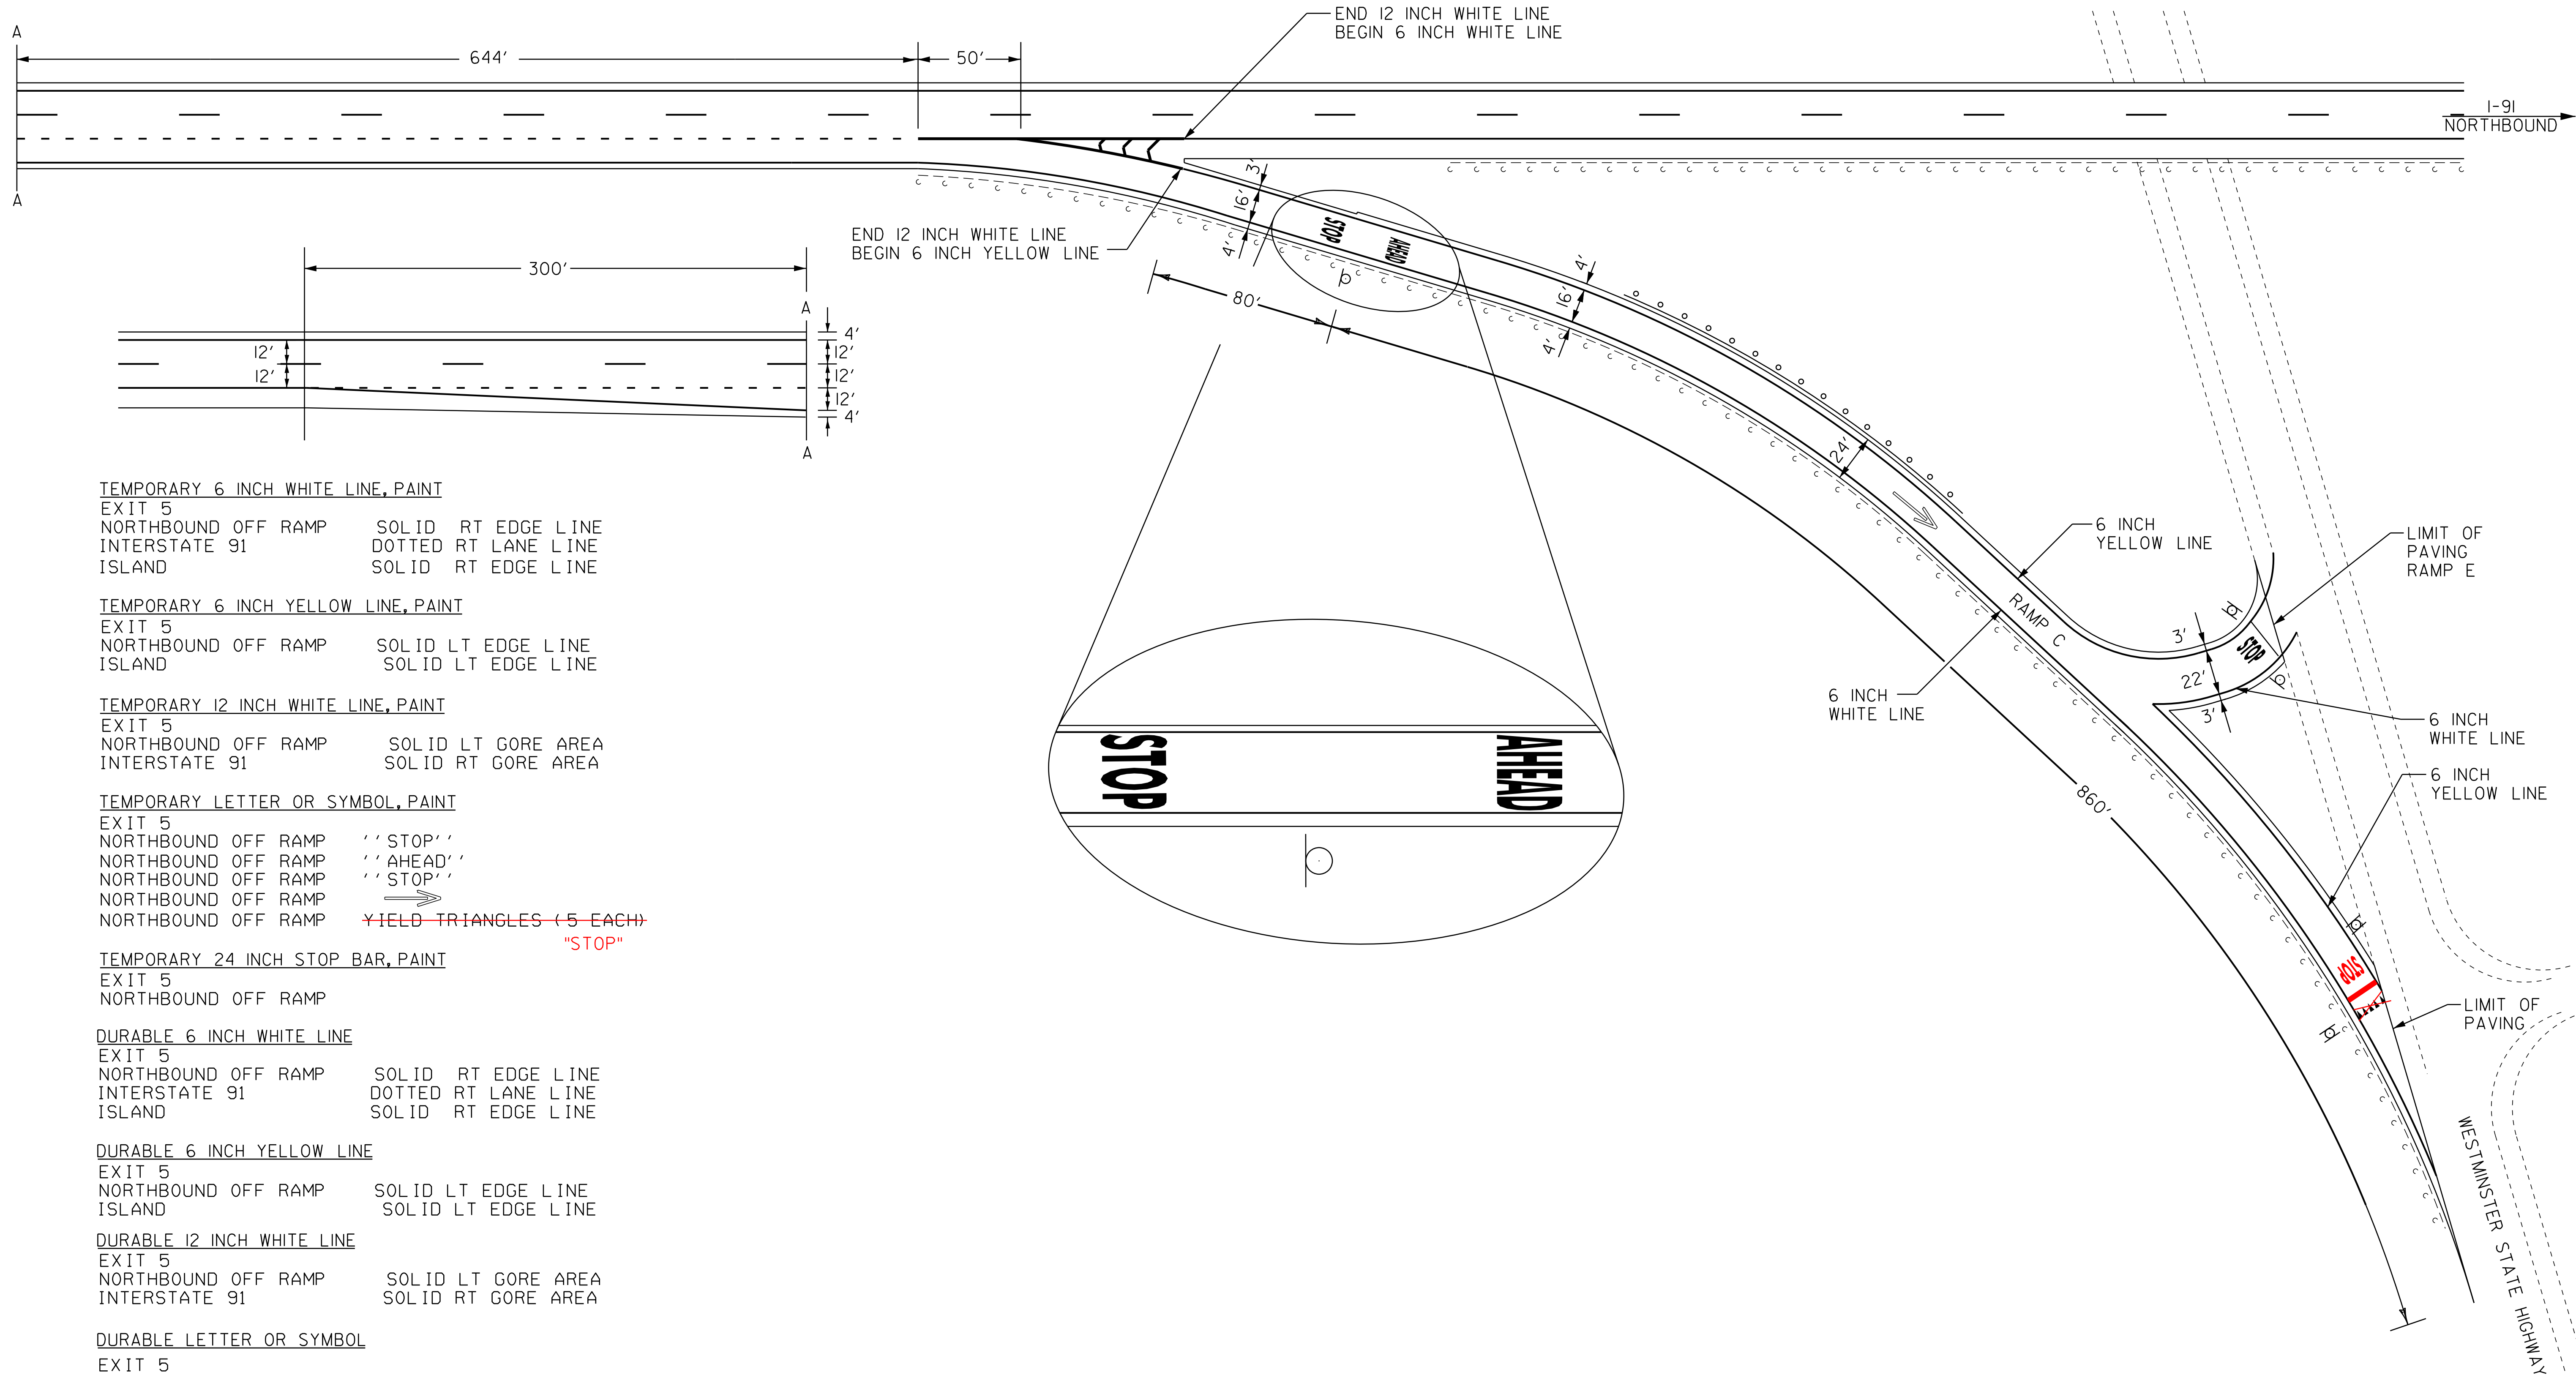

TEMPORARY 6 INCH WHITE LINE, PAINT
 EXIT 5
 NORTHBOUND OFF RAMP SOLID RT EDGE LINE
 INTERSTATE 91 DOTTED RT LANE LINE
 ISLAND SOLID RT EDGE LINE

TEMPORARY 6 INCH YELLOW LINE, PAINT
 EXIT 5
 NORTHBOUND OFF RAMP SOLID LT EDGE LINE
 ISLAND SOLID LT EDGE LINE

TEMPORARY 12 INCH WHITE LINE, PAINT
 EXIT 5
 NORTHBOUND OFF RAMP SOLID LT GORE AREA
 INTERSTATE 91 SOLID RT GORE AREA

TEMPORARY LETTER OR SYMBOL, PAINT
 EXIT 5
 NORTHBOUND OFF RAMP "STOP"
 NORTHBOUND OFF RAMP "AHEAD"
 NORTHBOUND OFF RAMP "STOP"
 NORTHBOUND OFF RAMP →
 NORTHBOUND OFF RAMP ~~YIELD TRIANGLES (5 EACH)~~
"STOP"

TEMPORARY 24 INCH STOP BAR, PAINT
 EXIT 5
 NORTHBOUND OFF RAMP

DURABLE 6 INCH WHITE LINE
 EXIT 5
 NORTHBOUND OFF RAMP SOLID RT EDGE LINE
 INTERSTATE 91 DOTTED RT LANE LINE
 ISLAND SOLID RT EDGE LINE

DURABLE 6 INCH YELLOW LINE
 EXIT 5
 NORTHBOUND OFF RAMP SOLID LT EDGE LINE
 ISLAND SOLID LT EDGE LINE

DURABLE 12 INCH WHITE LINE
 EXIT 5
 NORTHBOUND OFF RAMP SOLID LT GORE AREA
 INTERSTATE 91 SOLID RT GORE AREA

DURABLE LETTER OR SYMBOL
 EXIT 5
 NORTHBOUND OFF RAMP "STOP"
 NORTHBOUND OFF RAMP "AHEAD"
 NORTHBOUND OFF RAMP "STOP"
 NORTHBOUND OFF RAMP →
 NORTHBOUND OFF RAMP YIELD TRIANGLES (5 EACH)

DURABLE 24 INCH STOP BAR
 EXIT 5
 NORTHBOUND OFF RAMP

NOTES:
 1. SEE QUANTITY SHEETS FOR DURABLE PAVEMENT MARKING OPTIONS.

PAVEMENT MARKING DETAIL SHEET 7 EXIT 5 NB	PROJECT NAME: BRATTLEBORO - ROCKINGHAM
	PROJECT NUMBER: IM SURF (37)
	FILE NAME: pl2a398.dgn
	PLOT DATE: 27-MAR-2014 13:15
PROJECT LEADER: M. FOWLER	DRAWN BY: LOCKE
DESIGNED BY: LOCKE	CHECKED BY: HARRINGTON
IPARM FILE NAME: pl2a398pmd7.i	SHEET 18 OF 36