
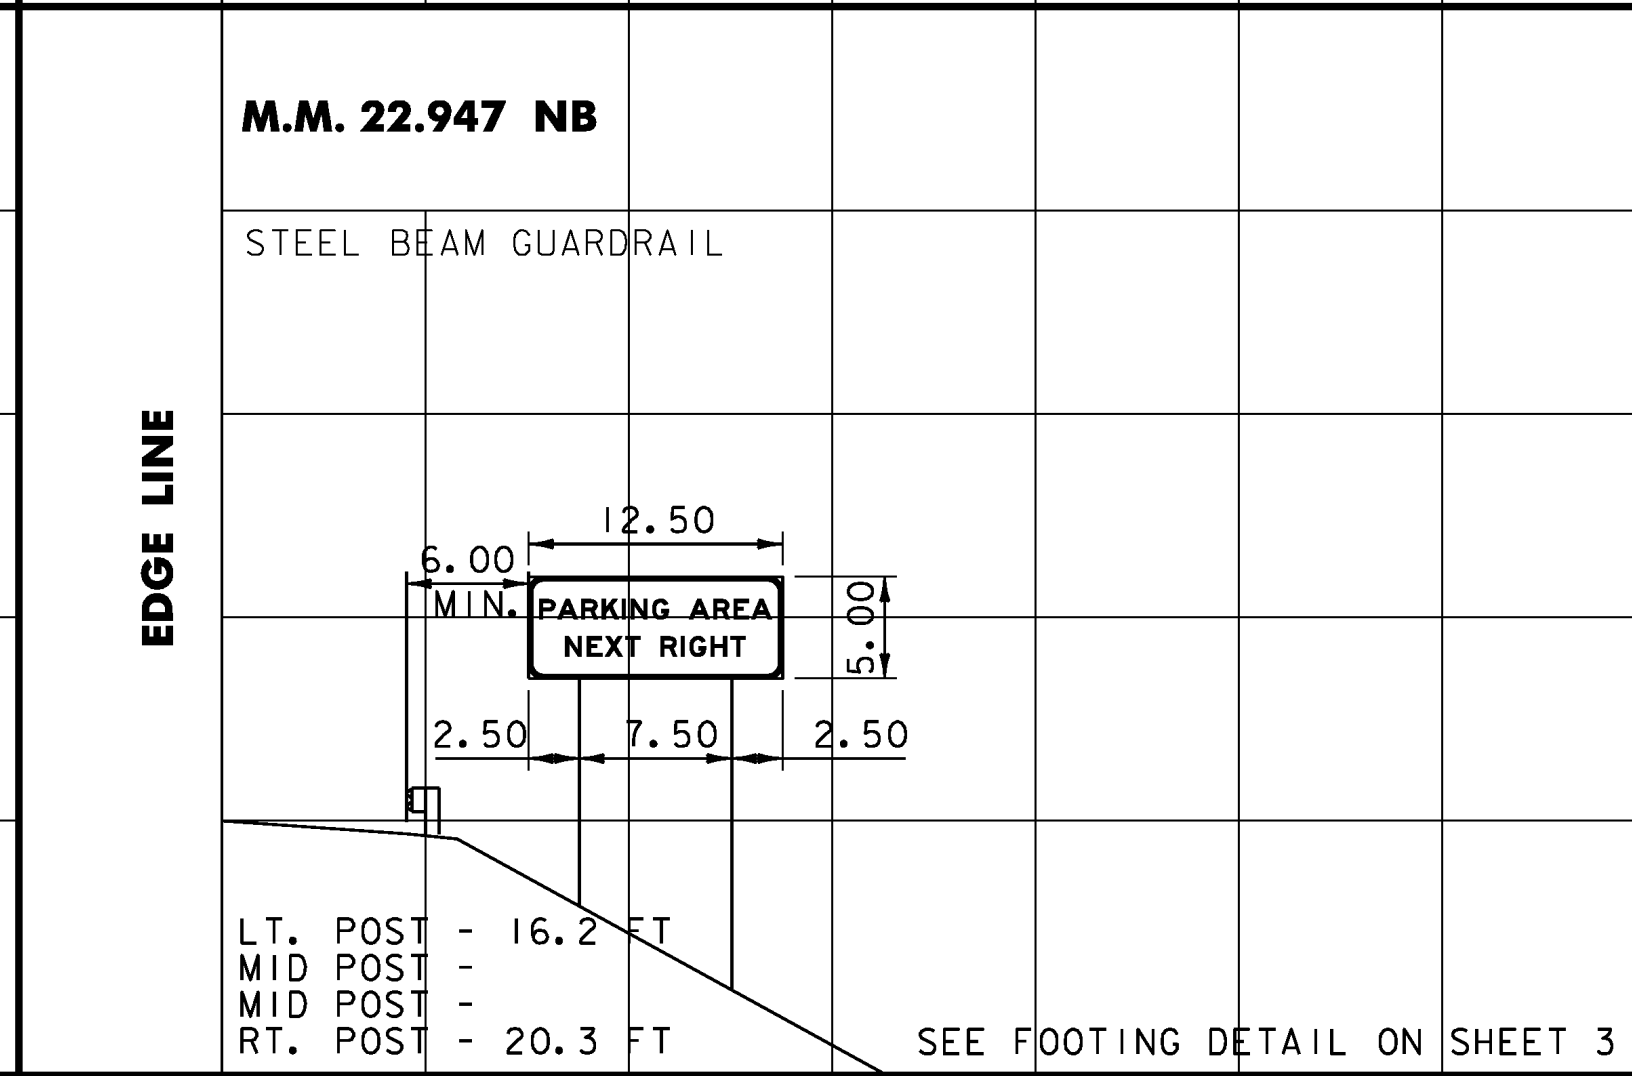
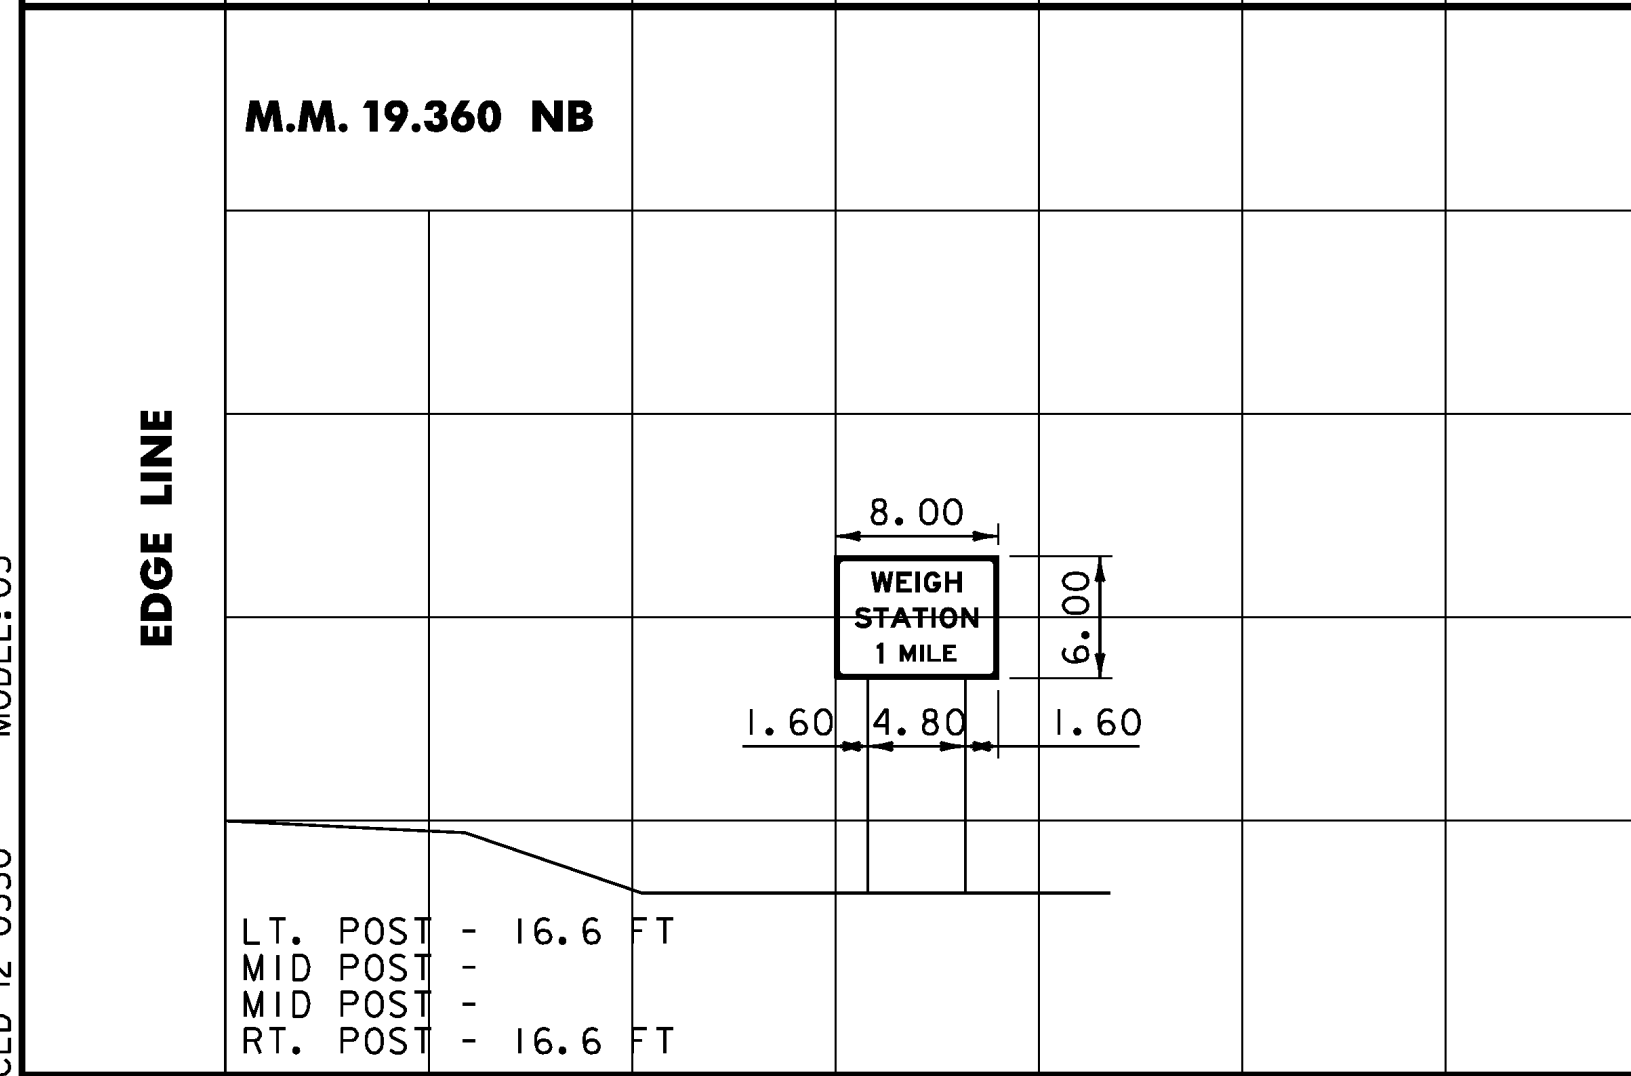
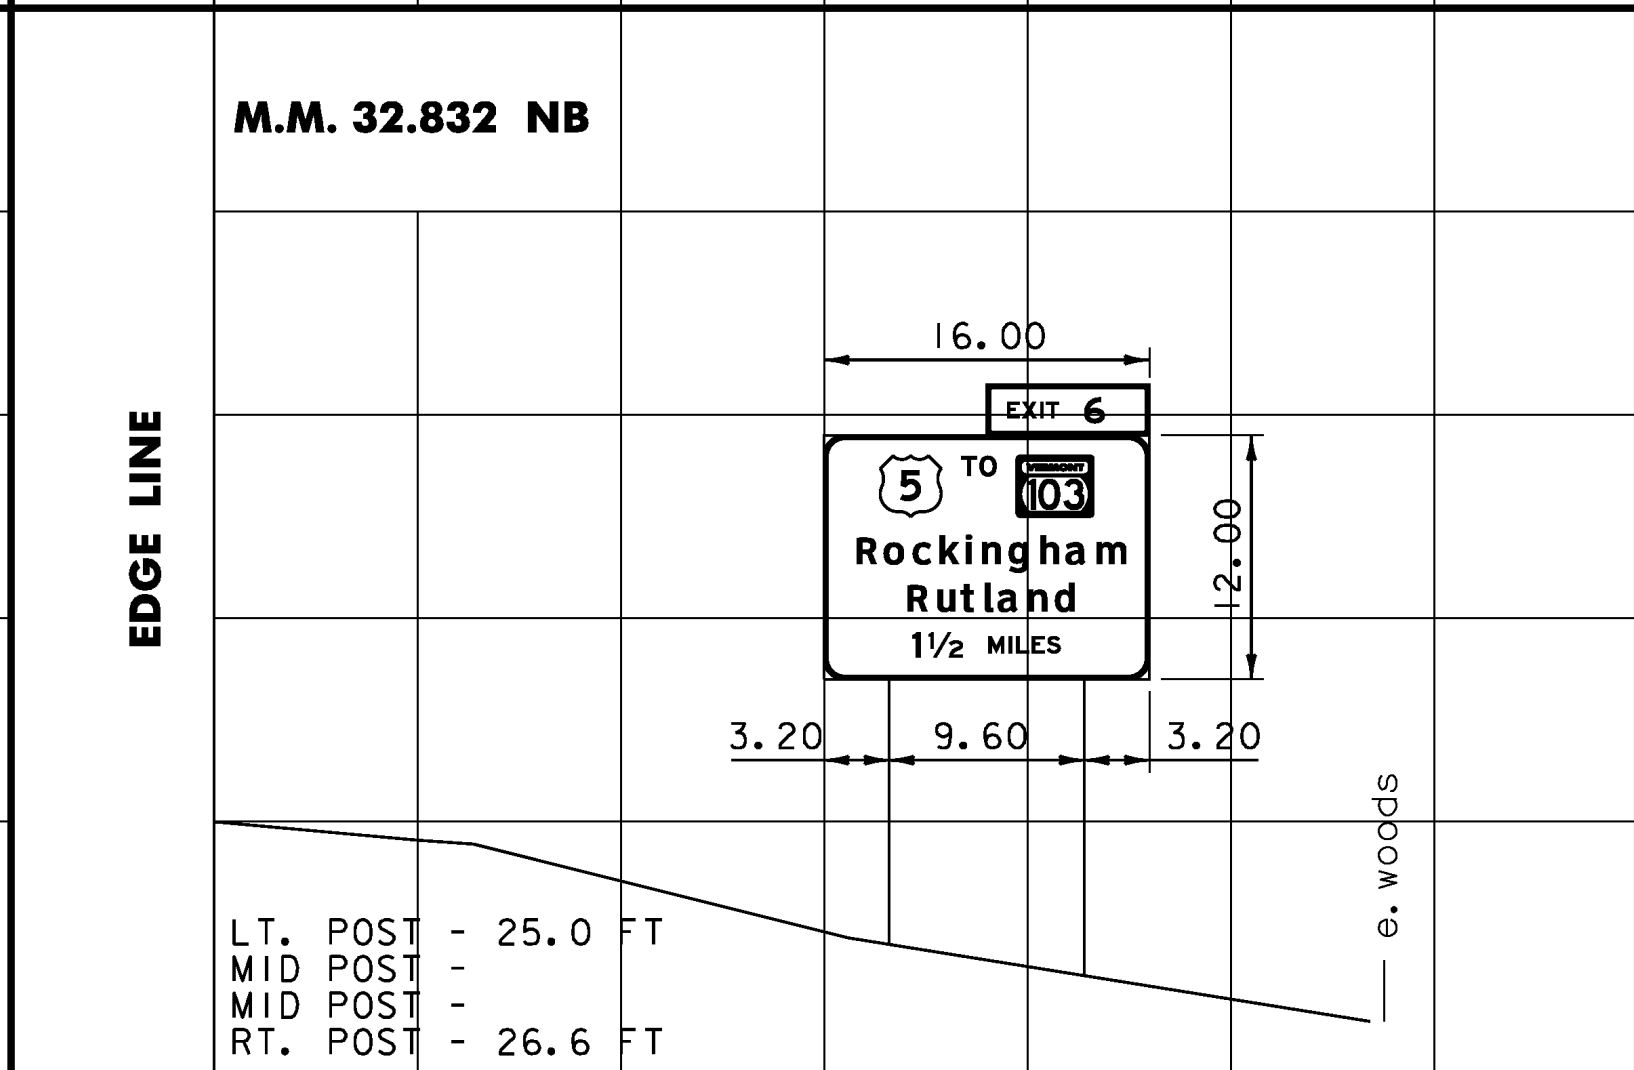
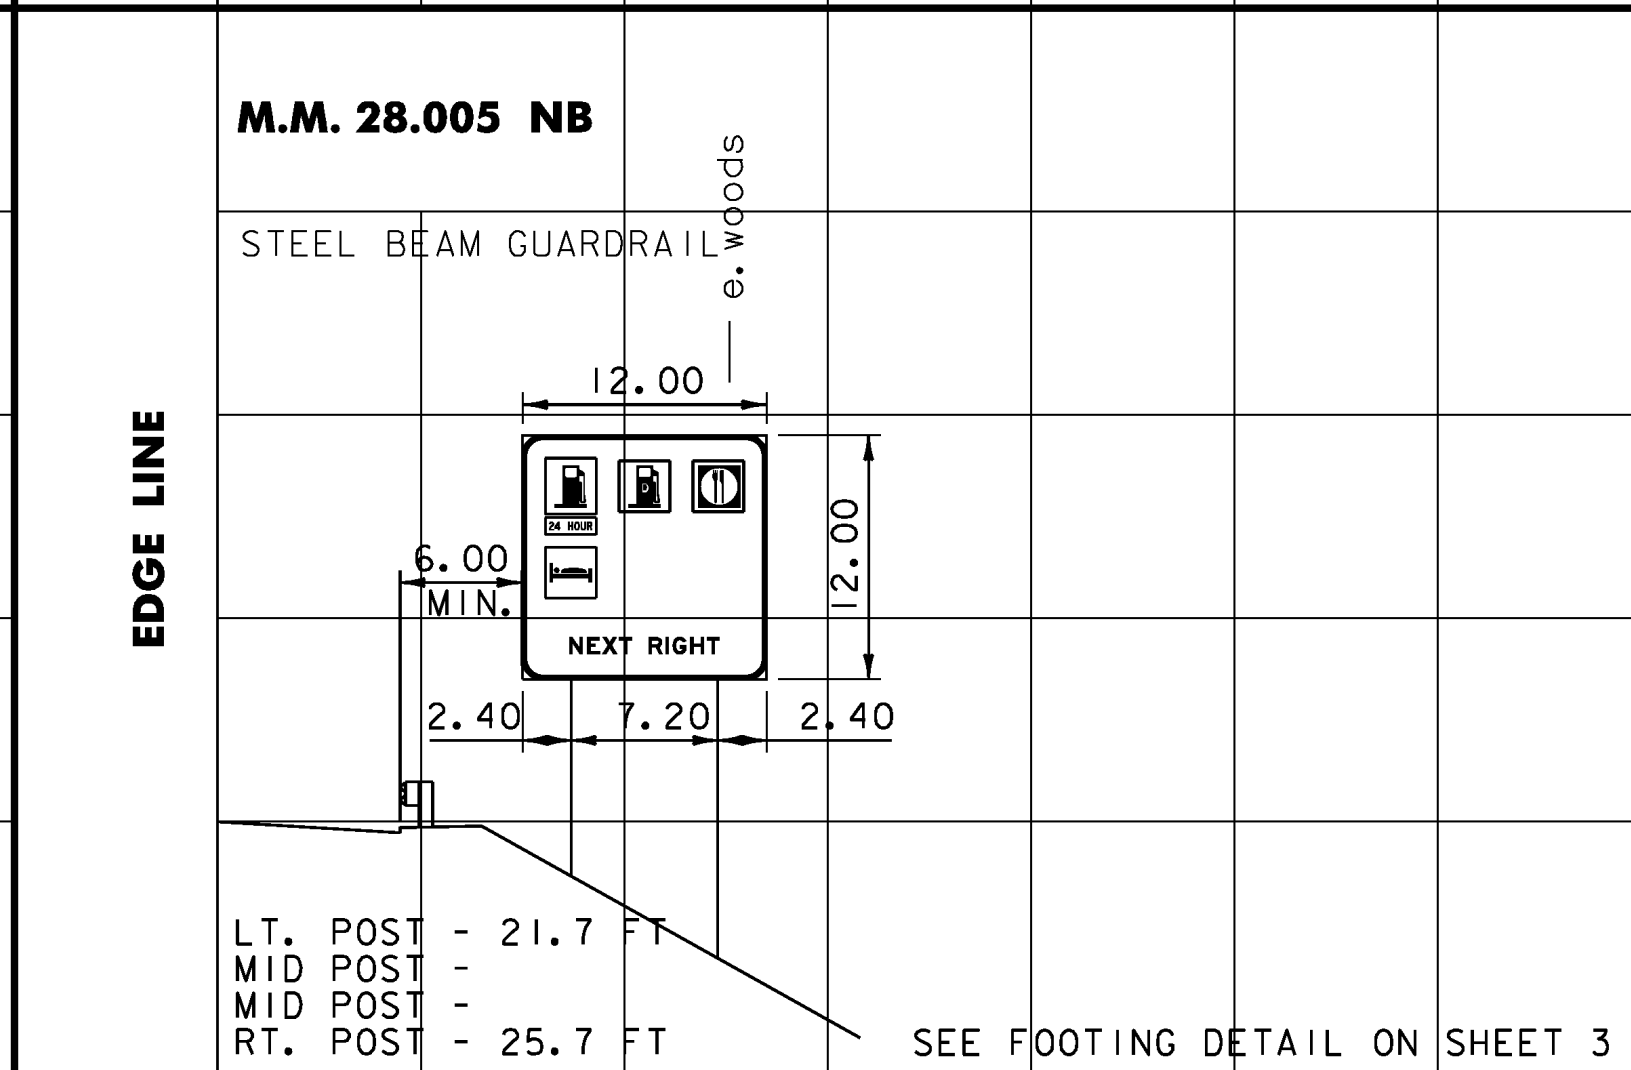
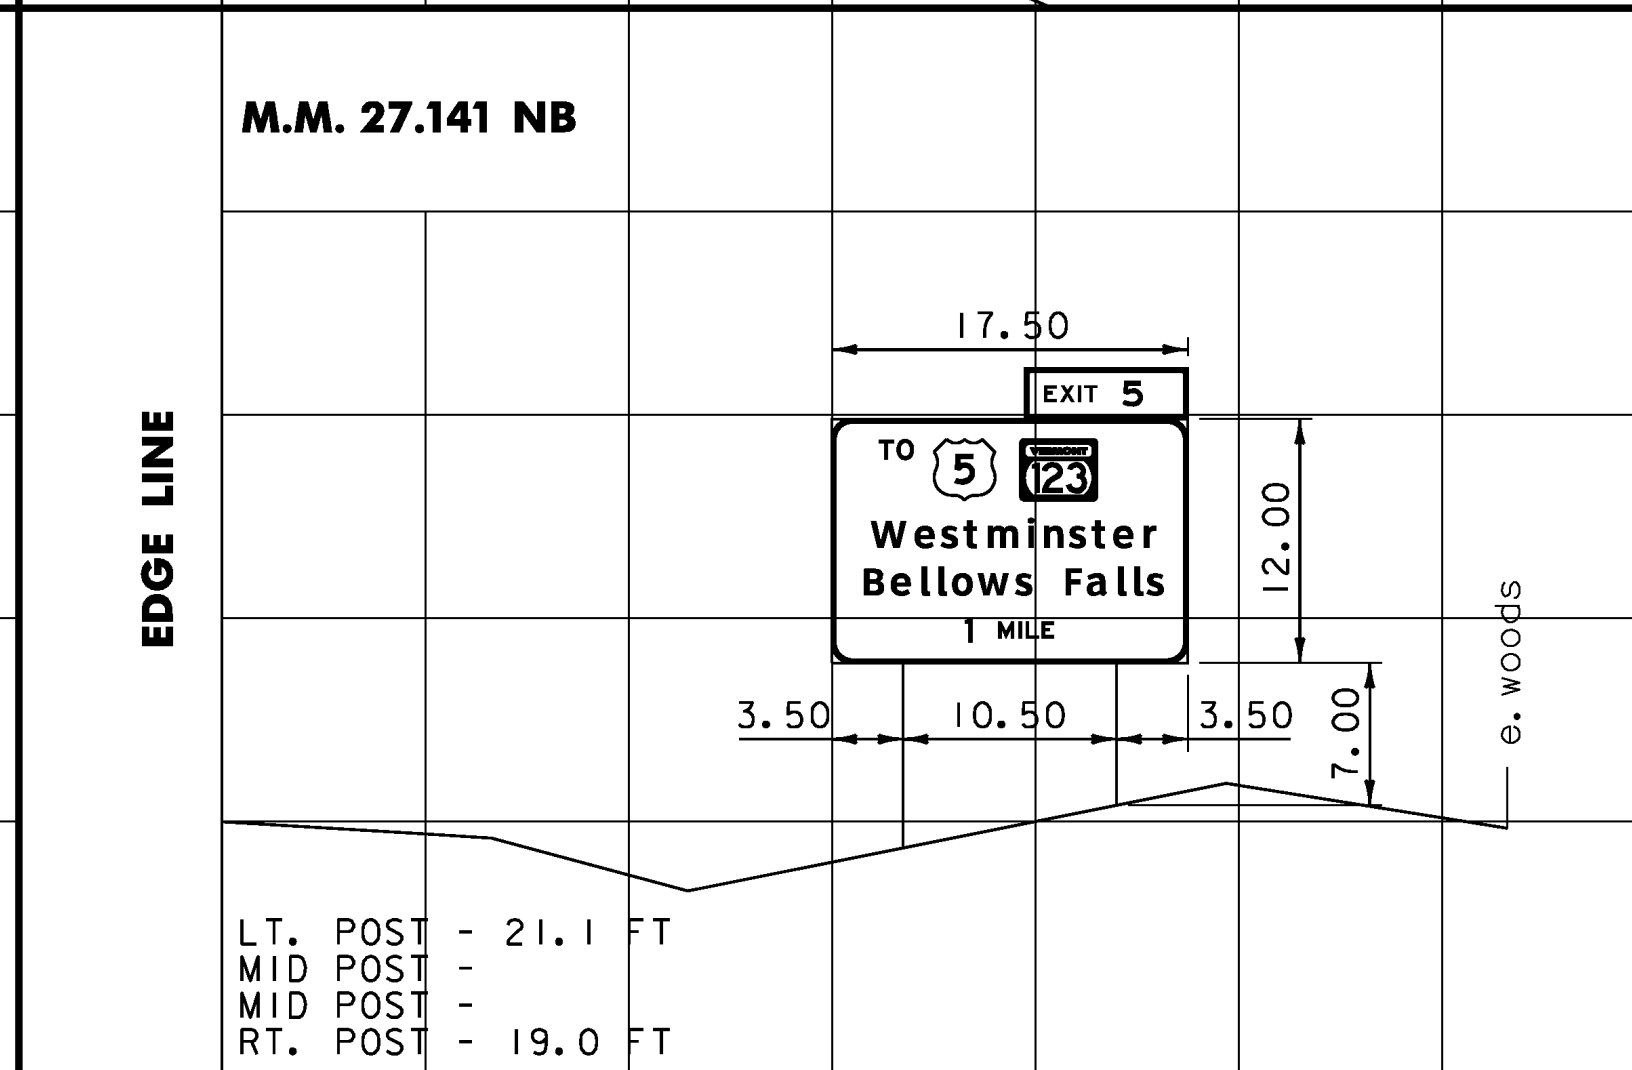
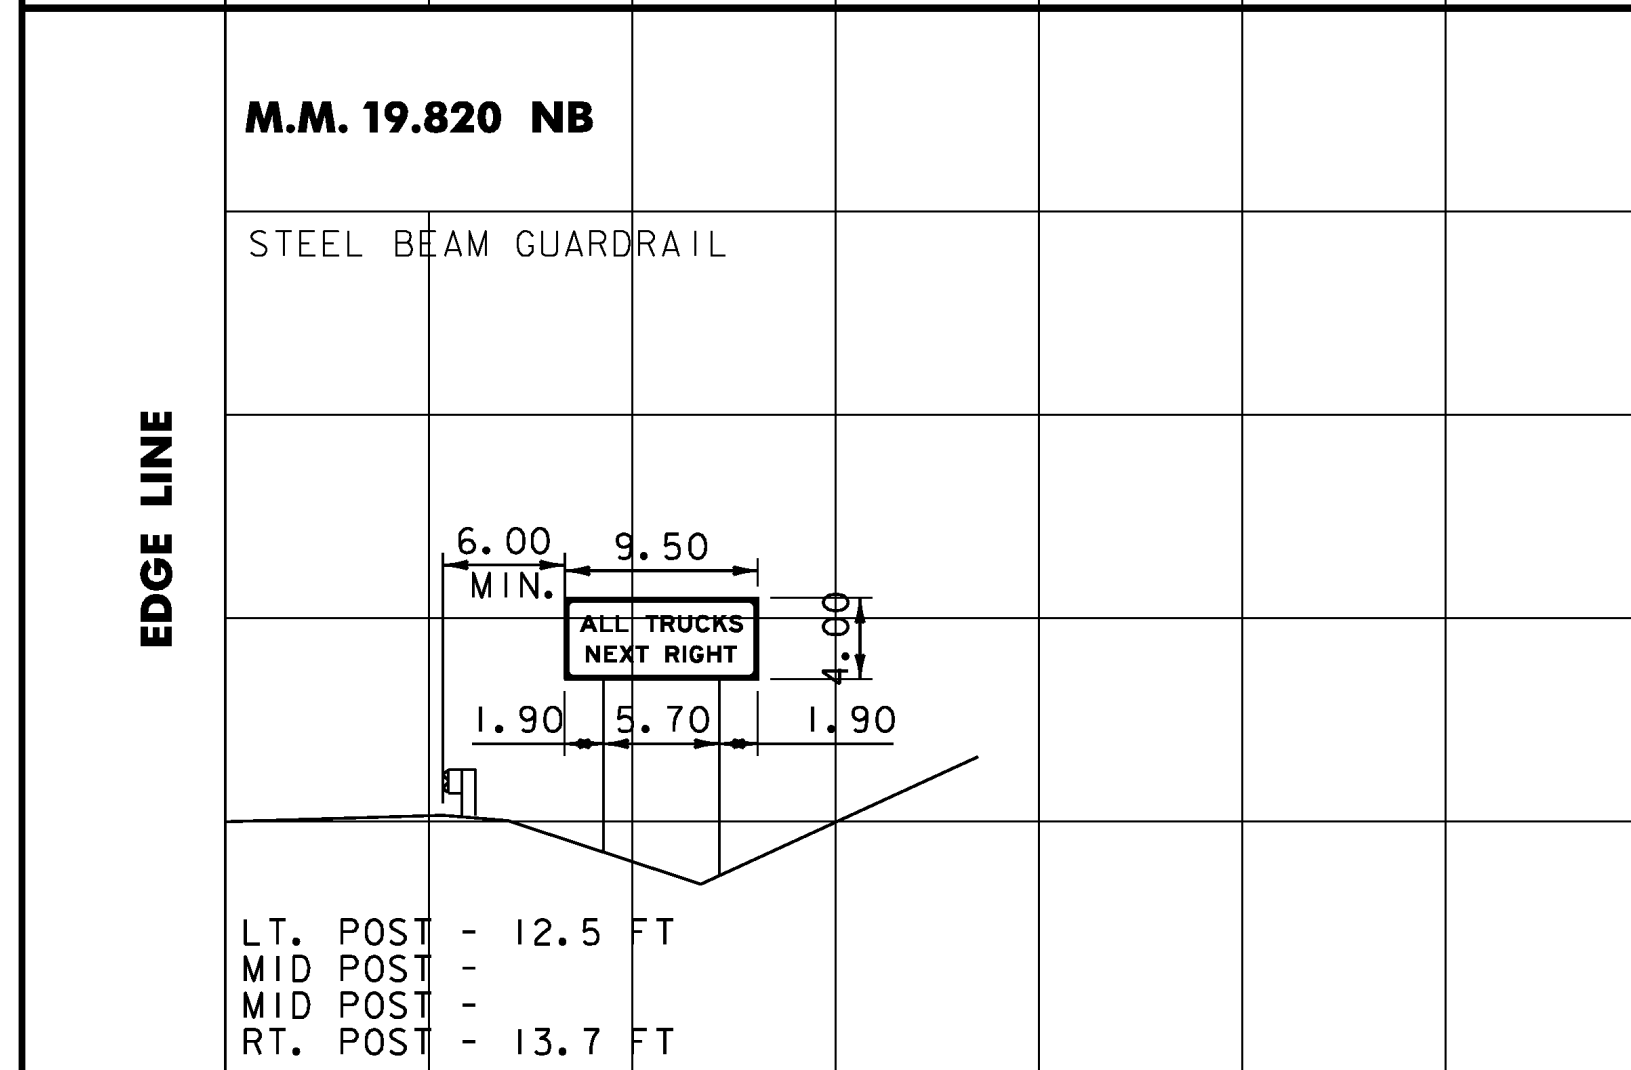
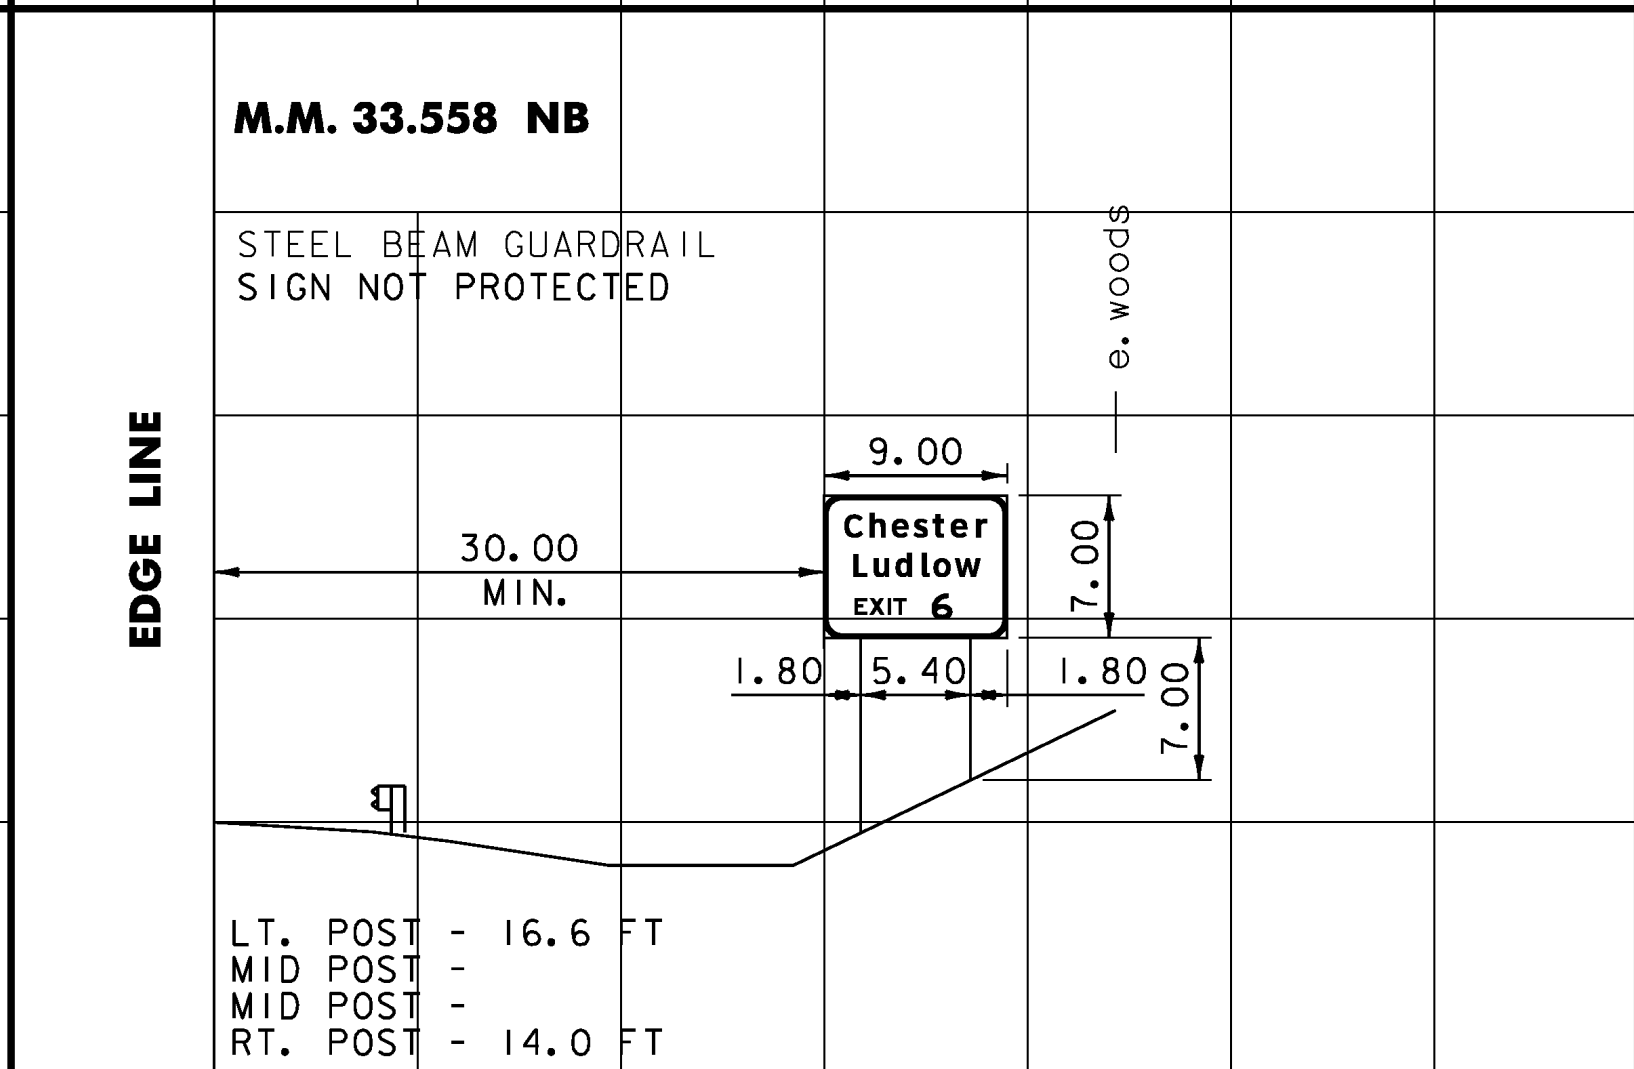
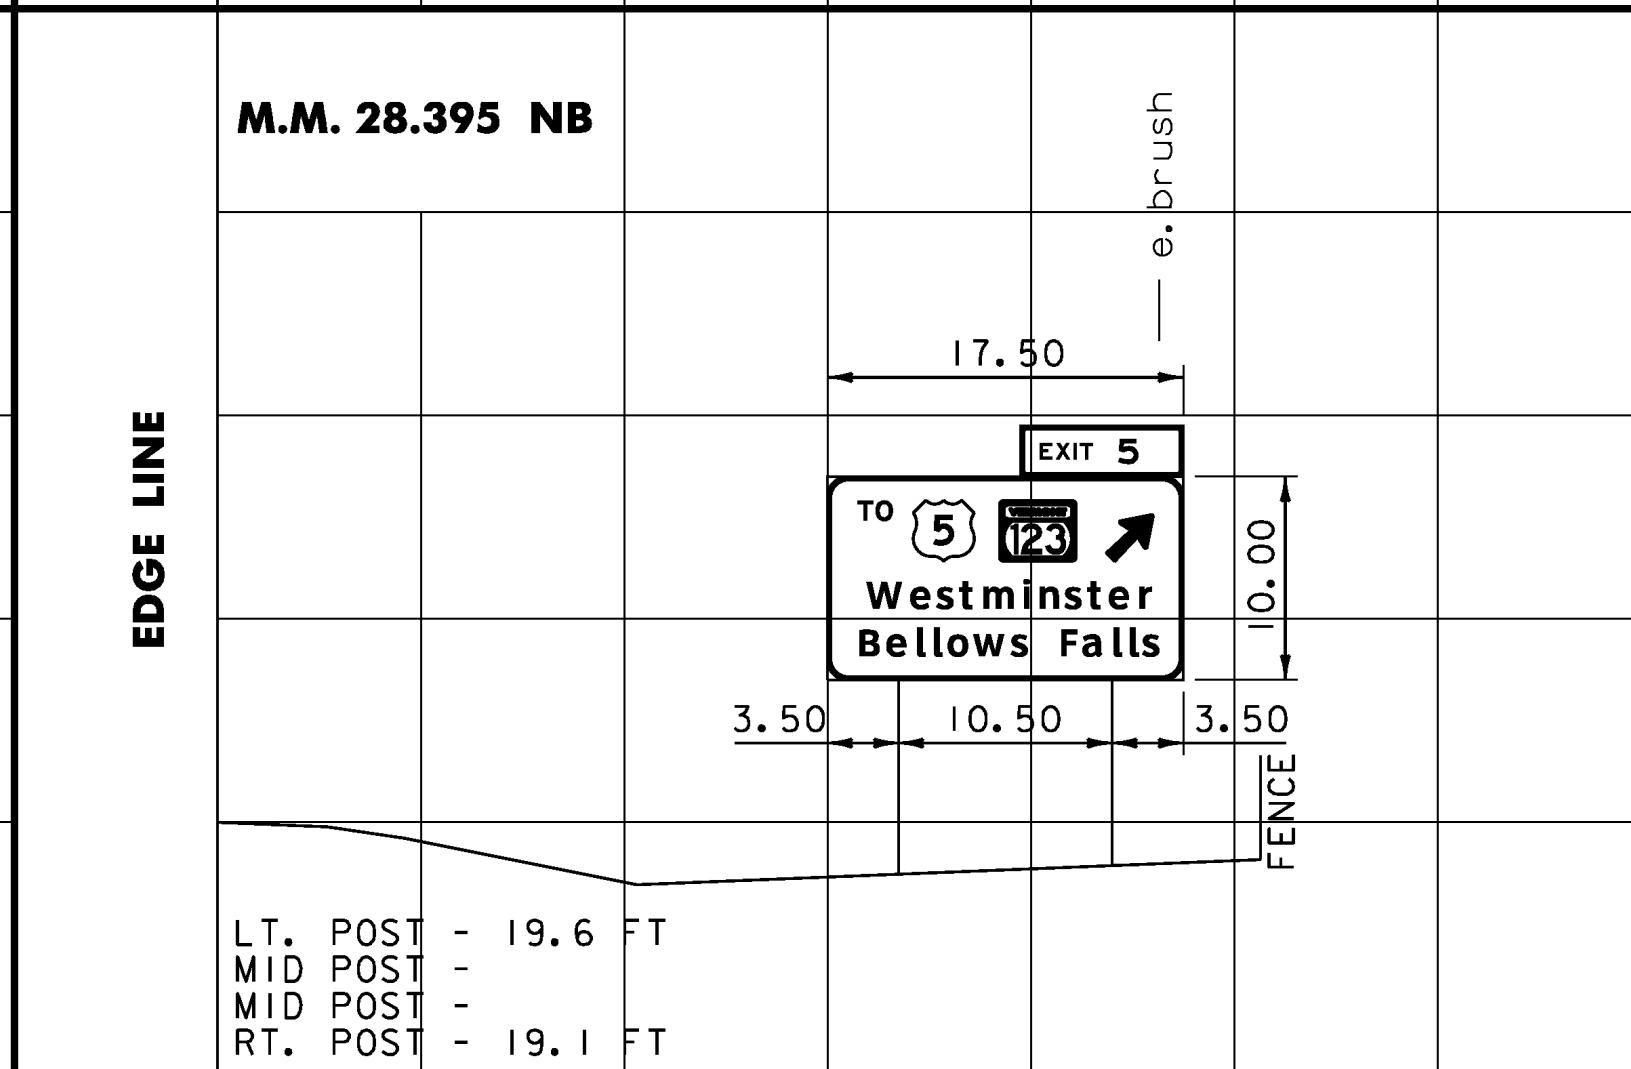
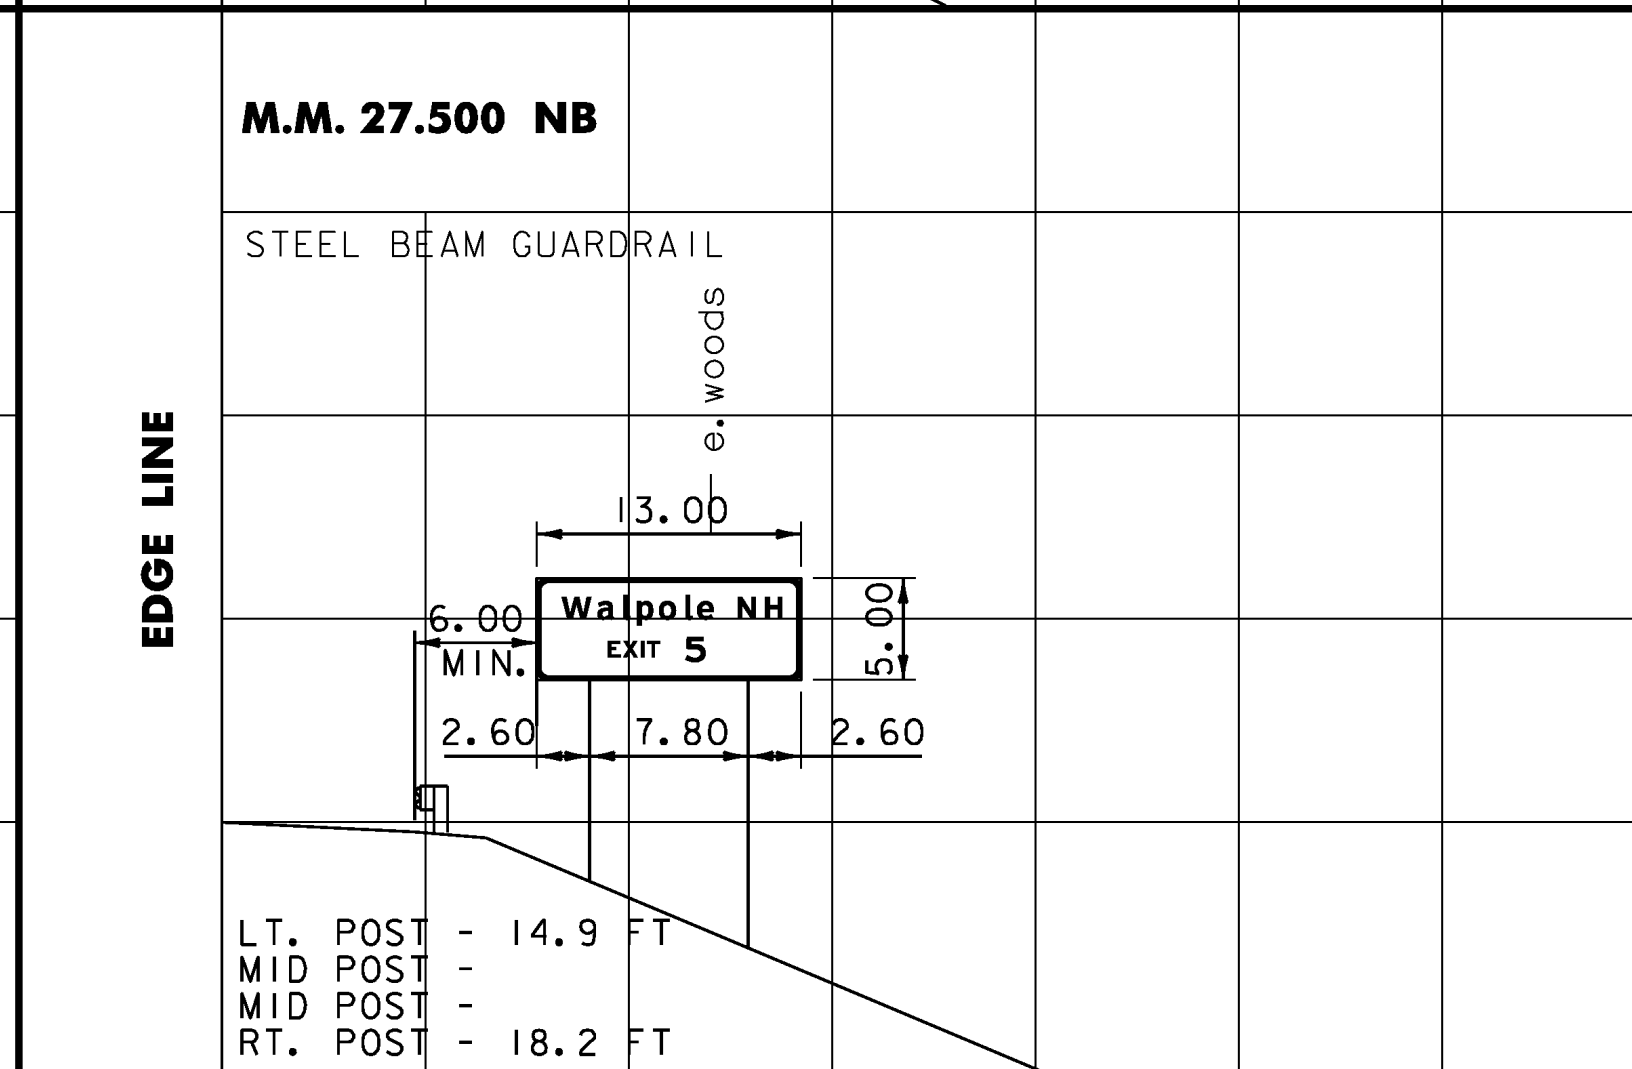
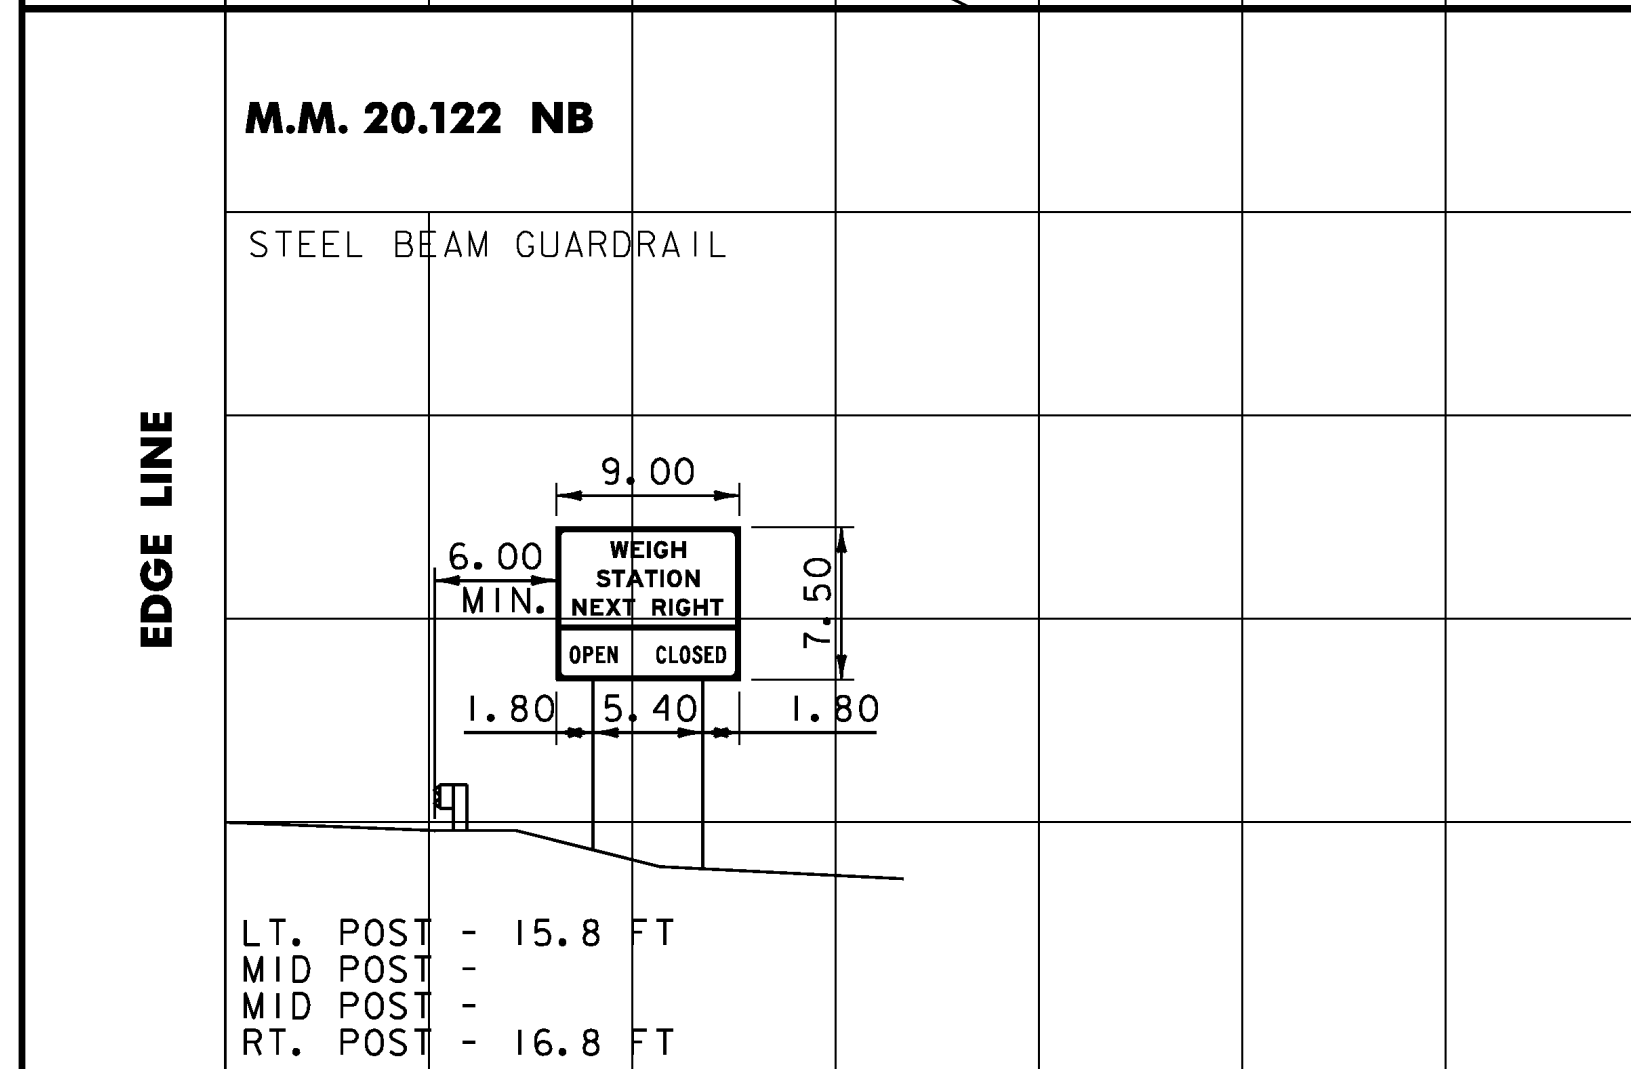
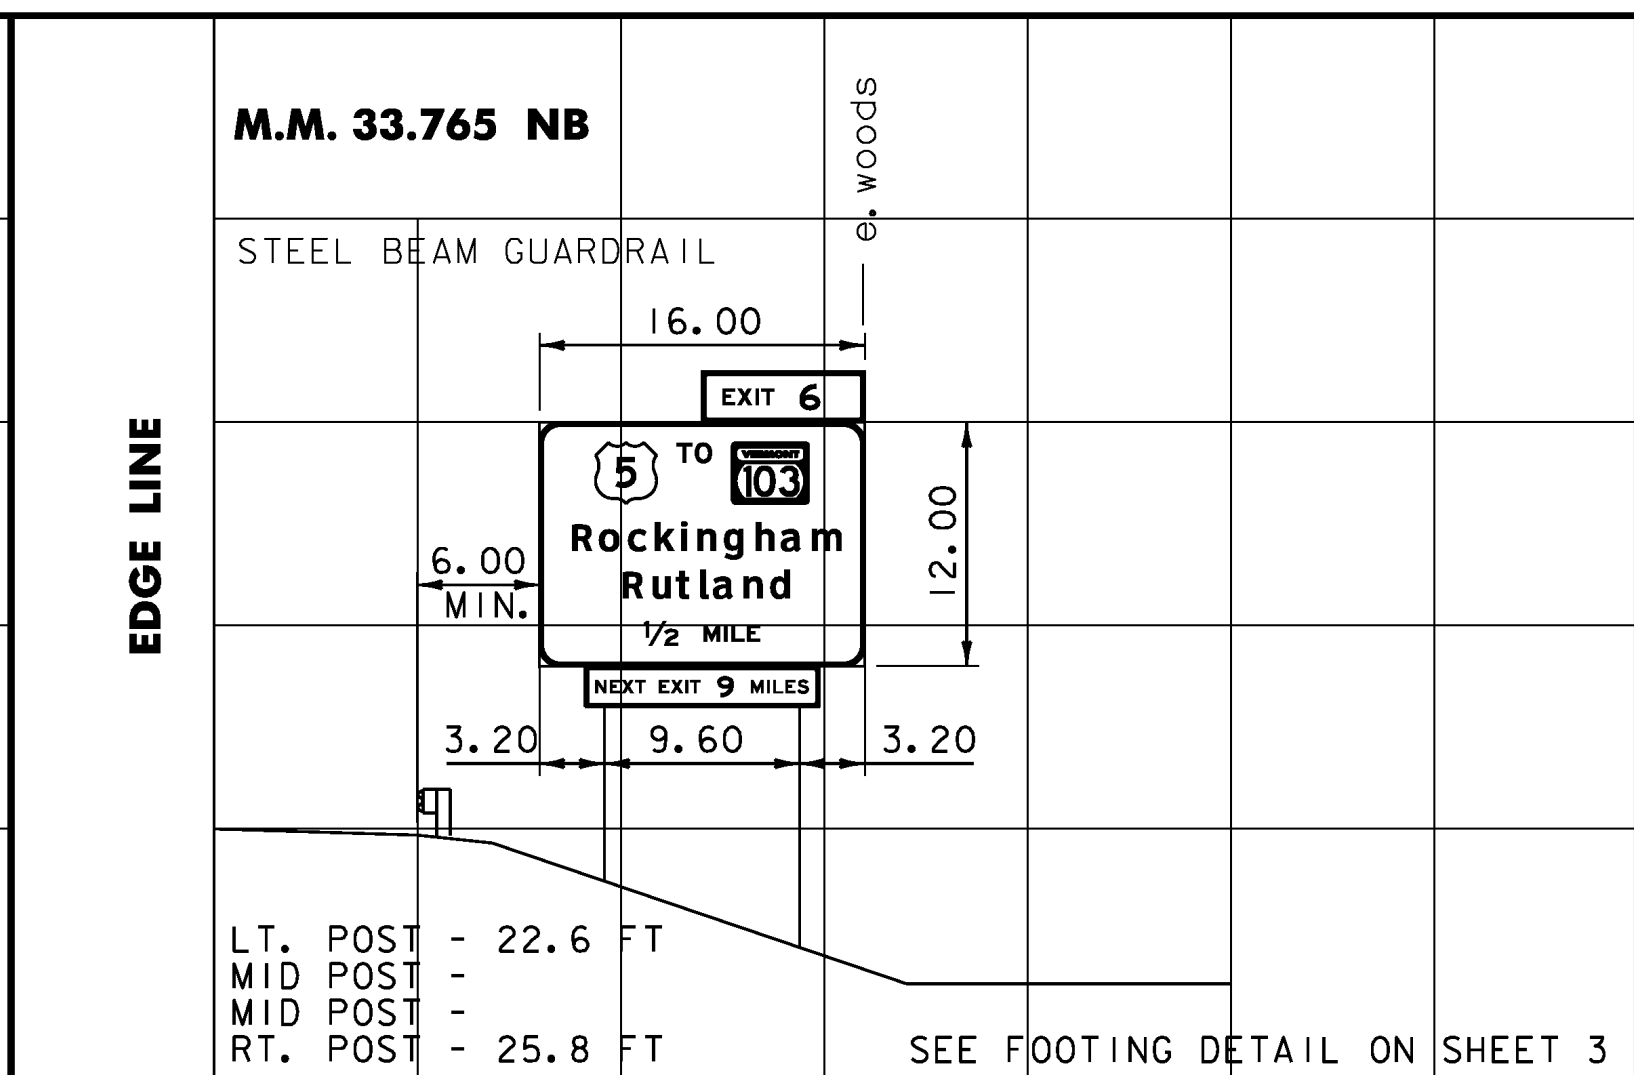
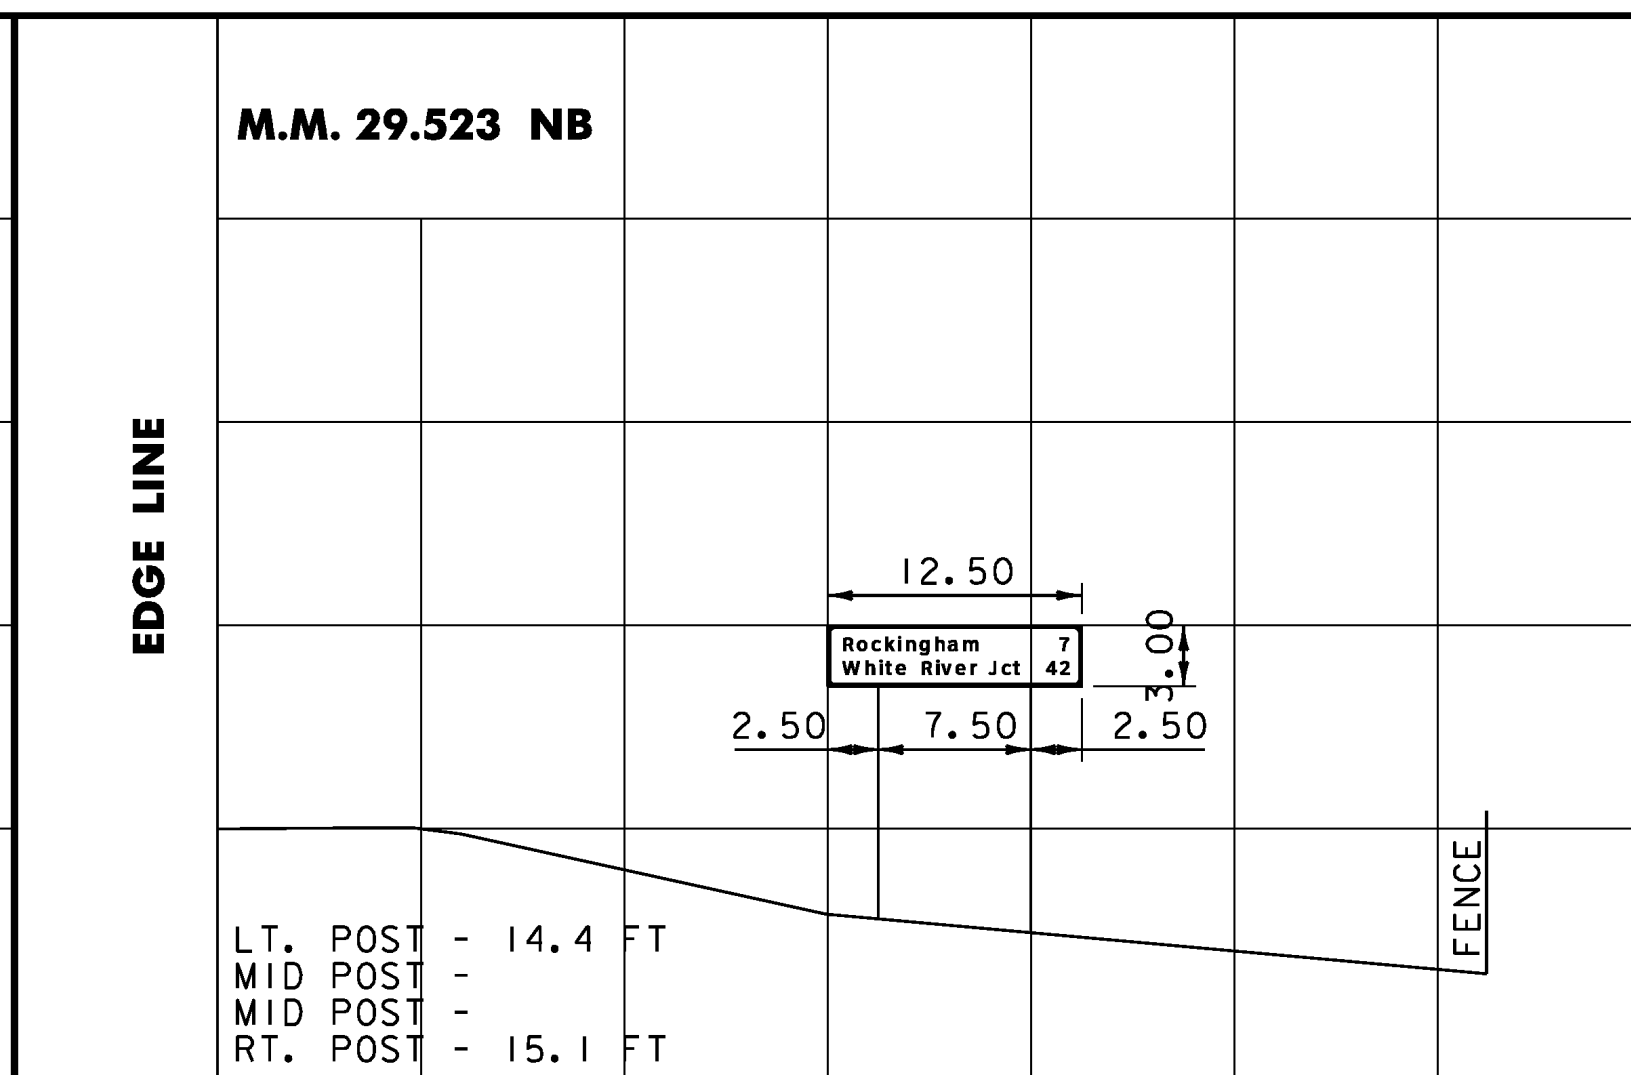
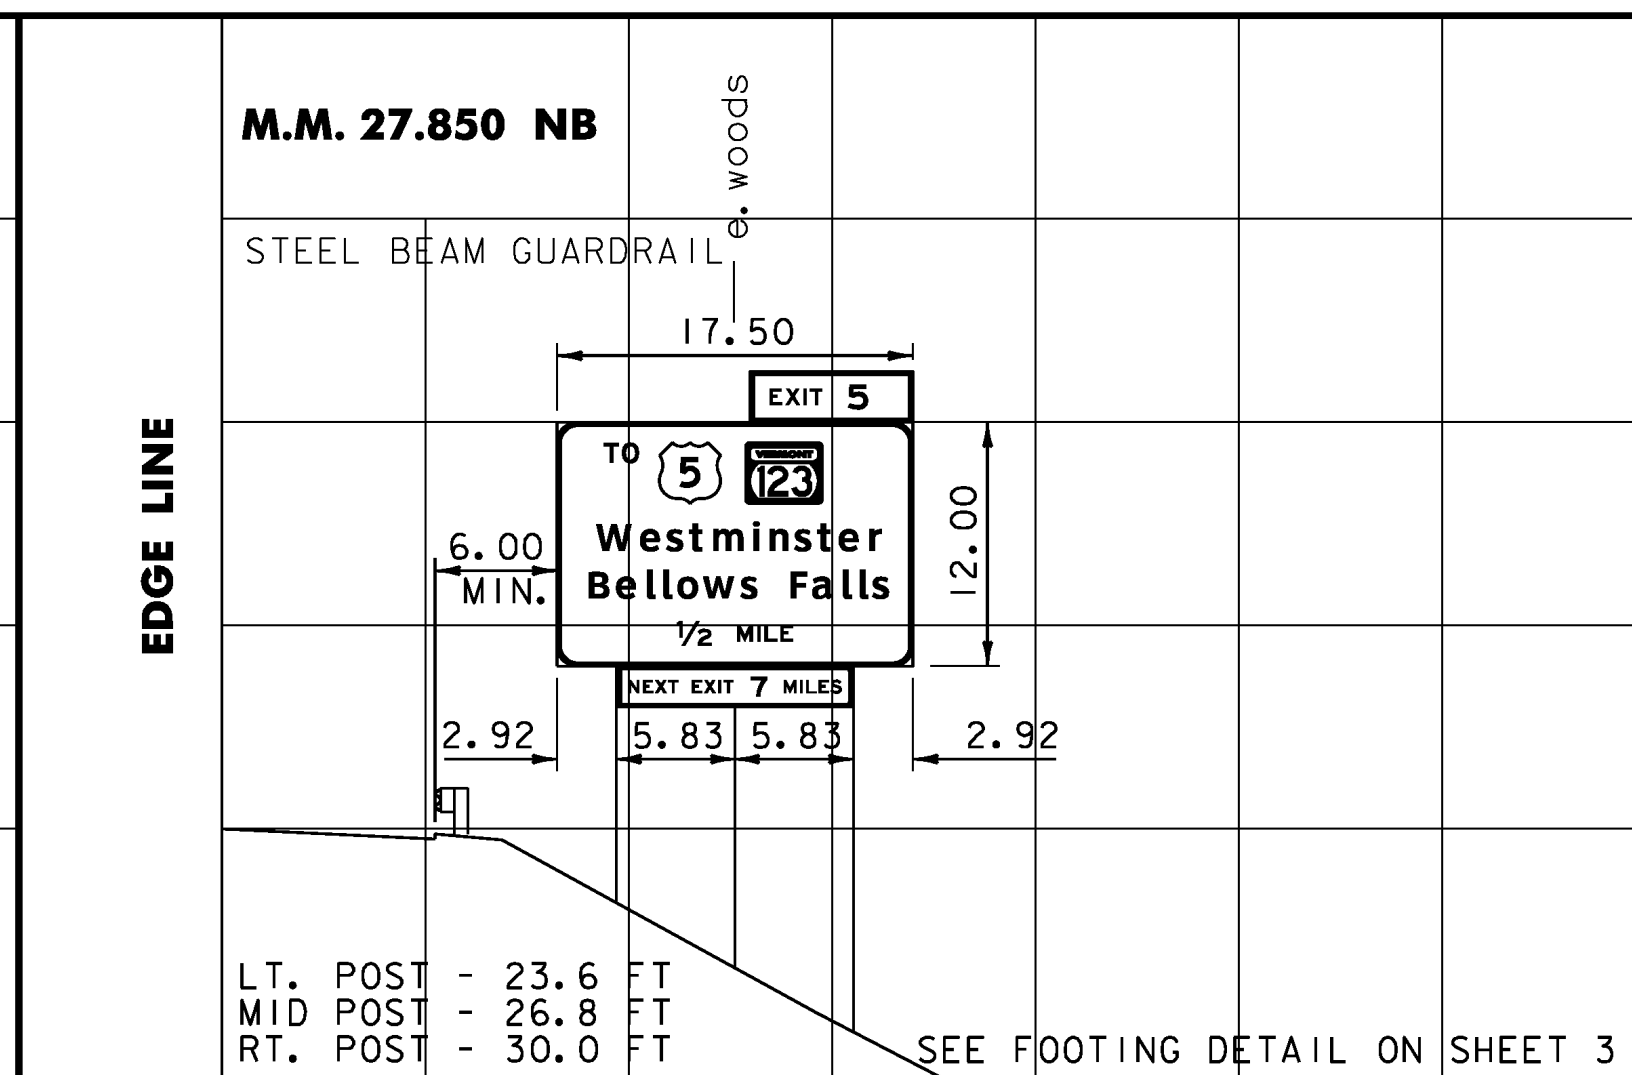


CLD 12-0350 MODEL: 03

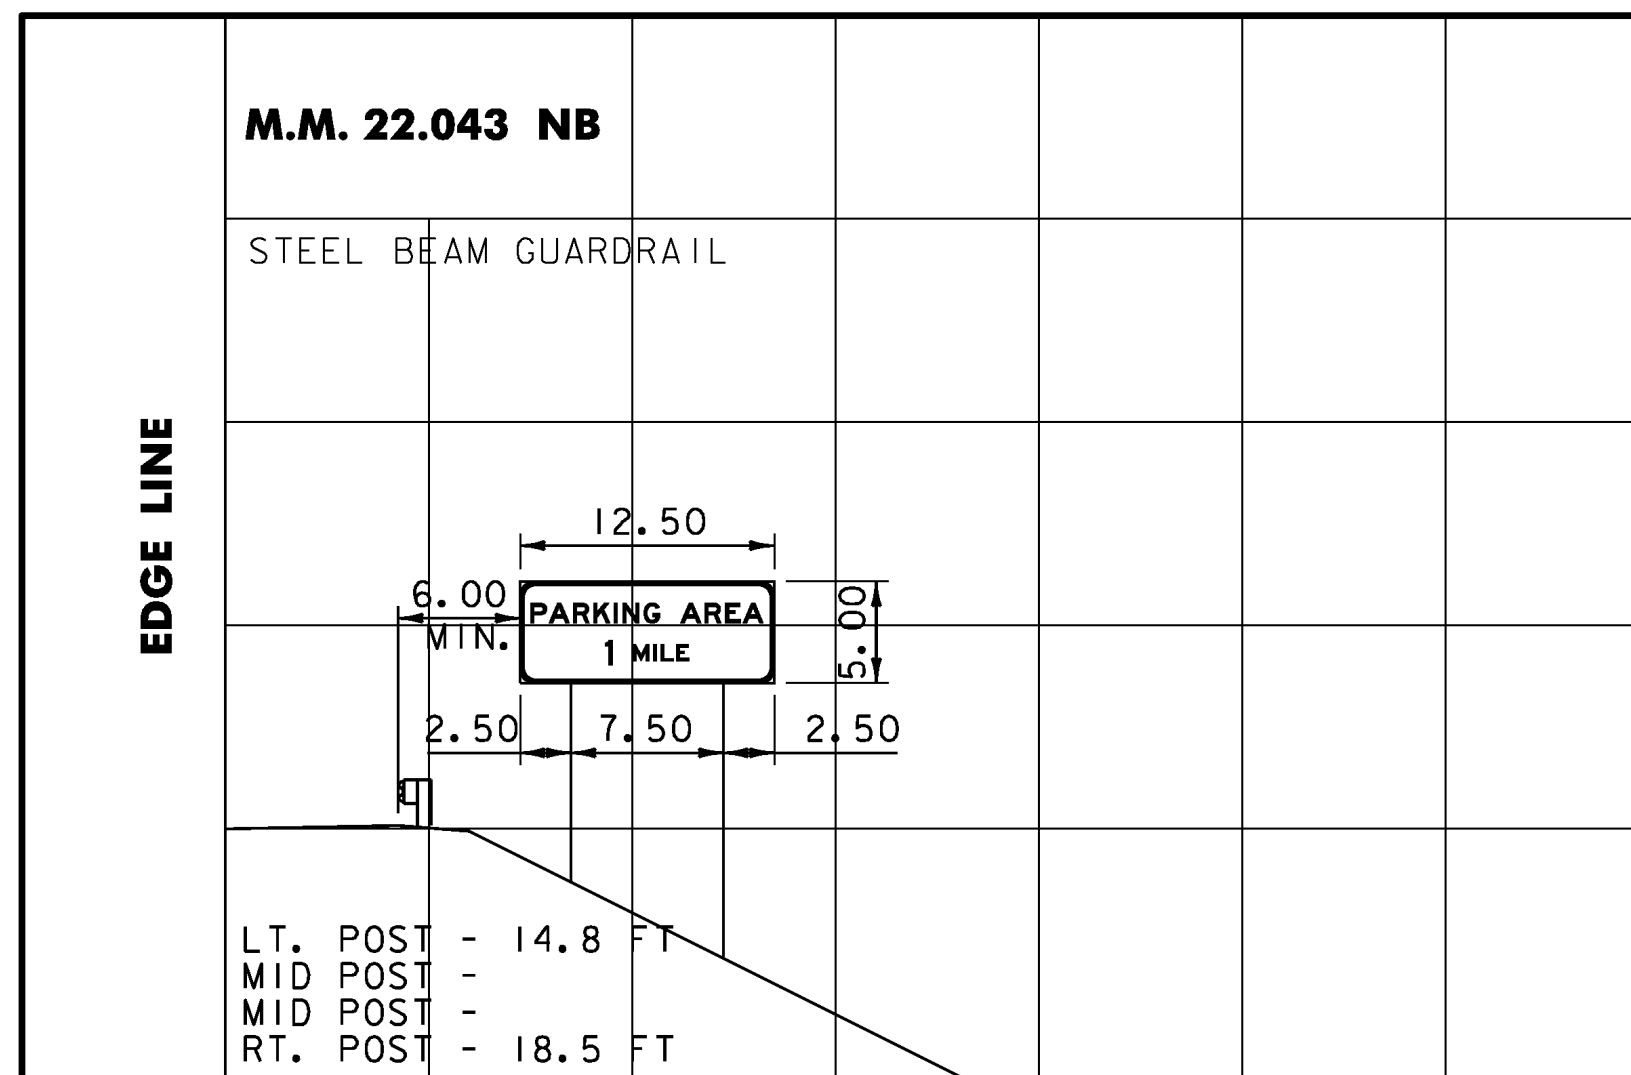

DIMENSIONS FOR CRITICAL OFFSETS OR CLEARANCES SHOWN FOR CONVENIENCE, REFER TO STANDARD SHEET E-120 FOR PLACEMENT GUIDELINES.

SCALE 1" = 10'

540 Commercial Street, Manchester, NH 03101
(603) 668-8223 • Fax: (603) 668-8802
clid@clidengineers.com • www.clidengineers.com
Maine • New Hampshire • Vermont

PROJECT NAME: GUILFORD-ROCKINGHAM
PROJECT NUMBER: IMG SIGN(44)

FILE NAME: z12A528xs.dgn
PROJECT LEADER: C. GREGORY
DESIGNED BY: J. SMITH
CROSS SECTION SHEET 3

PLOT DATE: 4/17/2014
DRAWN BY: S. GOODWIN
CHECKED BY: D. MUNRO
SHEET 153 OF 157