



MM 27.141 NB

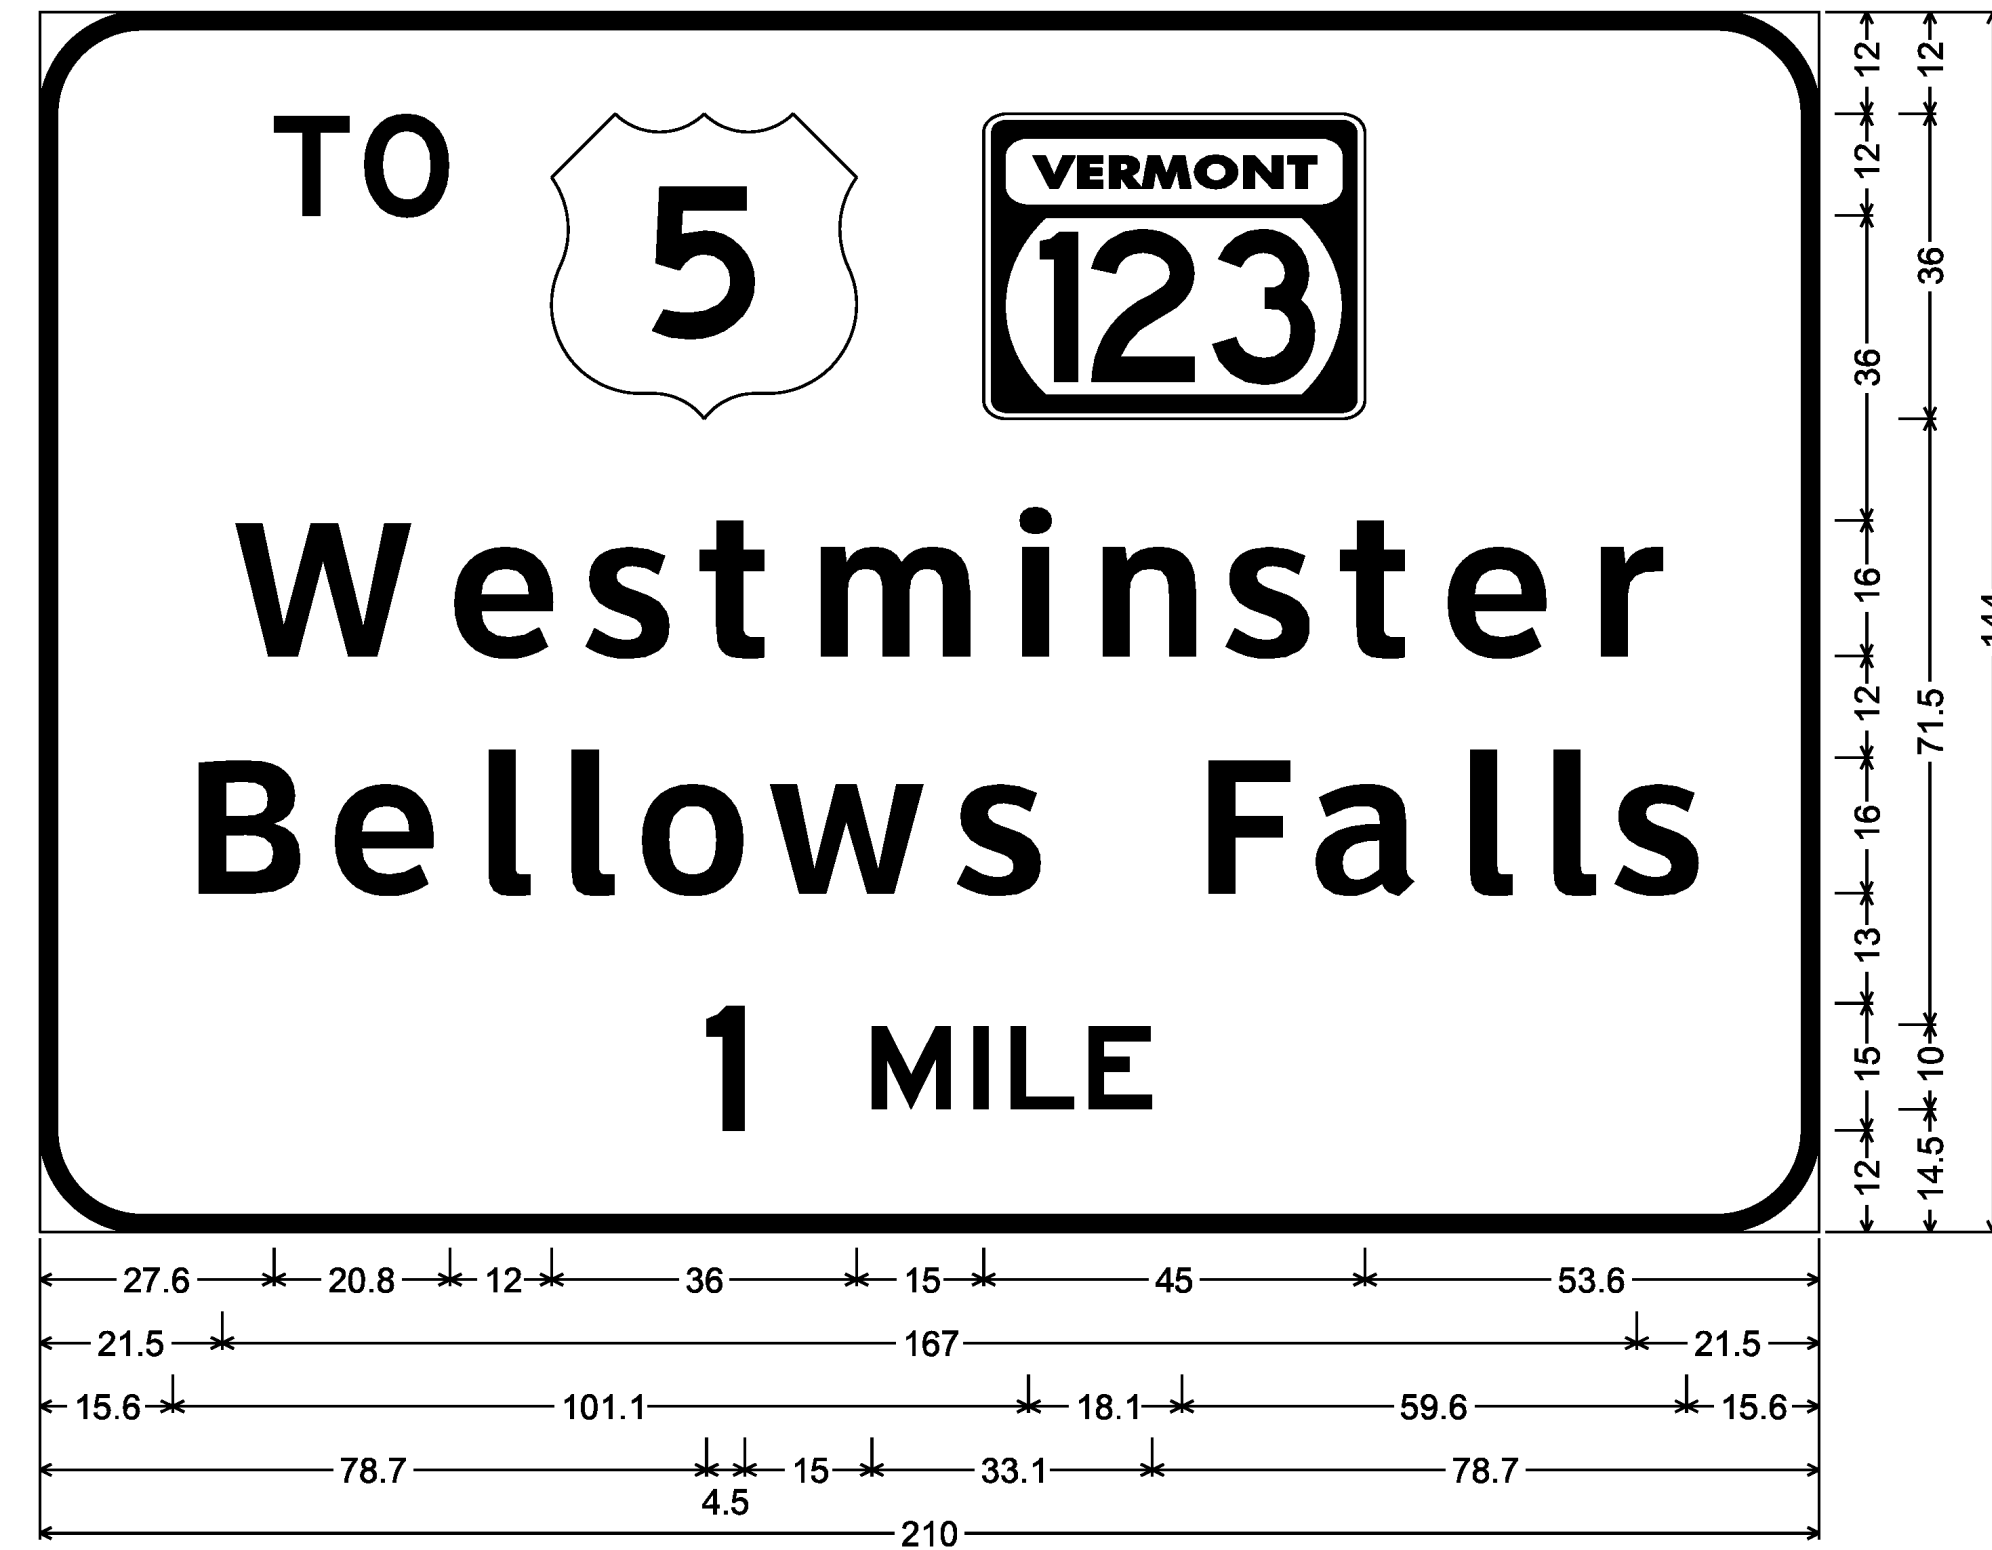


12.0" Radius, 2.0" Border, White on Green;  
 [TO] E 2K; VT123; [Westminster] ClearviewHwy-5-W; [Bellows Falls] ClearviewHwy-5-W;  
 [1 MILE] E 2K;

MM 27.850 NB

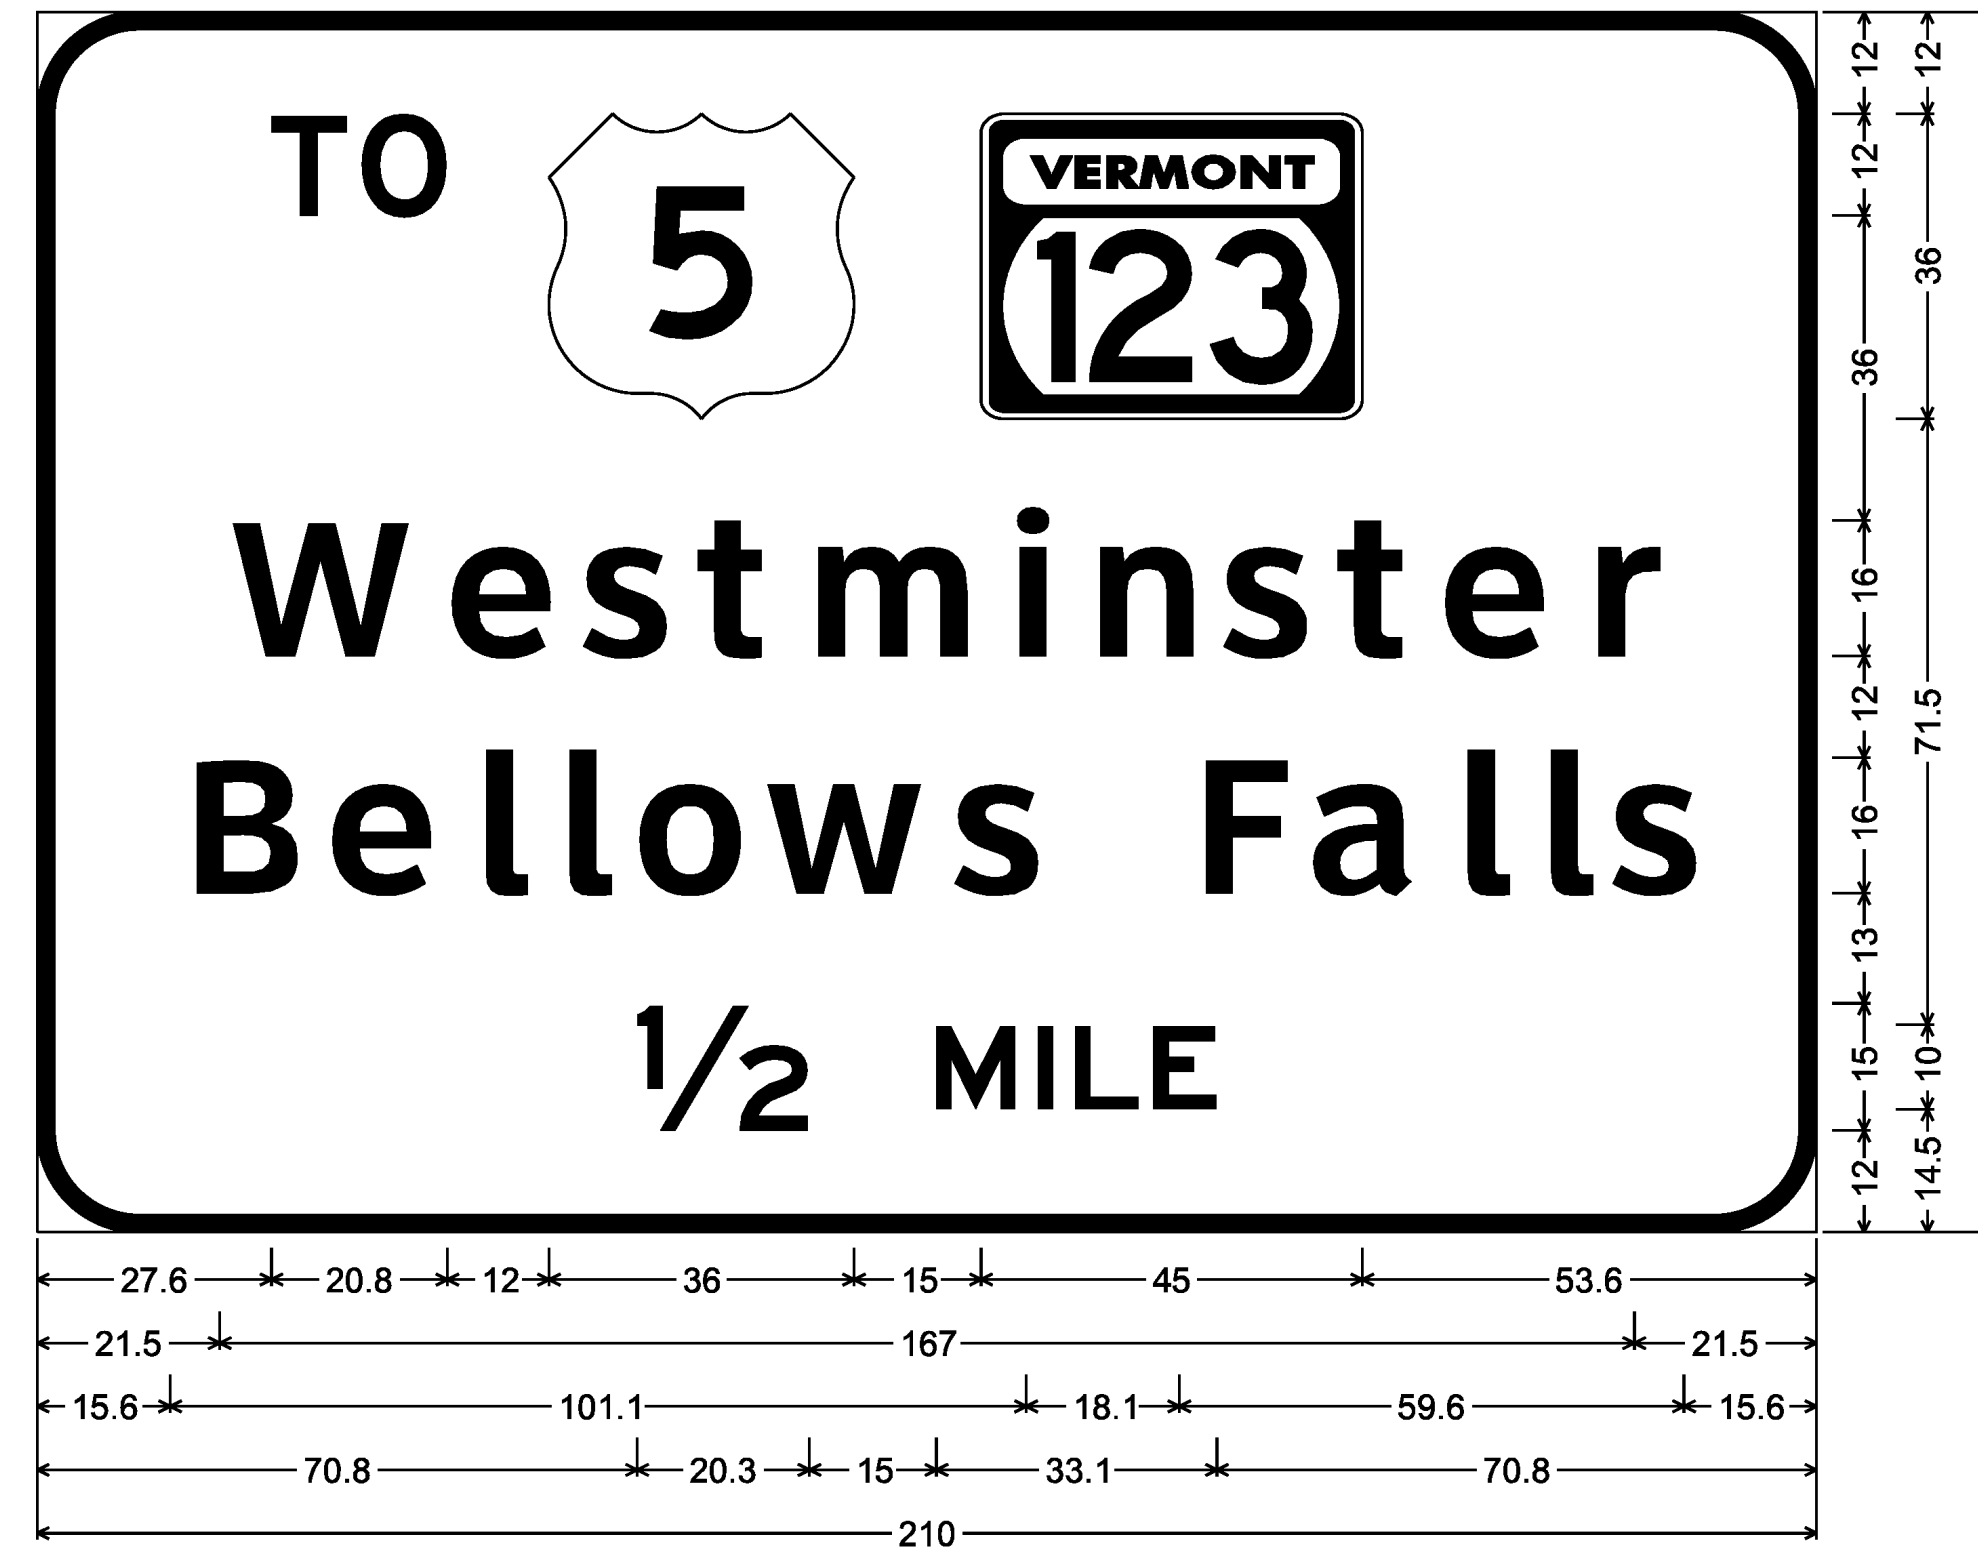


12.0" Radius, 2.0" Border, White on Green;  
 [TO] E 2K; VT123; [Westminster] ClearviewHwy-5-W; [Bellows Falls] ClearviewHwy-5-W; [1/2] E 2K;  
 [MILE] E 2K;

MM 28.005 NB  
MM 29.060 SB

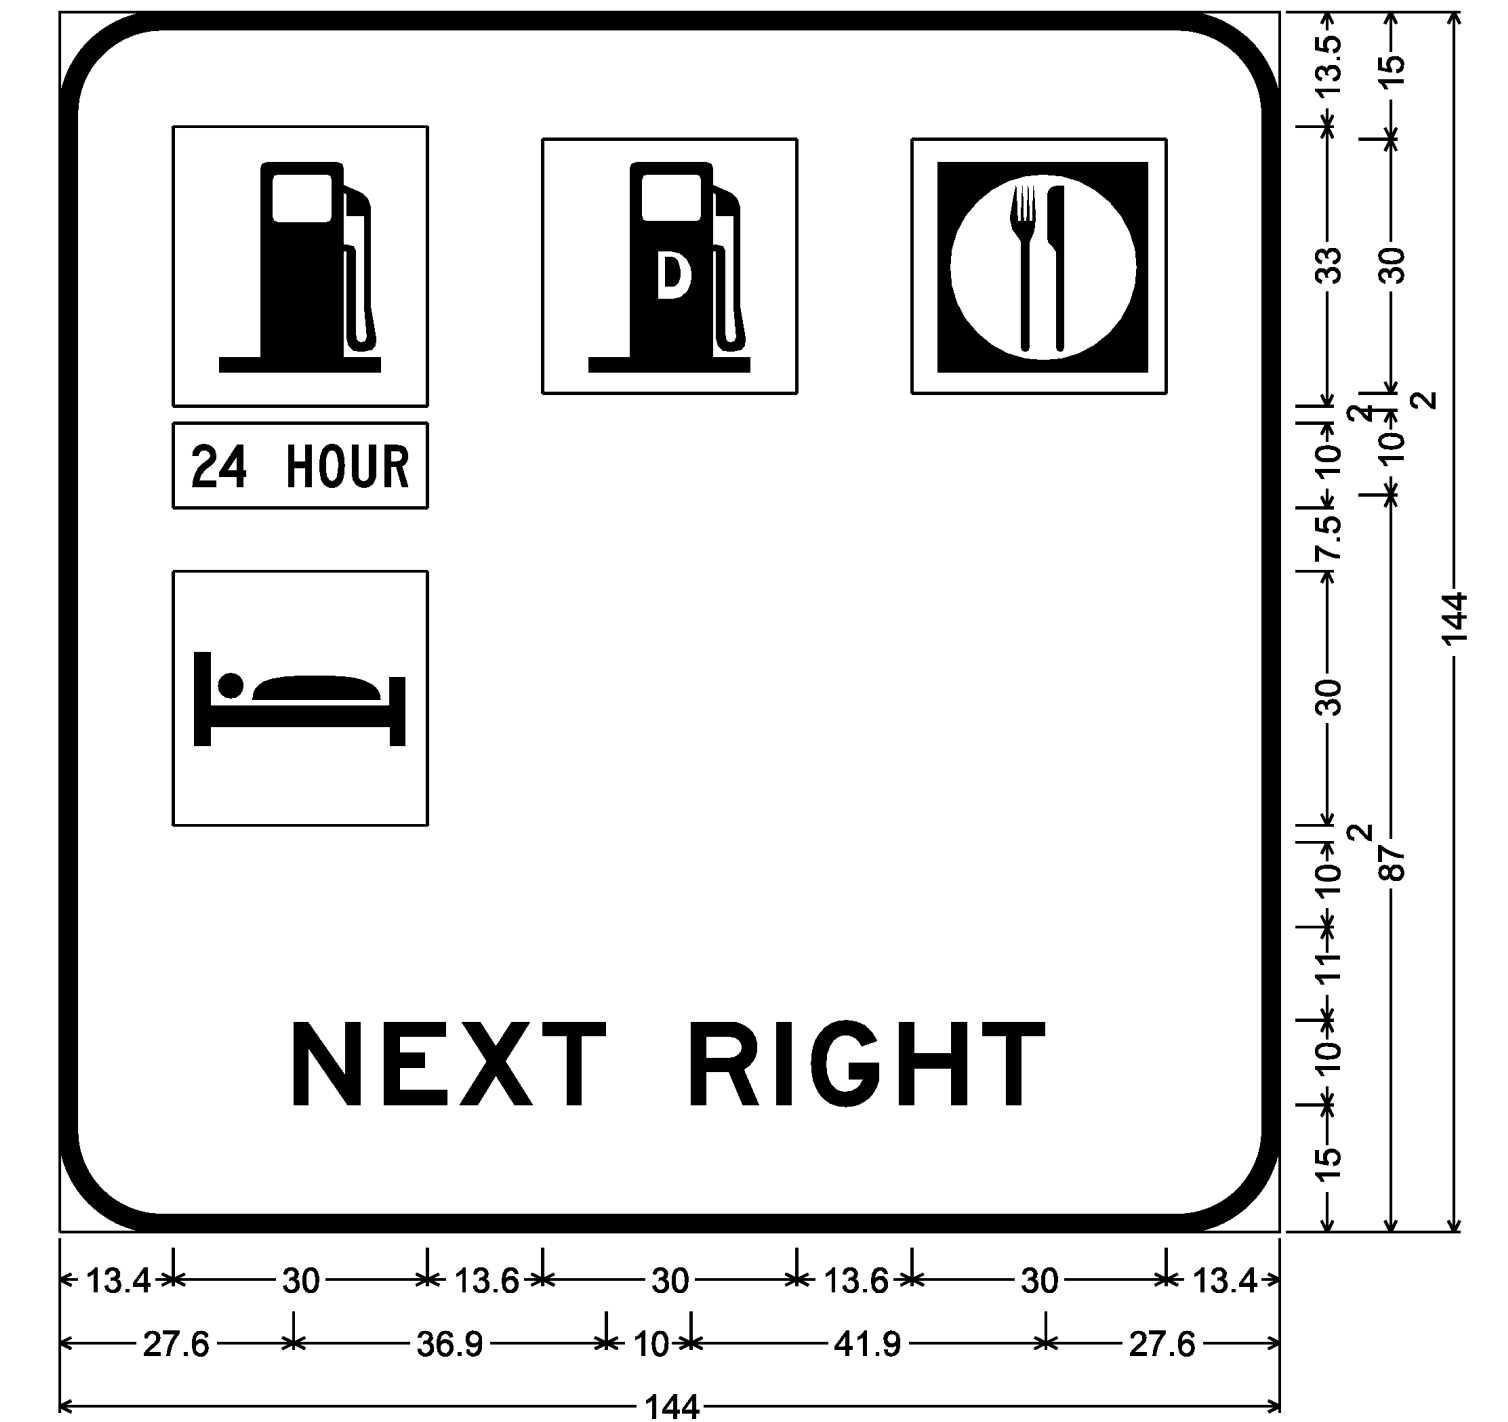


12.0" Radius, 2.0" Border, White on Blue;  
 [NEXT RIGHT] E 2K;

MM 28.395 NB

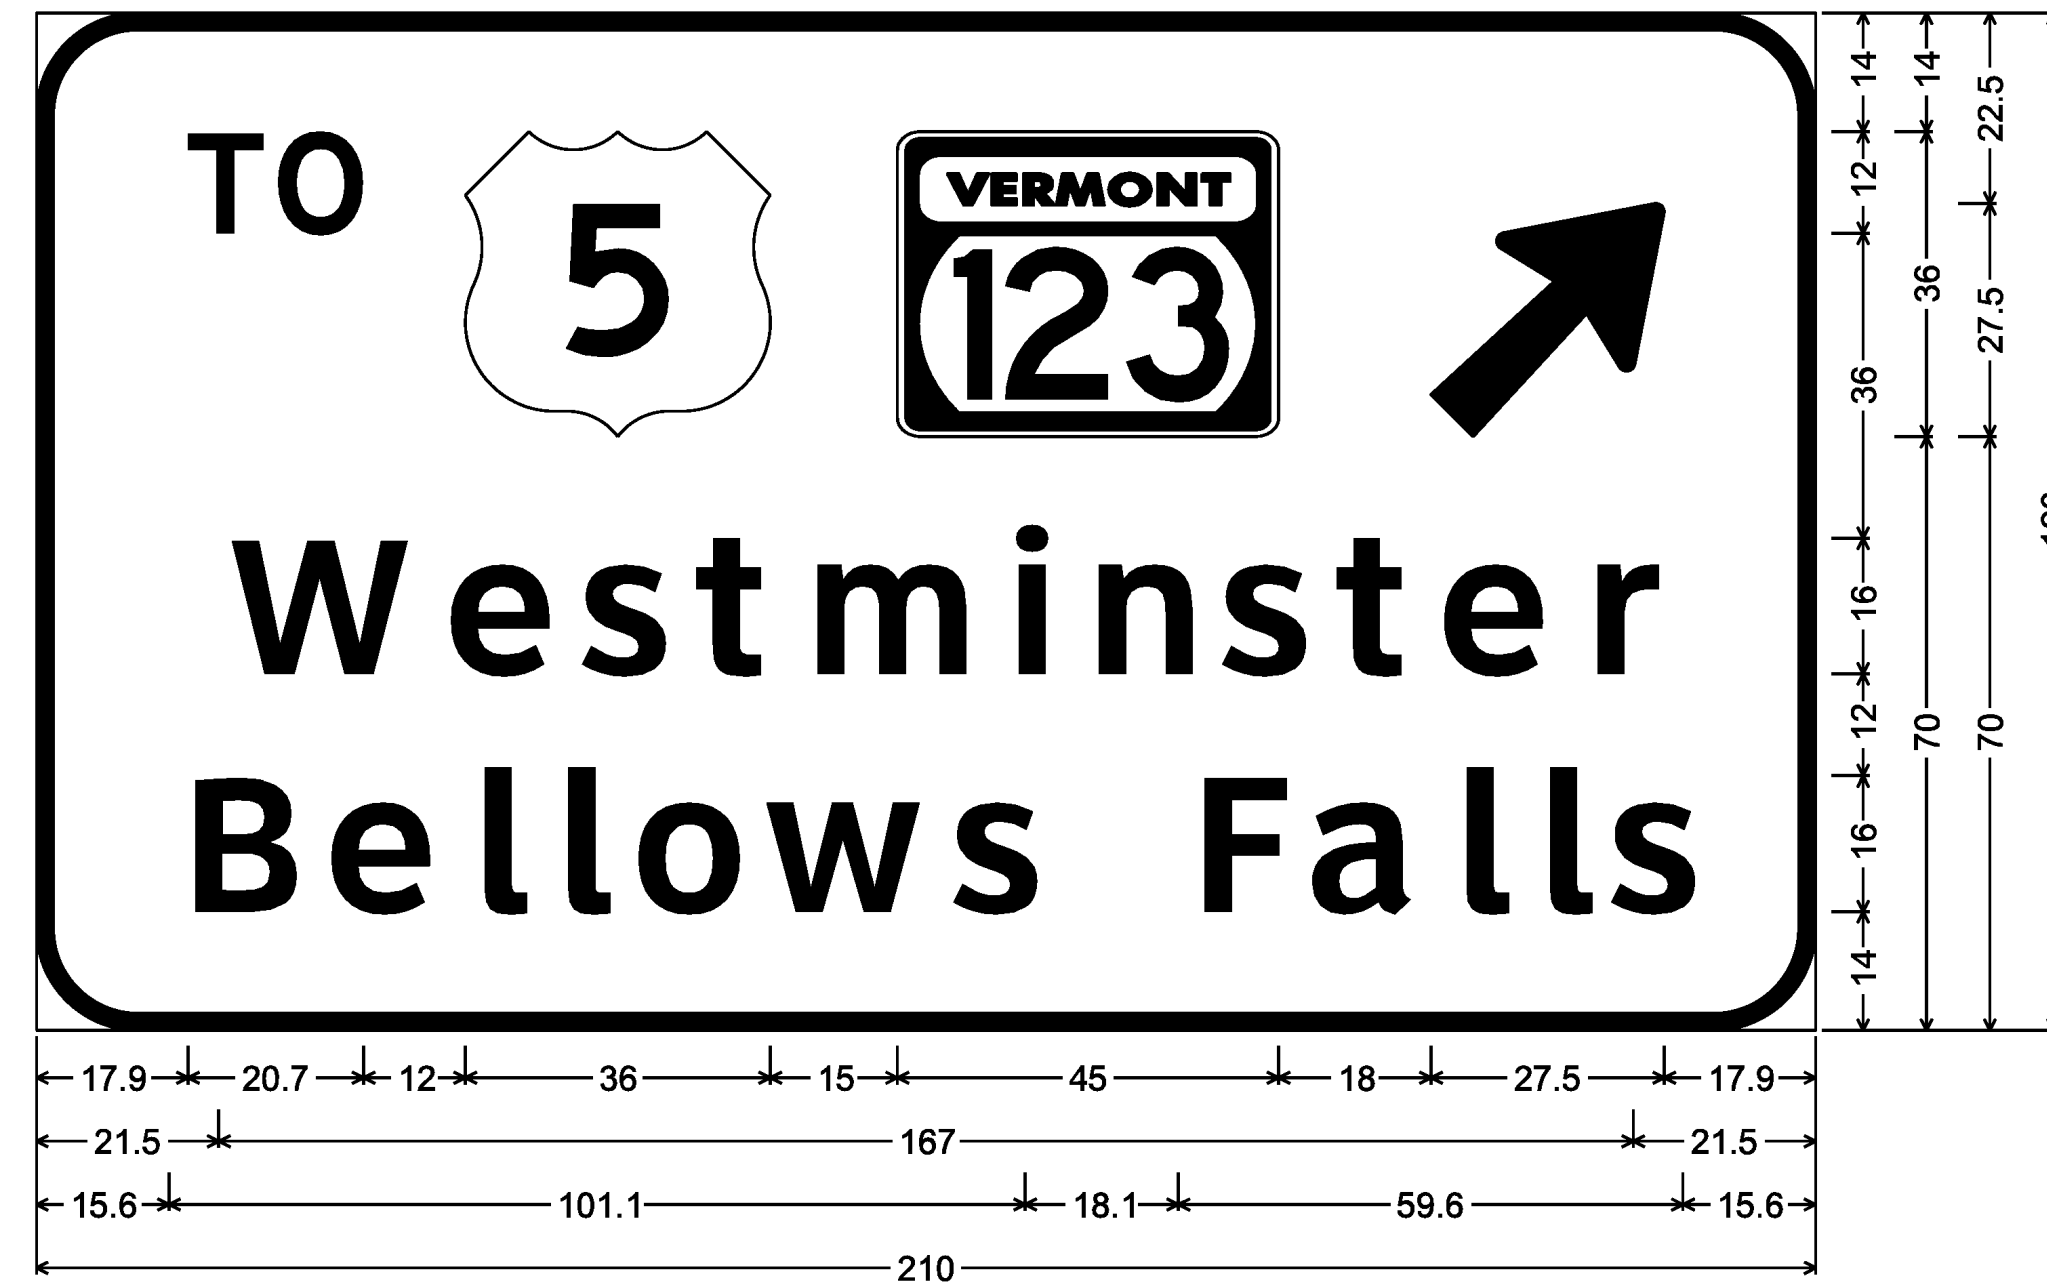

12.0" Radius, 2.0" Border, White on Green;  
 [TO] E 2K; VT123; Arrow 160 - 35.0" 45°; [Westminster] ClearviewHwy-5-W;  
 [Bellows Falls] ClearviewHwy-5-W;


MM 27.500 NB

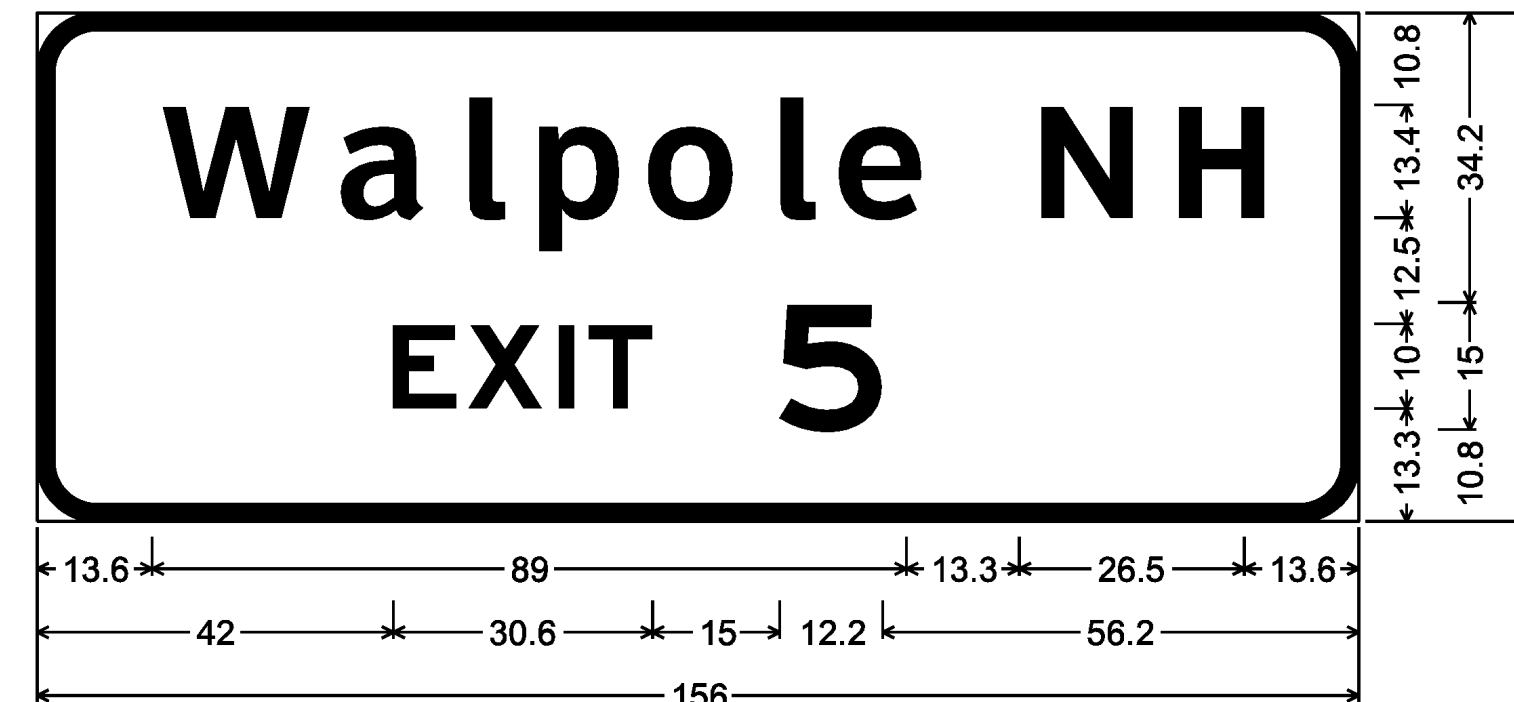

7.0" Radius, 2.0" Border, White on Green;  
 [Walpole] ClearviewHwy-5-W; [NH] ClearviewHwy-5-W; [EXIT] E 2K;  
 [5] E 2K;

LAYOUT OF SIGN LEGEND TO  
 ACCOMMODATE FUTURE EXIT NUMBER 28

MM 29.523 NB

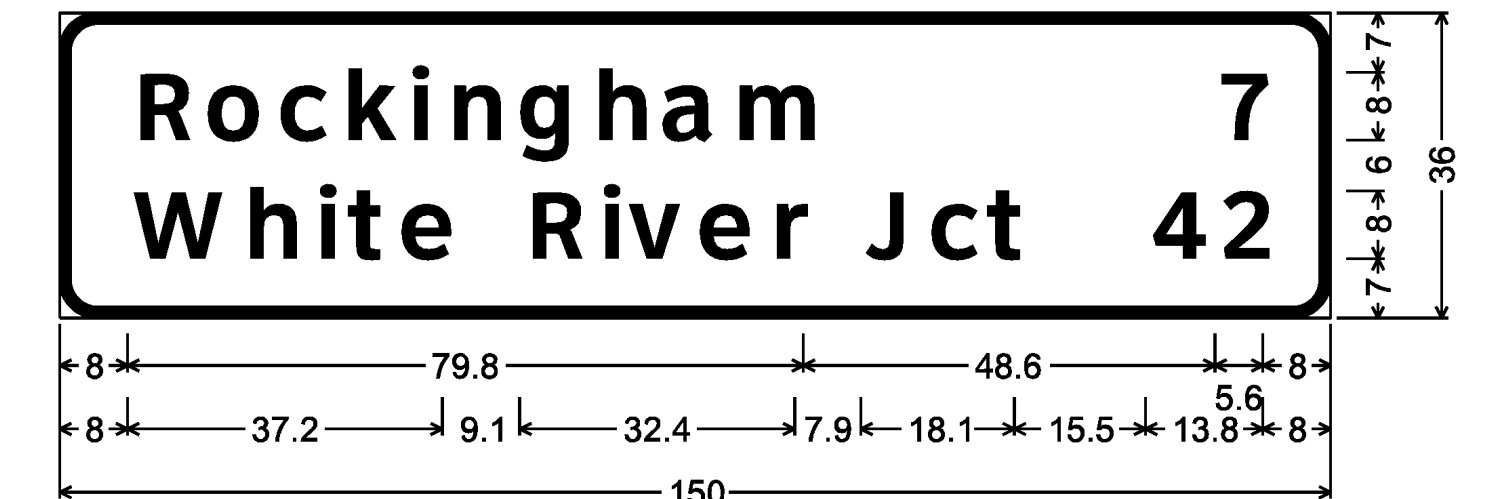

4.5" Radius, 1.3" Border, White on Green;  
 [Rockingham] ClearviewHwy-5-W; [White River Jct] ClearviewHwy-5-W;  
 [7] ClearviewHwy-5-W; [42] ClearviewHwy-5-W;

CLD 12-0350 MODEL: SIGN09

**CLD CONSULTING ENGINEERS**  
 540 Commercial Street, Manchester, NH 03101  
 (603) 668-8223 • Fax: (603) 668-8802  
 cld@cldeengineers.com • www.cldeengineers.com  
 Maine • New Hampshire • Vermont

PROJECT NAME: GUILFORD-ROCKINGHAM  
 PROJECT NUMBER: IMG SIGN(44)

FILE NAME: z12A528frm.dgn  
 PROJECT LEADER: C. GREGORY  
 DESIGNED BY: D. MUNRO  
 SIGN DETAIL SHEET 9

PLOT DATE: 4/17/2014  
 DRAWN BY: S. GOODWIN  
 CHECKED BY: D. MUNRO  
 SHEET 142 OF 157