



MM 32.832 NB

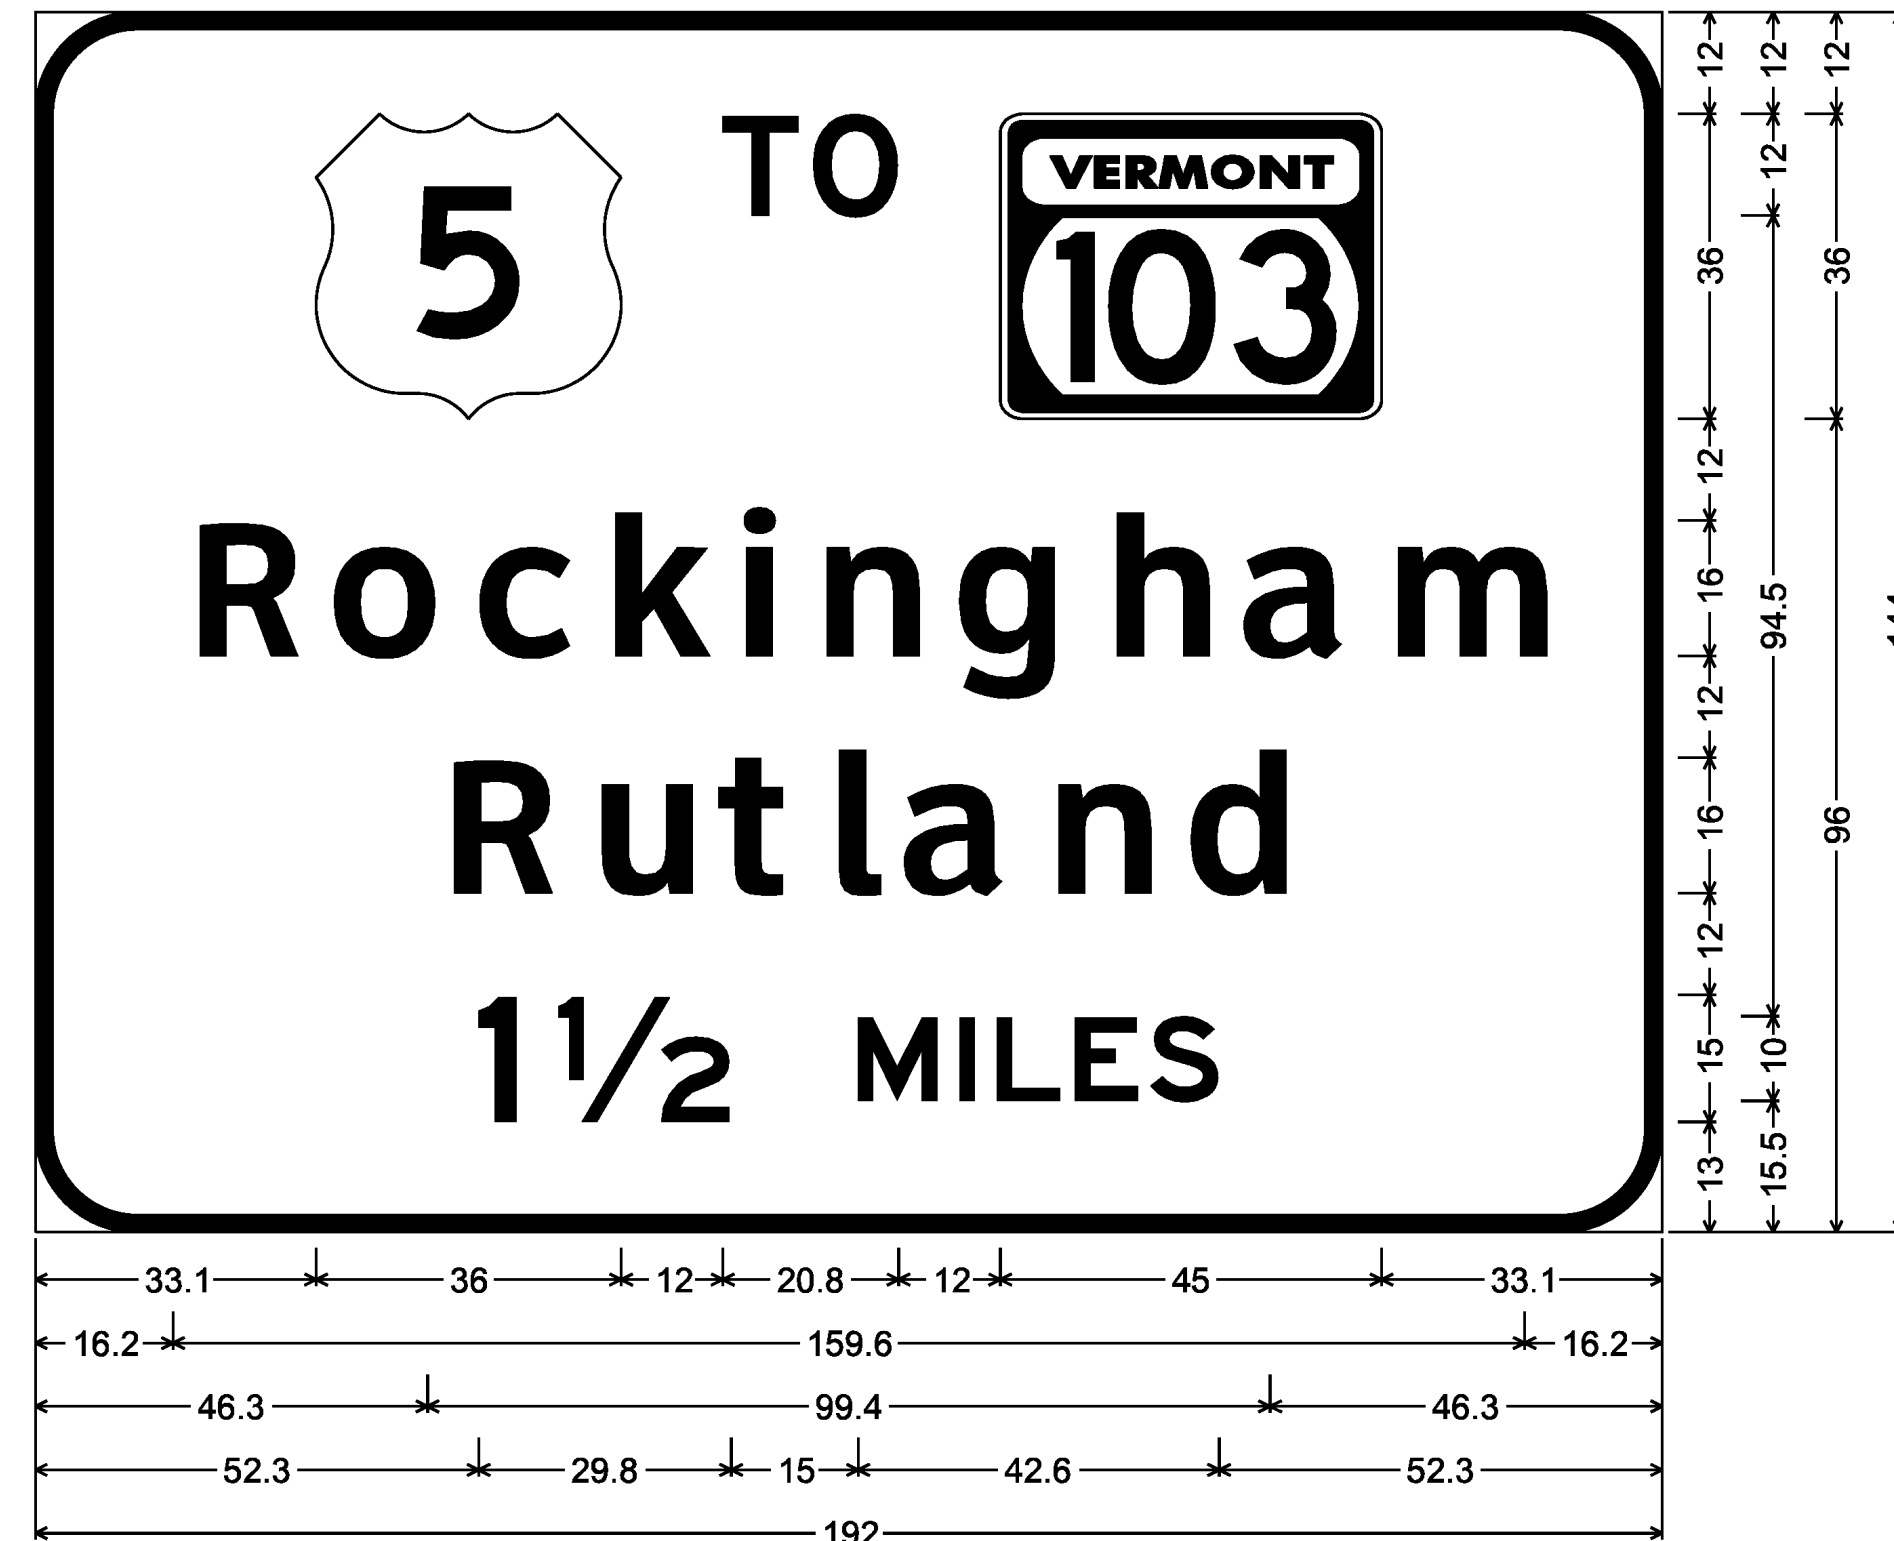


12.0" Radius, 2.0" Border, White on Green;
 [TO] E 2K; VT103; [Rockingham] ClearviewHwy-5-W; [Rutland] ClearviewHwy-5-W;
 [1 1/2] E 2K; [MILES] E 2K;

MM 33.765 NB

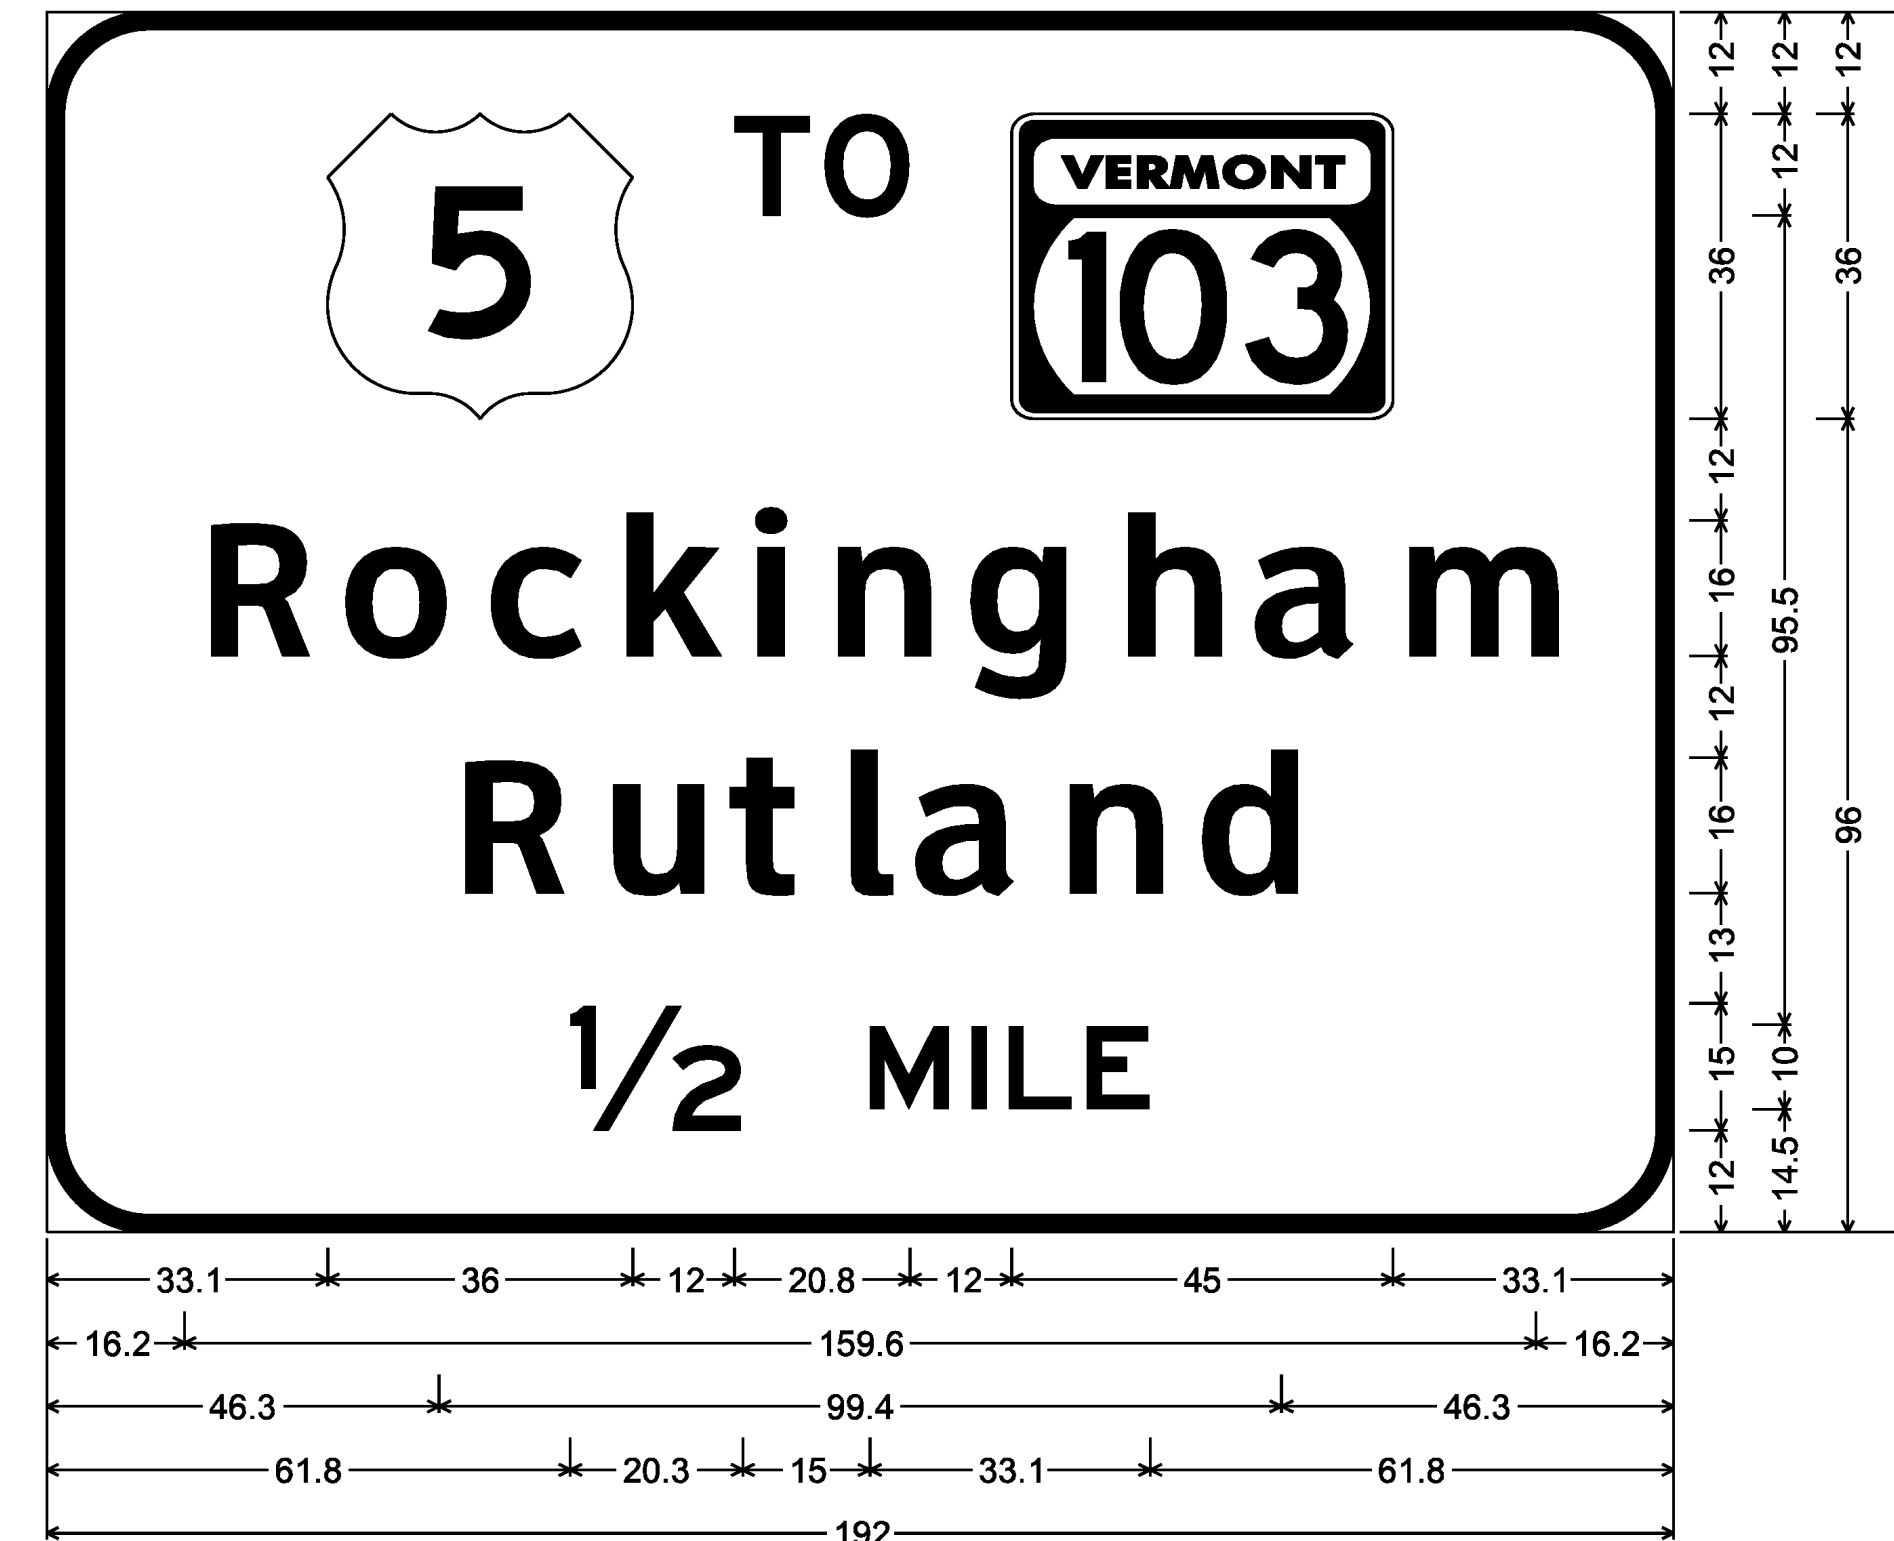


12.0" Radius, 2.0" Border, White on Green;
 [TO] E 2K; VT103; [Rockingham] ClearviewHwy-5-W; [Rutland] ClearviewHwy-5-W; [1/2] E 2K;
 [MILE] E 2K;

MM 33.950 NB
MM 35.650 SB

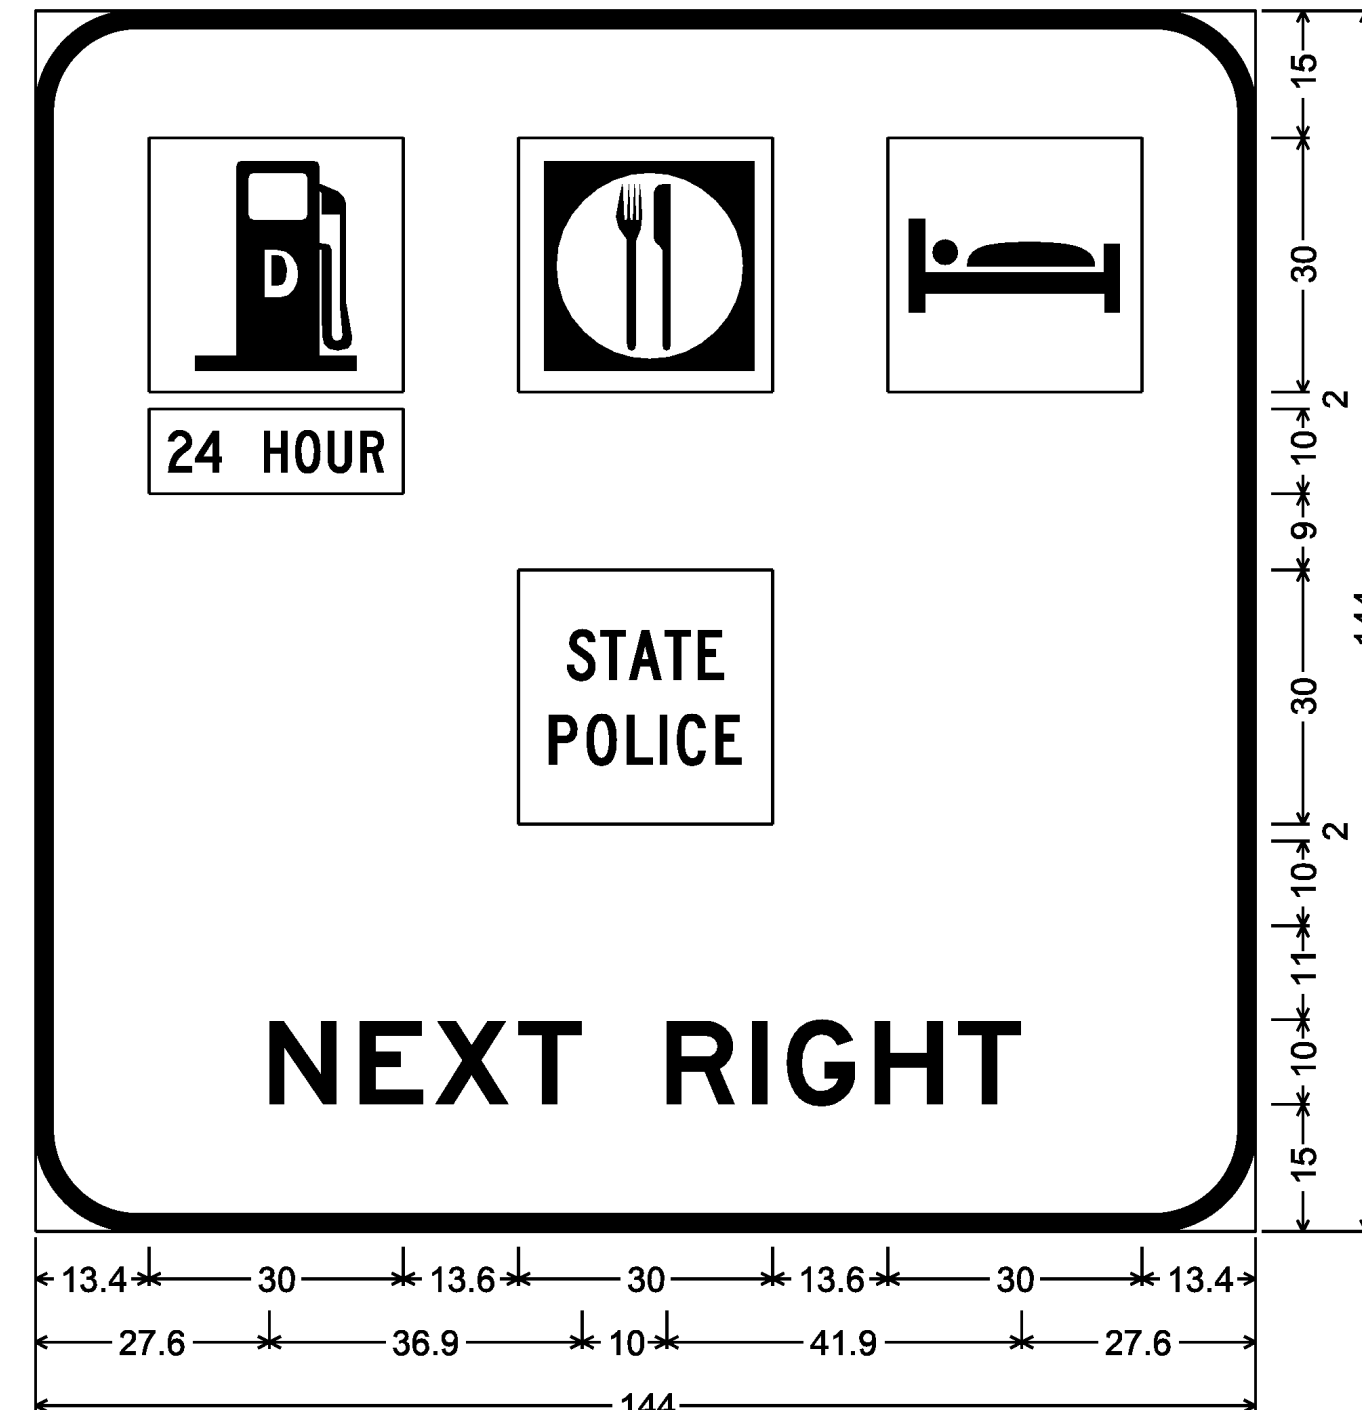

12.0" Radius, 2.0" Border, White on Blue;
 [NEXT RIGHT] E 2K;

MM 34.109 NB

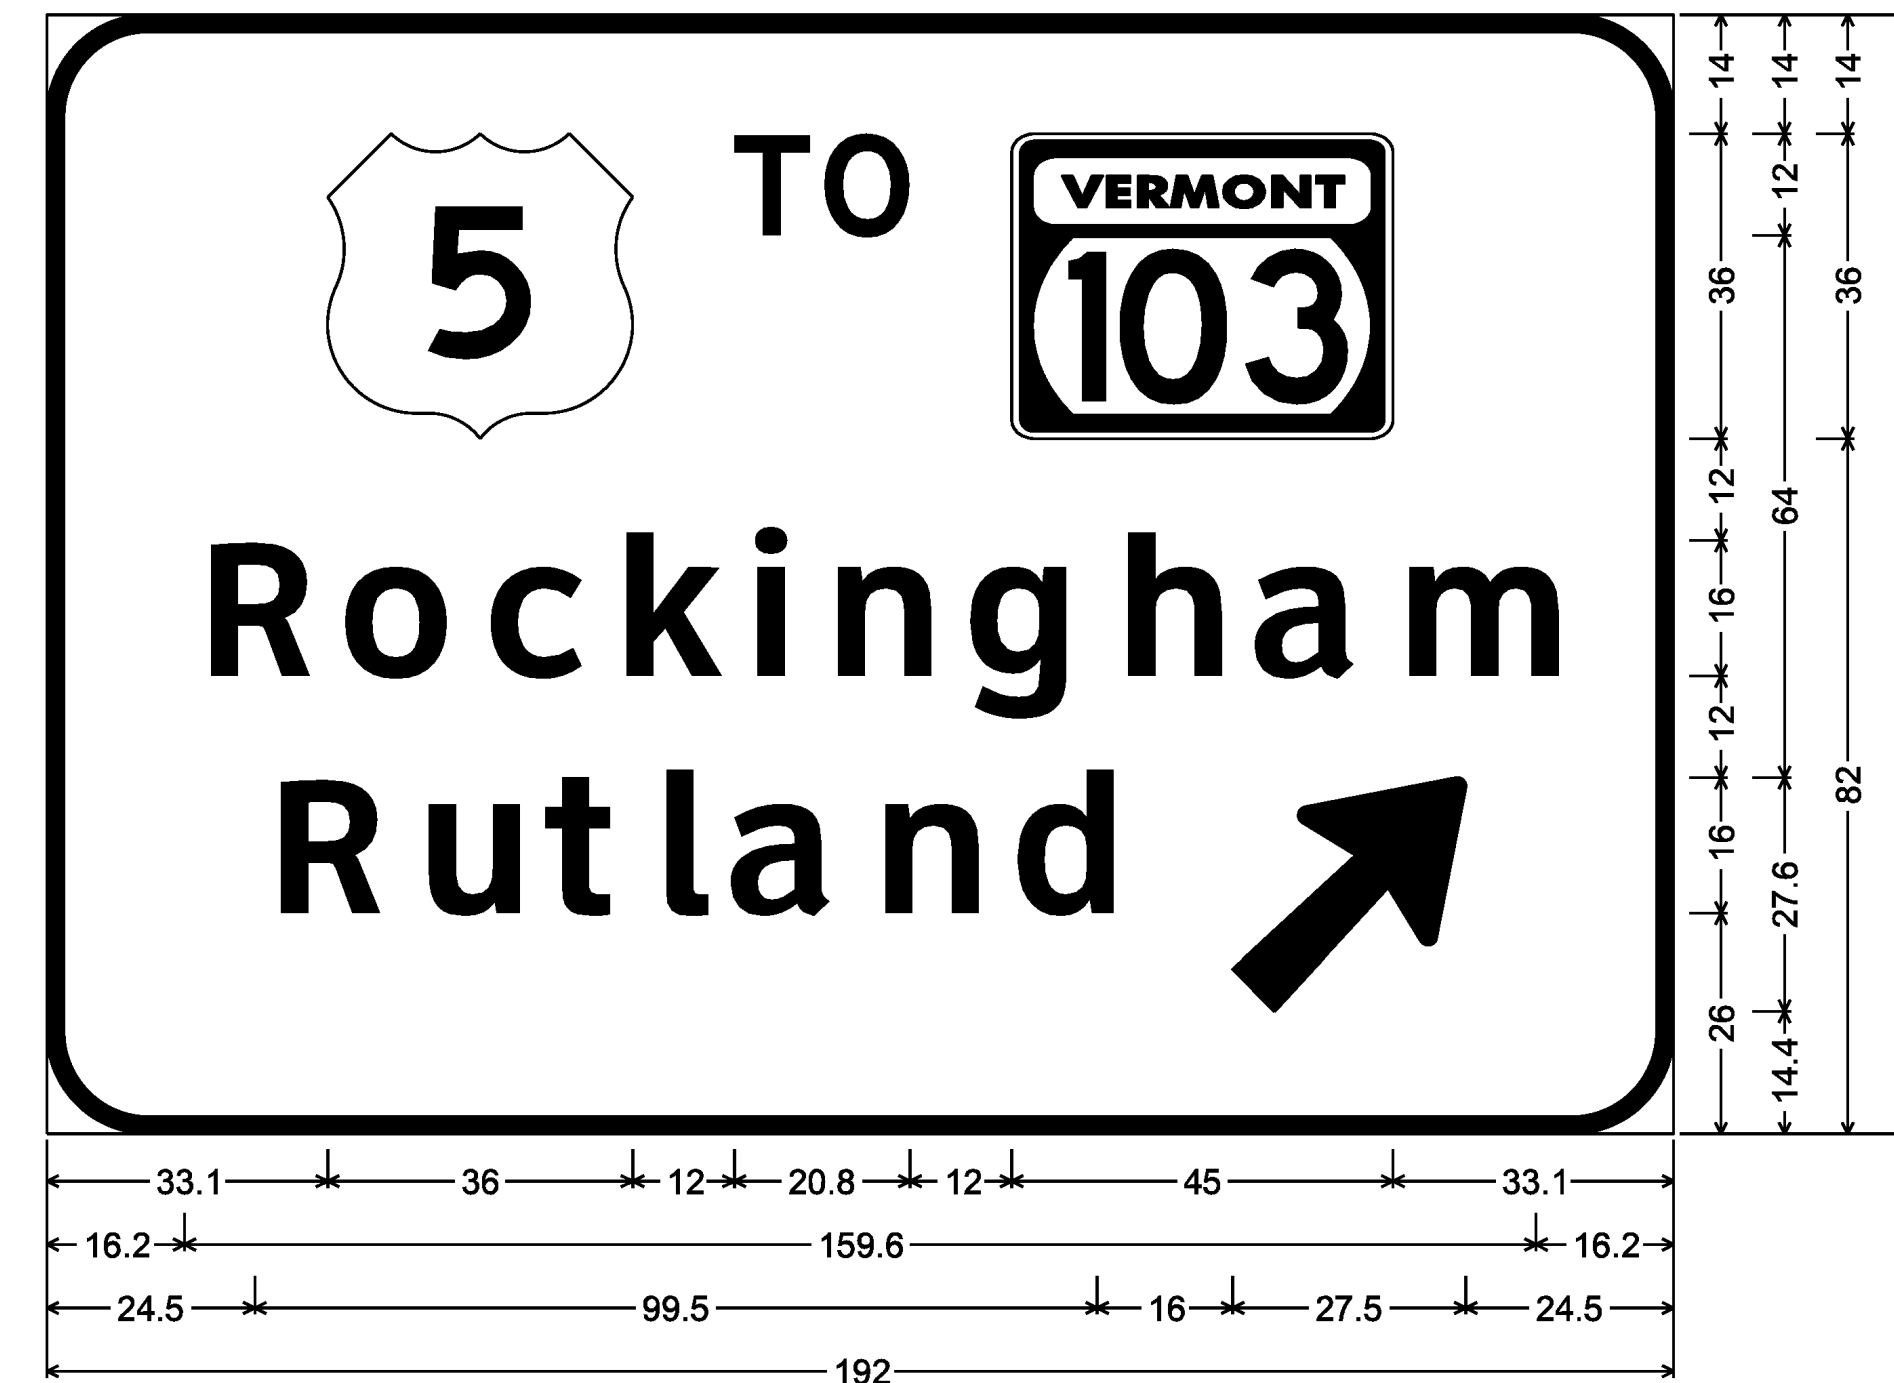

12.0" Radius, 2.0" Border, White on Green;
 [TO] E 2K; VT103; [Rockingham] ClearviewHwy-5-W; [Rutland] ClearviewHwy-5-W;
 Arrow 160 - 35.0" 45°;