


STATE OF VERMONT AGENCY OF TRANSPORTATION

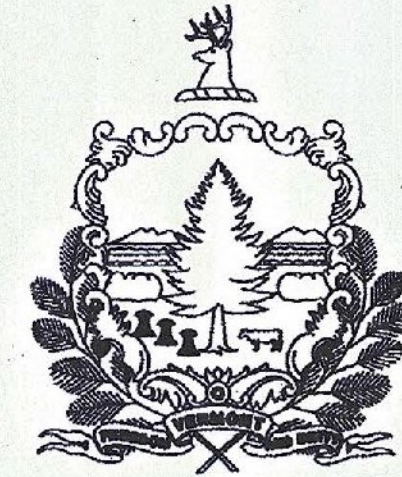


PROPOSED IMPROVEMENT TOWNS OF GUILFORD, VERNON, BRATTLEBORO, DUMMERSTON, PUTNEY, WESTMINSTER, ROCKINGHAM COUNTY OF WINDHAM I-91 (PRINCIPAL ARTERIAL - INTERSTATE)(NHS)


BEGINNING AT THE VERMONT - MASSACHUSETTS STATE LINE ON INTERSTATE 91 AT MILE MARKER 0.000 AND EXTENDING NORTHERLY FOR BOTH NORTHBOUND AND SOUTHBOUND LANES A DISTANCE OF 190,080.00 FEET (36.000 MILES) AND ENDING AT MILEMARKER 36.000 IN THE TOWN OF ROCKINGHAM.

LENGTH OF ROADWAY = 190,080.00 FEET (36.000 MILES)
LENGTH OF PROJECT = 190,080.00 FEET (36.000 MILES)

WORK TO BE PERFORMED UNDER THIS PROJECT INCLUDES THE REMOVAL OF EXISTING SIGNS AND POSTS AND THE INSTALLATION OF NEW SIGNS AND SIGN POSTS AND OTHER HIGHWAY RELATED ITEMS.


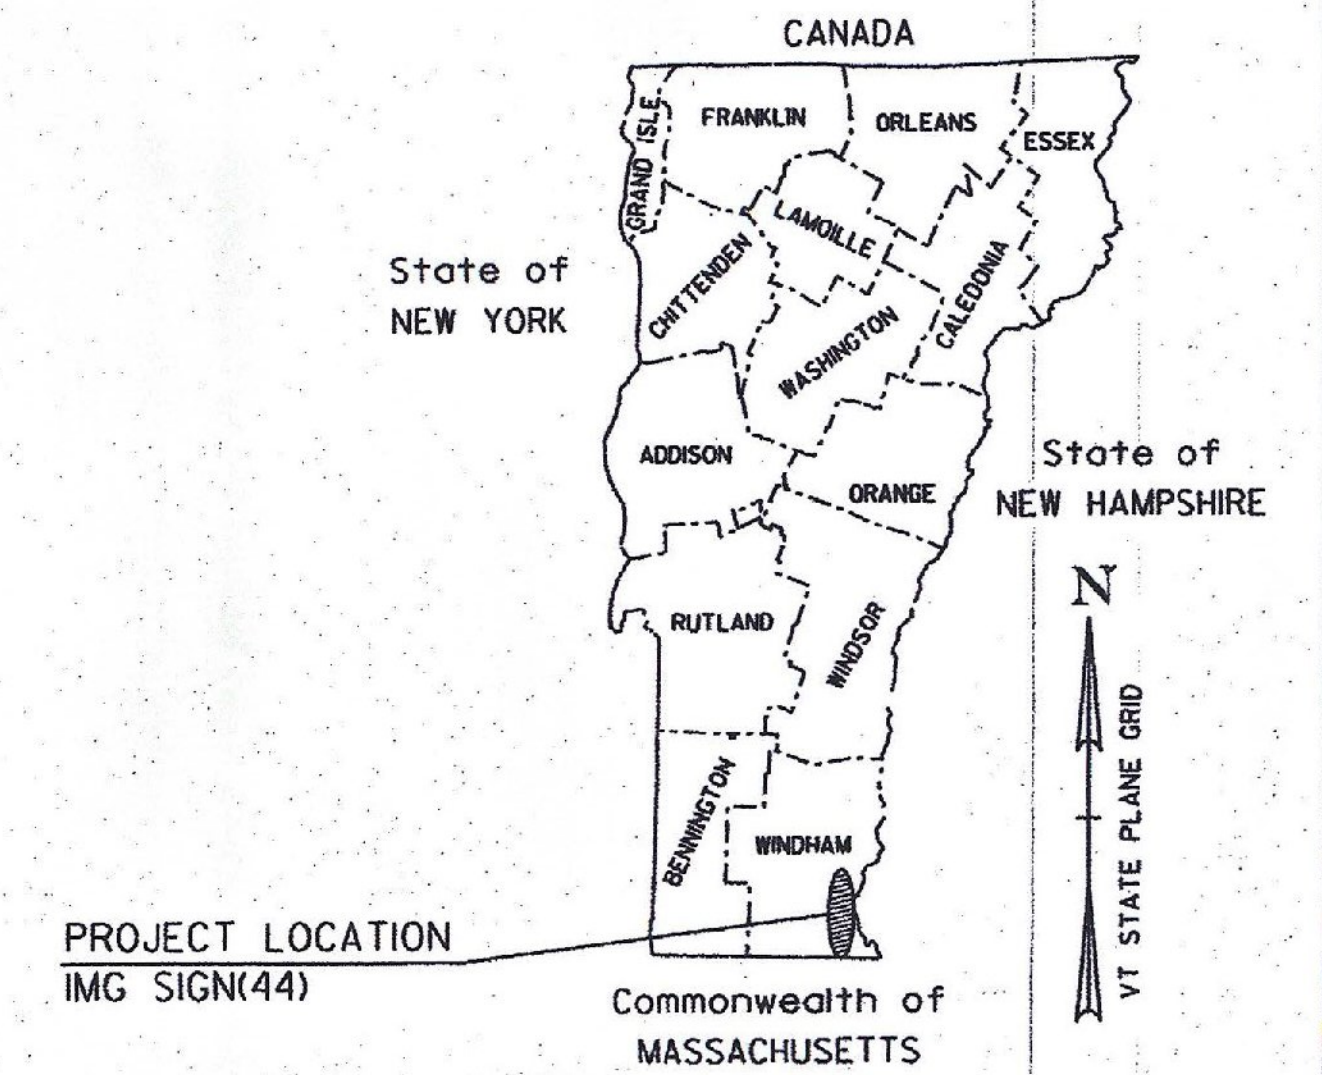


RECORD PLANS	
CONTRACTOR:	F. R. LAFAYETTE, INC. - ESSEX JUNCTION, VT
RESIDENT ENGINEER:	RYAN DARLING
CONSTRUCTION BEGAN:	JULY 29, 2014
CONSTRUCTION COMPLETE:	AUGUST 12, 2014
RECORD PLANS BY:	RYAN DARLING & KEVIN KING
I HEREBY CERTIFY THAT ALL THE CONSTRUCTION REQUIRED BY THIS SET OF DRAWINGS HAS BEEN ACCOMPLISHED AS INDICATED HEREIN.	
BY:	<i>Ryan Darling</i> RESIDENT ENGINEER
DATE:	01/23/2015
NOTE: Any further information concerning final quantities, amounts or other details relative to this project may be found by contacting Vtrans Records Management.	

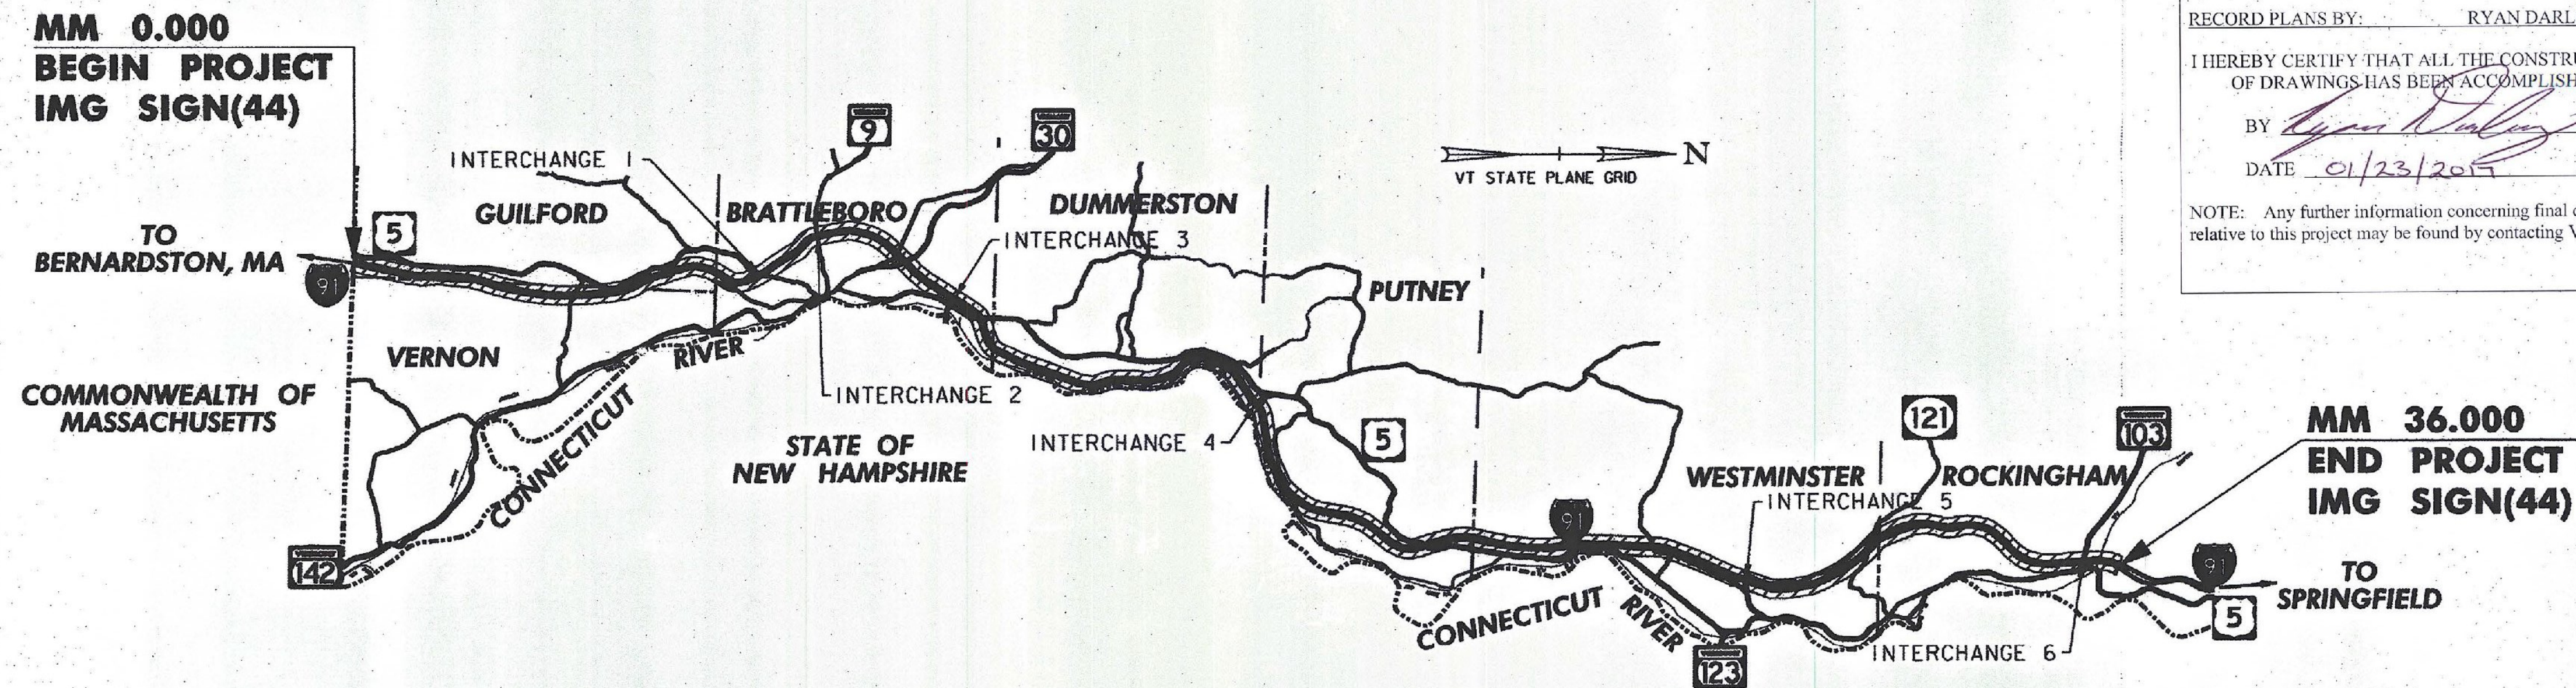

THESE PLANS ARE SUBJECT TO SUCH ENGINEERING CHANGES AS MAY BE REQUIRED BY THE FEDERAL HIGHWAY ADMINISTRATION OR THE DIRECTOR OF PROGRAM DEVELOPMENT.
CONSTRUCTION IS TO BE CARRIED ON IN ACCORDANCE WITH THESE PLANS AND THE STANDARD SPECIFICATIONS FOR CONSTRUCTION DATED 2011, AS APPROVED BY THE FEDERAL HIGHWAY ADMINISTRATION ON JULY 20, 2011 FOR USE ON THIS PROJECT, INCLUDING ALL SUBSEQUENT REVISIONS AND SUCH REVISED SPECIFICATIONS AND SPECIAL PROVISIONS AS ARE INCORPORATED IN THESE PLANS.

QUALITY ASSURANCE PROGRAM : LEVEL I
SURVEYED BY : N/A
SURVEYED DATE : N/A
DATUM
VERTICAL N/A
HORIZONTAL N/A

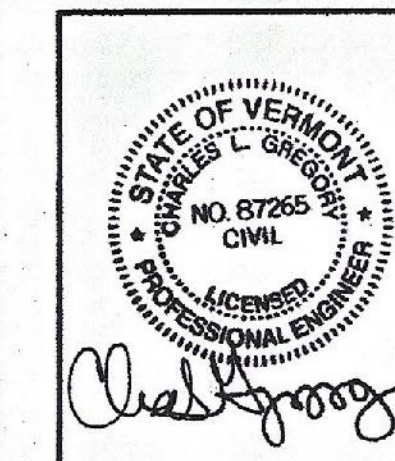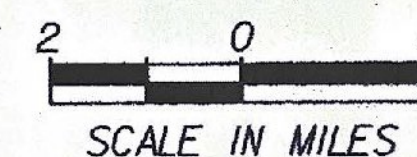

CLD
CONSULTING ENGINEERS
540 Commercial Street
Manchester, NH 03101
(603) 688-8223
www.cldengineers.com

DIRECTOR OF PROGRAM DEVELOPMENT	
APPROVED <i>[Signature]</i>	DATE 1/23/14
PROJECT MANAGER : DEREK LYMAN, P. E.	
PROJECT NAME : GUILFORD - ROCKINGHAM	
PROJECT NUMBER: IMG SIGN(44)	
SHEET 1 OF 157 SHEETS	