


**BEGIN APPROACH
IMG SIGN(44)
(MA. MM 54.000)**

**BEGIN PROJECT
IMG SIGN(44)
(MM 0.000)
(MA. MM 54.908)**

REMOVING SIGNS
TYPE A: 18
TYPE B: 4
BRIDGE PLAQUE: 0

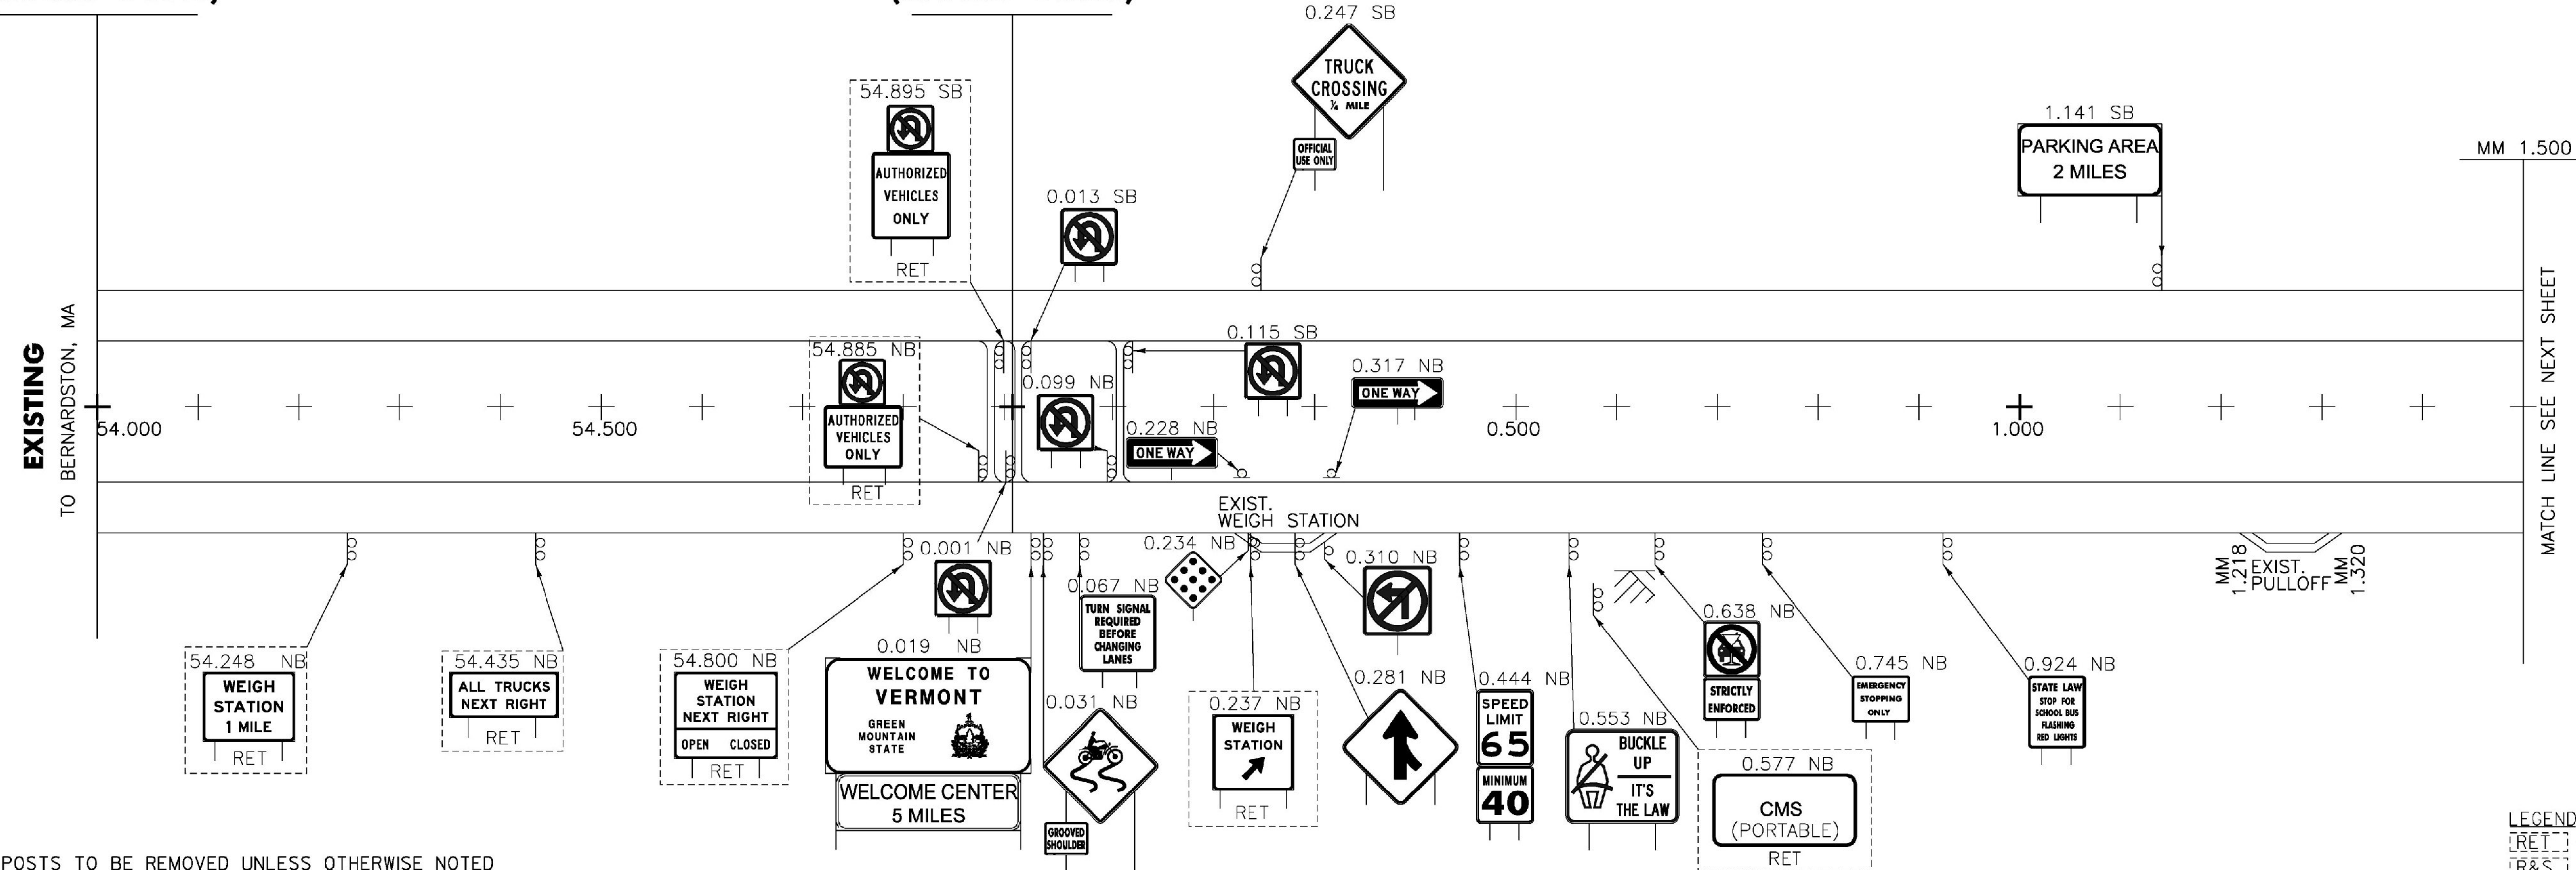


ALL EXISTING SIGNS AND POSTS TO BE REMOVED UNLESS OTHERWISE NOTED

LEGEND
[RET] - RETAIN
[R&S] - REMOVE & SALVAGE

**BEGIN APPROACH
IMG SIGN(44)
(MA. MM 54.000)**

**BEGIN PROJECT
IMG SIGN(44)
(MM 0.000)
(MA. MM 54.908)**

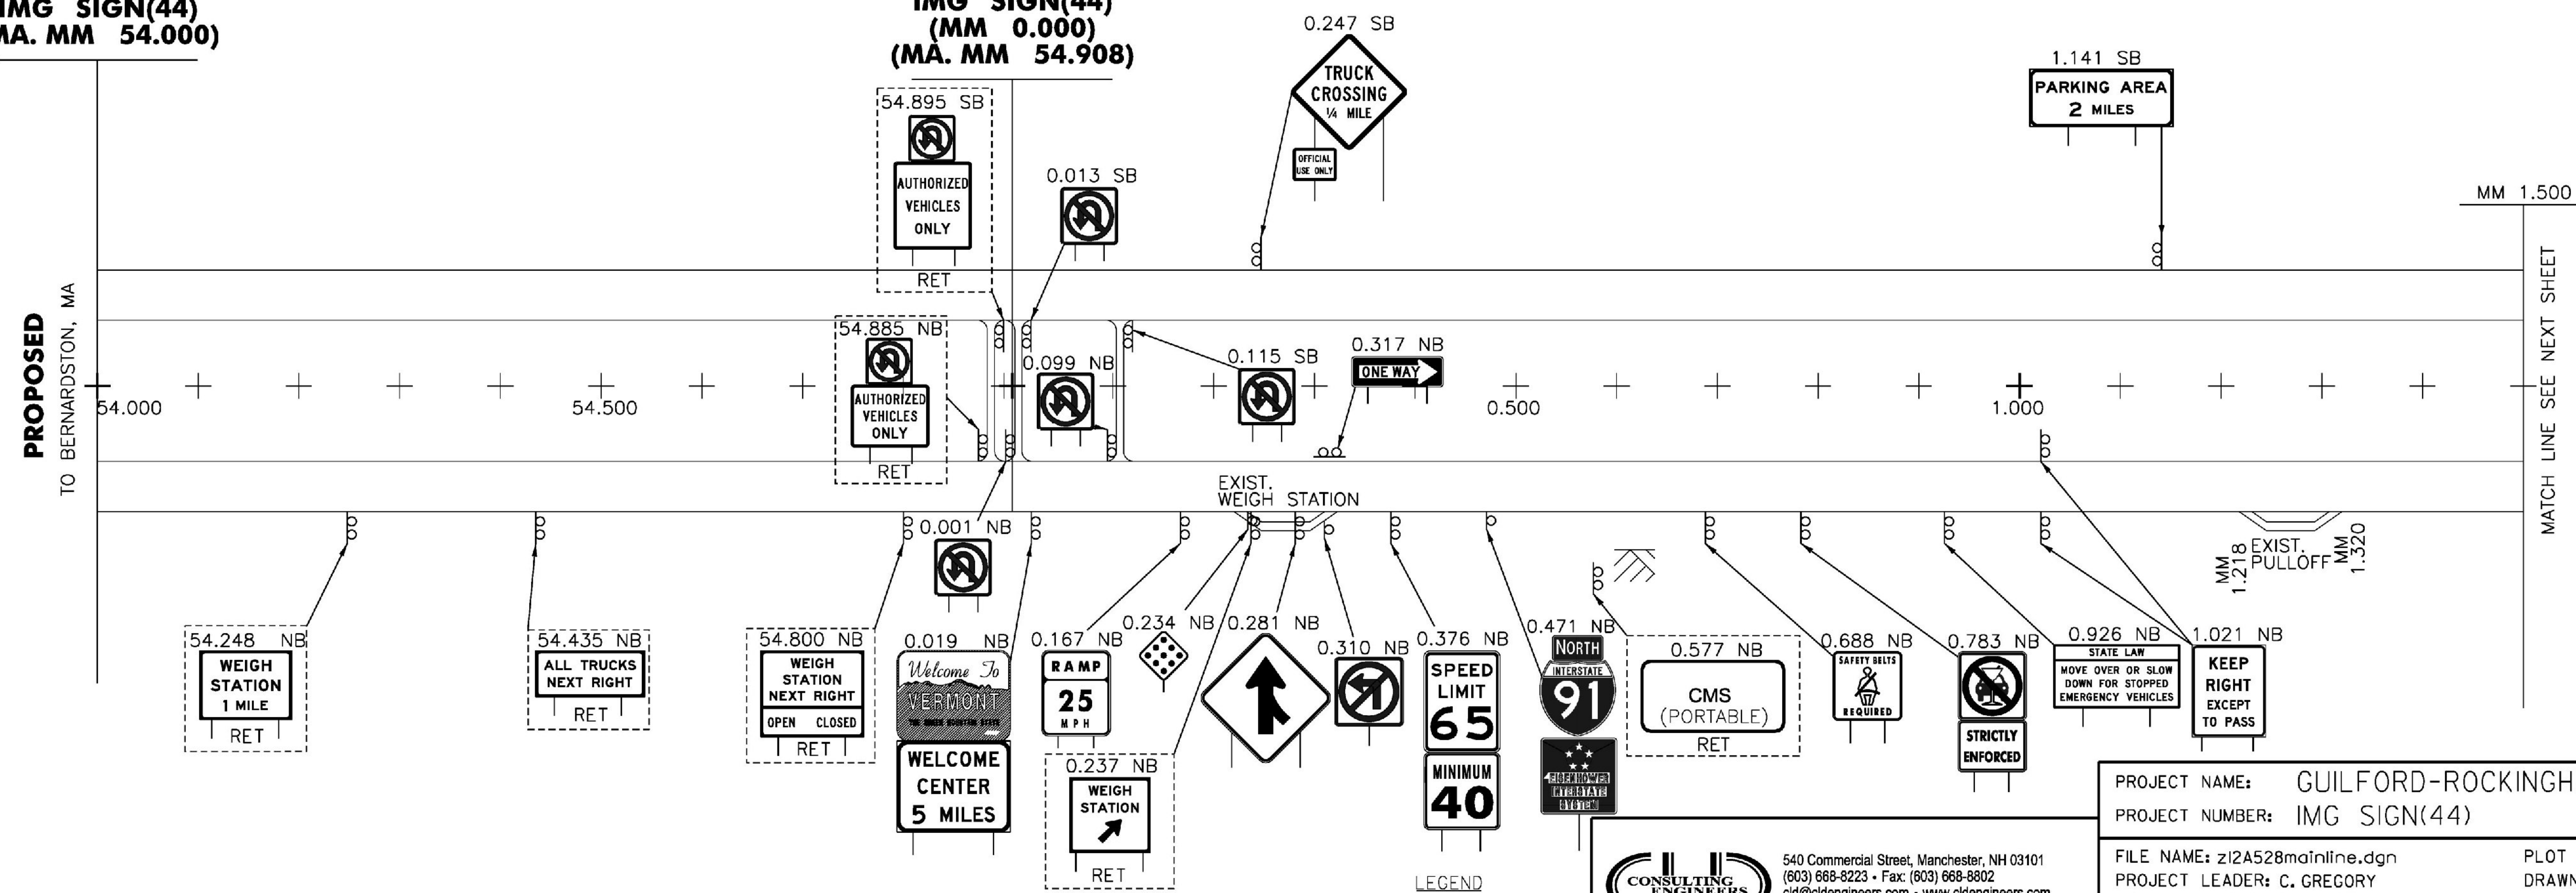

ALL PROPOSED SIGNS ARE NEW UNLESS OTHERWISE NOTED

NOT TO SCALE

LEGEND
[RET] - RETAIN
[SALV] - SALVAGE

CLD CONSULTING ENGINEERS
540 Commercial Street, Manchester, NH 03101
(603) 668-8223 • Fax: (603) 668-8802
cid@clidengineers.com • www.clidengineers.com
Maine • New Hampshire • Vermont

PROJECT NAME: GUILFORD-ROCKINGHAM
PROJECT NUMBER: IMG SIGN(44)
FILE NAME: z12A528mainline.dgn
PROJECT LEADER: C. GREGORY
DESIGNED BY: J. SMITH
MAINLINE SIGN LAYOUT 1
PLOT DATE: 4/17/2014
DRAWN BY: S. GOODWIN
CHECKED BY: D. MUNRO
SHEET 5 OF 157

CLD 12-0350 MODEL: 01