


ALL EXISTING SIGNS AND POSTS TO BE REMOVED UNLESS OTHERWISE NOTED

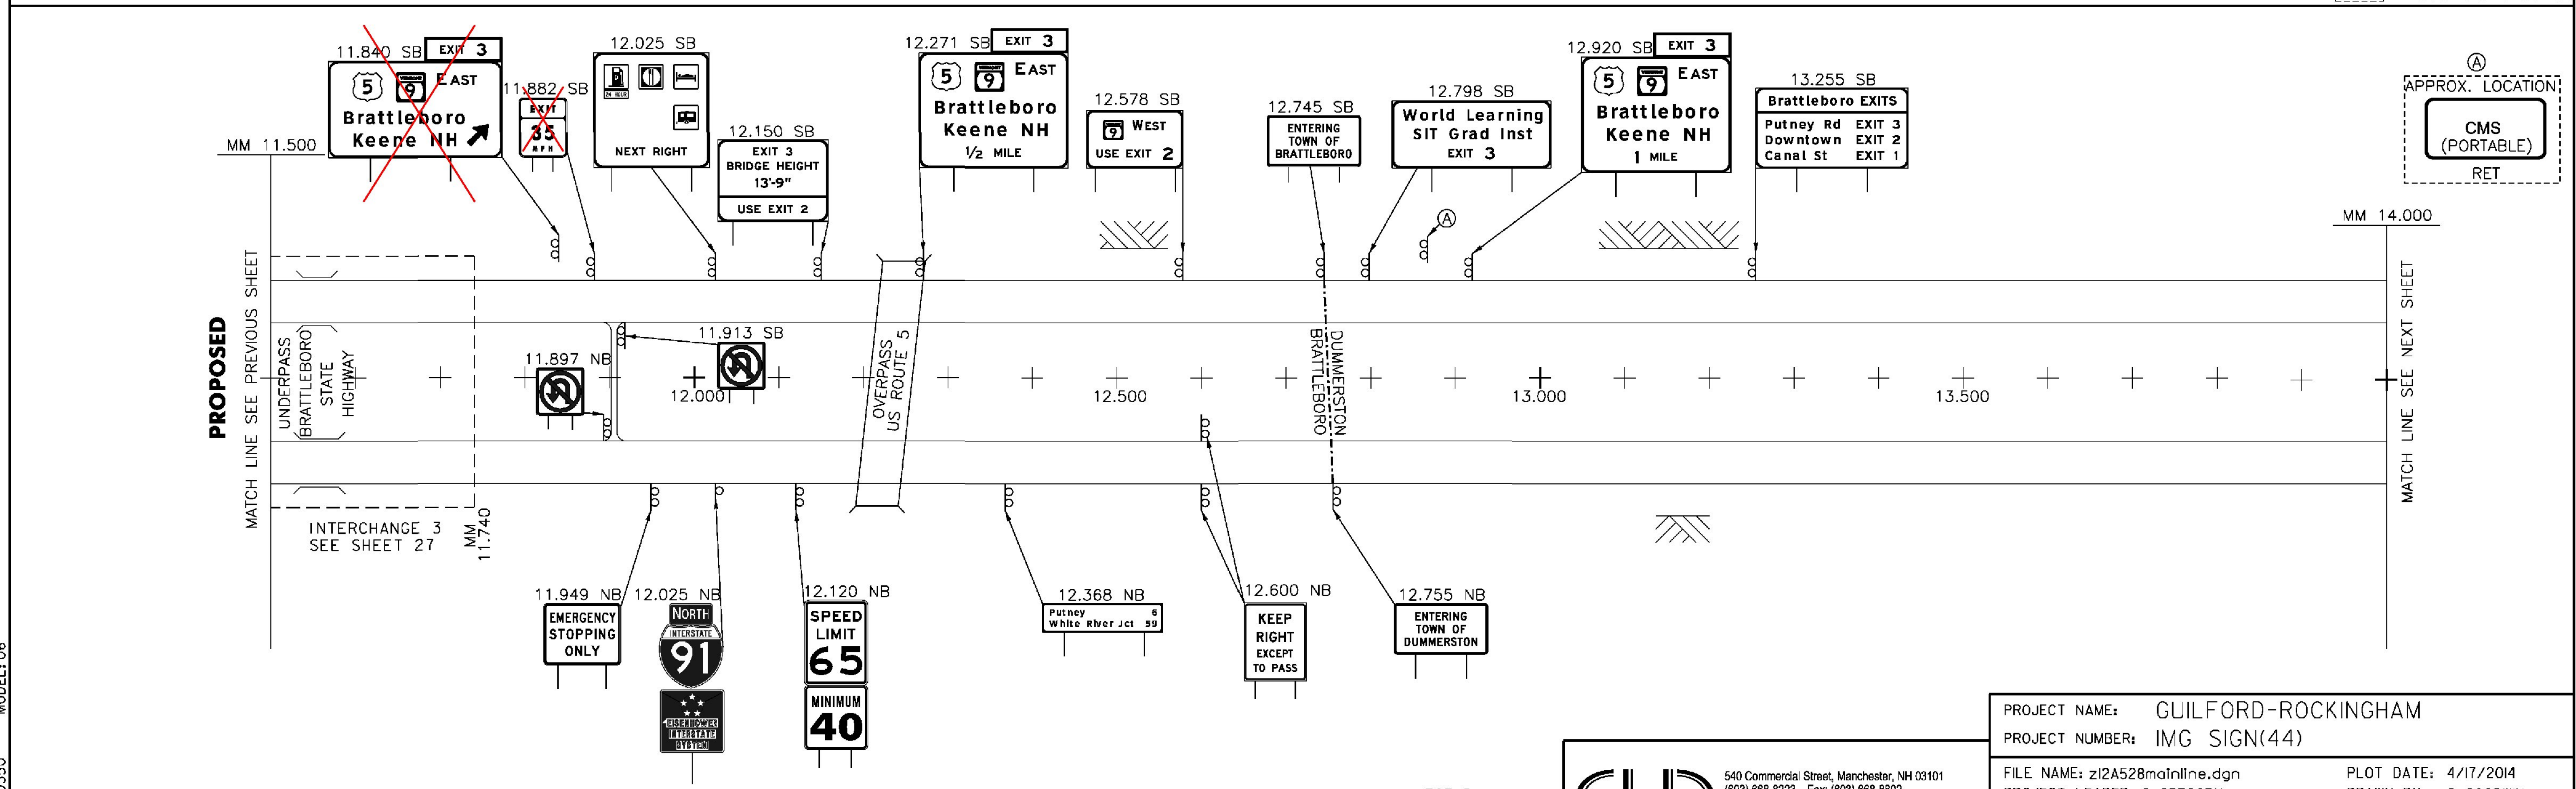

ALL PROPOSED SIGNS ARE NEW UNLESS OTHERWISE NOTED

NOT TO SCALE

CONSULTING ENGINEERS

540 Commercial Street, Manchester, NH 03101
 (603) 868-8223 • Fax: (603) 868-8802
 cld@cldeengineers.com • www.cldeengineers.com
 Maine • New Hampshire • Vermont

PROJECT NAME: GUILFORD-ROCKINGHAM	PLOT DATE: 4/17/2014
PROJECT NUMBER: IMG SIGN(44)	DRAWN BY: S. GOODWIN
FILE NAME: z12A528mainline.dgn	CHECKED BY: D. MUNRO
DESIGNED BY: J. SMITH	SHEET 10 OF 157
MAINLINE SIGN LAYOUT 6	

MODEL: 06
 CLD 12-0350