



REMOVING SIGNS
 TYPE A: 16
 TYPE B: 4
 BRIDGE PLAQUE: 4

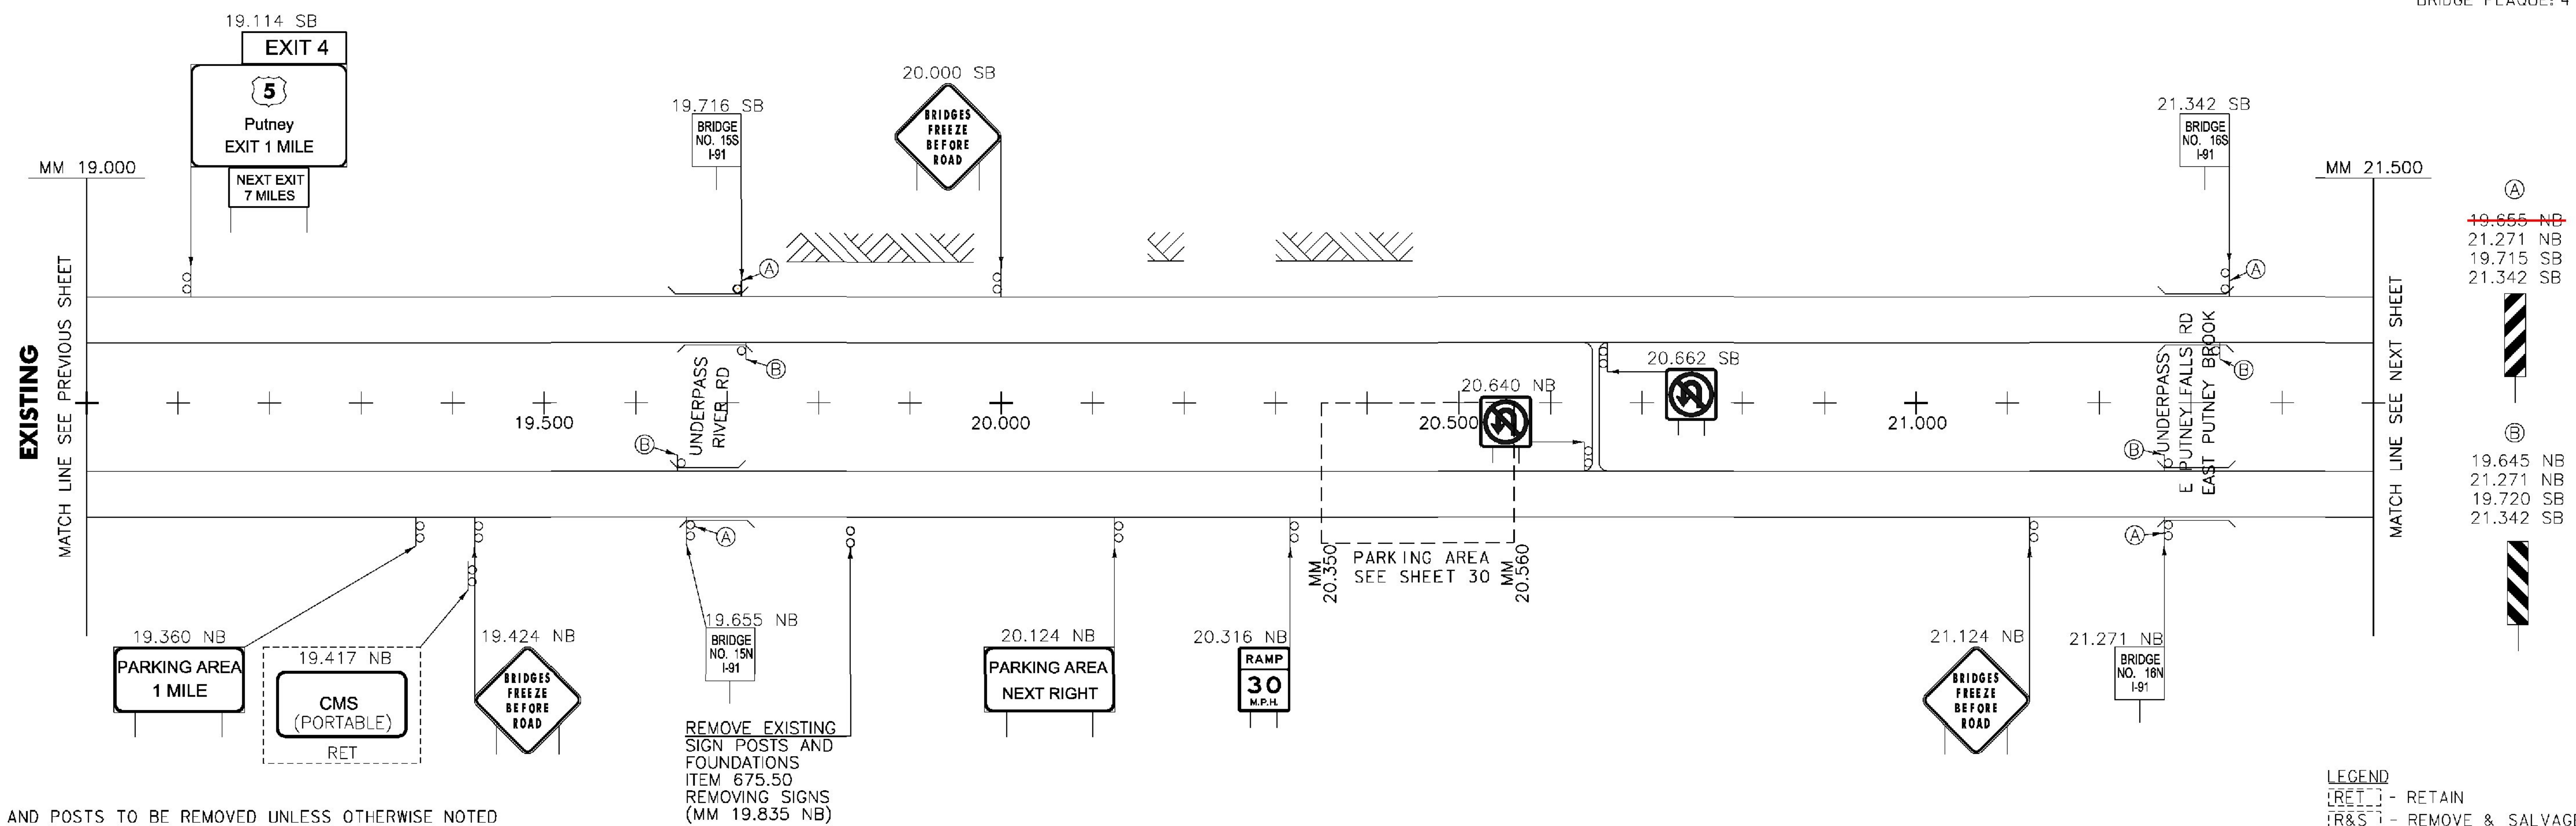

ALL EXISTING SIGNS AND POSTS TO BE REMOVED UNLESS OTHERWISE NOTED


LEGEND
 [RET] - RETAIN
 [R&S] - REMOVE & SALVAGE

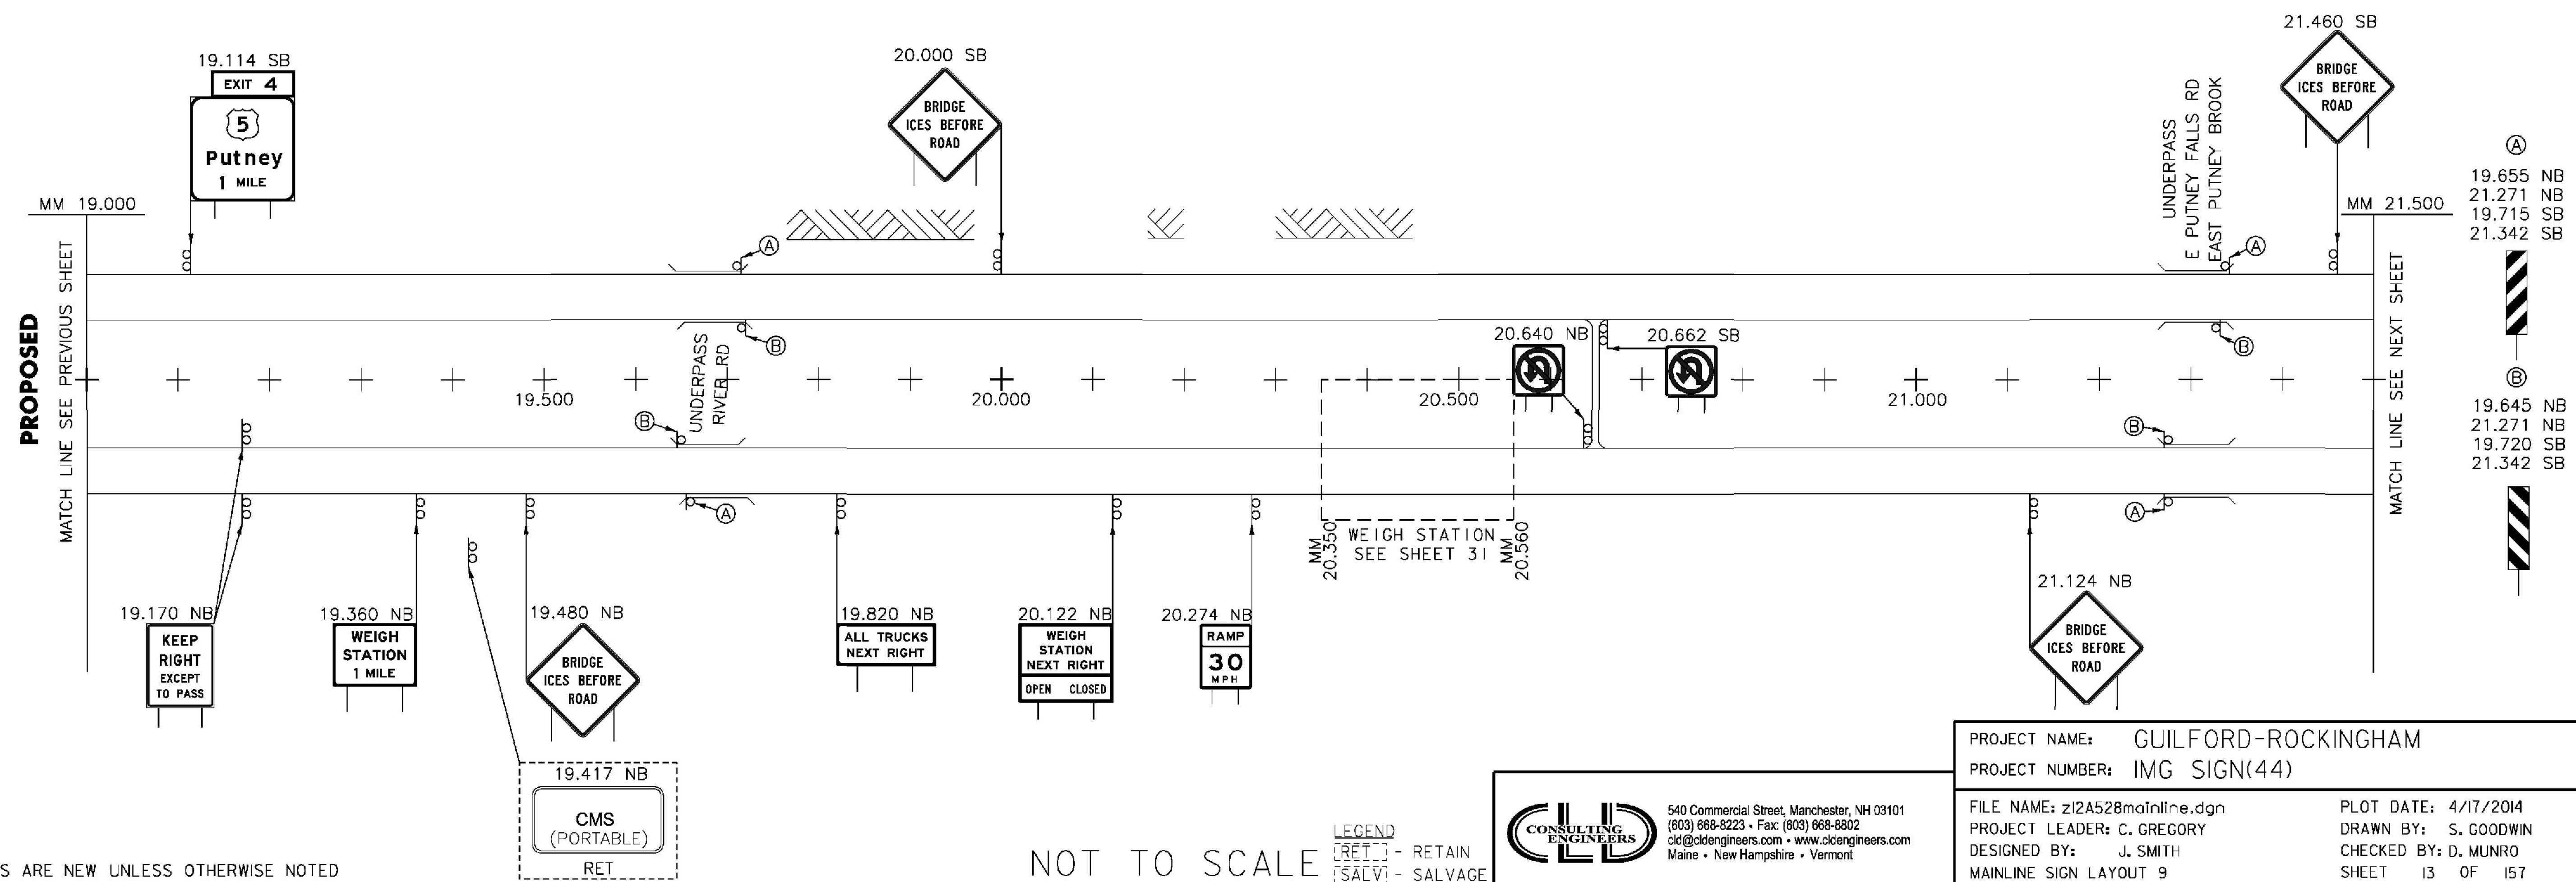

ALL PROPOSED SIGNS ARE NEW UNLESS OTHERWISE NOTED

NOT TO SCALE

LEGEND
 [RET] - RETAIN
 [S&V] - SALVAGE

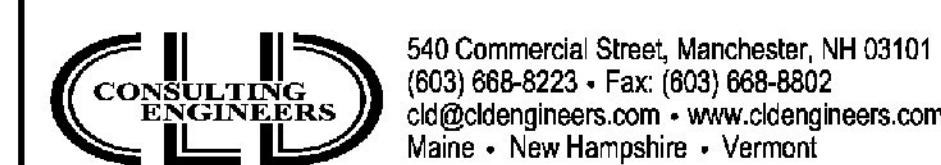

PROJECT NAME: GUILFORD-ROCKINGHAM
 PROJECT NUMBER: IMG SIGN(44)

FILE NAME: z12A528mainline.dgn
 PROJECT LEADER: C. GREGORY
 DESIGNED BY: J. SMITH
 MAINLINE SIGN LAYOUT 9

PLOT DATE: 4/17/2014
 DRAWN BY: S. GOODWIN
 CHECKED BY: D. MUNRO
 SHEET 13 OF 157

CLD 12-0350 MODEL: 09