



REMOVING SIGNS  
 TYPE A: 21  
 TYPE B: 3  
 BRIDGE PLAQUE: 2

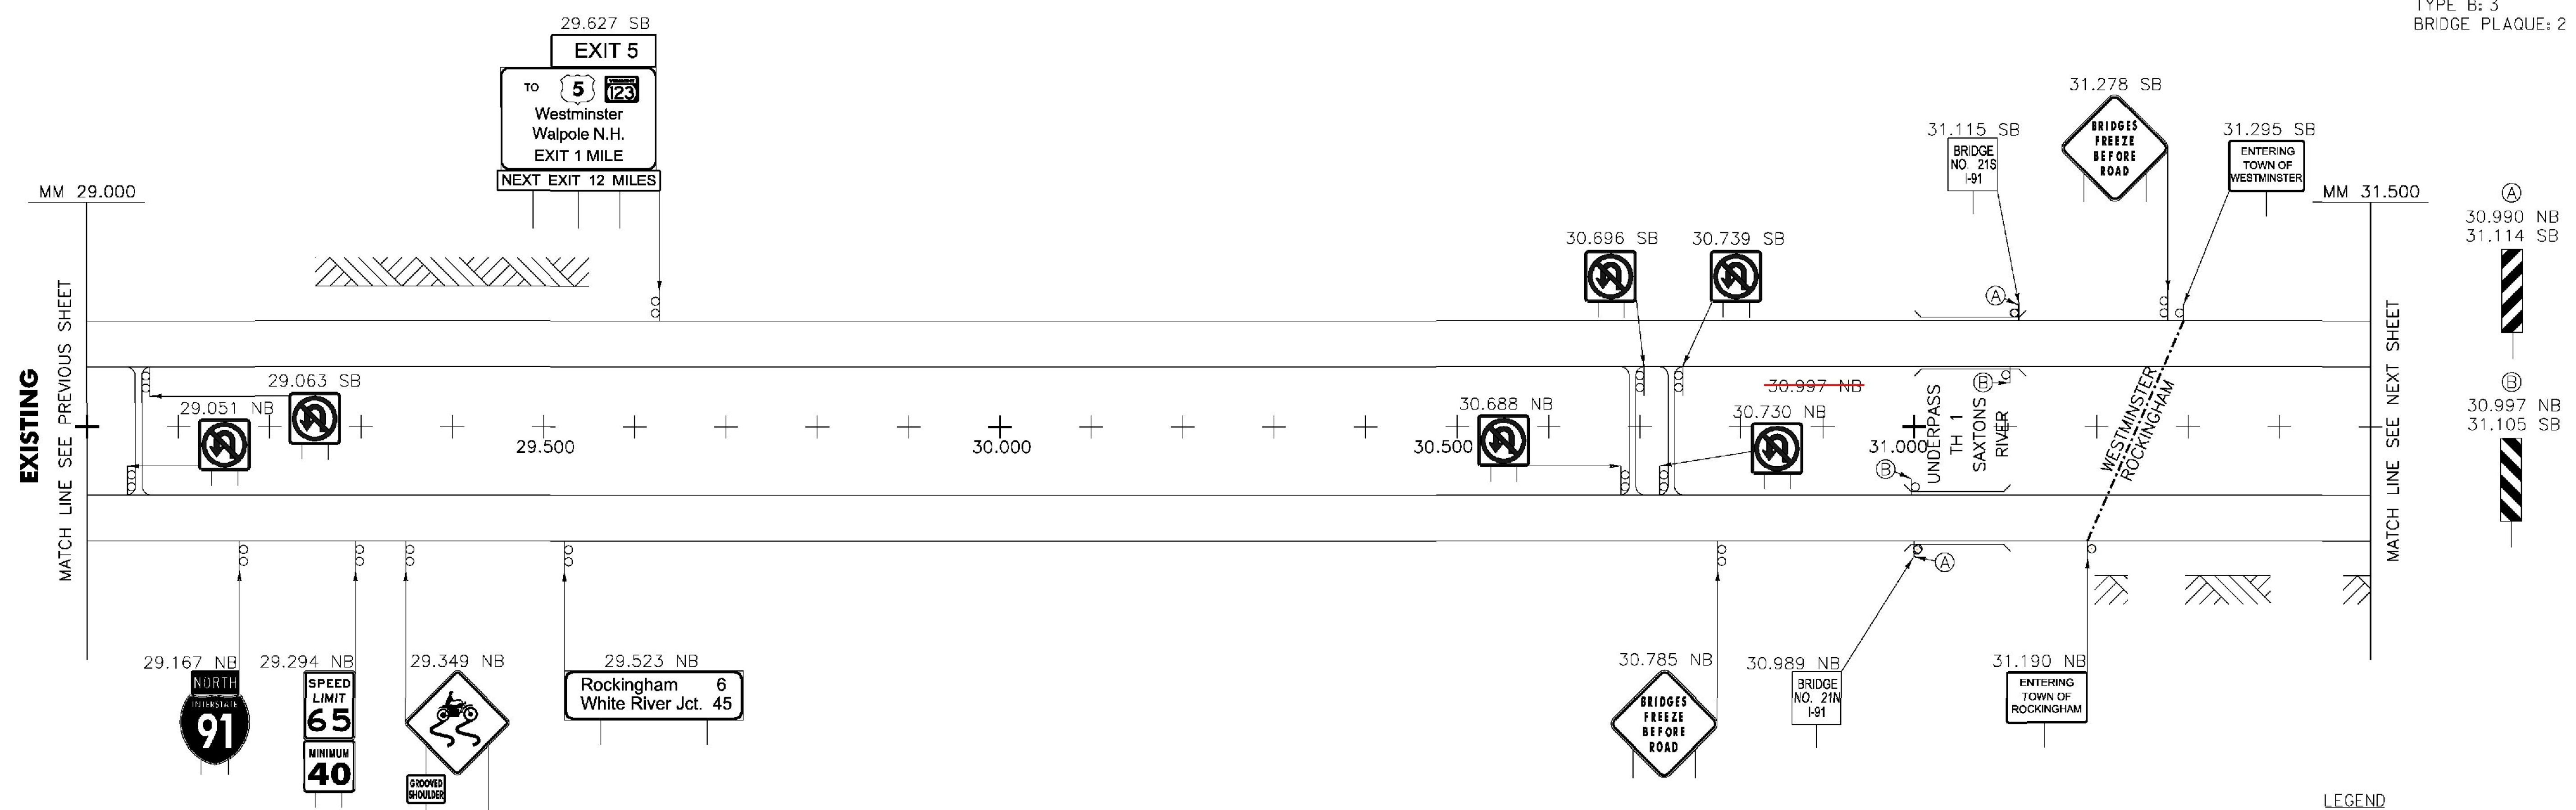

ALL EXISTING SIGNS AND POSTS TO BE REMOVED UNLESS OTHERWISE NOTED

LEGEND  
 [RET] - RETAIN  
 [R&S] - REMOVE & SALVAGE

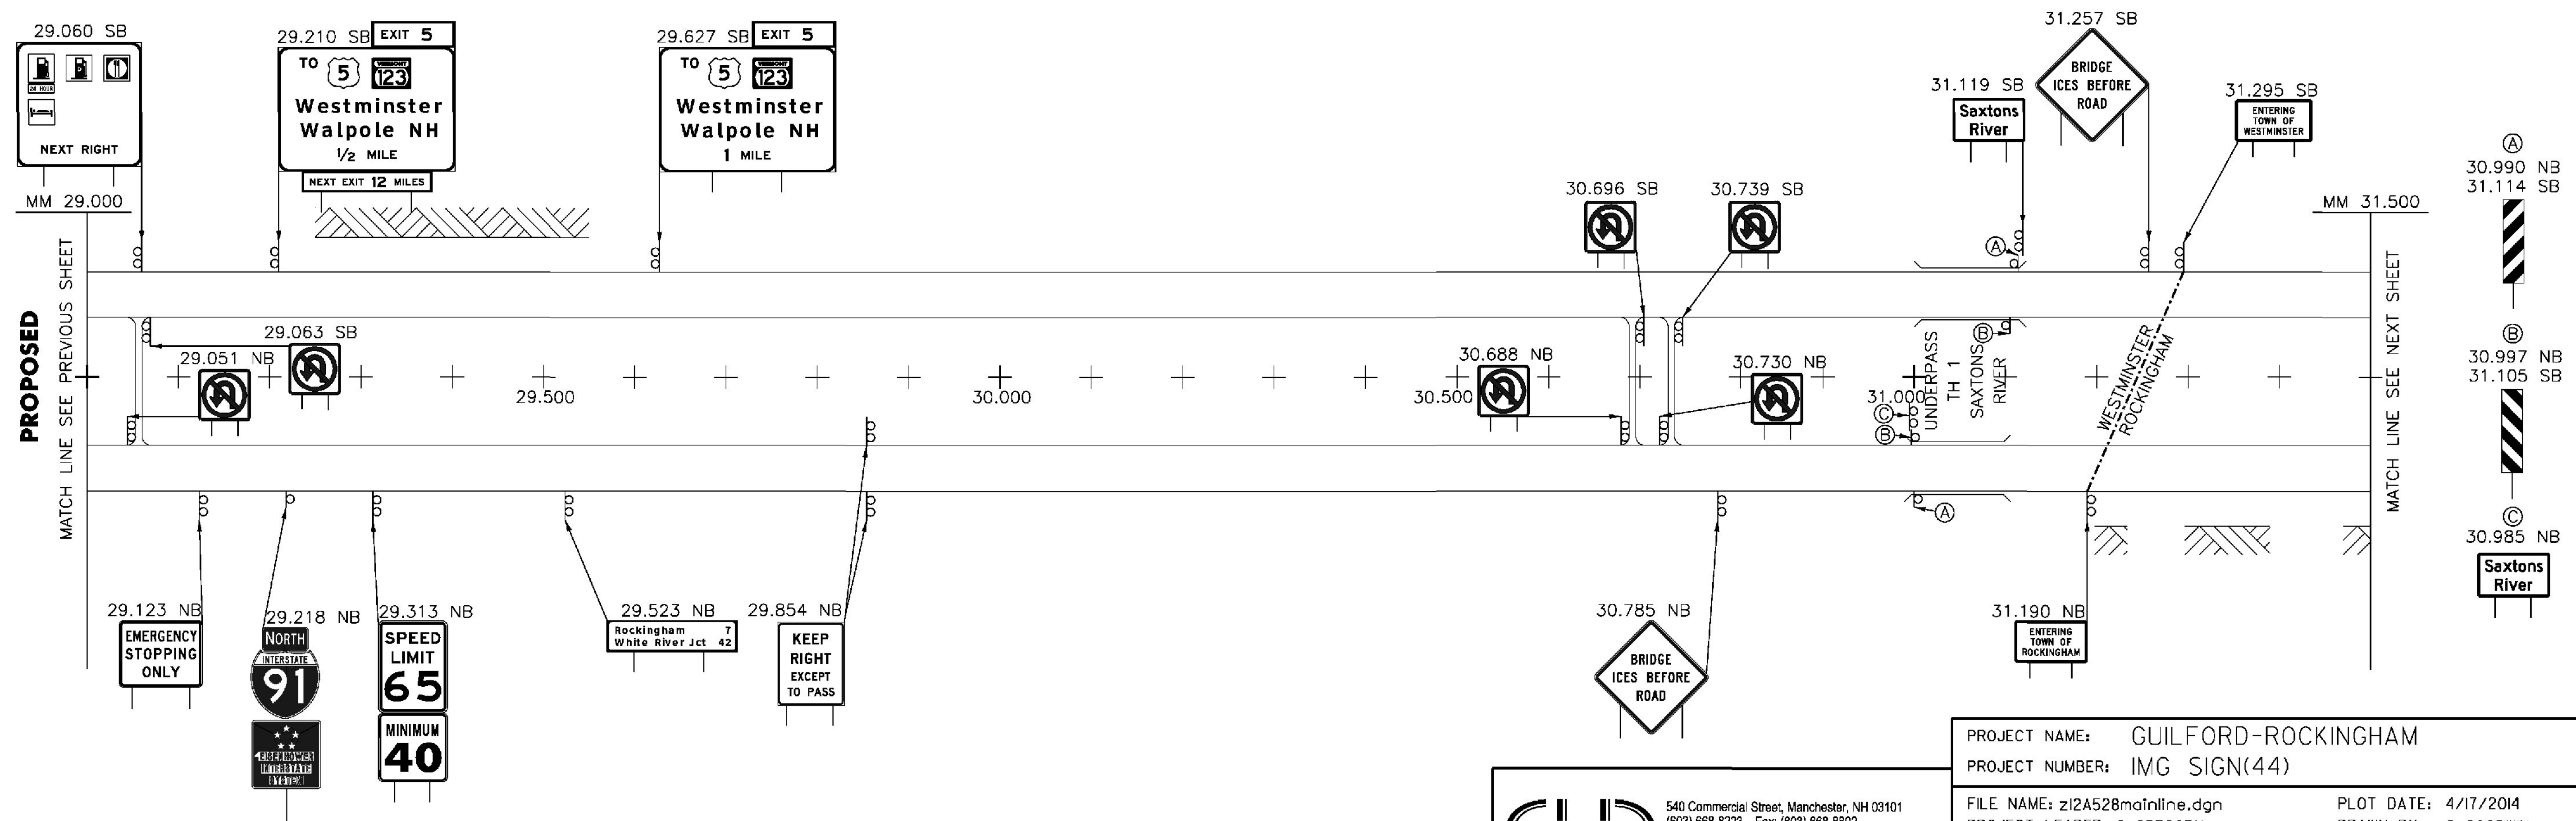

ALL PROPOSED SIGNS ARE NEW UNLESS OTHERWISE NOTED

NOT TO SCALE

LEGEND  
 [RET] - RETAIN  
 [SALV] - SALVAGE

**CLD CONSULTING ENGINEERS**

540 Commercial Street, Manchester, NH 03101  
 (603) 868-8223 • Fax: (603) 868-8802  
 cld@cldeengineers.com • www.cldeengineers.com  
 Maine • New Hampshire • Vermont

PROJECT NAME: GUILFORD-ROCKINGHAM	PLOT DATE: 4/17/2014
PROJECT NUMBER: IMG SIGN(44)	DRAWN BY: S. GOODWIN
FILE NAME: z12A528mainline.dgn	CHECKED BY: D. MUNRO
PROJECT LEADER: C. GREGORY	SHEET 17 OF 157
DESIGNED BY: J. SMITH	
MAINLINE SIGN LAYOUT 13	

CLD 12-0350 MODEL: 13