



REMOVING SIGNS
 TYPE A: 6
 TYPE B: 3
 BRIDGE PLAQUE: 2

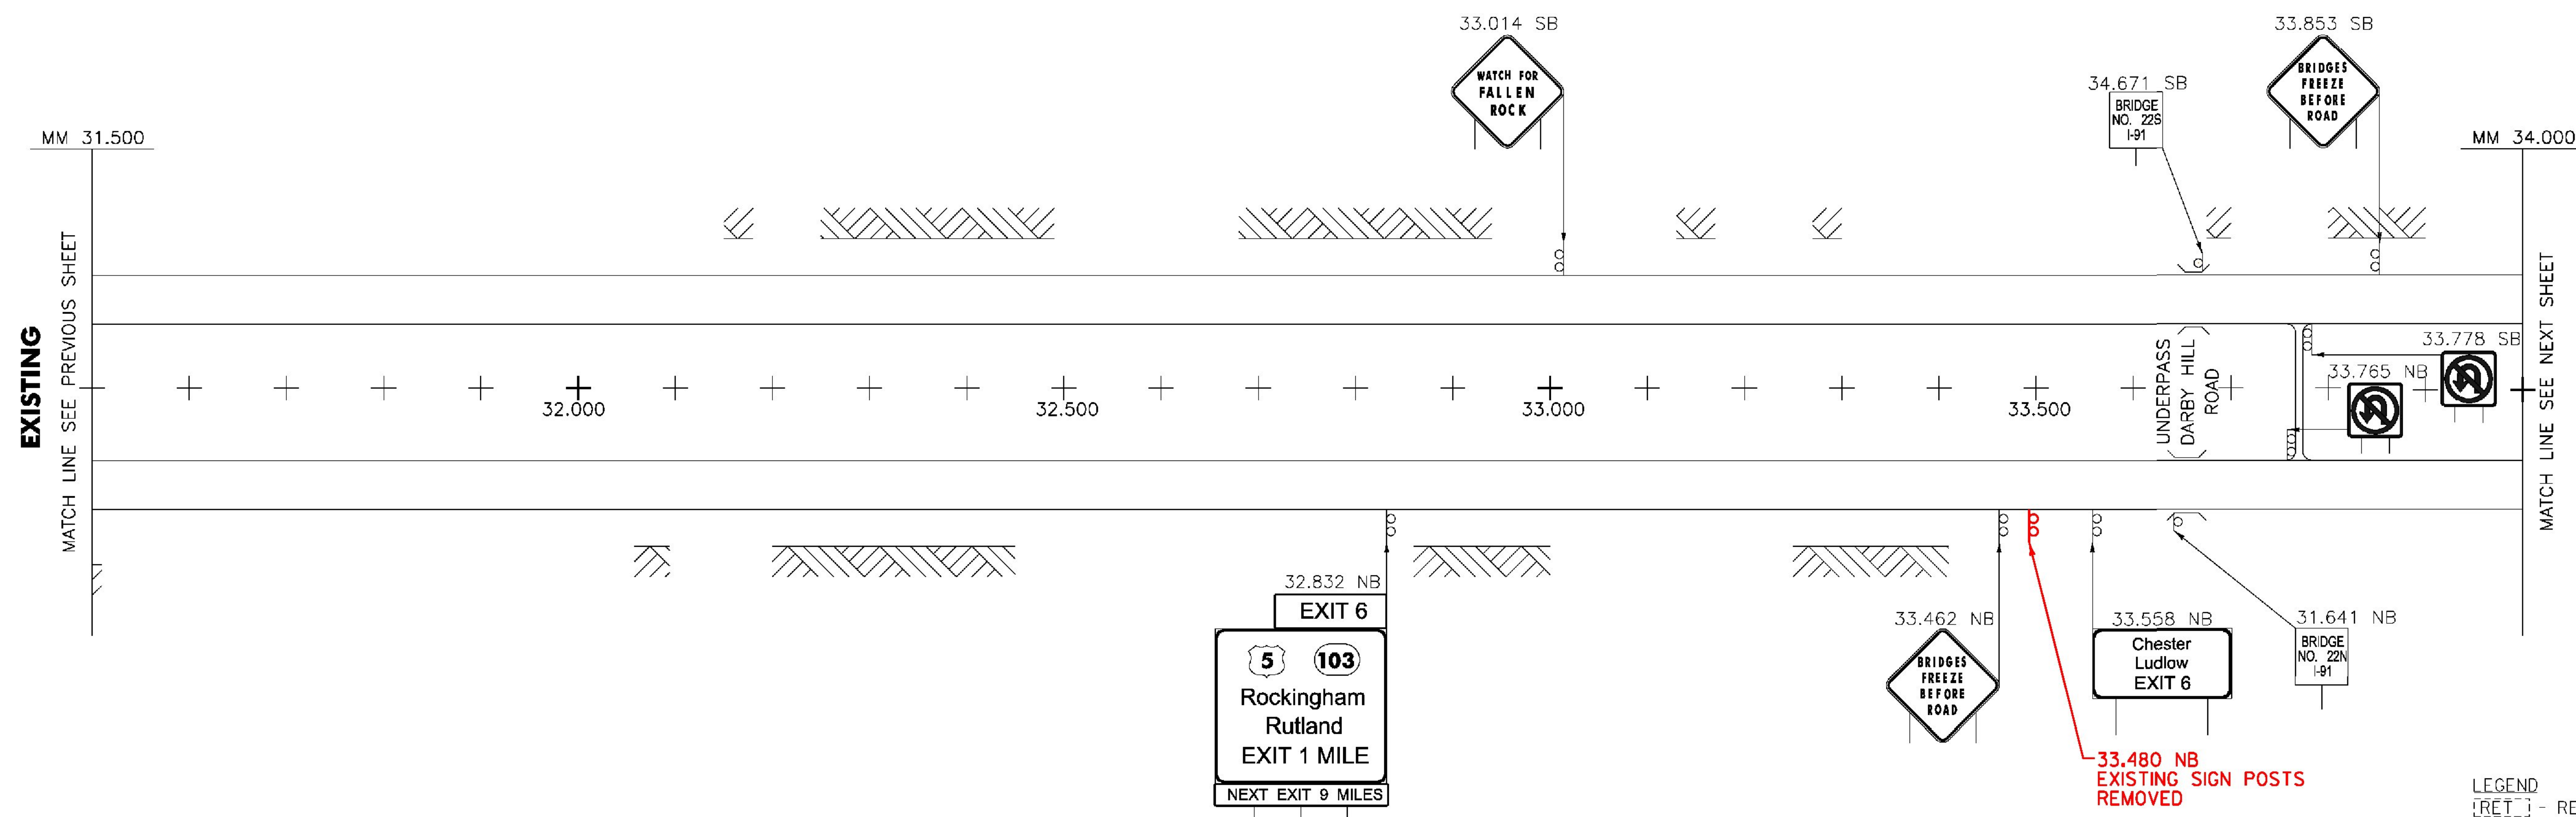

ALL EXISTING SIGNS AND POSTS TO BE REMOVED UNLESS OTHERWISE NOTED

LEGEND
 [RET] - RETAIN
 [R&S] - REMOVE & SALVAGE

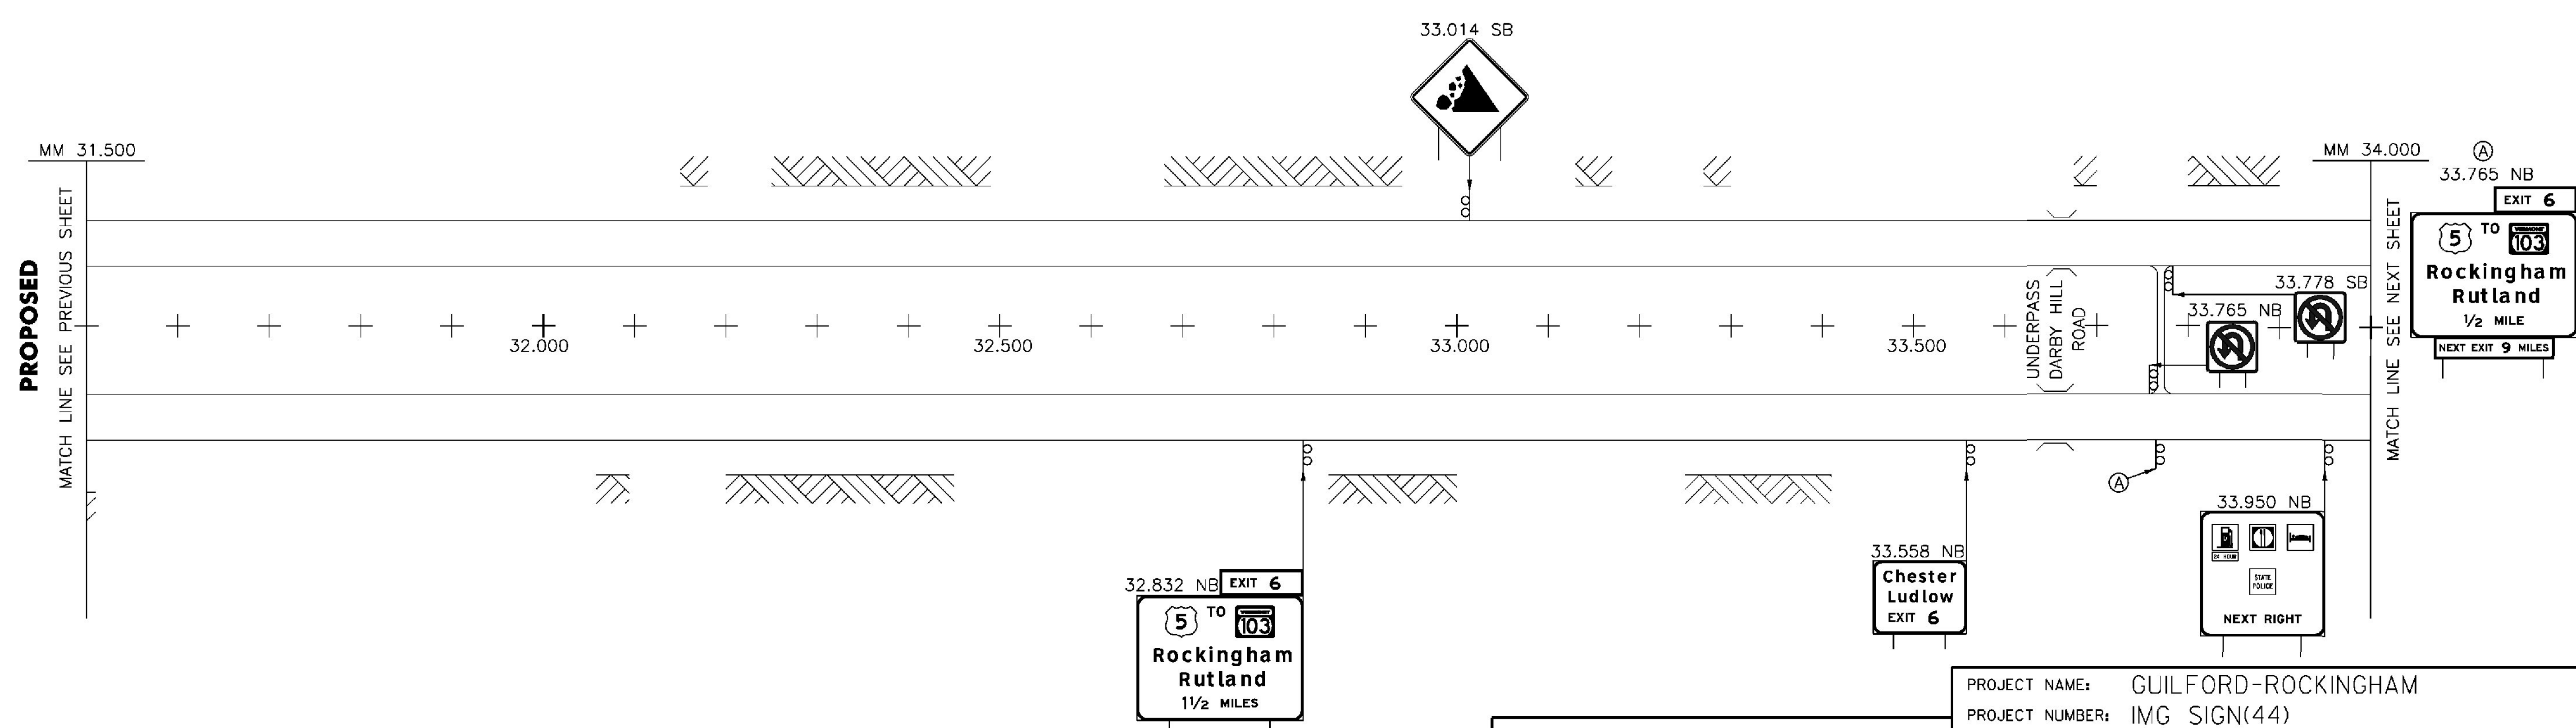

ALL PROPOSED SIGNS ARE NEW UNLESS OTHERWISE NOTED

NOT TO SCALE

LEGEND
 [RET] - RETAIN
 [S&V] - SALVAGE

CLD CONSULTING ENGINEERS
 540 Commercial Street, Manchester, NH 03101
 (603) 868-8223 • Fax: (603) 868-8802
 clc@cldeengineers.com • www.cldeengineers.com
 Maine • New Hampshire • Vermont

PROJECT NAME: GUILFORD-ROCKINGHAM	PLOT DATE: 4/17/2014
PROJECT NUMBER: IMG SIGN(44)	DRAWN BY: S. GOODWIN
FILE NAME: z12A528mainline.dgn	CHECKED BY: D. MUNRO
DESIGNED BY: J. SMITH	SHEET 18 OF 157
MAINLINE SIGN LAYOUT 14	

CLD 12-0350 MODEL: 14